S

AS

SZ

# SANITARY SEWER CONSTRUCTION PLANS

- C24 OVERALL SANITARY SEWER PLAN
- C25 SANITARY SEWER GENERAL NOTES
- C26 SANITARY SEWER BENERAL NOTES
  C26 SANITARY SEWER PLAN & PROFILE LINE "A"
  C27 SANITARY SEWER PLAN & PROFILE LINE "B"
  C28 SANITARY SEWER PLAN & PROFILE LINE "C"
  C29 SANITARY SEWER STANDARD DETAILS

# LOCATION MAP

# **PLAN OF RECORD**

THESE RECORD DOCUMENTS HAVE BEEN PREPARED BASED ON INFORMATION PROVIDED BY OTHERS. THE ENGINEER HAS NOT VERIFIED THE ACCURACY OF THIS INFORMATION AND ASSUMES NO LIABILITY FOR ANY ERRORS AND OMISSIONS CAUSED AS A RESULT.



# PULTE HOME OF TEXAS, L.P.

VICINITY MAP

# **DEVELOPER:**


PULTE HOMES OF TEXAS, L.P. CONTACT PERSON: EMILIANO GUERRERO, P.E. 1718 DRY CREEK WAY, SUITE 120 SAN ANTONIO, TX 78259 TEL: (210) 496-1985


FAX: (210) 496-0449


# 4122 Pond Hill Road, Suite 101 San Antonio, Texas 78231

P:(210) 681.2951 F: (210) 523.7112

•	.0, 001.2331 1. (210, 323.)	
DRAWN BY	DATE	PLAT NO.
BMO\SMR\TCD\BAS	12/23/2015	CP201603
CHECKED BY	PROJECT NO.	SAWS JOB NO.
W. PATRICK MURPHY, P.E.	02975.010	16-1527

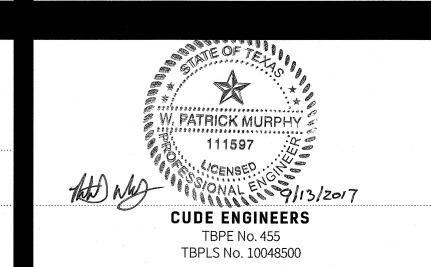

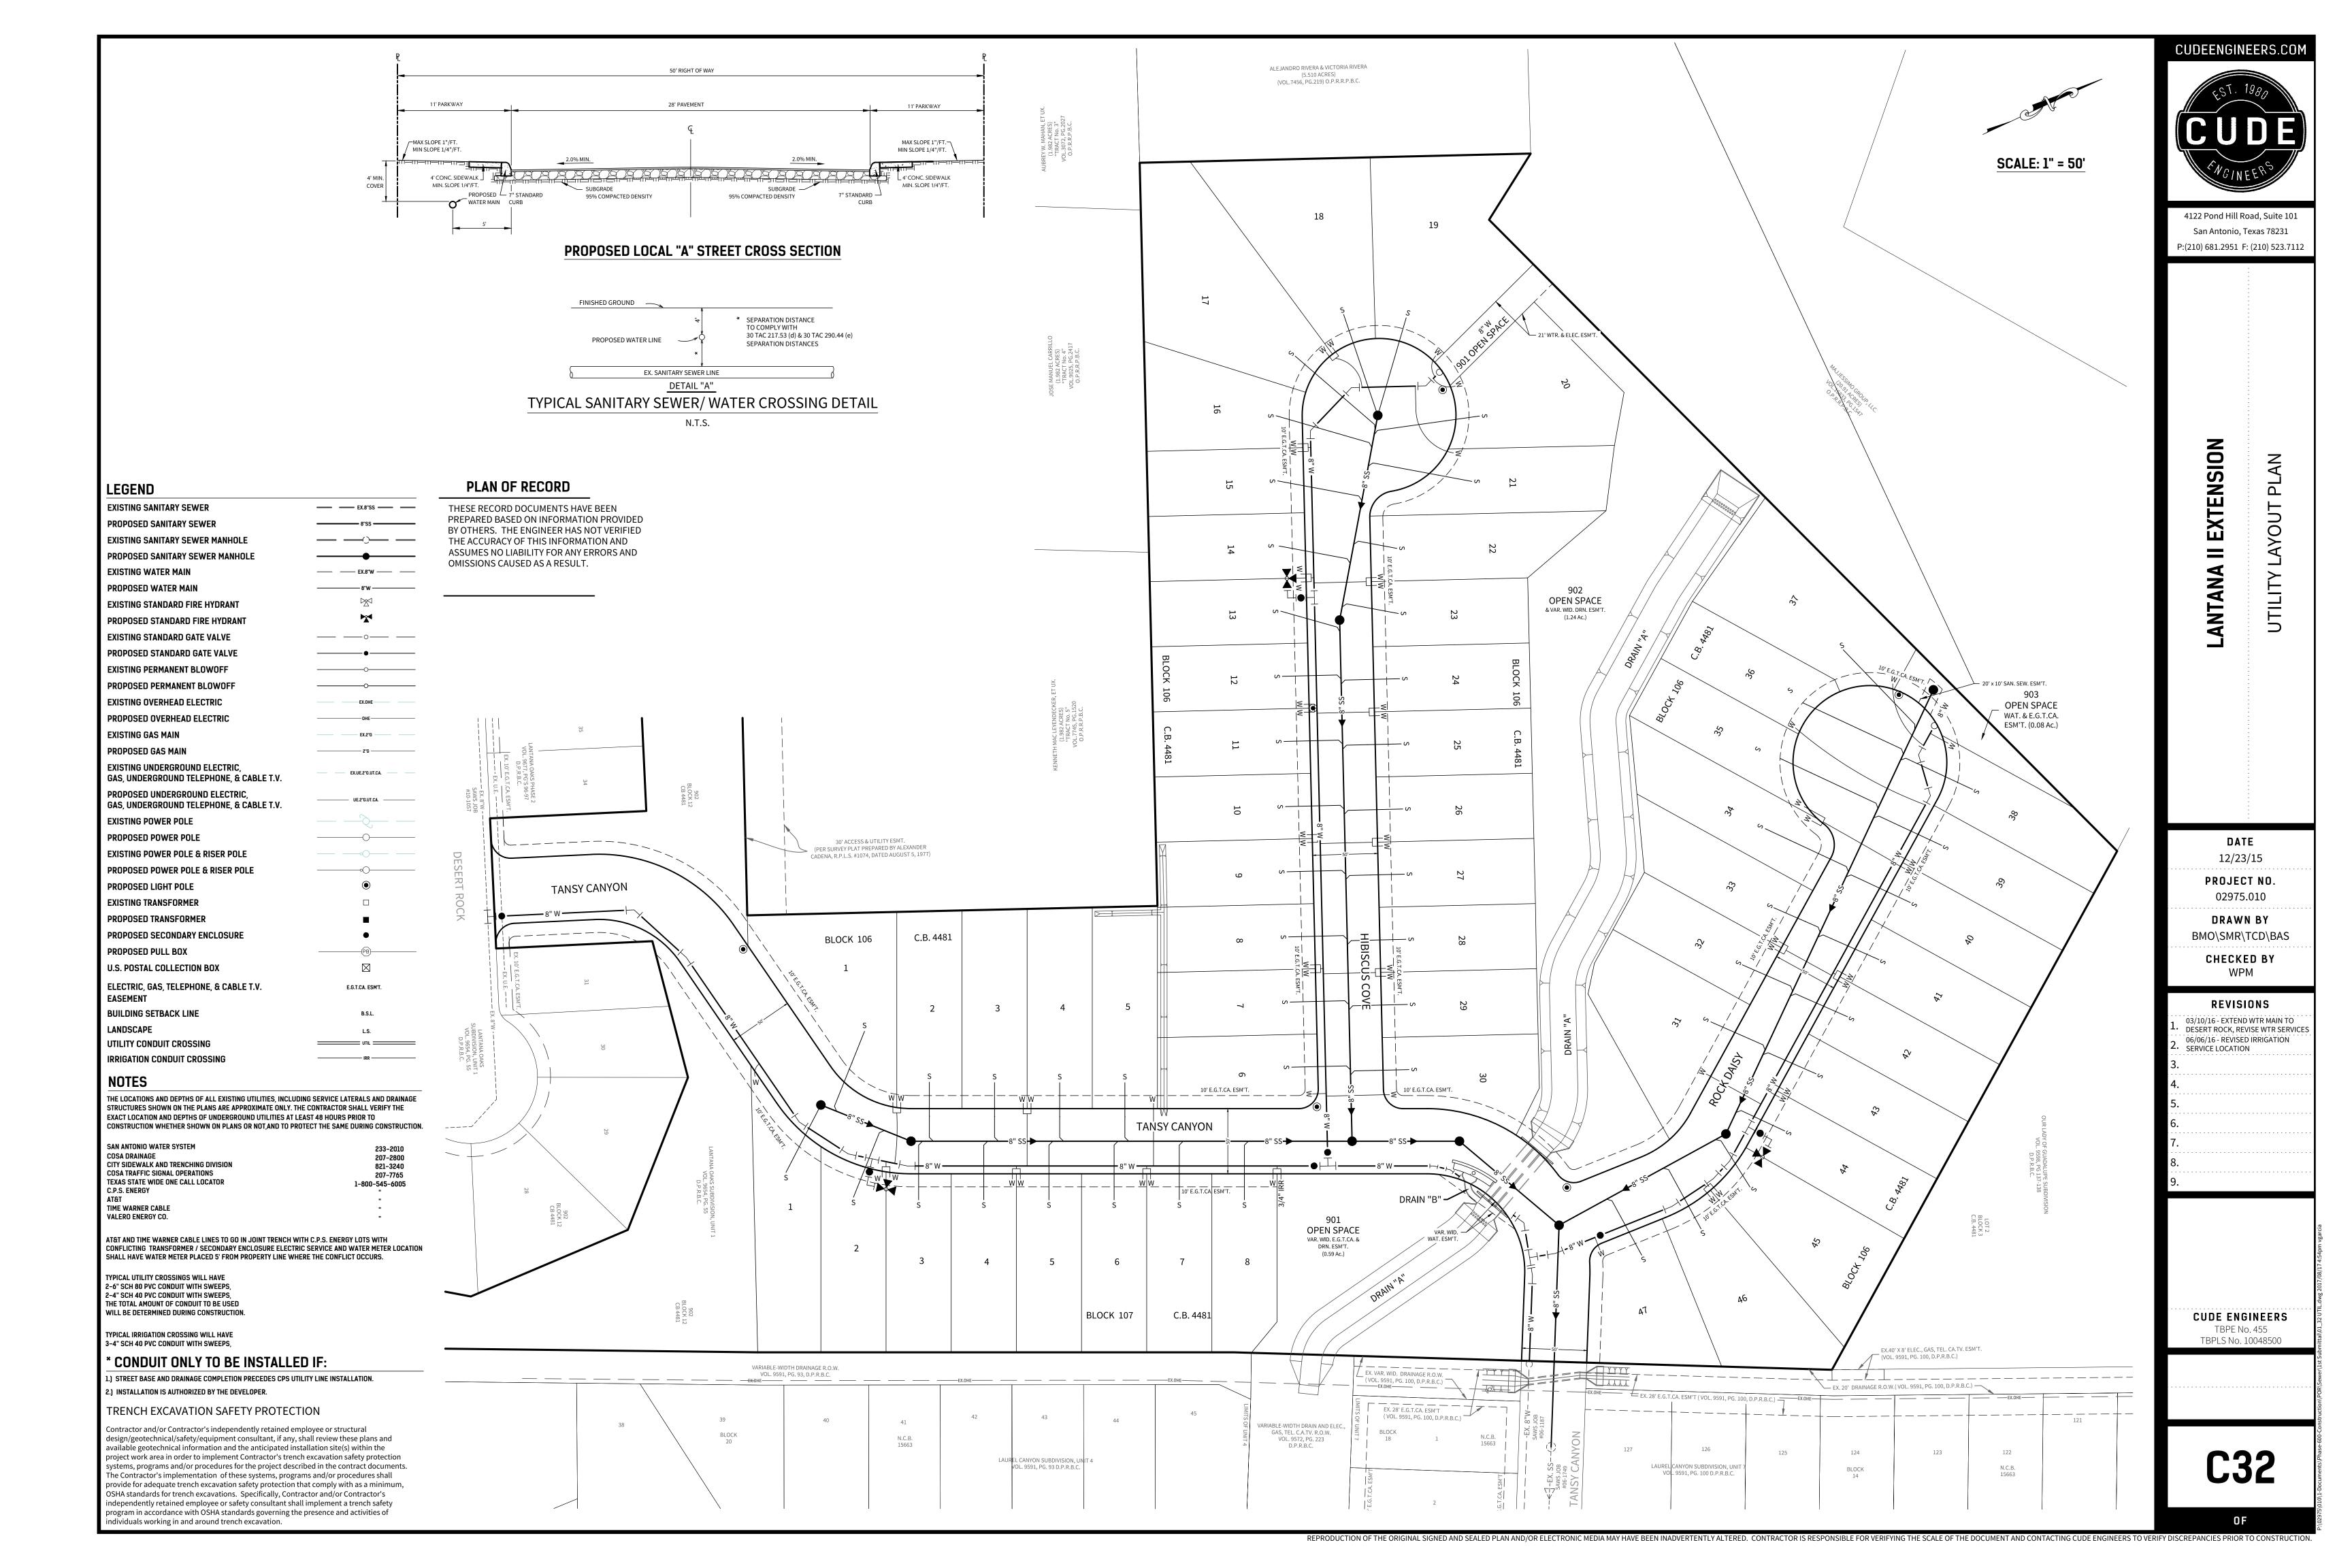

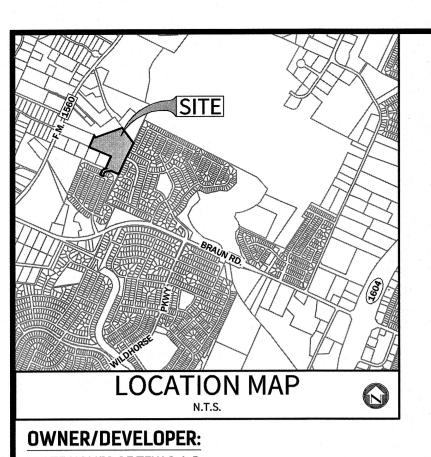

PULTE HOMES OF TEXAS, L.P. CONTACT PERSON: EMILIANO Z. GUERRERO, P.E. 1718 DRY CREEK WAY, SUITE 120 SAN ANTONIO, TX 78259

TEL: (210) 496-1985

# **CIVIL ENGINEER:**

M.W. CUDE ENGINEERS, L.L.C. CONTACT PERSON: W. PATRICK MURPHY, P.E. 4122 POND HILL ROAD, SUITE 101 SAN ANTONIO, TX 78231

TEL: (210) 681-2951 FAX: (210) 523-7112

# MANUFACTURER'S NOTES:


**NORTH AMERICAN:** 

CHARLOTTE:

**PLASTIC TRENDS:** 

# PLAN OF RECORD

THESE RECORD DOCUMENTS HAVE BEEN PREPARED BASED ON INFORMATION PROVIDED BY OTHERS. THE ENGINEER HAS NOT VERIFIED THE ACCURACY OF THIS INFORMATION AND ASSUMES NO LIABILITY FOR ANY ERRORS AND **OMISSIONS CAUSED AS A RESULT.** 

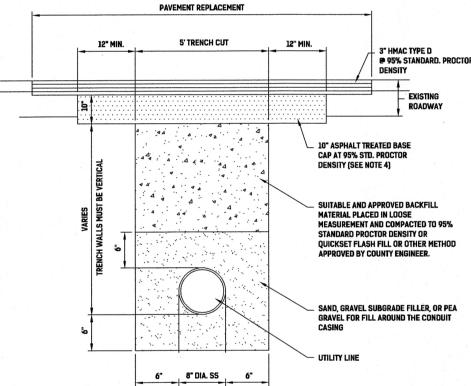

1. ALL UTILITIES WILL BE BORED UNDER EXISTING PAVEMENT. ONLY AT THOSE LOCATIONS AT WHICH IT IS PHYSICALLY IMPOSSIBLE TO BORE WILL THE PAVEMENT BE ALLOWED TO BE CUT AND RESTORED ACCORDING TO THIS DETAIL.

2. THE LIMITS OF THE PAVEMENT REPLACEMENT WILL BE DETERMINED AT THE TIME A PERMIT IS REVIEWED AND MUST BE SAW CUT STRAIGHT. TACK OIL AT A RATE OF 0.10 GAL/SY SHALL BE PLACED PRIOR TO PLACEMENT OF 2" HMAC TYPE "D" FINISHED SURFACE. LONGITUDINAL ROADWAY CUTS WILL BE PAVED WITH THE CLOSEST LINE EXTENSION OF THE EXISTING PAVEMENT EDGE AS A MINIMUM.

3. A 10" THICKNESS OF ASPHALT TREATED BASE, BENCHED A FEET EACH SIDE OF TRENCH, WILL BE USED FOR THE FINAL LIFT OF THE TRENCH REPAIR. THE ASPHALT TREATED BASE, PLACED IN 5" LIFTS, SHALL

4. THE UTILITY COMPANY WILL BE RESPONSIBLE FOR THE MAINTENANCE OF THE STREET CUT THEREAFTER UNTIL AND IF THE COUNTY REMOVES THE STREET CUT THROUGH RECONSTRUCTION.

5. SEAL COAT, TO BE DETERMINED AT THE TIME OF PERMIT REQUEST, SHALL BE EXTENDED A MINIMUM OI 20 FEET EACH DIRECTION FROM THE EDGE OF PAVEMENT REPLACEMENT FOR THE FULL WIDTH OF THE

6. WHEN GEOGRID OR OTHER GEOSYNTHETIC SUBGRADE/BASE REINFORCEMENT IS PRESENT, THE CONTRACTOR SHALL CONDUCT EXCAVATION TO PROVIDE APPROPRIATE OVERLAP (2' MIN) AND TIE TO EXISTING UNDISTURBED REINFORCEMENT AS REQUIRED BY MANUFACTURER FOR EACH LAYER OF REINFORCEMENT ENCOUNTERED.

# STREET CUT REPAIR DETAIL

THE CONTRACTOR SHALL BE RESPONSIBLE FOR MEETING 98% COMPACTION ON ALL TRENCH BACKFILL AND PAYING FOR THE TESTS TO BE PERFORMED BY A THIRD PARTY. COMPACTION TEST WILL BE DONE AT ONE LOCATION POINT RANDOMLY SELECTED OR AS INDICATED BY THE SAWS INSPECTOR/TEST ADMINISTER, PER EACH 12-INCH LOOSE LIFT PER 400 LINEAR FEET AT A MINIMUM. THIS PROJECT WILL NOT BE ACCEPTED AND FINALIZED BY SAWS WITHOUT THIS REQUIREMENT BEING MET AND VERIFIED BY PROVIDING ALL NECESSARY DOCUMENTED TEST


# CAUTION NOTE:

RESULTS.

THE CONTRACTOR SHALL BE AWARE THAT A 8" WATER MAIN, 8" SEWER MAIN, AND OVERHEAD ELECTRIC LINE EXIST ALONG TANSY CANYON. IT IS THE RESPONSIBILITY OF THE CONTRACTOR TO HAVE THESE UTILITIES LOCATED PRIOR TO COMMENCING CONSTRUCTION. THE CONTRACTOR SHALL USE EXTREME CAUTION WHEN WORKING IN THIS AREA. ANY DAMAGE DONE TO THESE EXISTING FACILITIES WILL BE THE SOLE RESPONSIBILITY OF THE CONTRACTOR TO REPAIR.

# TRENCH EXCAVATION SAFETY PROTECTION

CONTRACTOR AND/OR CONTRACTOR'S INDEPENDENTLY RETAINED EMPLOYEE OR STRUCTURAL DESIGN/GEOTECHNICAL/SAFETY/EQUIPMENT CONSULTANT, IF ANY, SHALL REVIEW THESE PLANS AND AVAILABLE GEOTECHNICAL INFORMATION AND THE ANTICIPATED INSTALLATION SITE(S) WITHIN THE PROJECT WORK AREA IN ORDER TO IMPLEMENT CONTRACTOR'S TRENCH EXCAVATION SAFETY PROTECTION SYSTEMS, PROGRAMS AND/OR PROCEDURES FOR THE PROJECT DESCRIBED IN THE CONTRACT DOCUMENTS. THE CONTRACTOR'S IMPLEMENTATION OF THESE SYSTEMS, PROGRAMS AND/OR PROCEDURES SHALL PROVIDE FOR ADEQUATE TRENCH EXCAVATION SAFETY PROTECTION THAT COMPLY WITH AS A MINIMUM, OSHA STANDARDS FOR TRENCH EXCAVATIONS. SPECIFICALLY, CONTRACTOR AND/OR CONTRACTOR'S INDEPENDENTLY RETAINED EMPLOYEE OR SAFETY CONSULTANT SHALL IMPLEMENT A TRENCH SAFETY PROGRAM IN ACCORDANCE WITH OSHA STANDARDS GOVERNING THE PRESENCE AND ACTIVITIES OF INDIVIDUALS WORKING IN AND AROUND TRENCH EXCAVATION.

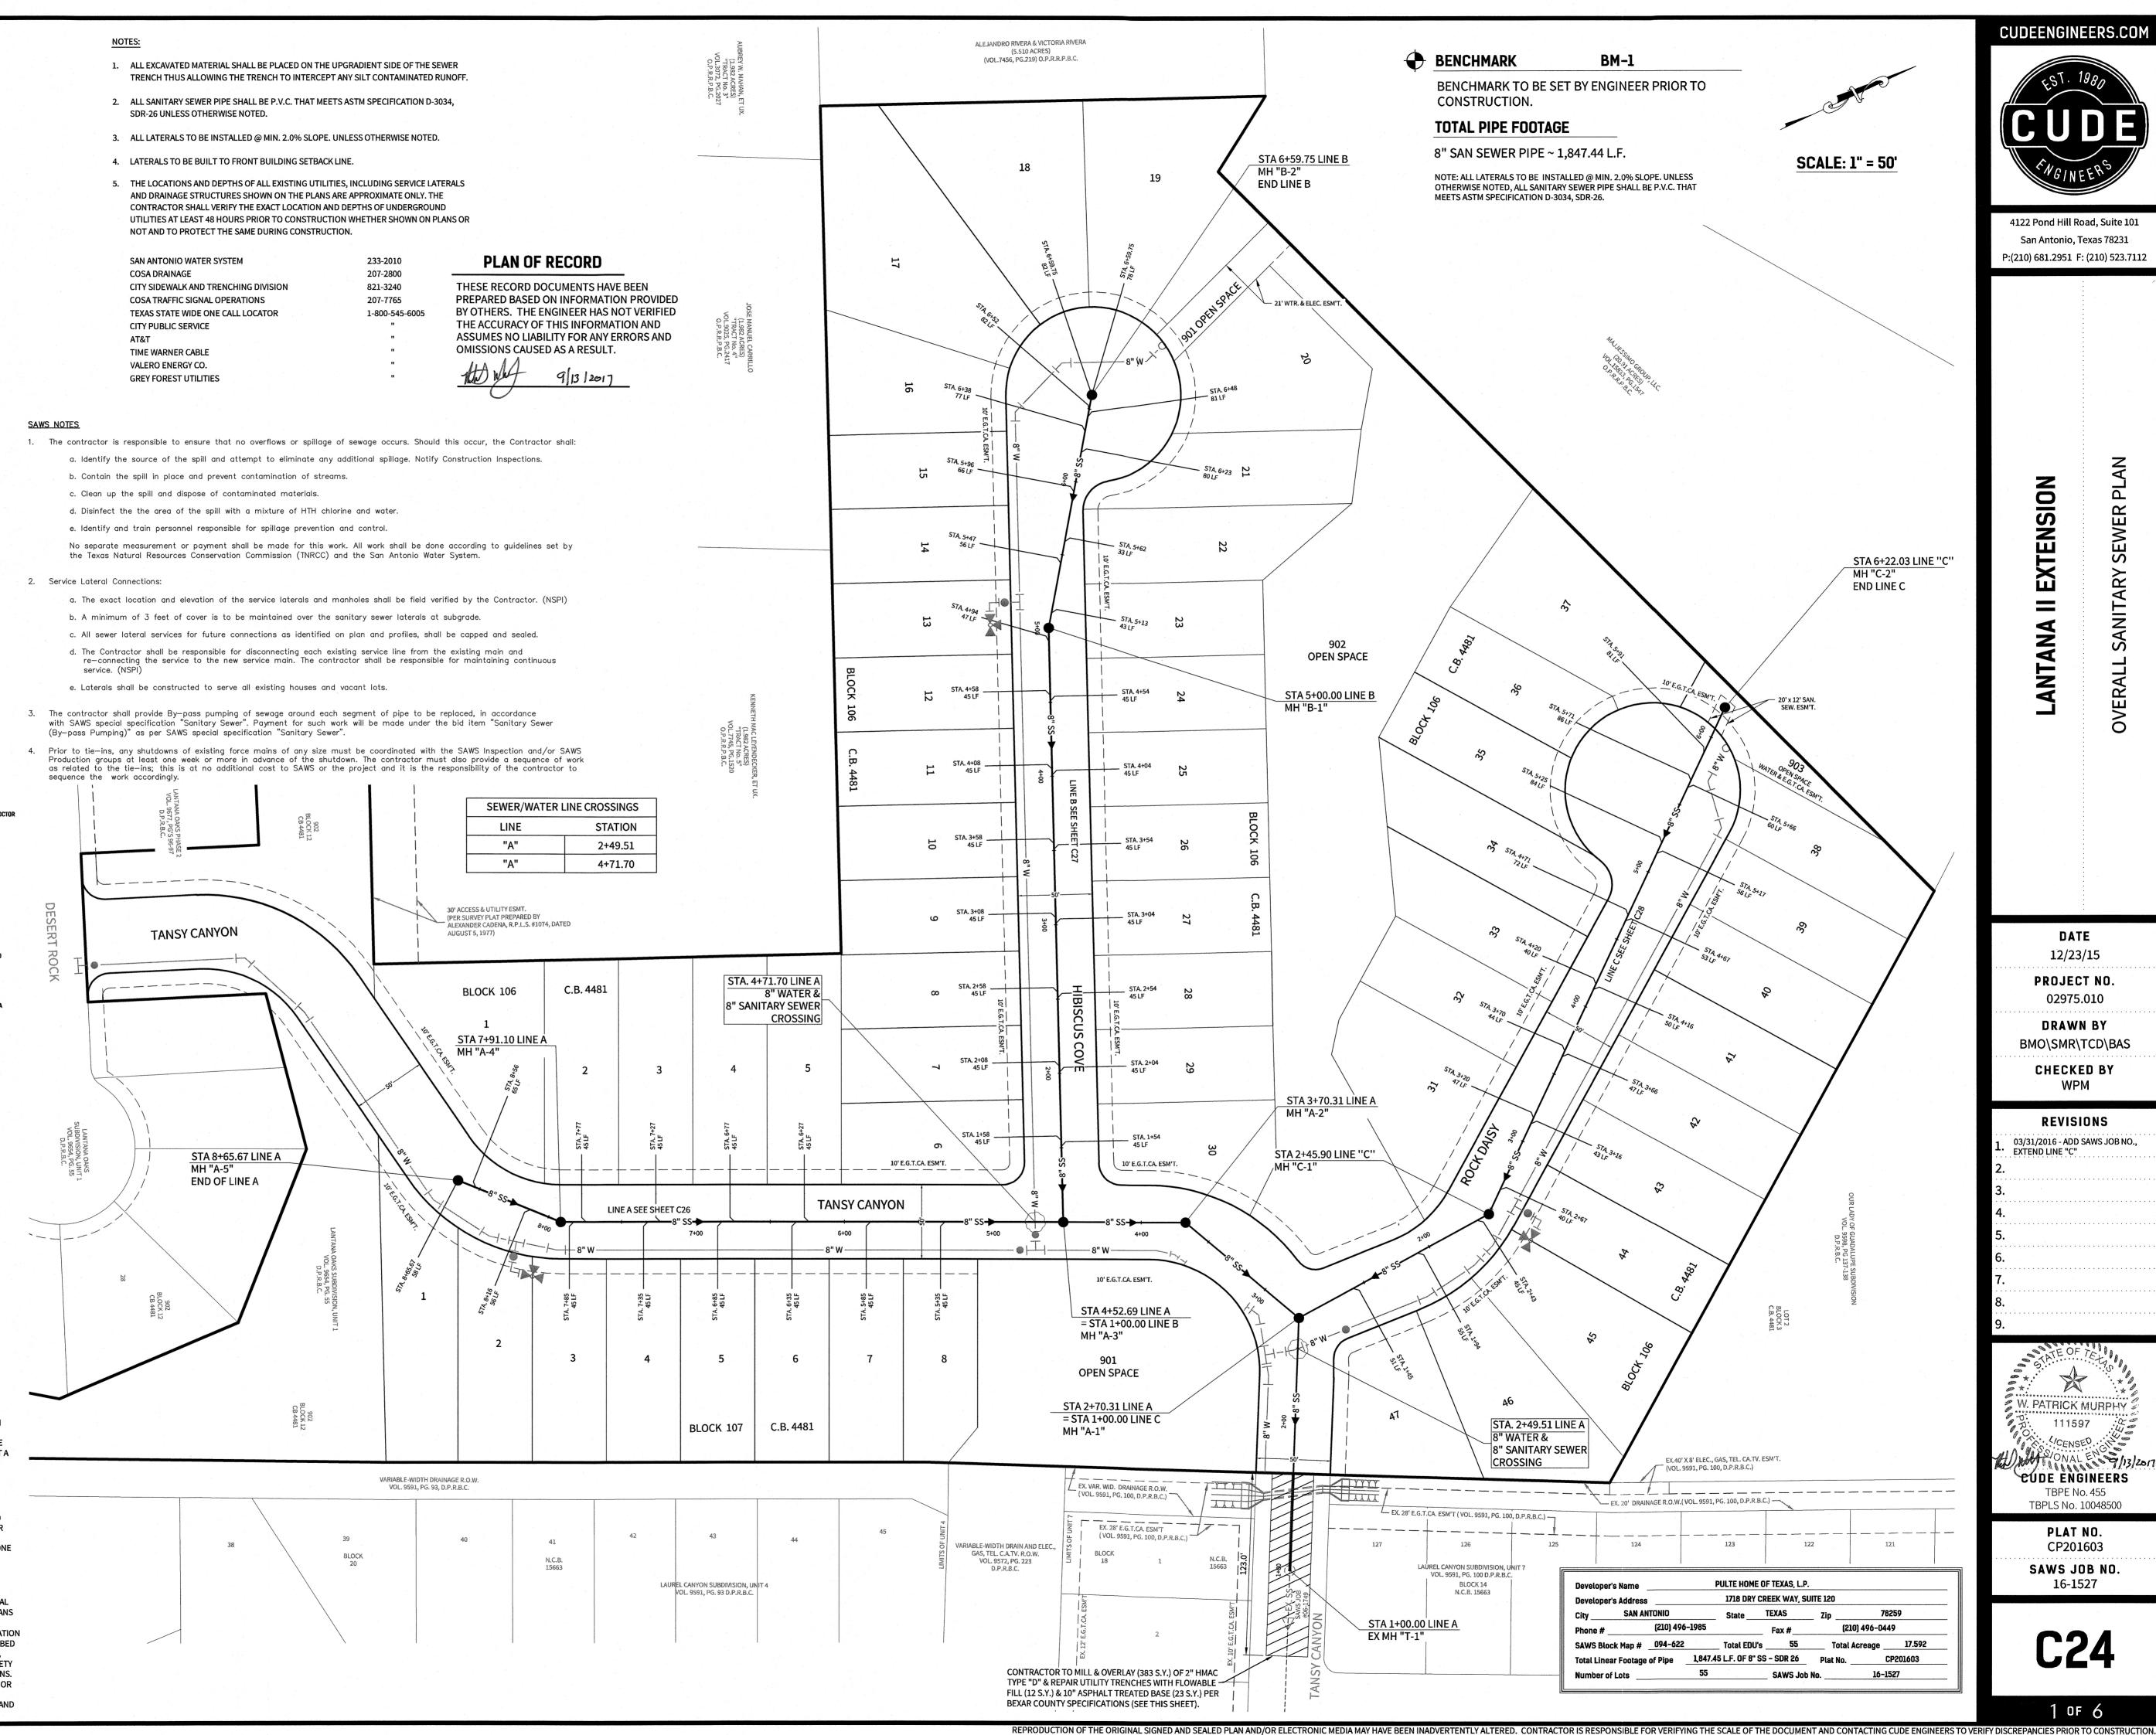

**CUDEENGINEERS.COM** 

4122 Pond Hill Road, Suite 101 San Antonio, Texas 78231 P:(210) 681.2951 F: (210) 523.7112

EXTENSION

12/23/15 PROJECT NO. 02975.010

DRAWN BY BMO\SMR\TCD\BAS

> CHECKED BY WPM

REVISIONS 03/31/2016 - ADD SAWS JOB NO., EXTEND LINE "C"

W. PATRICK MURPHY 111597 CENSED. CUDE ENGINEERS TBPE No. 455

> TBPLS No. 10048500 PLAT NO. CP201603

SAWS JOB NO. 16-1527

All materials and construction procedures within the scope of this contract shall be San Antonio Water System (SAWS) and comply with the plans, specifications, general conditions and with the following as applicable:

A. Current Texas Commission on Environmental Quality (TCEQ) "Design Criteria for Domestic Wastewater System", Texas Administrative Code (TAC) Title 30 Part 1 Chapter 217 and "Public Drinking Water", TAC

Title 30 Part 1 Chapter 290. B. Current Texas Department of Transportation (TXDOT) "Standard

E. Current City of San Antonio "Utility Excavation Criteria Manual".

with the inspector and consultant for the work requirements.

Specifications for Construction of Highways, Streets and Drainage." Current San Antonio Water System "Standard Specifications for Water

and Sanitary Sewer Construction."

D. Current City of San Antonio "Standard Specifications for Public Works Construction."

2. The Contractor shall not proceed with any pipe installation work until they obtain a copy of the approved G.C.P. from the Consultant and has been notified by SAWS Construction Inspection Division to proceed with the work and has arranged a meeting

The Contractor shall verify the exact location of underground utilities and drainage structures at least 48 hours prior to construction whether shown on plans or not. The following contact information are supplied for verification purposes:

San Antonio Water System 233-2010 COSA Drainage 207-2800 COSA Traffic Signal Operations 207-7765 State Wide One Call Locator 1-800-545-6005 City Public Service South Western Bell Time Warner Cable Valero Energy Co.

The Contractor shall be responsible for restoring to its original or better condition from damage done to existing fences, curbs, streets, driveways, landscaping and structures.

The Contractor shall avoid cutting roots larger than one inch in diameter when excavating near existing trees. Excavation in vicinity of trees shall proceed with caution. The Contractor shall contact the City Arborist at 207-8053 for guidance. SAWS Construction Inspector shall also be notified.

The Contractor shall maintain service to existing sanitary sewers at all times during

Due to Federal Regulations Title 49, Part 192.181, City Public Service must maintain access to gas valves at all times. The Contractor must protect and work around gas valves that are in the project areas.

All residential sewer service laterals shall be extended to the property line (or as

the satisfaction of the inspector.

specified on the plans) and capped and sealed. On all manholes to be abandoned, the rings and covers shall be salvaged in accordance with the most current San Antonio Water System's Standard Specification for

Construction, Item 101: Preparation of right-of-way. The hole should be backfilled to

approved by the

10. When allowable, blasting shall be performed in accordance with appropriate criteria established by the National Fire Protection Association [30 TAC 313.5(c)(6)].

Blasting for sewer line excavation must be done in such a manner as to minimize the 11. fracturing of rock beyond the required excavation. The Contractor shall consider the elevation of the existing sanitary sewer main in relation to the blasting charge and the relative direction of existing and proposed trenches. Blasting within such areas shall be accomplished only by qualified blasting contractors who hold blasting licenses from a qualified agency such as the San Antonio Fire Department in Bexar County. Any damage to existing sanitary sewers resulting from blasting shall be repaired and retested by the contractor at his own expense.

No blasting shall be performed within 75 feet of existing utilities.

12. After construction, testing will be done by TV camera by the Contractor and observed by Inspector, and Wastewater Engineering personnel, as the camera is run through the lines.

Any abnormalities, such as broken pipe or misaligned joints, must be replaced by the Contractor at his expense. Contractor to provide TV tapes to Construction Inspection for review prior to final inspection of the project.

**EXCAVATION** 

14. Contractor and/or Contractor's independently retained employee or structural design/geotechnical/safety/equipment consultant, if any, shall review these plans and available geotechnical information and the anticipated installation site(s) within the project work area in order to implement Contractor's trench excavation safety protection systems, programs and/or procedures. The Contractor's implementation of the systems, programs and/or procedures shall provide for adequate trench excavation safety protection that complies with as a minimum, OSHA Standards for trench excavations. Specifically, Contractor and/or Contractor's independently retained employee or safety consultant shall implement a trench safety program in accordance with OSHA Standards governing the presence and activities of individuals working in and around trench

The Contractor shall not place any waste materials or spoils in the 100-year flood plain without first obtaining an approved Flood Plain Permit.

Water jetting the backfill within a street will not be permitted. Sanitary sewer trenches subject to traffic shall conform to the S.A.W.S. Standard Specifications for Construction,

Item No. 550 & 804.

## WATER LINE CROSSING

17. Where the minimum 9 foot separation distance between sewer lines and water lines/mains cannot be maintained, the installation of sewer lines shall be in strict accordance with the Texas Natural Resourse Conservation Commission's Rules ([30 TAC 217.53(d) & 30 TAC 290.44 (e)]).

EROSION AND SEDIMENTATION CONTROL

18. The Texas Commission on Environmental Quality and Environmental Protection Agency (EPA) require erosion and sedimentation control for construction of sewer collection systems. Developer or authorized representative shall provide erosion and sedimentation control as notes on the project's plan and profile sheets.

All temporary erosion and sedimentation controls shall be removed by the Contractor 19. at final acceptance of the project by the San Antonio Water System.

SUPPLEMENTARY

20. No extra-payment shall be allowed for work called for on the plans but not included on the bid schedule. This incidental work will be required and shall be included under the pay item to which it relates.

21. The Developer dedicates the sanitary sewer mains upon completion by the Developer and acceptance by the San Antonio Water System. The San Antonio Water System will own and maintain said sanitary sewer mains which are located within this particular subdivision. (As applicable)

The Developer will be responsible for the lift station maintenance fee in effect at the 22. time of certification. The current maintenance fee per lift station will be collected prior to plat recordation.

All PVC Sewer Pipe with over 14 feet of cover shall be extra strength pipe, Minimum Stiffness of 115 PSI.

WORK COMPLETED BY THE CONTRACTOR WHICH HAS NOT RECEIVED A WORK ORDER OR THE NOTICE TO PROCEED WITH THE SAN ANTONIO WATER SYSTEM CONSTRUCTION INSPECTION DIVISION WILL BE SUBJECT TO REMOVAL AND REPLACEMENT BY AND AT THE EXPENSE OF THE CONTRACTOR.

SAN ANTONIO WATER SYSTEM CRITERIA FOR SEWER MAIN CONSTRUCTION IN THE VICINITY OF WATER MAINS

I. WHERE A SEWER MAIN CROSSES OVER A WATER MAIN AND THE SEPARATION DISTANCE IS LESS THAN NINE (9) FEET. ALL PORTIONS OF THE SEWER MAIN WITHIN NINE (9) FEET OF THE WATER LINE SHALL BE CONSTRUCTED USING 150 psi Pressure rated ductile Iron, cast Iron or PVC PIPE and Joined with EQUALLY PRESSURE RATED PRESSURE RING GASKET CONNECTIONS OR CORROSION PROTECTED MECHANICAL COUPLING DEVICES OF A CAST IRON OR DUCTILE IRON MATERIAL. A SECTION FO 150 psi PRESSURE RATED PIPE AT LEAST EIGHTEEN (18) FEET IN LENGTH MAY BE CENTERED ON THE WATER MAIN IN LIEU OF PIPE CONNECTION REQUIREMENTS. (NO SEPARATE PAY ITEM)

II. WHERE A SEMI-RIGID OR RIGID SEWER MAIN CROSSES UNDER A WATER MAIN AND THE SEPARATION DISTANCE IS LESS THAN NINE FEET BUT GREATER THAN TWO FEET, THE INITIAL BACKFILL SHALL BE CEMENT STABILIZED SAND (TWO OR MORE BAGS OR CEMENT PER CUBIC YARD OF SAND) FOR ALL SECTIONS OF THE SEWER WITHIN NINE FEET OF THE WATER MAIN.


III. WHERE A SEWER MAIN CROSSES UNDER A WATER MAIN AND THE SEPARATION DISTANCE IS LESS THAN TWO FEET, THE SEWER MAIN SHALL BE CONSTRUCTED OF CAST IRON, DUCTILE IRON, OR PVC WITH A MINIMUM PRESSURE RATING OF 150 PSI WITHIN NINE FEET OF THE WATER MAIN, SHALL BE PLACED NO CLOSER THAN SIX INCHES BETWEEN OUTER DIAMETERS, AND SHALL BE JOINED WITH PRESSURE RING GASKET CONNECTIONS OR CORROSION PROTECTED MECHANICAL COUPLING DEVICES OR A CAST IRON OR DUCTILE IRON MATERIAL. A SECTION OF 150 psi PRESSURE RATED PIPE OF A LENGTH GREATER THAN EIGHTEEN (18) FEET MAY BE CENTERED ON THE WATER MAIN IN LIEU OF PIPE CONNECTION REQUIREMENTS. (NO SEPARATE PAY ITEM)

IV. WHERE A SEWER MAIN PARALLELS A WATER MAIN AND THE SEPARTION DISTANCE IS LESS THAN NINE FEET, THE SEWER MAIN SHALL BE BELOW THE WATER MAIN, SHALL BE CONSTRUCTED OF CAST IRON, DUCTILE IRON, OR PVC WITH A MINIMUM PRESSURE RATING OF 150 PSI FOR BOTH PIPE AND JOINTS FOR A DISTANCE OF NINE FEET BEYOND THE POINT OF CONFLICT, SHALL MAINTAIN A MINIMUM SEPARATION DISTANCE BETWEEN OUTER DIAMETERS OF TWO FEET VERTICALLY AND FOUR FEET HORIZONTALLY, AND SHALL BE JOINED WITH PRESSURE RING GASKET CONNECTIONS OR CORROSION PROTECTED MECHANICAL COUPLING DEVICES OF A CAST IRON OR DUCTILE IRON MATERIALS.

V. SANITARY SEWER MANHOLES SHALL NOT BE INSTALLED ANY CLOSER THAN NINE FEET TO WATER MAINS.

V.I. PLAN & PROFILE MUST SHOW TYPE OR CROSSING AND MATERIAL TO USE.

STEEL FENCE POST MAX. 8' SPACING WOVEN WIRE FABRI (HOG WIRE) 12 GA. FABRIC TOE-IN SILT FENCE DETAIL

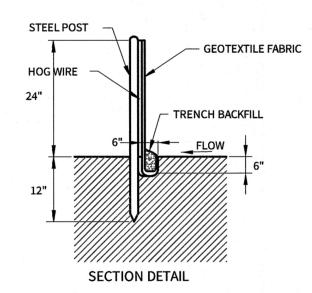

STEEL FENCE POST

@ 10'-0" O.C.

**EXISTING** 


PLAN

General Notes

1. Steel posts which support the silt fence shall be installed on a slight angle toward the anticipated runoff source. Post must be embedded a minimum of one foo 2. The toe of the silt fence shall be trenched in with a spade or mechanical trencher, so that the downslope face of the trench is flat and perpendicular to the line of flow. Where fence cannot be trenched in (e.g. pavement) weight fabric flap with washed gravel on uphill side to prevent flow under fence. a. The trench must be a minimum of 6 inches deep and 6 inches wide to allow for the silt fence fabric to be laid in the ground and backfilled with compacted material 4. Silt fence should be securely fastened to each steel support posts or to woven wire, which is in turn attached to the steel fence post 5. Inspection shall be made weekly or after each rainfall event and repair or replacement shall be made promptly as needed.


6. Silt fence shall be removed when the site is completely stabilized so as not to block or impede storm flow or drainage 7. Accumulated silt shall be removed when it reaches a depth of 6 inches. The silt shall be disposed of in an approved site and in such a manner as to not contribute to additional siltation

# SILT FENCE DETAIL

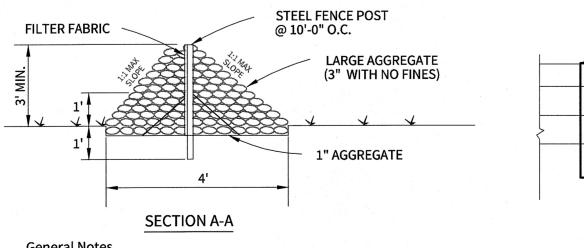

1. The rock berm shall be inspected weekly or after each rain and the stone shall be replaced when the structure ceases to function as intended due to silt accumulation, washout, etc.

2. When silt reaches a depth of 12", the silt shall be removed and disposed of at an approved site. ROCK BERM W/ SILT FENCE DETAIL

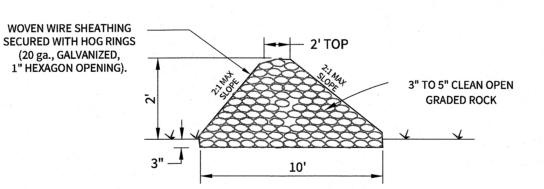


**General Notes** 

1. The rock berm shall be secured with a woven wire sheathing having maximum 1 inch opening and minimum wire diameter of 20 gauge.

2. The rock berm shall be inspected weekly or after each rain, and the stone and/or fabric core-woven wire sheathing shall be replaced when ne structure ceases to function as intended, due to silt accumulation among the rocks, washout, construction traffic damage, etc. 3. When silt reaches a depth equal to 6", it shall be removed and disposed of at an approved site and in a manner as to not create a siltation 4. When the site is completely stabilized, the berm and accumulated silt shall be removed and disposed of in an approved manner


# **ROCK BERM DETAIL**

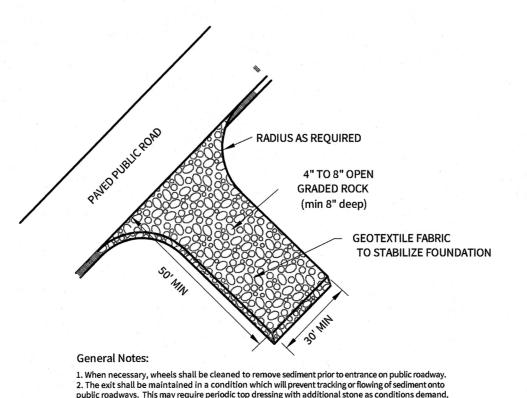


**TEMPORARY CONSTRUCTION ENTRANCE/EXIT DETAIL** 

and repair and/or clean-out of any measures used to trap sediment. All sediment spilled, dropped,

washed, or tracked onto public roadways must be removed immediately

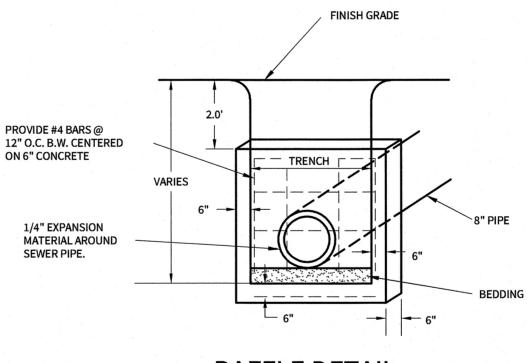

# **BAFFLE DETAIL**

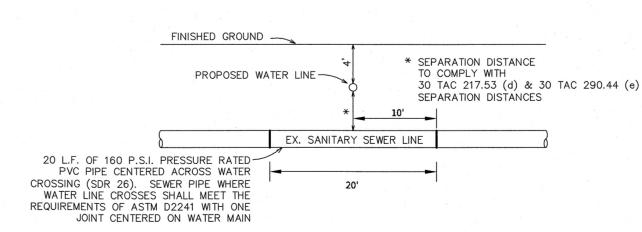

SANITARY SEWER / WATER LINE **CROSSING DETAIL** N.T.S.

TRENCH EXCAVATION SAFETY PROTECTION

CONTRACTOR AND/OR CONTRACTOR'S INDEPENDENTLY RETAINED EMPLOYEE OR STRUCTURAL DESIGN/GEOTECHNICAL/SAFETY/EQUIPMENT CONSULTANT, IF ANY, SHALL REVIEW THESE PLANS AND AVAILABLE GEOTECHNICAL INFORMATION AND THE ANTICIPATED INSTALLATION SITE(S), WITHIN THE PROJECT WORK AREA IN ORDER TO IMPLEMENT CONTRACTOR'S TRENCH EXCAVATION SAFETY PROTECTION SYSTEMS, PROGRAMS AND/OR PROCEDURES FOR THE PROJECT DESCRIBED IN THE CONTRACT DOCUMENTS. THE CONTRACTOR'S IMPLEMENTATION OF THESE SYSTEMS, PROGRAMS AND/OR PROCEDURE SHALL PROVIDE FOR ADEQUATION THE SEASON TO SHARP THE CONTRACTOR'S IMPLEMENTATION OF THESE SYSTEMS, PROGRAMS AND/OR PROCEDURE SHALL PROVIDE FOR ADEQUATION THE CONTRACTOR OF THE SEASON SPECIFICALLY, CONTRACTOR AND /OR CONTRACTOR'S INDEPENDENTLY RETAINED EMPLOYEE OR SAFETY CONSULTANT SHALL IMPLEMENT A TRENCH SAFETY PROGRAM IN ACCORDANCE WITH OSHA STANDARDS GOVERNING THE PRESENCE AND ACTIVITIES OF INDIVIDUALS WORKING IN AND AROUND TRENCH EXCAVATION

**PLAN OF RECORD** 

OMISSIONS CAUSED AS A RESULT.

THESE RECORD DOCUMENTS HAVE BEEN

PREPARED BASED ON INFORMATION PROVIDED

BY OTHERS. THE ENGINEER HAS NOT VERIFIED

THE ACCURACY OF THIS INFORMATION AND ASSUMES NO LIABILITY FOR ANY ERRORS AND

Developer's Name		PULTE HOME OF	TEXAS, L.P.			
Developer's Address		1718 DRY CR	EEK WAY, SUITE	120		
City SAN ANTO	NIO	State	TEXAS	Zip	78259	
Phone #	210) 496-1985		Fax #	(2:	10) 496-0449	
SAWS Block Map #		Total EDU's	55	Total	Acreage17.592	
Total Linear Footage of	Pipe 1,847.	45 L.F. OF 8" SS	- SDR 26	Plat No.	CP201603	
Number of Lots	55	В.	SAWS Job No.		16-1527	
				1, 1		

**CUDEENGINEERS.COM** 

4122 Pond Hill Road, Suite 101 San Antonio, Texas 78231 P:(210) 681.2951 F: (210) 523.7112

NOT

**XTENSION** 

GENERAL S

12/23/15 PROJECT NO. 02975.010 DRAWN BY

BMO\SMR\TCD\BAS CHECKED BY

REVISIONS 03/31/2016 - ADD SAWS JOB NO.

2.													
3.													
4.													
5.													
6.													
7.		 			 	 					 		
8.													
9.		 			 	 					 	 	
		<b>60</b> h	R	,		ļ	Ų	B	17	â			


W. PATRICK MURPH


TBPE No. 455 TBPLS No. 10048500


PLAT NO. CP201603 SAWS JOB NO. 16-1527


2 OF 6


REPRODUCTION OF THE ORIGINAL SIGNED AND SEALED PLAN AND/OR ELECTRONIC MEDIA MAY HAVE BEEN INADVERTENTLY ALTERED. CONTRACTOR IS RESPONSIBLE FOR VERIFYING THE OCCUMENT AND CONTACTING CUDE ENGINEERS TO VERIFY DISCREPANCIES PRIOR TO CONSTRUCTION

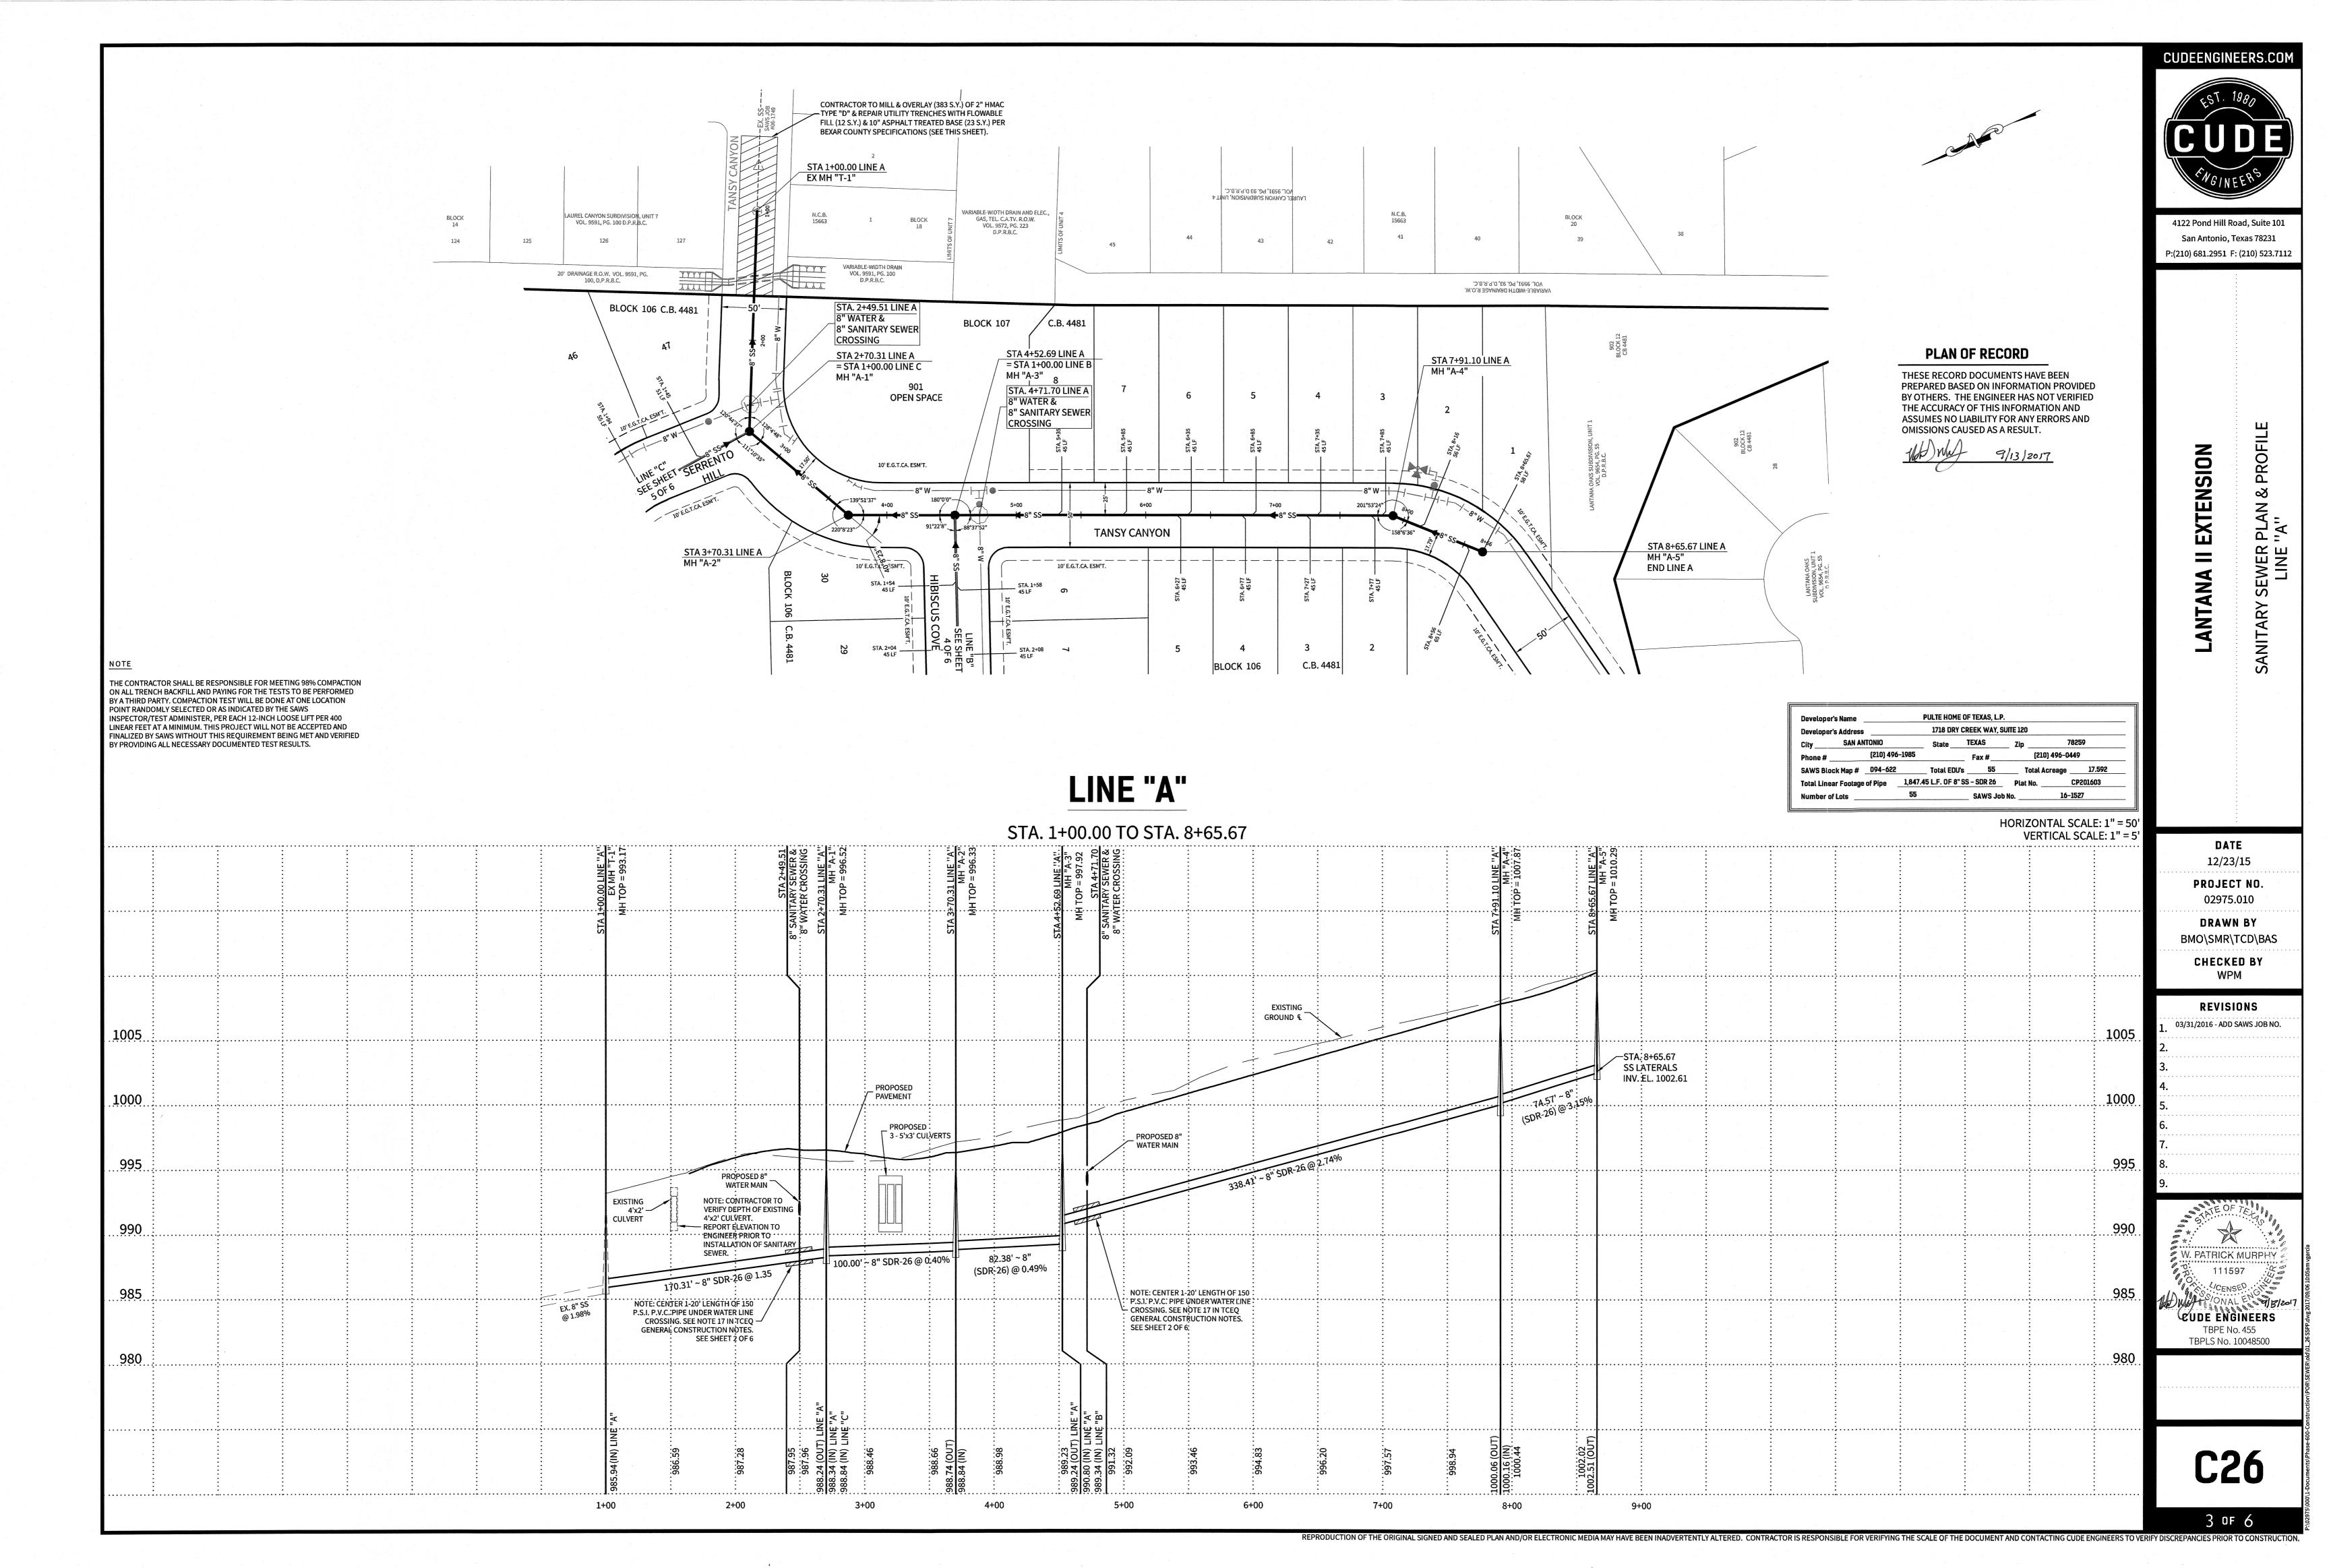


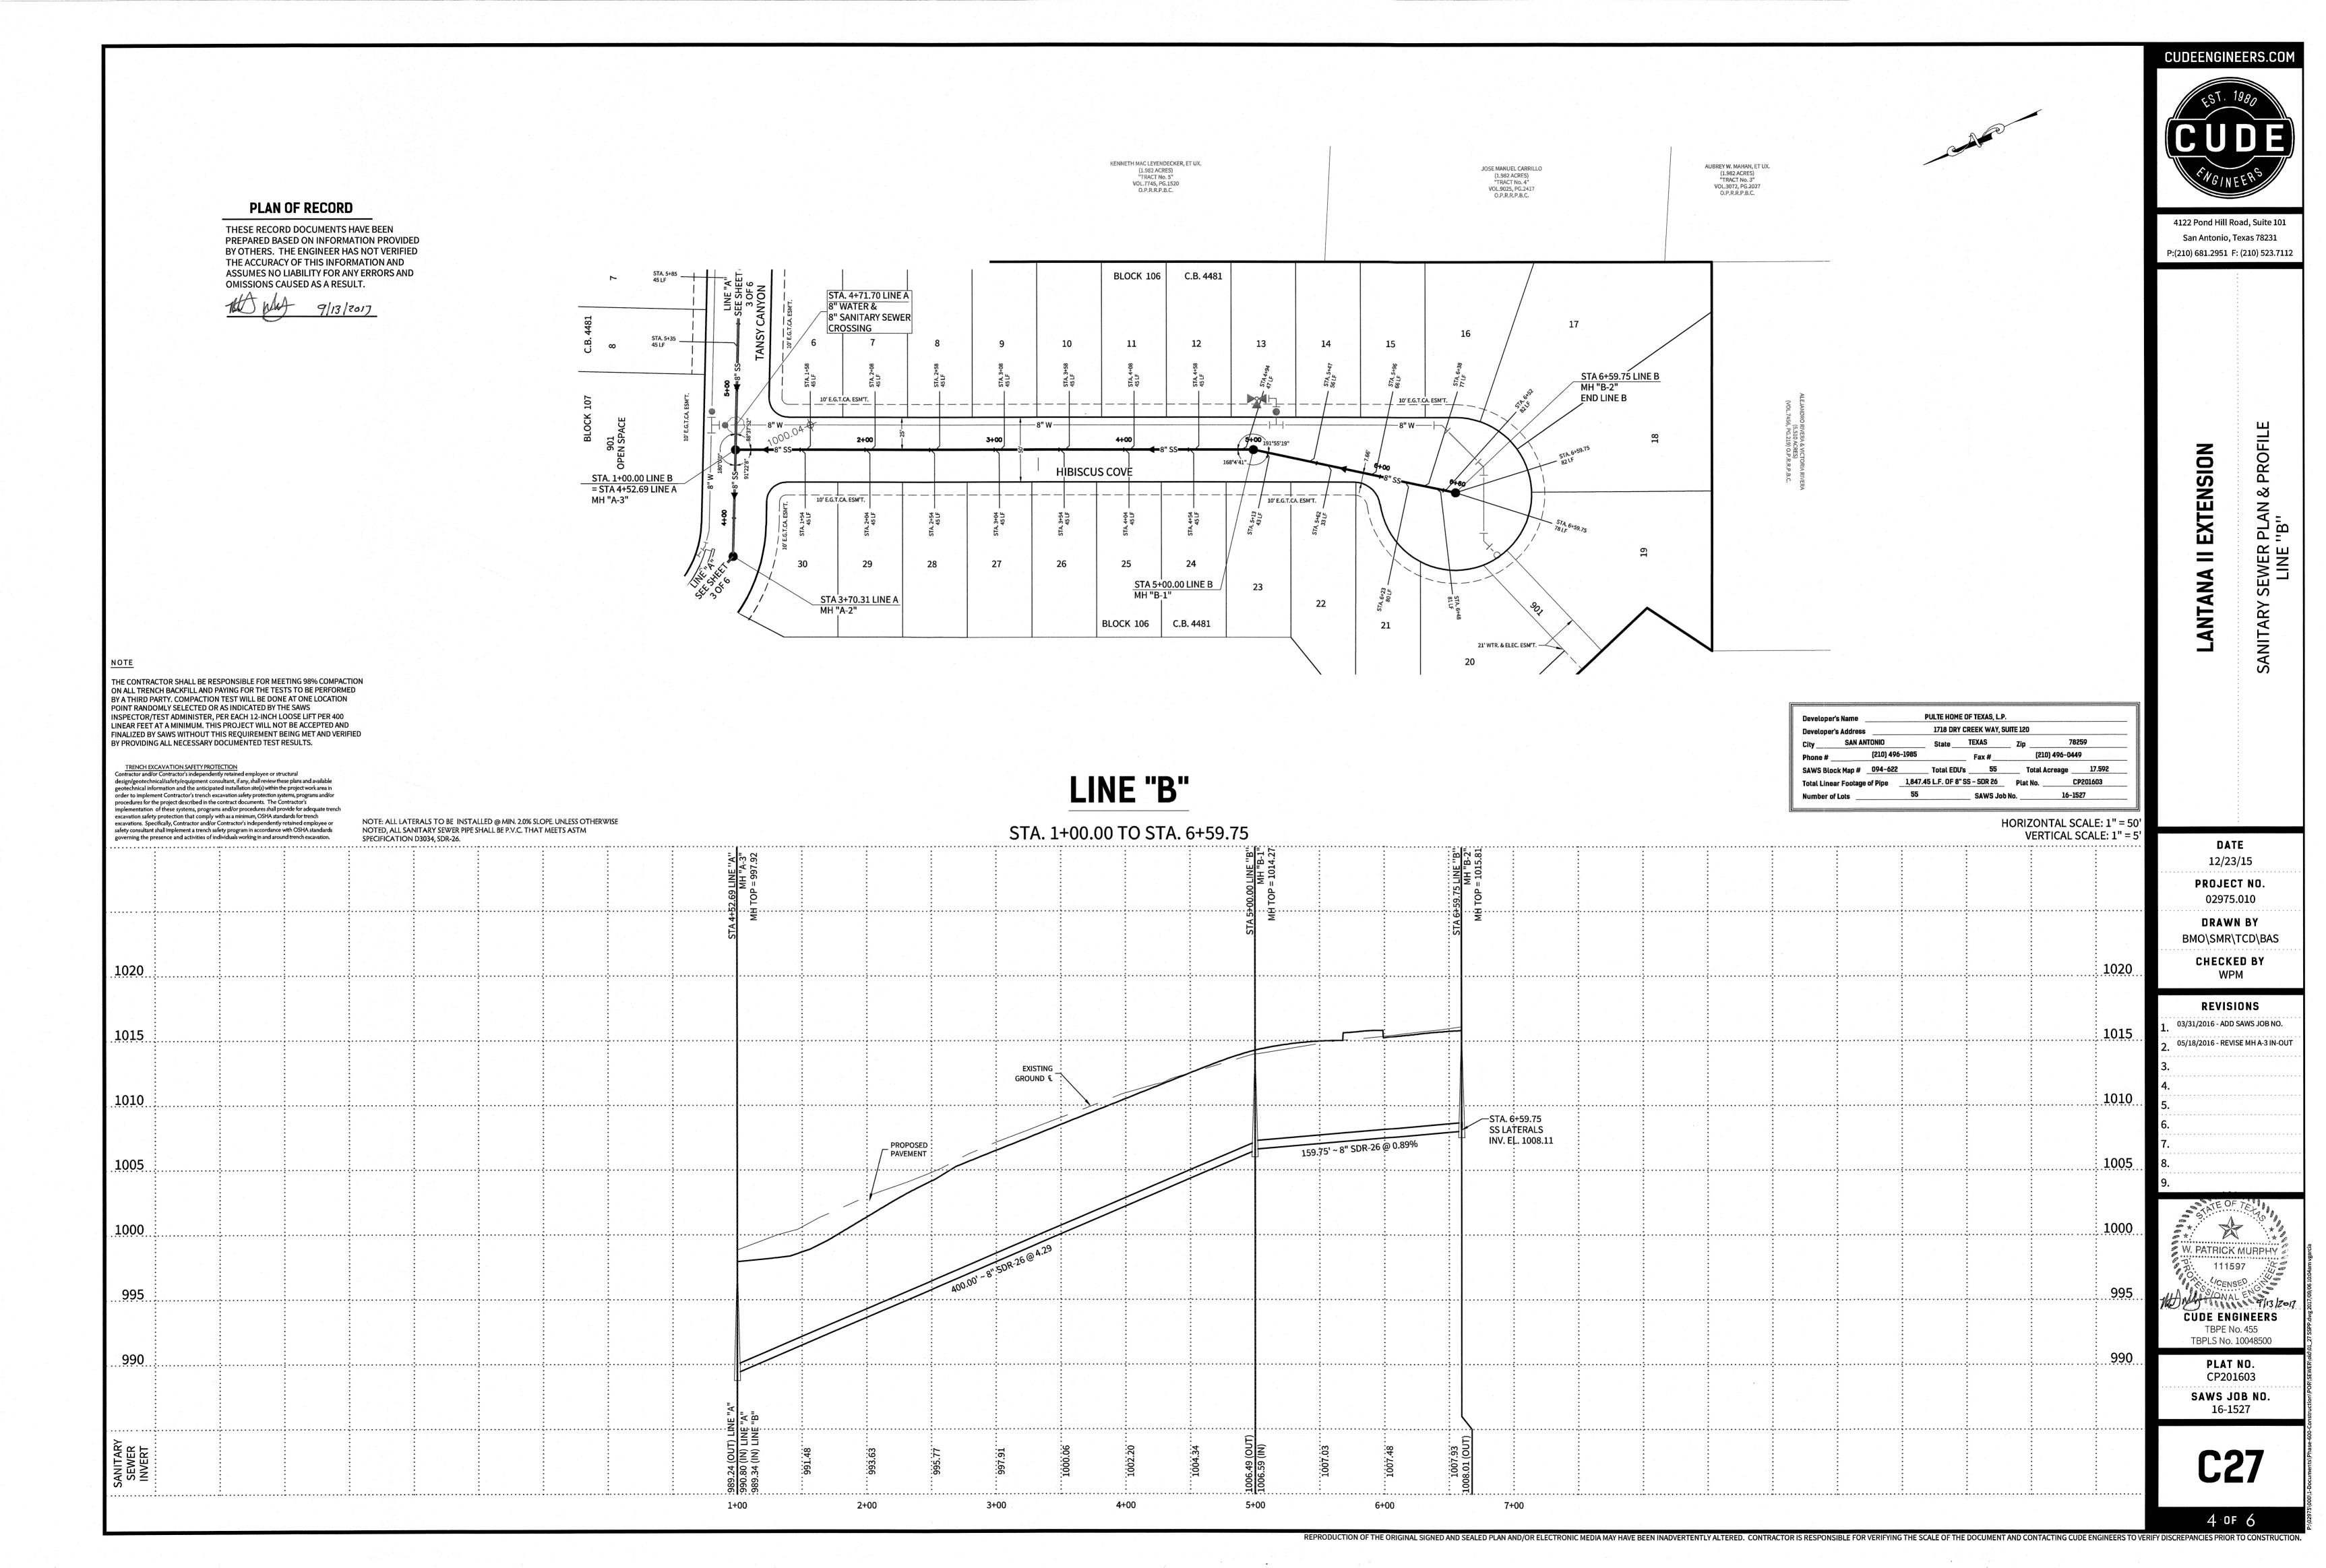


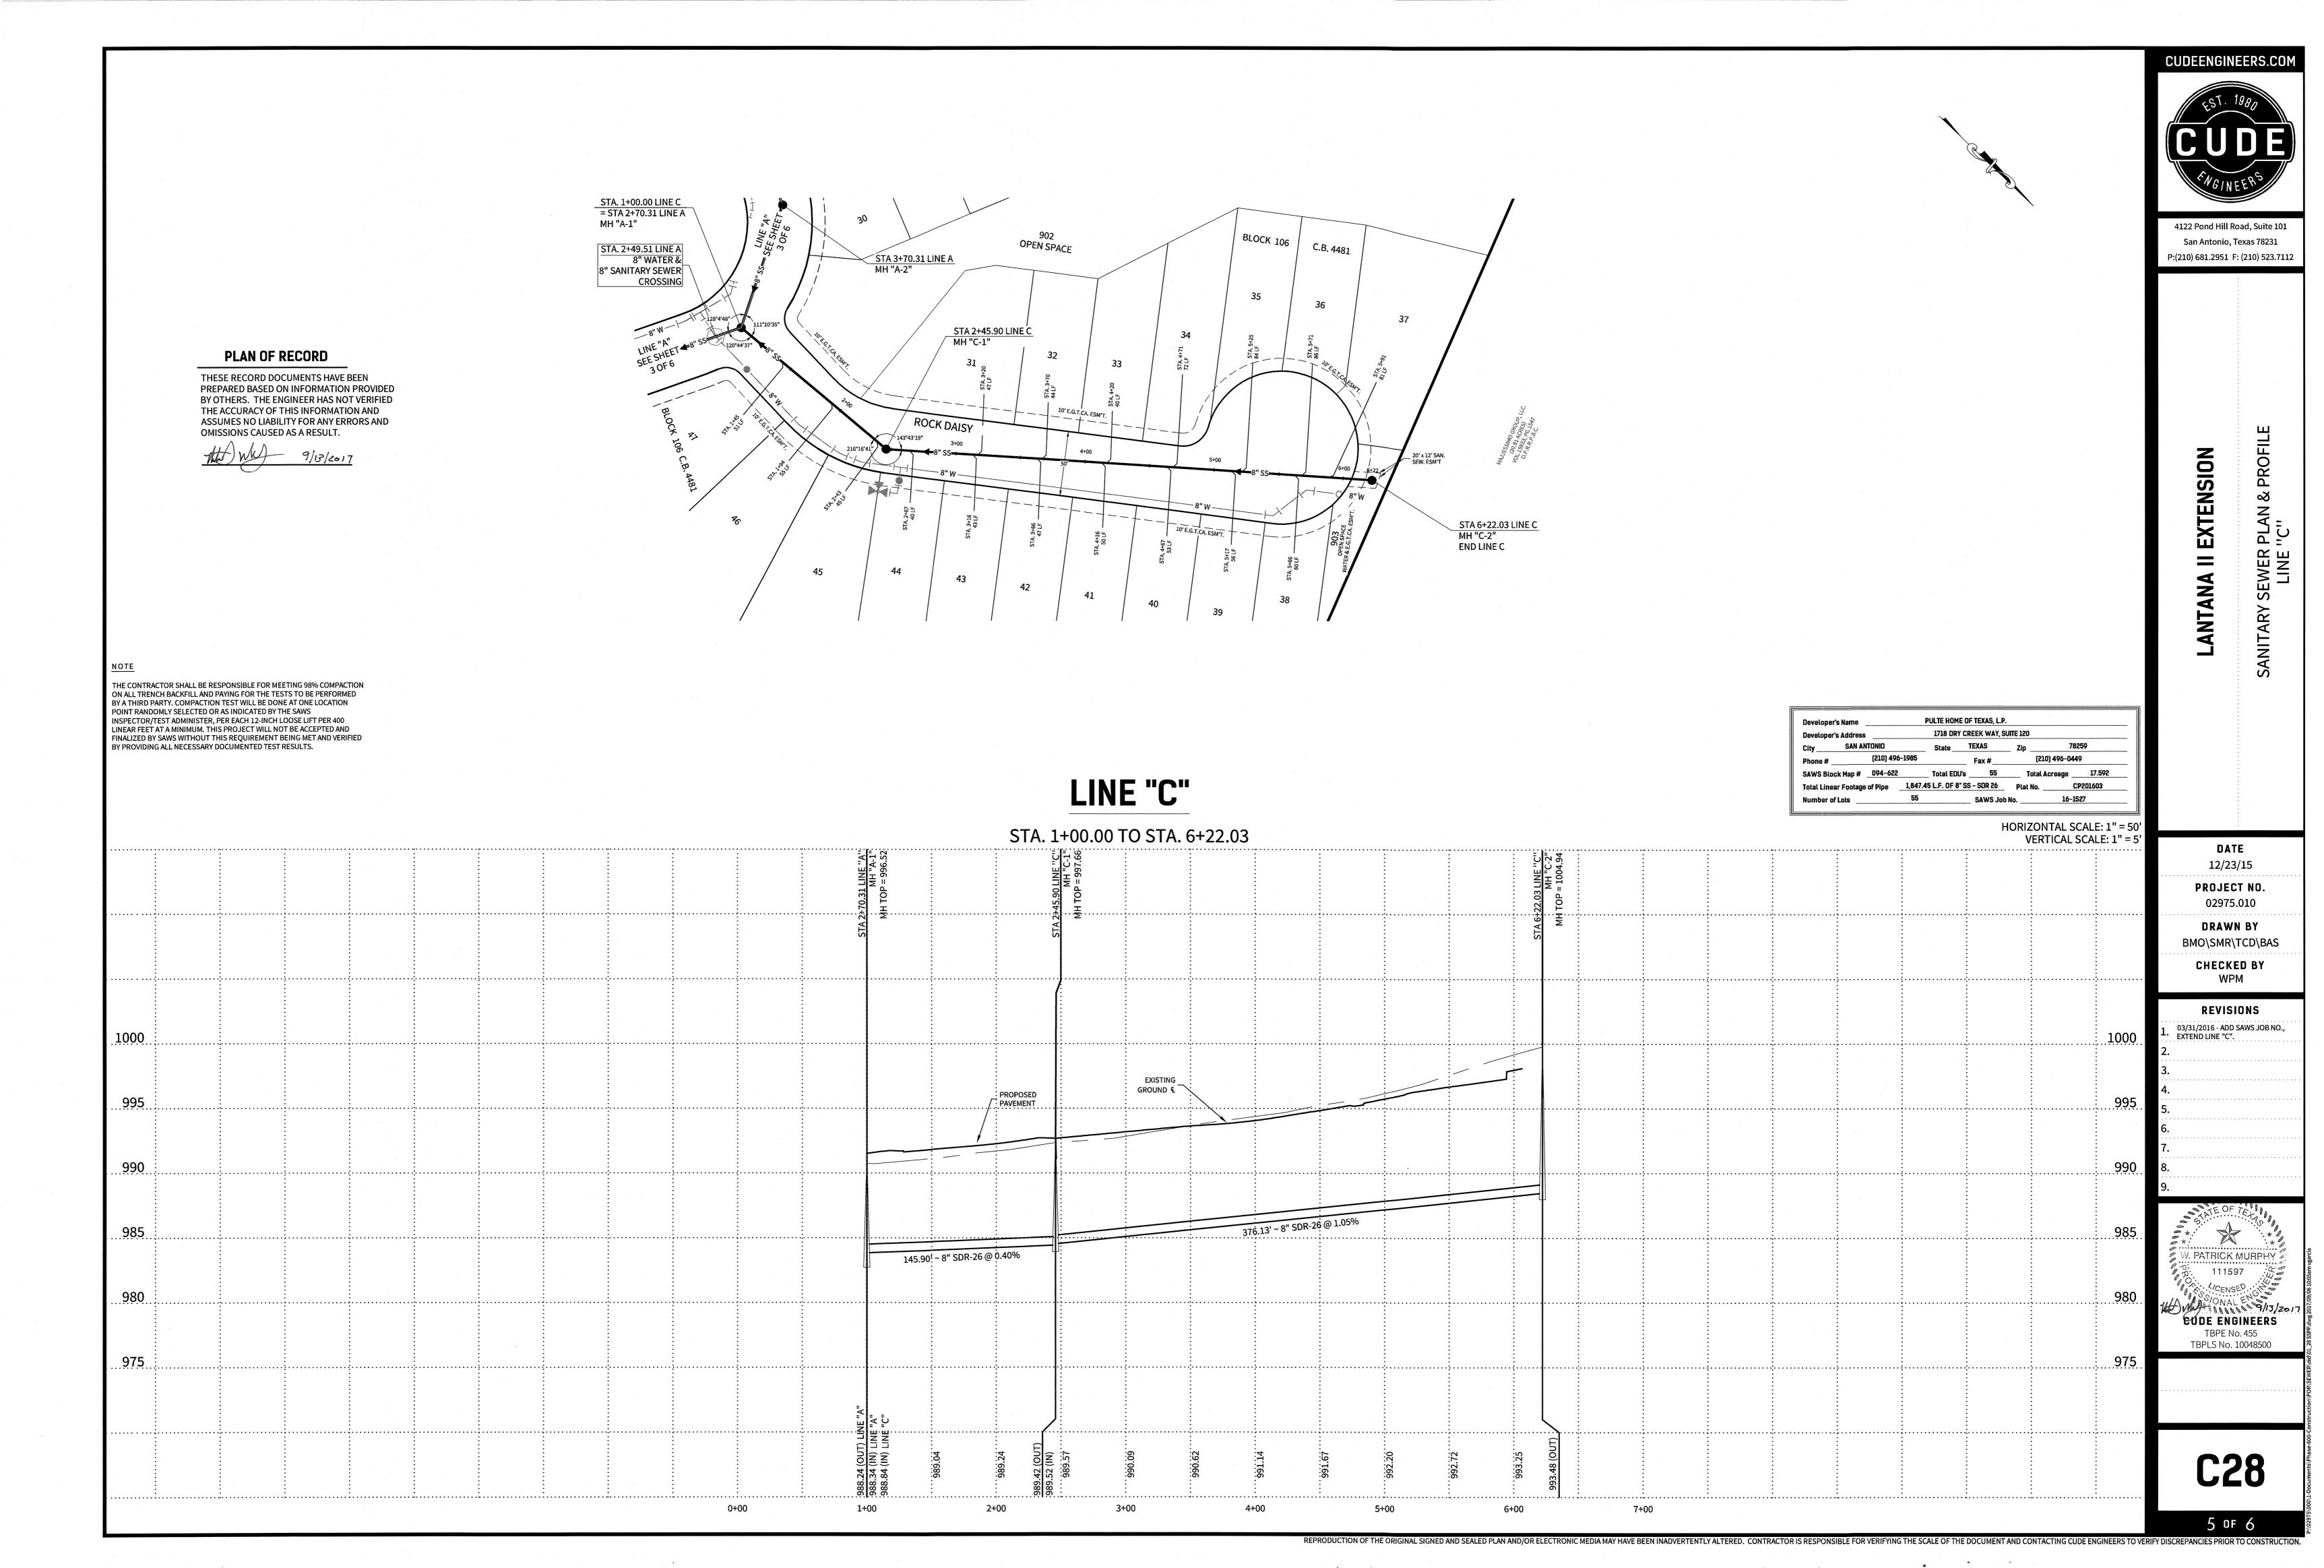


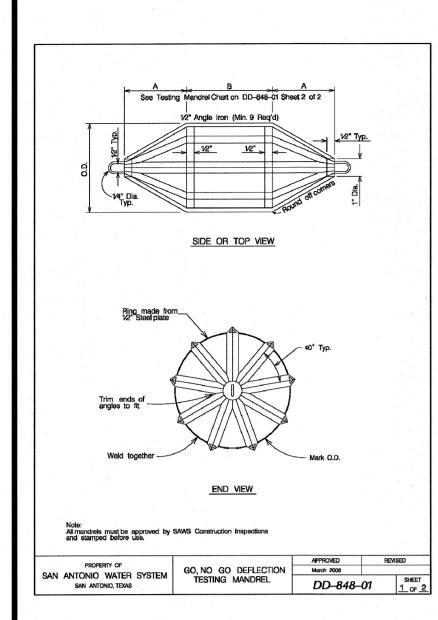


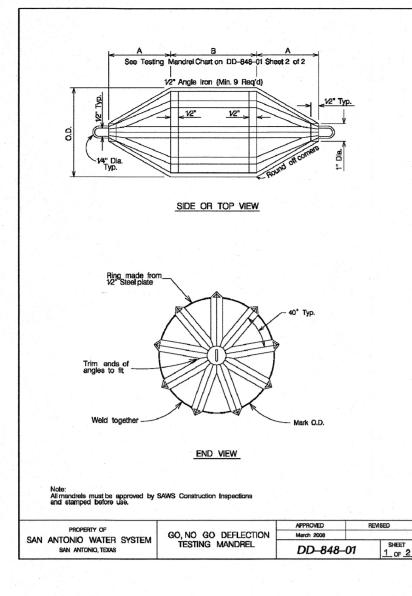


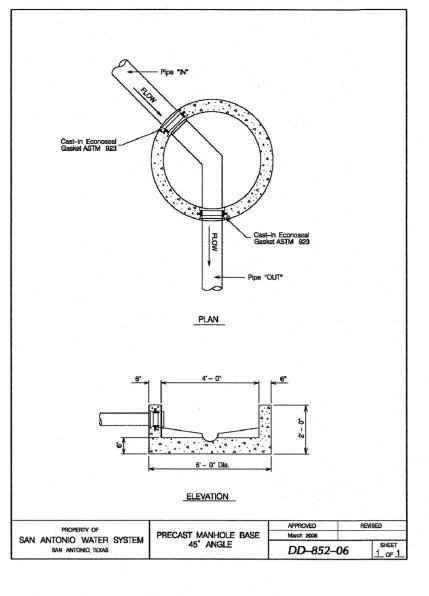


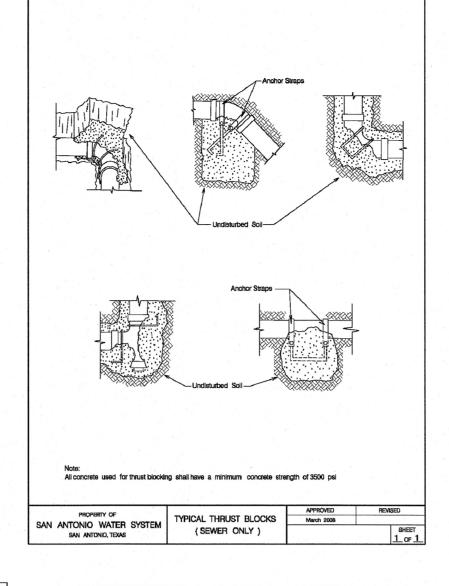


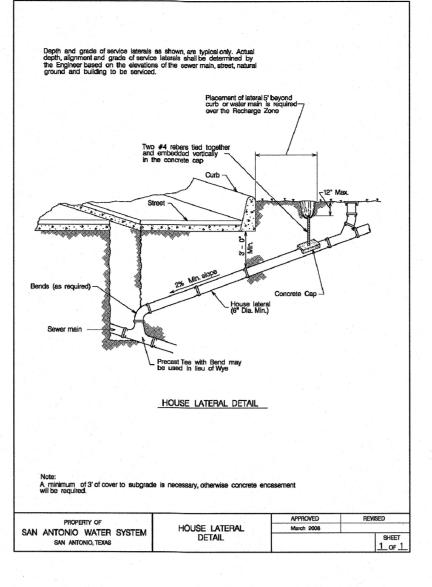


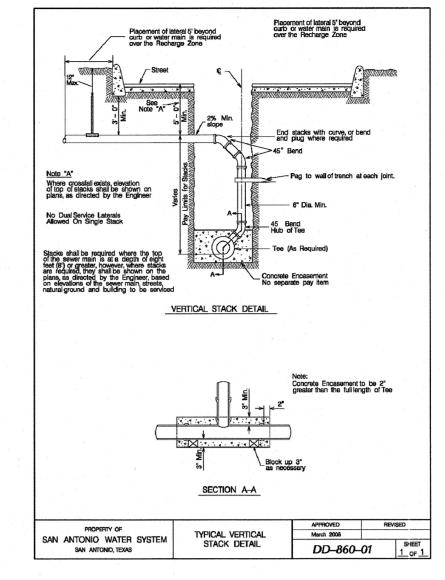


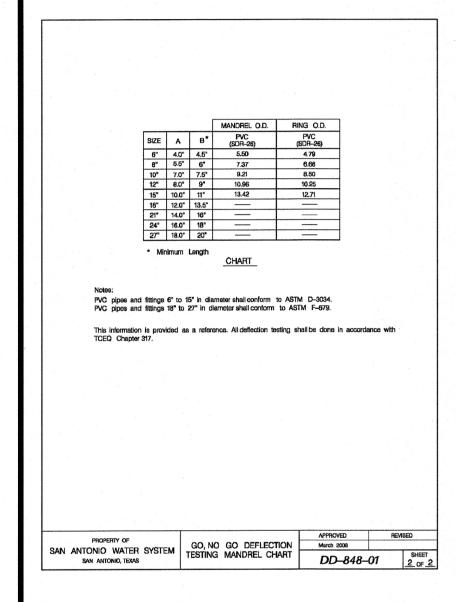


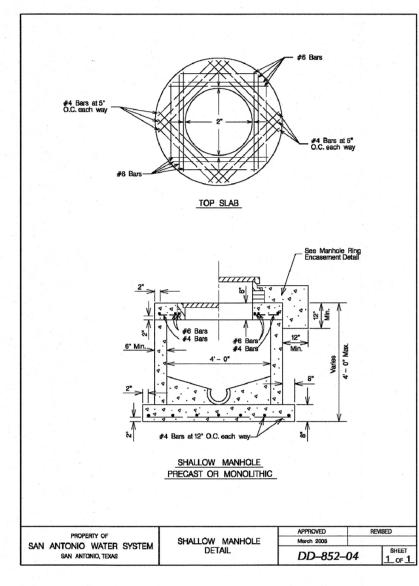


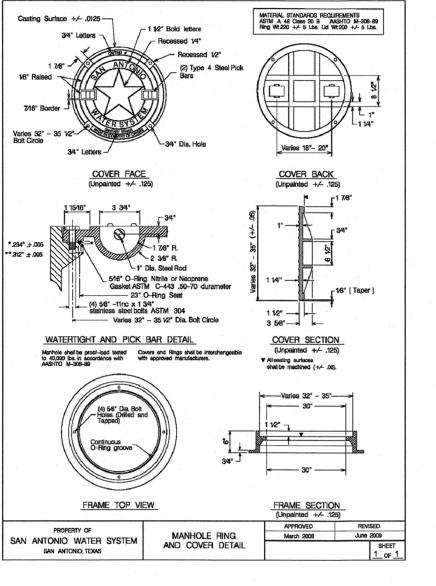


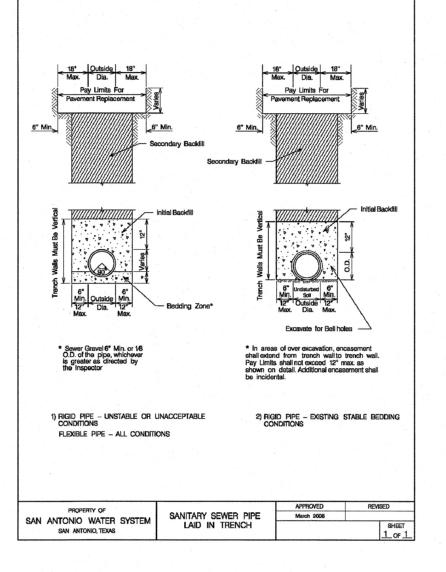


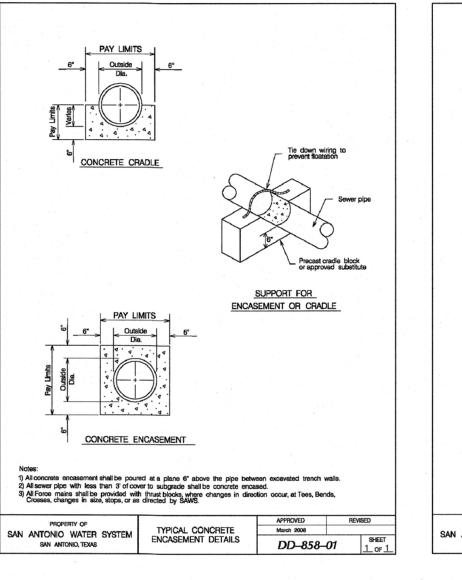


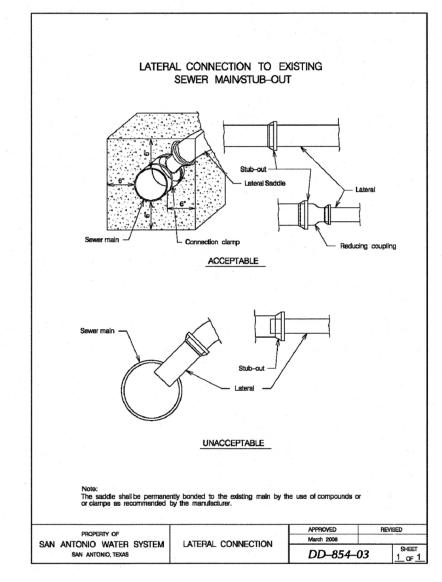


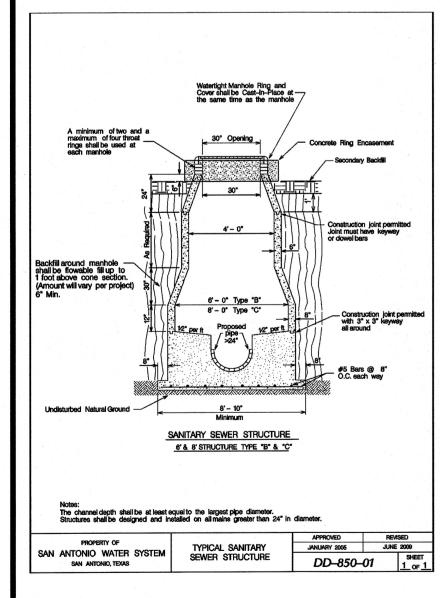


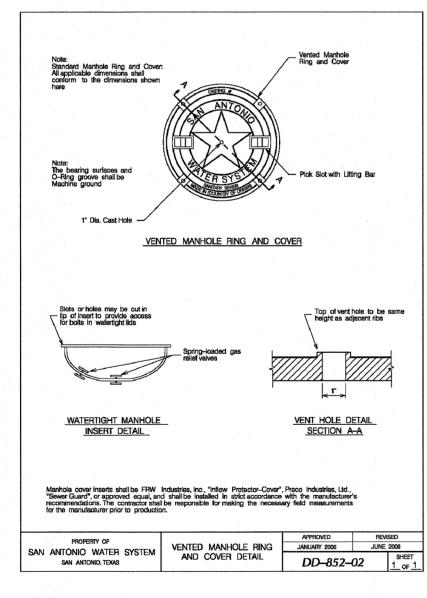


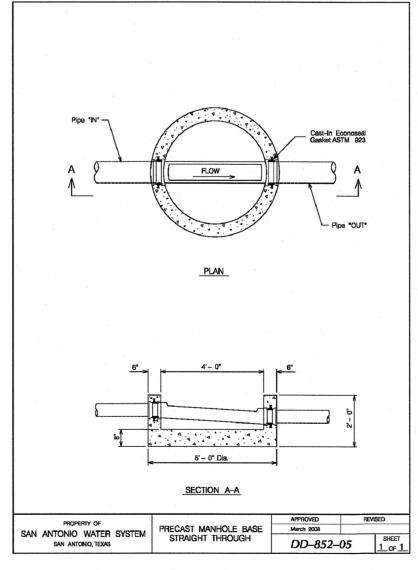

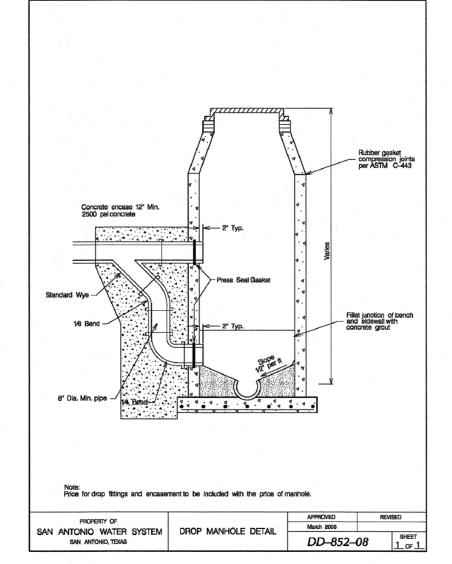

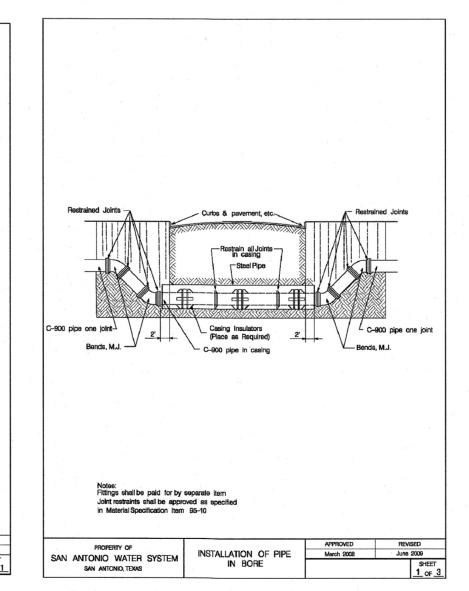

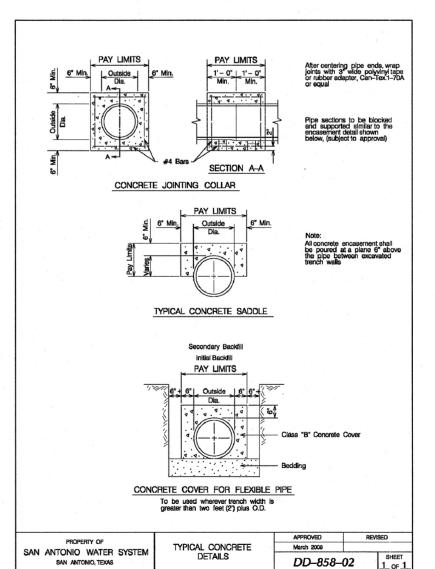

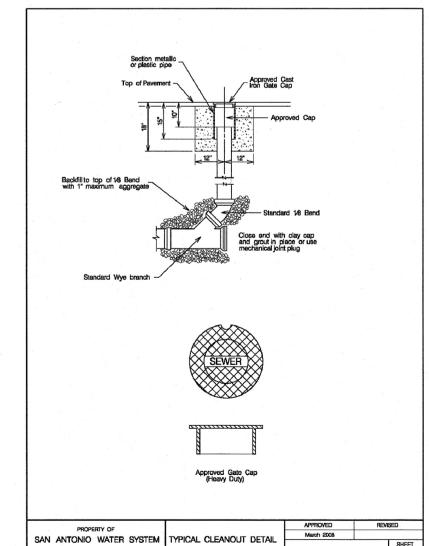

THE CONTRACTOR SHALL BE RESPONSIBLE FOR MEETING 98% COMPACTION ON ALL TRENCH BACKFILL AND PAYING FOR THE TESTS TO BE PERFORMED BY A THIRD PARTY. COMPACTION TEST WILL BE DONE AT ONE LOCATION POINT RANDOMLY SELECTED OR AS INDICATED BY THE SAWS INSPECTOR/TEST ADMINISTER, PER EACH 12-INCH LOOSE LIFT PER 400 LINEAR FEET AT A MINIMUM. THIS PROJECT WILL NOT BE ACCEPTED AND FINALIZED BY SAWS WITHOUT THIS REQUIREMENT BEING MET AND VERIFIED BY PROVIDING ALL NECESSARY DOCUMENTED TEST RESULTS. TRENCH EXCAVATION SAFETY PROTECTION

CONTRACTOR AND/OR CONTRACTOR'S INDEPENDENTLY RETAINED EMPLOYEE OR STRUCTURAL DESIGN/GEOTECHNICAL/SAFETY/EQUIPMENT CONSULTANT, IF ANY, SHALL REVIEW THESE PLANS AND AVAILABLE GEOTECHNICAL INFORMATION AND THE ANTICIPATED INSTALLATION SITE(S) WITHIN THE PROJECT WORK AREA IN ORDER TO IMPLEMENT CONTRACTOR'S TRENCH EXCAVATION SAFETY PROTECTION SYSTEMS. PROGRAMS AND/OR PROCEDURES FOR THE PROJECT DESCRIBED IN THE CONTRACT DOCUMENTS. THE CONTRACTOR'S IMPLEMENTATION OF THESE SYSTEMS, PROGRAMS AND/OR PROCEDURES SHALL PROVIDE FOR ADEQUATE TRENCH EXCAVATION SAFETY PROTECTION THAT COMPLY WITH AS A MINIMUM, OSHA STANDARDS FOR TRENCH EXCAVATIONS. SPECIFICALLY, CONTRACTOR AND/OR CONTRACTOR'S INDEPENDENTLY RETAINED EMPLOYEE OR SAFETY CONSULTANT SHALL IMPLEMENT A TRENCH SAFETY PROGRAM IN ACCORDANCE WITH OSHA STANDARDS GOVERNING THE PRESENCE AND ACTIVITIES OF INDIVIDUALS WORKING IN AND AROUND TRENCH EXCAVATION.

# PLAN OF RECORD

THESE RECORD DOCUMENTS HAVE BEEN PREPARED BASED ON INFORMATION PROVIDED BY OTHERS. THE ENGINEER HAS NOT VERIFIED THE ACCURACY OF THIS INFORMATION AND ASSUMES NO LIABILITY FOR ANY ERRORS AND OMISSIONS CAUSED AS A RESULT.



Developer's Name		PULTE HOME O	F TEXAS, L.P.		
Developer's Address		1718 DRY C	REEK WAY, SUI	TE 120	
City SAN ANTO	NIO	State	TEXAS	Zip	78259
Phone #	210) 496-1985		Fax #	(210) 496	5-0449
SAWS Block Map # _ C	94-622	Total EDU's	55	Total Acrea	ge17.592
Total Linear Footage of	Pipe1,84	7.45 L.F. OF 8" S	S - SDR 26	Plat No.	CP201603
Number of Lots	55		SAWS Job N	O.	16-1527

REPRODUCTION OF THE ORIGINAL SIGNED AND SEALED PLAN AND/OR ELECTRONIC MEDIA MAY HAVE BEEN INADVERTENTLY ALTERED. CONTRACTOR IS RESPONSIBLE FOR VERIFYING THE SCALE OF THE DOCUMENT AND CONTACTING CUDE ENGINEERS TO VERIFY DISCREPANCIES PRIOR TO CONSTRUCTION.

SAN ANTONIO, TEXAS

4122 Pond Hill Road, Suite 101 San Antonio, Texas 78231 P:(210) 681.2951 F: (210) 523.7112

DATE 12/23/15 PROJECT NO. 02975.010 **DRAWN BY** 

CHECKED BY REVISIONS

BMO\SMR\TCD\BAS

03/31/2016 - ADD SAWS JOB NO.

W. PATRICK MURPHY 111597 CUDE ENGINEERS TBPE No. 455 TBPLS No. 10048500

> PLAT NO. CP201603 SAWS JOB NO. 16-1527

6 OF 6