


CONSTRUCTION PLANS FOR

CIBOLO CREEK NORTH SEWER EXTENSION
PHASE II

BOERNE, KENDALL COUNTY, TEXAS

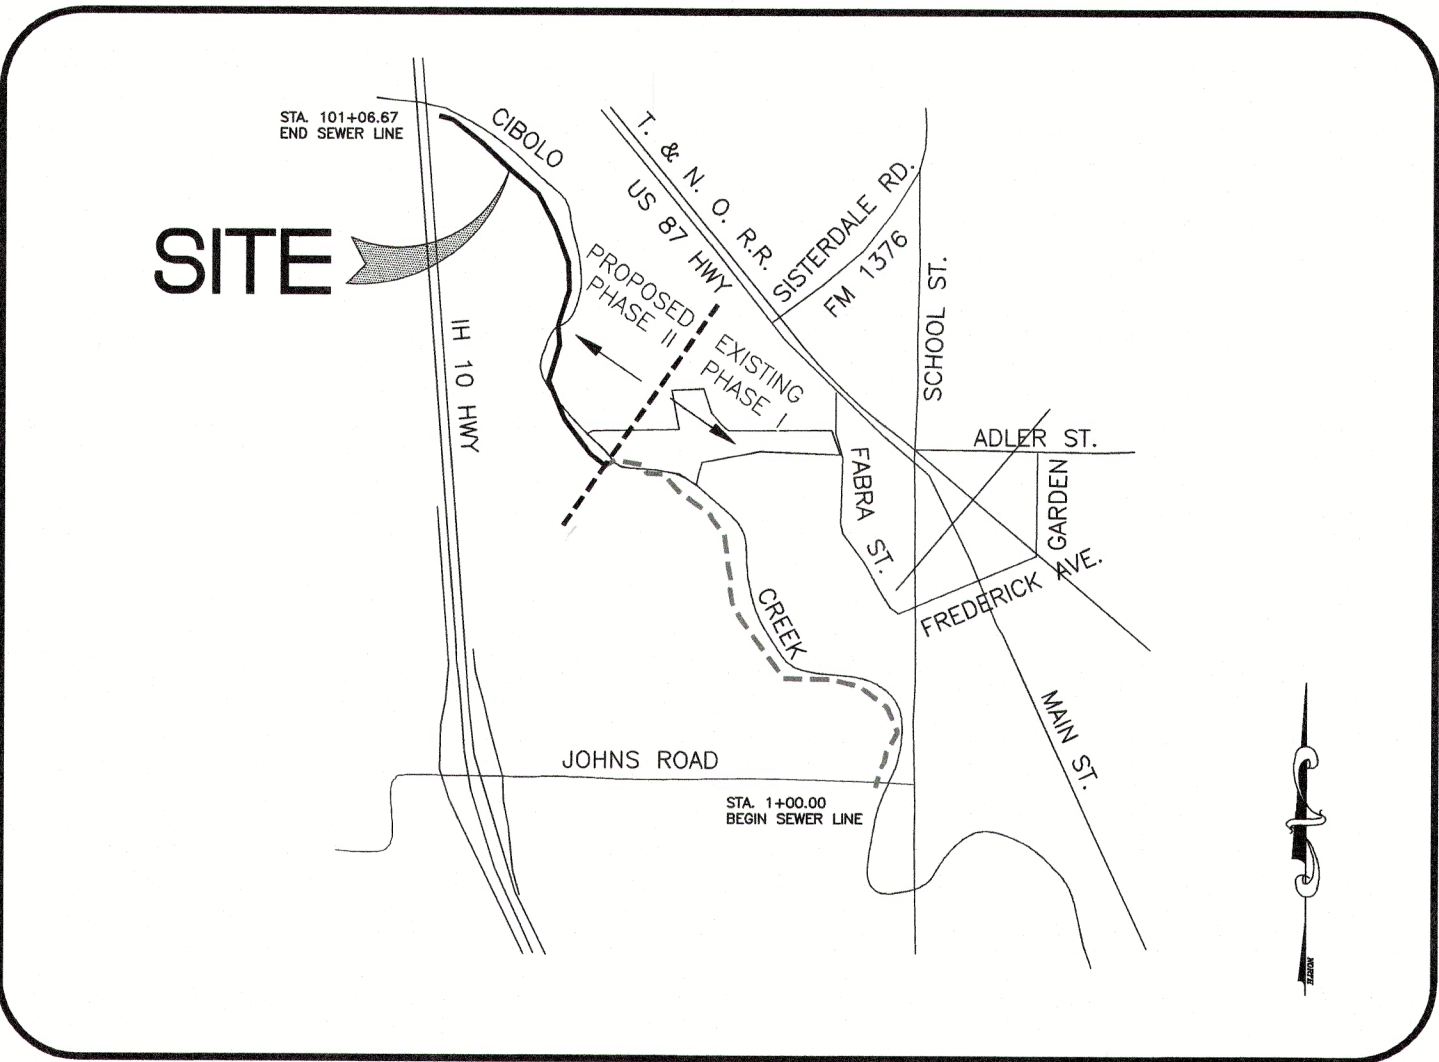

VICINITY MAP
N.T.S.

SUBMITTAL DATE:
APRIL 4, 2014

REVISION DATE:
△ SIZE OF SEWER MAIN AND SLOPE UPDATES 7/12/23

MTR
• Engineers
• Surveyors
• Planners
Moy Tarin Ramirez Engineers, LLC
FIRM TBPE NO. F-5297
12770 CIMARRON PATH, SUITE 100 TEL: (210) 698-5051
SAN ANTONIO, TEXAS 78249 FAX: (210) 698-5085

TABLE OF CONTENTS

SHEET 1	COVER
SHEET 2	CONSTRUCTION NOTES
SHEET 3	OVERALL SEWER PLAN / SEDIMENTATION & EROSION CONTROL PLAN
SHEET 4	SANITARY SEWER PLAN & PROFILE LINE A STA 55+62.00 TO STA 70+00.00
SHEET 5	SANITARY SEWER PLAN & PROFILE LINE A STA 70+00.00 TO STA 84+00.00
SHEET 6	SANITARY SEWER PLAN & PROFILE LINE A STA 84+00.00 TO STA 98+00.00
SHEET 7	SANITARY SEWER PLAN & PROFILE LINE A STA 98+00.00 TO STA 101+03.30
SHEET 8	SANITARY SEWER STANDARD DETAILS

SUBMITTED BY:
MOY TARIN RAMIREZ ENGINEERS, LLC
12770 CIMARRON PATH, SUITE 100
SAN ANTONIO, TEXAS 78249
TEL: (210) 698-5051
FAX: (210) 698-5085

*Sewer extension
built per plan
2/9/24
VRR
H. Anderson*

STATE OF TEXAS
99231
LICENSED PROFESSIONAL ENGINEER
CHRISTOPHER B. DUMAS
002, 7/12/23

NOTE: CHRISTOPHER B. DUMAS IS RESPONSIBLE FOR CHANGES DENOTED △