

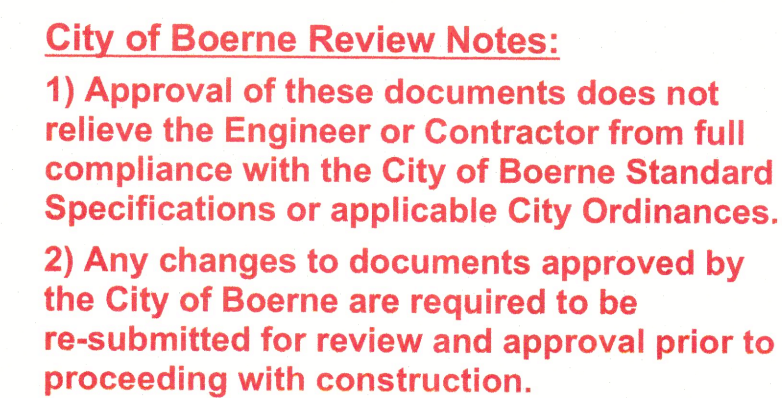


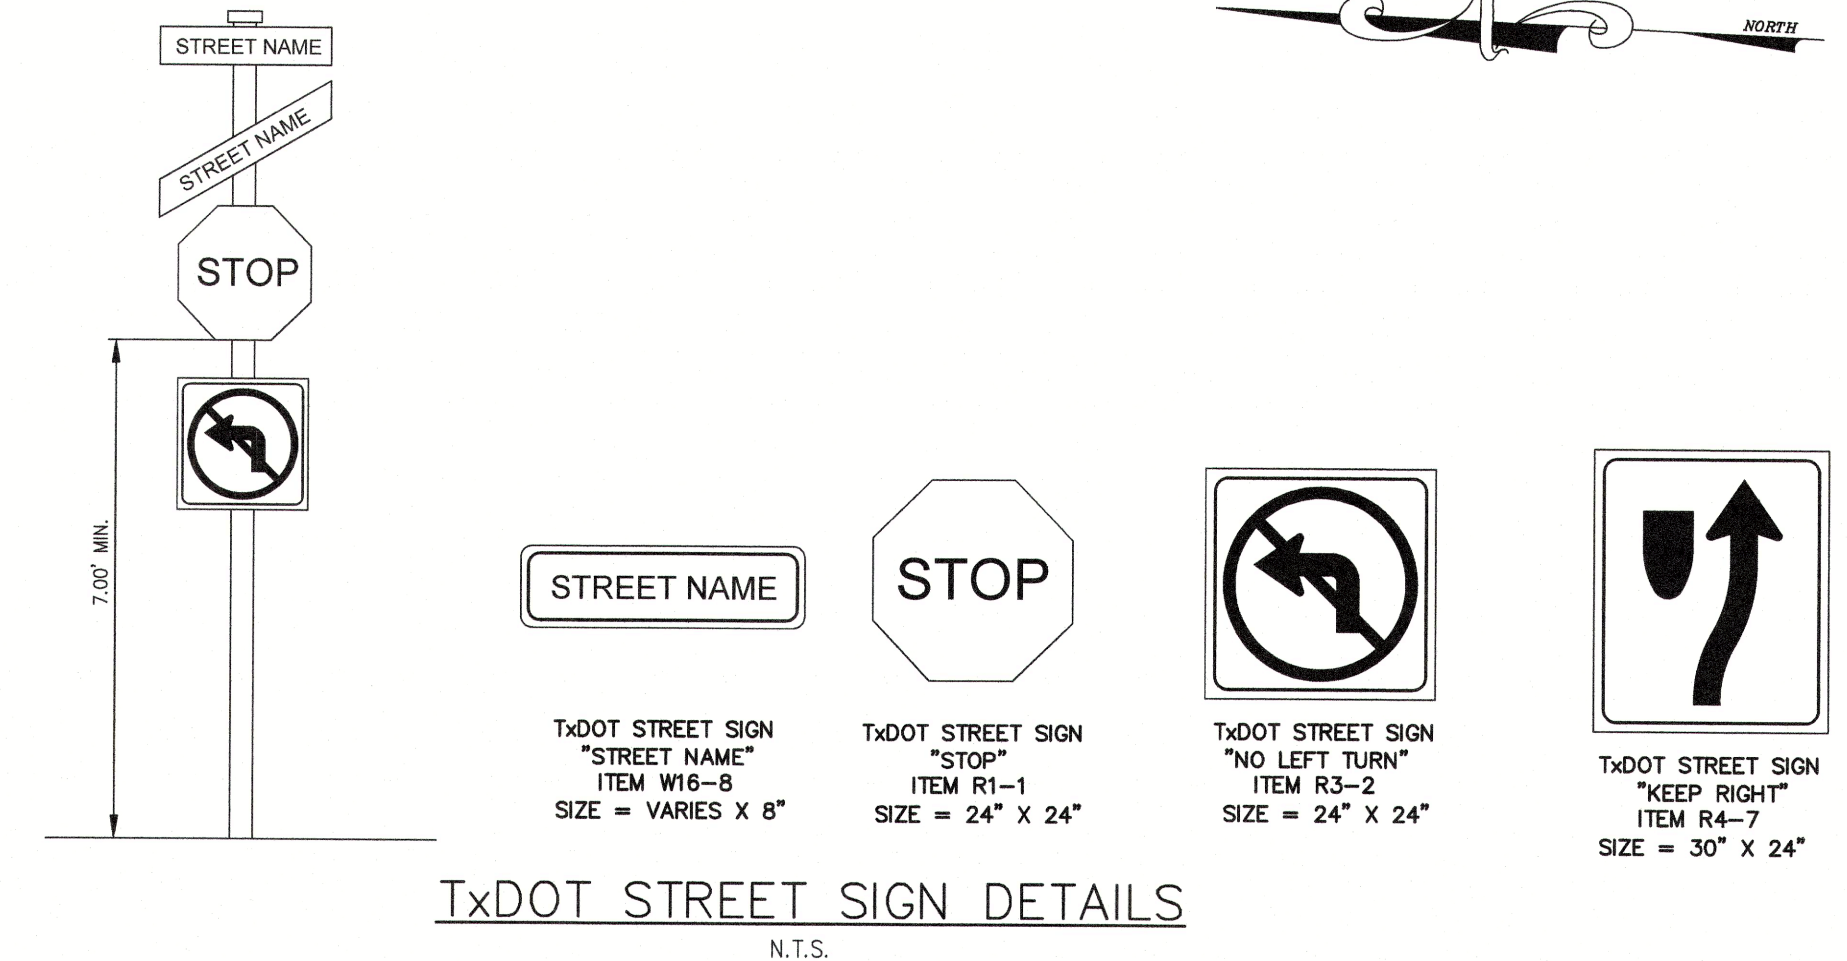

By: Cheryl J. Rogen Date: 7/27/2023

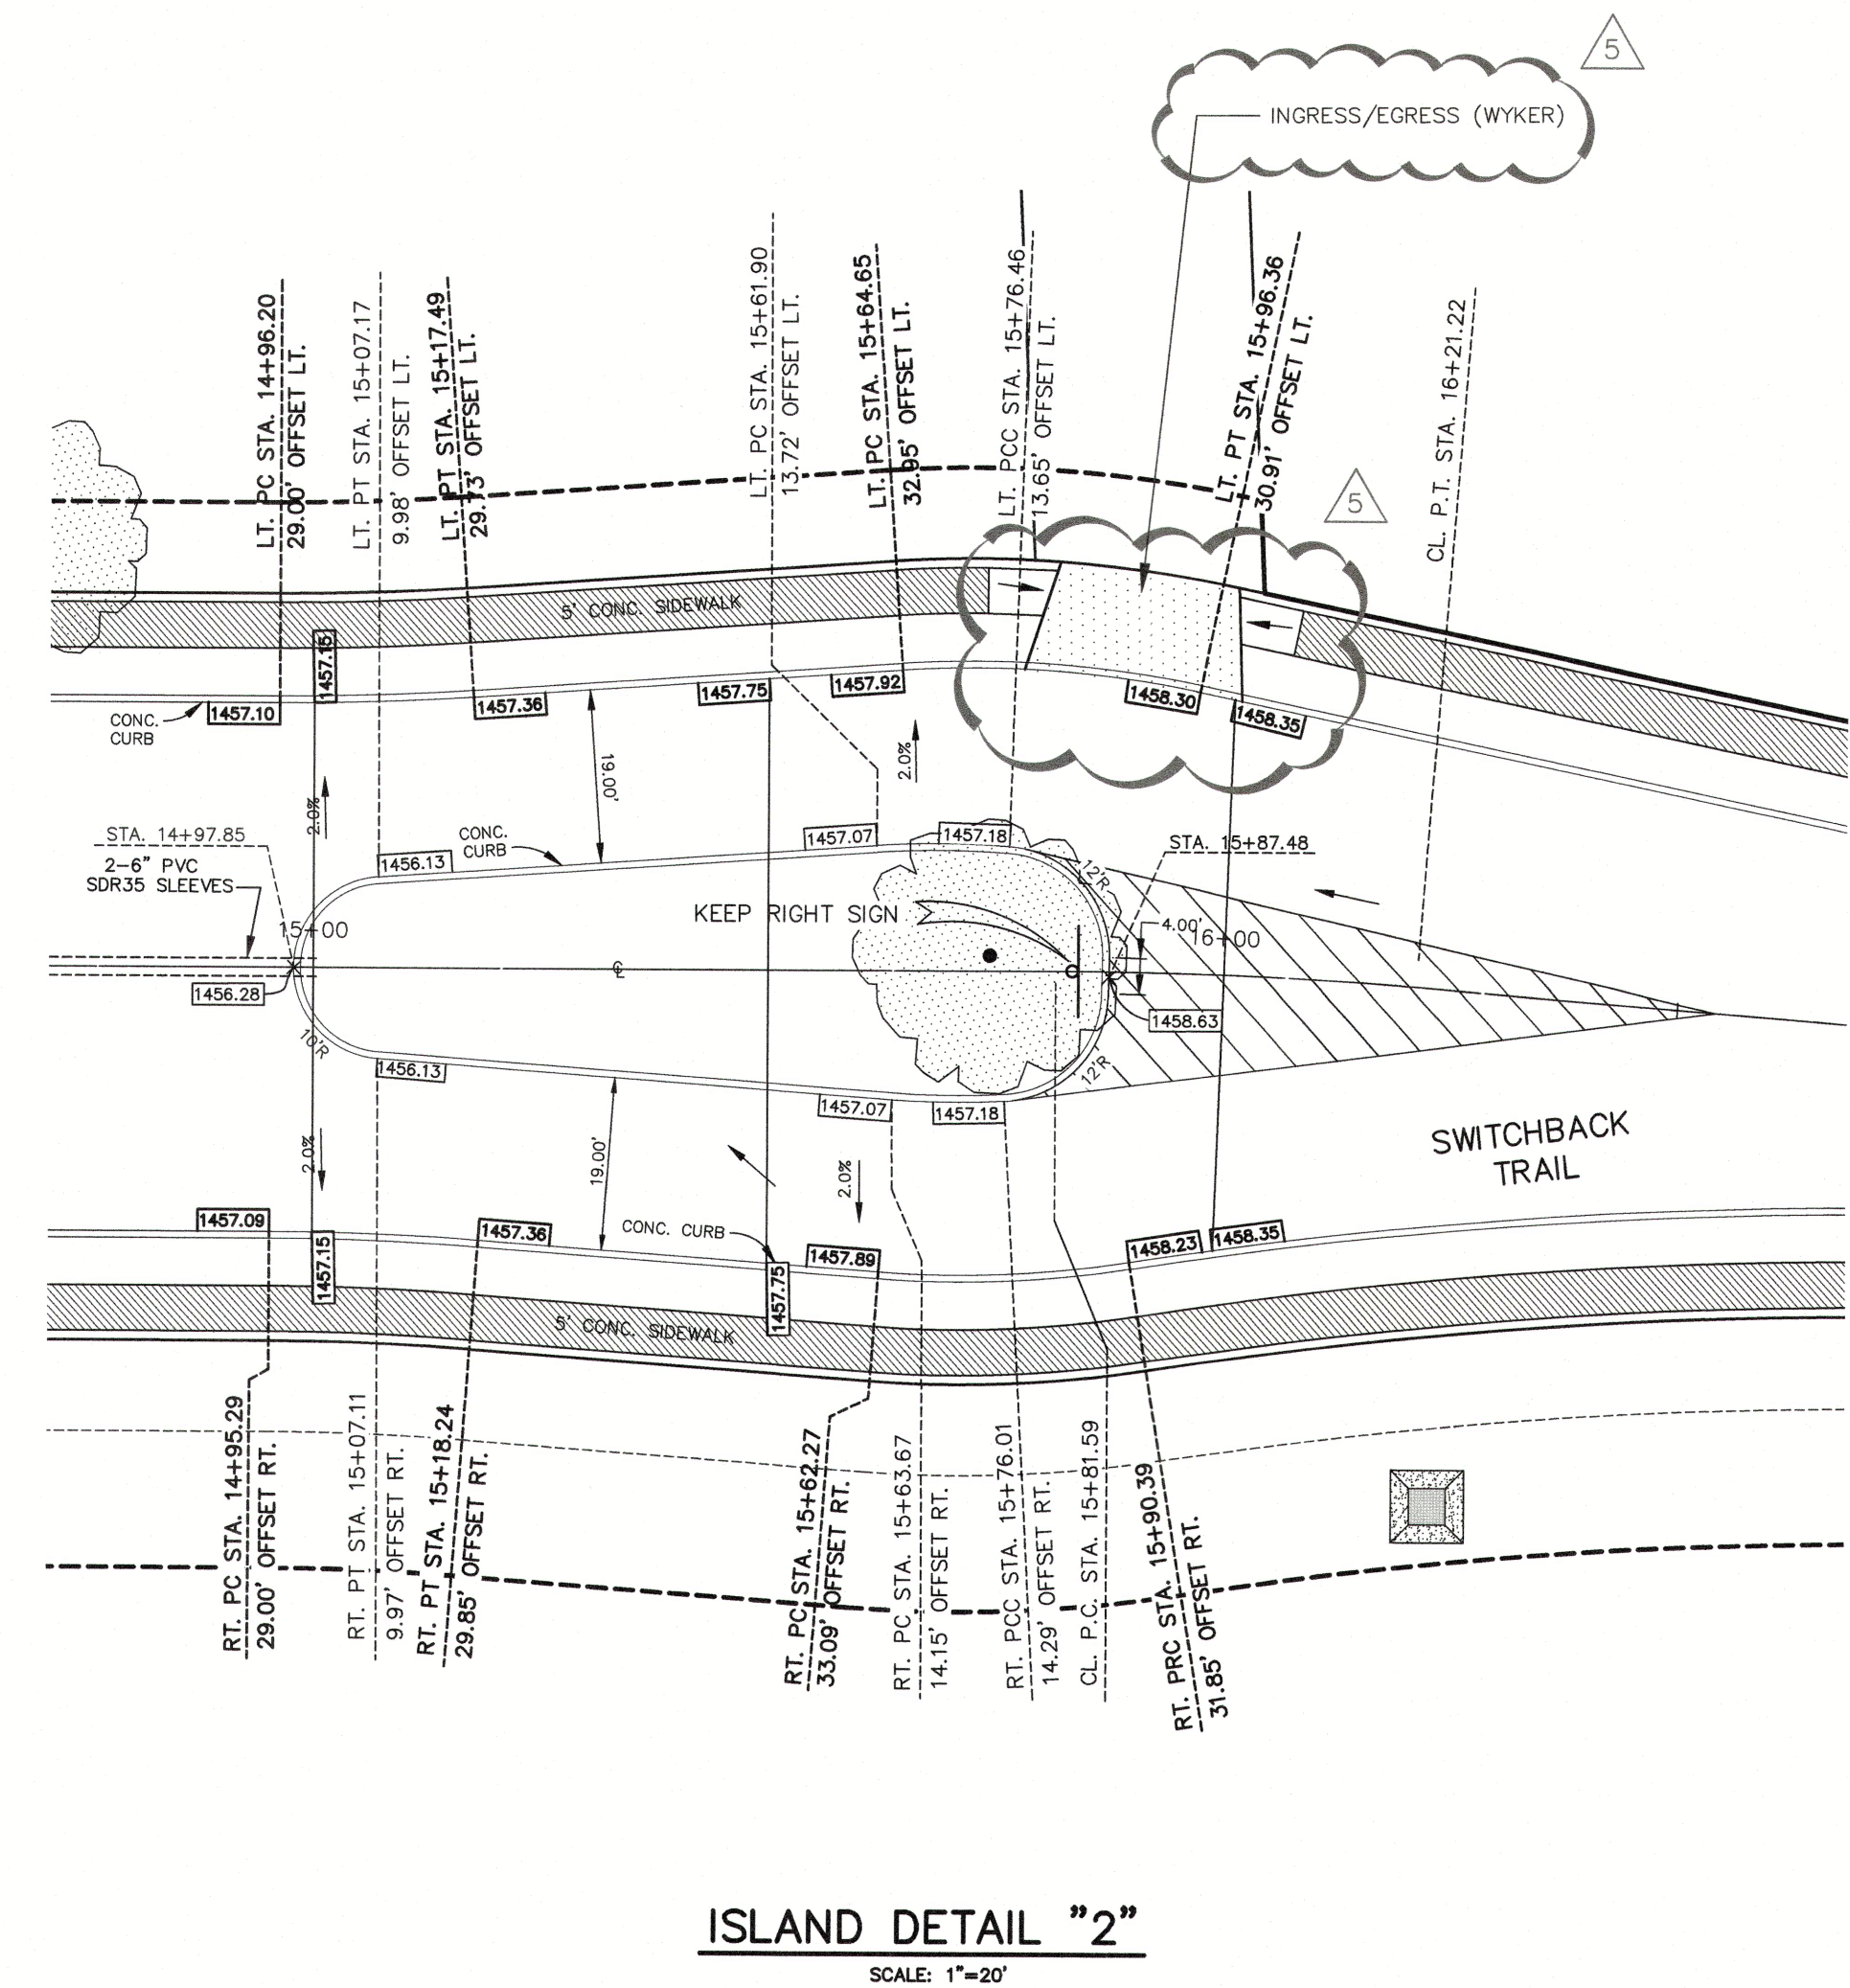

SCALE: 1"=20'

ALL SIGNS IN CITY OF BEORNE RIGHT OF WAY
SHALL COMPLY WITH CITY DETAILS 02514-1.0
AND 02514-1.1 AND CITY SPECIFICATIONS.

[illegible]

MIR
Moy Tarin Ramirez
FIRM TBPE N

NOTE: CHRISTOPHER B. DUMAS IS RESPONSIBLE FOR CHANGES DENOTED

STATE OF TEXAS
CHRISTOPHER B. DUMAS
99231
LICENSED
PROFESSIONAL ENGINEER
P.E.
6/30/12

SWITCHBACK TRAIL ISLAND & CONDUIT PLAN

SHEET 4.2

OF 37