



NUMBER OF LOTS: 299 SAWS JOB NO. 23-1670

PROGRAM IN ACCORDANCE WITH OSHA STANDARDS GOVERNING THE PRESENCE AND ACTIVITIES OF INDIVIDUALS WORKING IN AND AROUND TRENCH EXCAVATION.

EMPLOYEE OR SAFETY CONSULTANT SHALL IMPLEMENT A TRENCH SAFETY

SHEETS

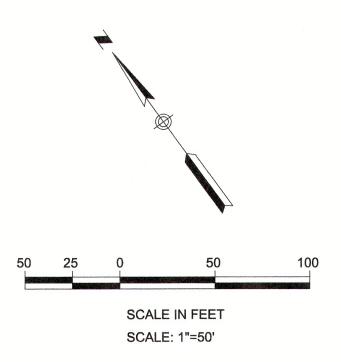

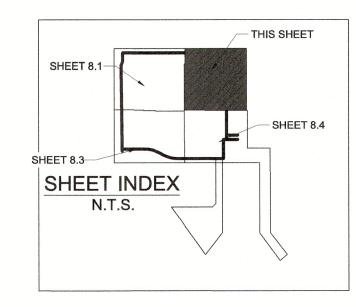

A 10' G.E.T.CA. ESM'T

OFF-LOT PERMEABLE VARIABLE WIDTH UTILITY \langle B \rangle ESM'T TO EXPIRE UPON INCORPORATION OF

FUTURE STREET R.O.W. (1.92 ACRES) OFF-LOT VARIABLE WIDTH PRIVATE DRAINAGE

/ ESM'T (2.86 ACRES, PERMEABLE) D 5' R.O.W. DEDICATION (0.102 ACRES)


E 5' G.E.T.CA. ESM'T


F 1' V.N.A.E. ESM'T

G OFF-LOT 15' GRADING ESM'T (0.486 ACRES)

(VOL. 7517, PGS. 863-867 OPR)

EAST SEWERSHED DEVELOPER'S NAME: MOSAIC LAND DEVELOPMENT DEVELOPER'S ADDRESS: 6812 WEST AVENUE, SUITE 100 STATE TEXAS ZIP 78213 PHONE # (210) 764-9575 FAX # SAWS BLOCK MAP # 194544, 190542 TOTAL EDU'S 299 TOTAL ACREAGE 46.43 AC TOTAL LINEAR FOOTAGE OF PIPE: 8" - 9,812 LF PLAT NO. 23-11800410 NUMBER OF LOTS: 299 SAWS JOB NO. 23-1670

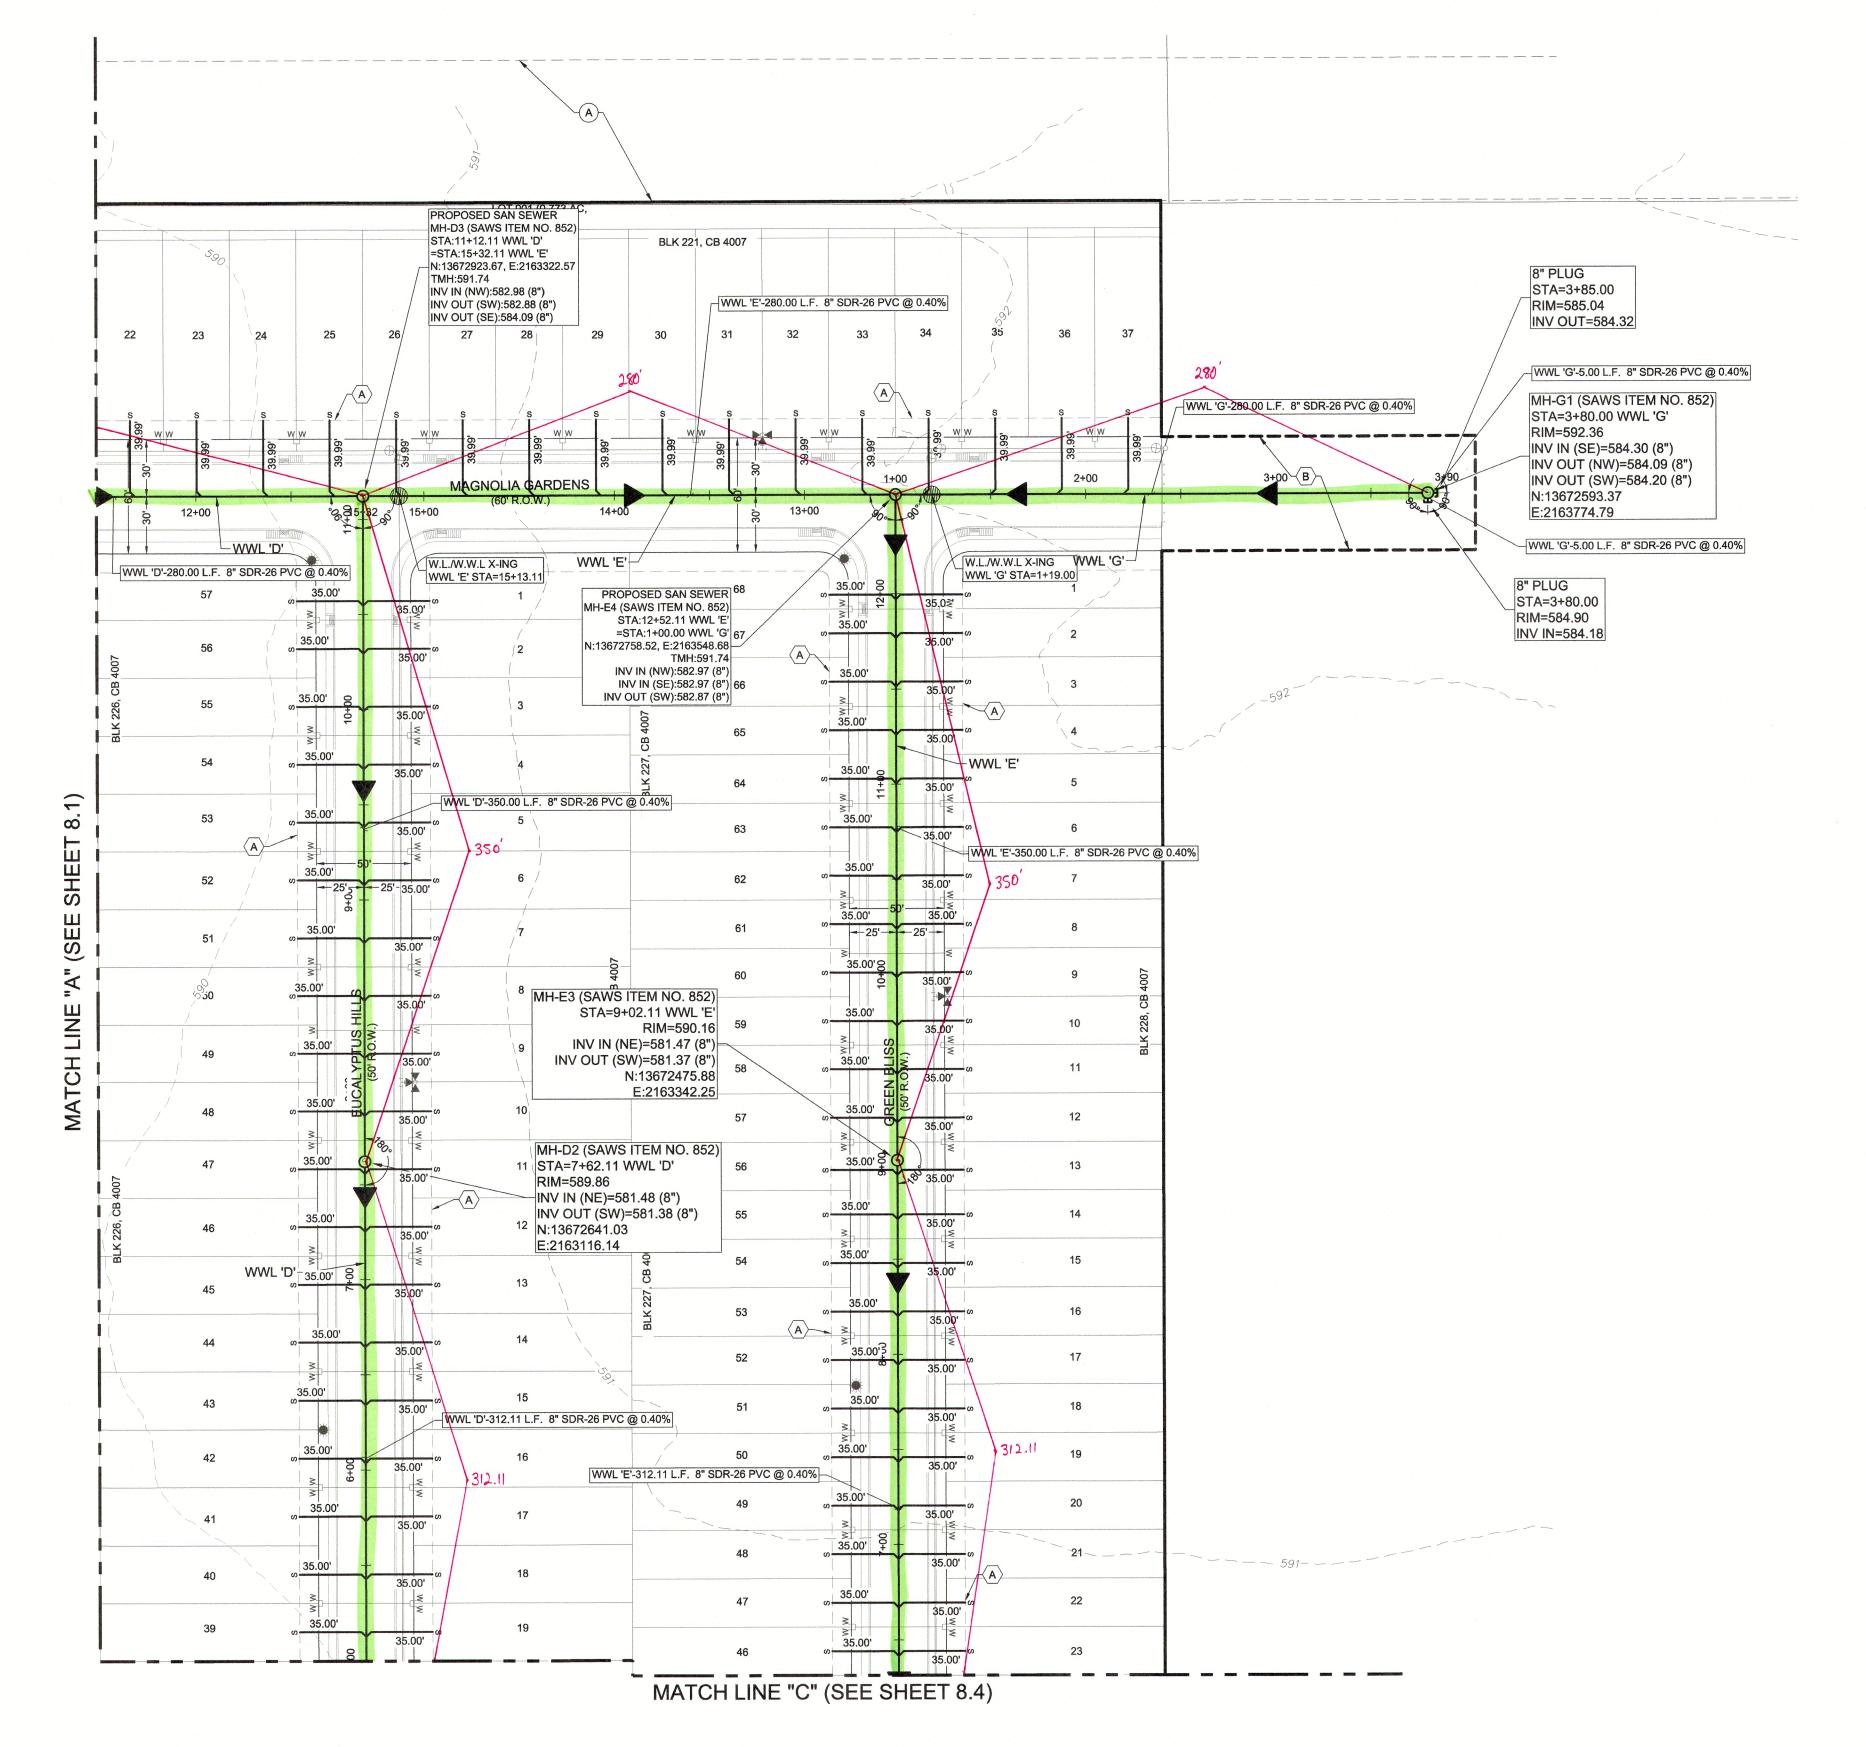

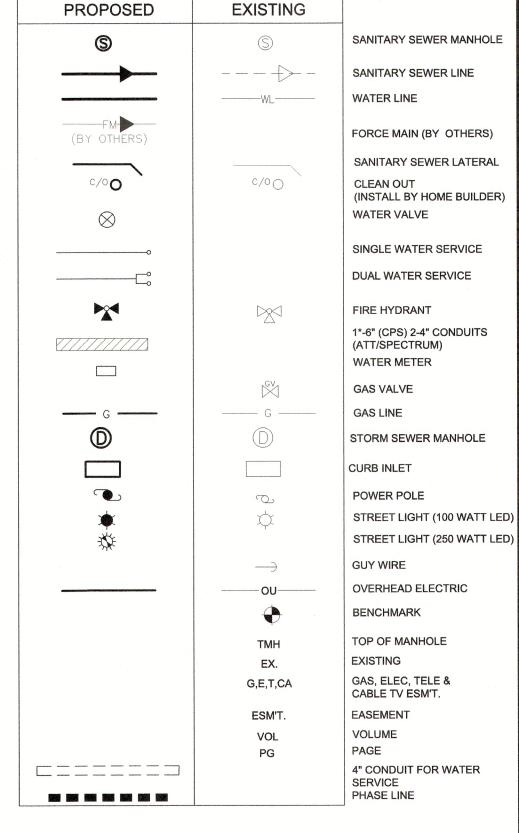

LEGEND

GENERAL NOTES

BACKGROUND VEGETATIVE COVER.

- 1. THE CONTRACTOR IS RESPONSIBLE FOR CONSTRUCTING AND TESTING THE SANITARY SEWER SYSTEM IN ACCORDANCE WITH 30 TAC 217 [AND 213.5 FOR PROJECTS IN THE ERZD], THE DESIGN PLANS AND SAWS SPECIFICATIONS.
- 2. THE CONTRACTOR MUST PROVIDE CERTIFICATION UPON REQUEST OF THE ENGINEER THAT ALL MATERIALS FOR THE CONSTRUCTION OF THE SANITARY SEWER SYSTEM MEET TCEQ AND SAWS SPECIFICATIONS.
- 3. THE CONTRACTOR IS TO NOTIFY THE ENGINEER AT LEAST THREE (3) DAYS PRIOR TO BEGINNING WATER CONSTRUCTION AND TESTING SCHEDULE.
- 4. THE CONTRACTOR SHALL NOTIFY THE ENGINEER AT LEAST THREE (3) DAYS PRIOR TO ALL TESTING ON THE SANITARY SEWER SYSTEM.
- 5. ANY TESTING PERFORMED WITHOUT THE PRESENCE OF THE ENGINEER WILL BE
- 6. THE CONTRACTOR MUST PROVIDE THE ENGINEER WITH COPIES OF TV-VIDEO INSPECTIONS WHEN COMPLETED AND COMPACTION TESTING RESULTS PRIOR TO FINAL TESTING OBSERVATION BY THE ENGINEER.
- 7. AFTER ALL SANITARY SEWER CONSTRUCTION HAS BEEN COMPLETED, FINAL STABILIZATION OF THE CONSTRUCTION AREA ON ALL UNPAVED AREAS AND AREAS NOT COVERED BY PERMANENT STRUCTURES SHALL BE COMPLETED BY EVENLY DISTRIBUTING SEEDING AND WATERING TO A MINIMUM OF 70% OF THE NATIVE
- 8. ALL RESIDENTIAL SEWER SERVICE LATERALS ARE 6" DIA. AND 35 FEET FOR 50 FEET ROW, 40 FT. FOR 60 FEET ROW IN LENGTH UNLESS NOTED OTHERWISE.
- 9. ALL RESIDENTIAL SEWER SERVICE LATERALS SHALL BE EXTENDED TO THE 10' G.E.T.TV.E. EASEMENT AND CAPPED AND SEALED.
- 10.LATERALS TO LOTS THAT SLOPE AWAY FROM STREET SHALL BE SLOPED FROM THE TEE OR STACK AT 2% TO THE PROPERTY LINE.
- 12. CONTRACTOR TO FIELD VERIFY ALL MATCH EXISTING ELEVATIONS, SEWER MANHOLE INVERTS, STORM DRAIN INVERTS, AND ALL OTHER UTILITIES PRIOR TO UTILITY WORK AND NOTIFY THE ENGINEER IN WRITING OF ANY DISCREPANCIES.
- 13.RIM ELEVATIONS OF PROPOSED MANHOLES THAT ARE NOT WITHIN STREET RIGHT-OF-WAY ARE TO BE APPROXIMATELY 6" ABOVE NATURAL GROUND.
- 14.DAMAGE TO EXISTING PAVEMENT SHALL BE REPLACED BY CONTRACTOR AT NO
- ADDITIONAL COST. 15. COORDINATES ARE BASED ON STATE PLANE TX83-SCF- SURFACE. SCALE FACTOR:

16.CONTRACTOR SHALL BE RESPONSIBLE FOR MEETING SAWS STANDARD SPECIFICATION 804 FOR EXCAVATION, TRENCHING AND BACKFILLING REQUIREMENTS AND STANDARD SPECIFICATION 812 FOR WATER/SEWER SEPARATION REQUIREMENTS.

> CAUTION: CONTRACTOR TO NOTIFY TEXAS ONE CALL AT 1-800-245-4545 48 HOURS PRIOR TO CONSTRUCTION FOR UTILITY LINE LOCATE. CONTRACTOR SHALL VERIFY HORIZONTAL AND VERTICAL LOCATION OF ALL EXISTING UTILITIES PRIOR TO CONSTRUCTION. ENGINEER SHALL BE NOTIFIED IMMEDIATELY OF ANY SIGNIFICANT DISCREPANCIES OR REQUIRED DESIGN CHANGES. EXISTING UTILITIES SHOWN HEREON ARE FOR INFORMATIONAL PURPOSES ONLY. ENGINEER ASSUMES NO RESPONSIBILITY FOR THE ACCURACY OF THIS INFORMATION.

LOCATION OF EXISTING UNDERGROUND AND OVERHEAD UTILITIES ARE APPROXIMATE LOCATIONS ONLY. THE CONTRACTOR SHALL DETERMINE THE EXACT LOCATION OF ALL EXISTING UTILITIES PRIOR TO BEGINNING WORK AND SHALL BE FULLY RESPONSIBLE FOR ANY AND

ALL DAMAGES WHICH MIGHT OCCUR.

ORDER TO IMPLEMENT CONTRACTOR'S TRENCH EXCAVATION SAFETY

PROVIDE FOR ADEQUATE TRENCH EXCAVATION, SAFETY PROTECTION THAT

EMPLOYEE OR SAFETY CONSULTANT SHALL IMPLEMENT A TRENCH SAFETY PROGRAM IN ACCORDANCE WITH OSHA STANDARDS GOVERNING THE PRESENCE

COMPLIES WITH AS A MINIMUM, OSHA STANDARDS FOR TRENCH EXCAVATIONS. SPECIFICALLY, CONTRACTOR AND/OR CONTRACTOR'S INDEPENDENTLY RETAINED



Call before you dig. TRENCH EXCAVATION SAFETY PROTECTION CONTRACTOR AND/OR CONTRACTOR'S INDEPENDENTLY RETAINED EMPLOYEE OR STRUCTURAL DESIGN/GEOTECHNICAL/ SAFETY/EQUIPMENT CONSULTANT, IF ANY, SHALL REVIEW THESE PLANS AND AVAILABLE GEOTECHNICAL INFORMATION AND THE ANTICIPATED INSTALLATION SITE(S) WITHIN THE PROJECT WORK AREA IN

JOB NUMBER: SA202-0401B-426 PROTECTION SYSTEMS, PROGRAMS AND/OR PROCEDURES. THE CONTRACTOR'S IMPLEMENTATION OF THE SYSTEMS, PROGRAMS AND/OR PROCEDURES SHALL


AND ACTIVITIES OF INDIVIDUALS WORKING IN AND AROUND TRENCH EXCAVATION. OF

*

RICHARD W. GRAY III

75617

06/10/2024

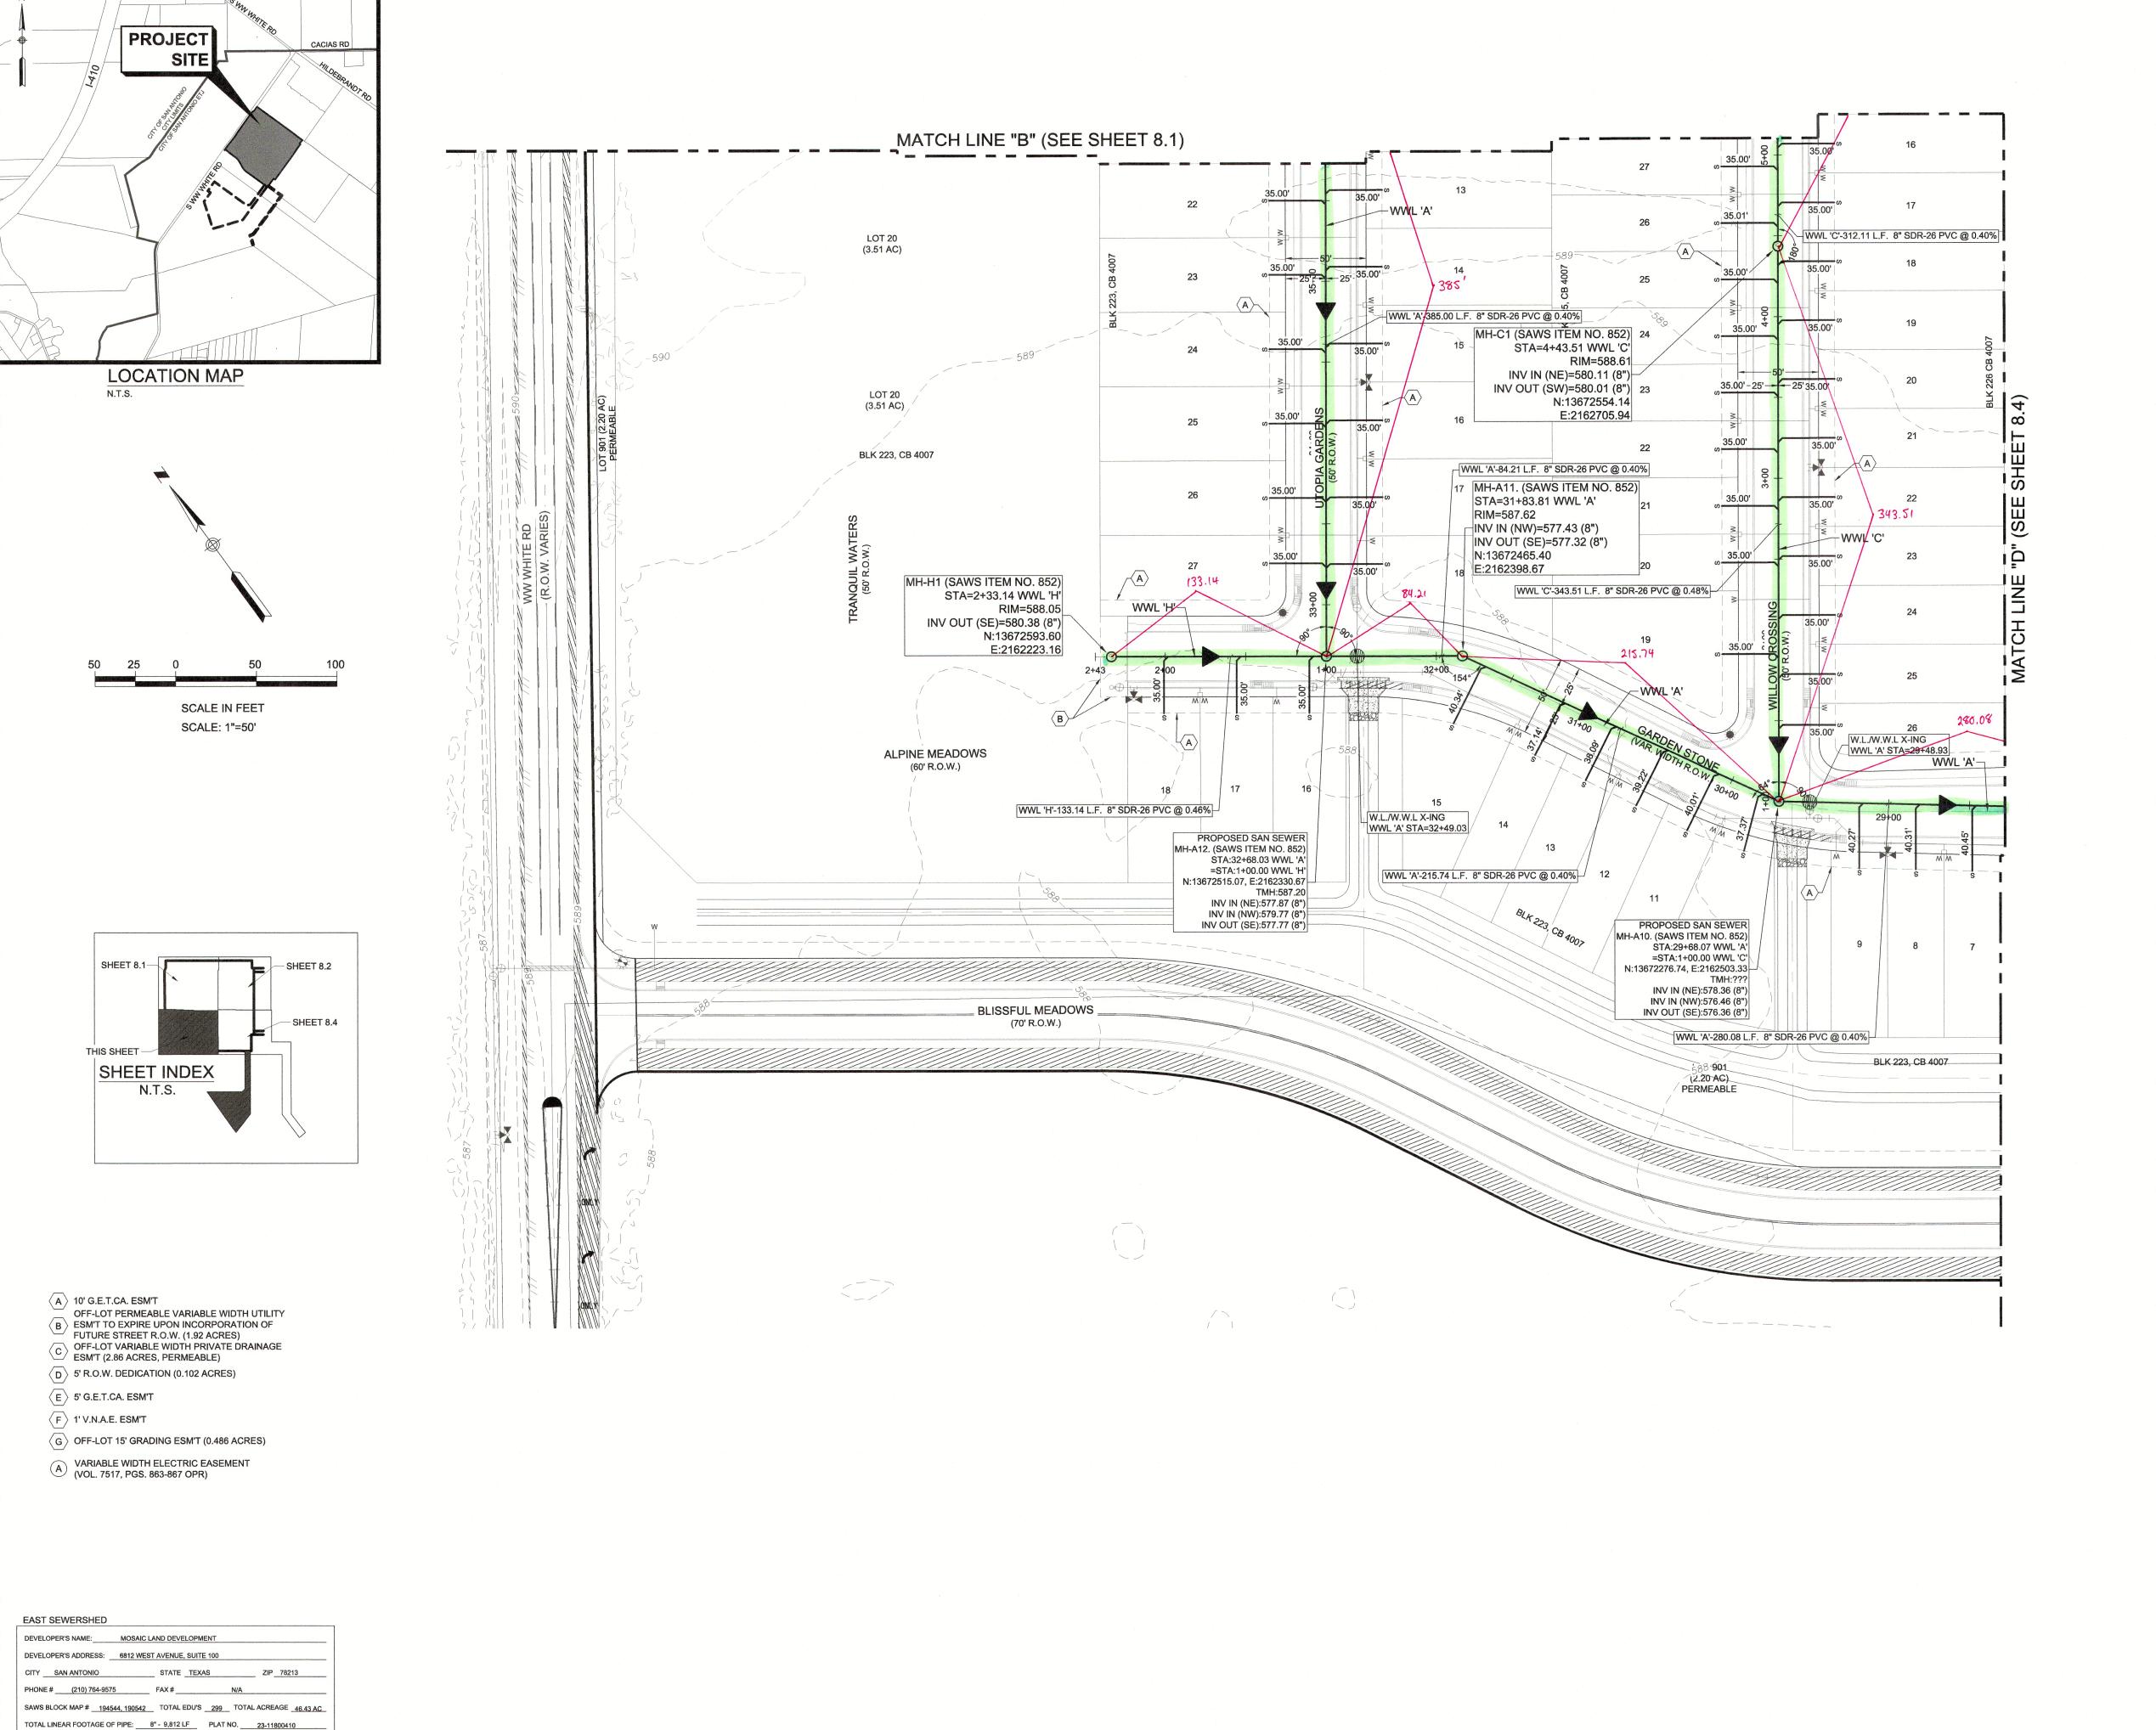

LEGEND

PROPOSED	EXISTING	
S	(5)	SANITARY SEWER MANHOLE
		SANITARY SEWER LINE
ACCEPTAGE OF THE PROPERTY CONTRACTOR OF THE PROPERTY OF THE PR	WL	WATER LINE
(BY OTHERS)		FORCE MAIN (BY OTHERS)
		SANITARY SEWER LATERAL
°/° o `	c/o ₀	CLEAN OUT (INSTALL BY HOME BUILDER WATER VALVE
		SINGLE WATER SERVICE
		DUAL WATER SERVICE
		FIRE HYDRANT
<u>-</u>		1*-6" (CPS) 2-4" CONDUITS (ATT/SPECTRUM) WATER METER
	©∨ 	GAS VALVE
	G	GAS LINE
		STORM SEWER MANHOLE
		CURB INLET
		POWER POLE
		STREET LIGHT (100 WATT LE
***		STREET LIGHT (250 WATT LE
	——————————————————————————————————————	GUY WIRE
	OU	OVERHEAD ELECTRIC
	•	BENCHMARK
	ТМН	TOP OF MANHOLE
	EX.	EXISTING
	G,E,T,CA	GAS, ELEC, TELE & CABLE TV ESM'T.
	ESM'T.	EASEMENT
	VOL	VOLUME
	PG	PAGE
		4" CONDUIT FOR WATER SERVICE PHASE LINE

GENERAL NOTES

BACKGROUND VEGETATIVE COVER.

- 1. THE CONTRACTOR IS RESPONSIBLE FOR CONSTRUCTING AND TESTING THE SANITARY SEWER SYSTEM IN ACCORDANCE WITH 30 TAC 217 [AND 213.5 FOR PROJECTS IN THE ERZD], THE DESIGN PLANS AND SAWS SPECIFICATIONS.
- 2. THE CONTRACTOR MUST PROVIDE CERTIFICATION UPON REQUEST OF THE ENGINEER THAT ALL MATERIALS FOR THE CONSTRUCTION OF THE SANITARY SEWER SYSTEM MEET TCEQ AND SAWS SPECIFICATIONS.
- 3. THE CONTRACTOR IS TO NOTIFY THE ENGINEER AT LEAST THREE (3) DAYS PRIOR TO BEGINNING WATER CONSTRUCTION AND TESTING SCHEDULE.
- 4. THE CONTRACTOR SHALL NOTIFY THE ENGINEER AT LEAST THREE (3) DAYS PRIOR TO ALL TESTING ON THE SANITARY SEWER SYSTEM.
- 5. ANY TESTING PERFORMED WITHOUT THE PRESENCE OF THE ENGINEER WILL BE
- 6. THE CONTRACTOR MUST PROVIDE THE ENGINEER WITH COPIES OF TV-VIDEO INSPECTIONS WHEN COMPLETED AND COMPACTION TESTING RESULTS PRIOR TO
- FINAL TESTING OBSERVATION BY THE ENGINEER. 7. AFTER ALL SANITARY SEWER CONSTRUCTION HAS BEEN COMPLETED, FINAL STABILIZATION OF THE CONSTRUCTION AREA ON ALL UNPAVED AREAS AND AREAS NOT COVERED BY PERMANENT STRUCTURES SHALL BE COMPLETED BY EVENLY DISTRIBUTING SEEDING AND WATERING TO A MINIMUM OF 70% OF THE NATIVE
- 8. ALL RESIDENTIAL SEWER SERVICE LATERALS ARE 6" DIA. AND 35 FEET FOR 50 FEET ROW, 40 FT. FOR 60 FEET ROW IN LENGTH UNLESS NOTED OTHERWISE.
- 9. ALL RESIDENTIAL SEWER SERVICE LATERALS SHALL BE EXTENDED TO THE 10' G.E.T.TV.E. EASEMENT AND CAPPED AND SEALED.
- 10.LATERALS TO LOTS THAT SLOPE AWAY FROM STREET SHALL BE SLOPED FROM THE TEE OR STACK AT 2% TO THE PROPERTY LINE.
- 12. CONTRACTOR TO FIELD VERIFY ALL MATCH EXISTING ELEVATIONS, SEWER MANHOLE INVERTS, STORM DRAIN INVERTS, AND ALL OTHER UTILITIES PRIOR TO UTILITY WORK AND NOTIFY THE ENGINEER IN WRITING OF ANY DISCREPANCIES.
- 13.RIM ELEVATIONS OF PROPOSED MANHOLES THAT ARE NOT WITHIN STREET RIGHT-OF-WAY ARE TO BE APPROXIMATELY 6" ABOVE NATURAL GROUND.
- 14.DAMAGE TO EXISTING PAVEMENT SHALL BE REPLACED BY CONTRACTOR AT NO ADDITIONAL COST.
- 15. COORDINATES ARE BASED ON STATE PLANE TX83-SCF- SURFACE. SCALE FACTOR:
- 16.CONTRACTOR SHALL BE RESPONSIBLE FOR MEETING SAWS STANDARD SPECIFICATION 804 FOR EXCAVATION, TRENCHING AND BACKFILLING REQUIREMENTS AND STANDARD SPECIFICATION 812 FOR WATER/SEWER SEPARATION REQUIREMENTS.

CAUTION: CONTRACTOR TO NOTIFY TEXAS ONE CALL AT 1-800-245-4545 48 HOURS PRIOR TO CONSTRUCTION FOR UTILITY LINE LOCATE. CONTRACTOR SHALL VERIFY HORIZONTAL AND VERTICAL LOCATION OF ALL EXISTING UTILITIES PRIOR TO CONSTRUCTION. ENGINEER SHALL BE NOTIFIED IMMEDIATELY OF ANY SIGNIFICANT DISCREPANCIES OR REQUIRED DESIGN CHANGES. EXISTING UTILITIES SHOWN HEREON ARE FOR INFORMATIONAL PURPOSES ONLY. ENGINEER ASSUMES NO RESPONSIBILITY FOR THE ACCURACY OF THIS INFORMATION.

LOCATION OF EXISTING UNDERGROUND AND OVERHEAD UTILITIES ARE APPROXIMATE LOCATIONS ONLY. THE CONTRACTOR SHALL DETERMINE THE EXACT LOCATION OF ALL EXISTING UTILITIES PRIOR TO BEGINNING WORK AND SHALL BE FULLY RESPONSIBLE FOR ANY AND ALL DAMAGES WHICH MIGHT OCCUR.



Call before you dig

TRENCH EXCAVATION SAFETY PROTECTION CONTRACTOR AND/OR CONTRACTOR'S INDEPENDENTLY RETAINED EMPLOYEE OF STRUCTURAL DESIGN/GEOTECHNICAL/ SAFETY/EQUIPMENT CONSULTANT, IF ANY, SHALL REVIEW THESE PLANS AND AVAILABLE GEOTECHNICAL INFORMATION AND THE ANTICIPATED INSTALLATION SITE(S) WITHIN THE PROJECT WORK AREA IN ORDER TO IMPLEMENT CONTRACTOR'S TRENCH EXCAVATION SAFETY PROTECTION SYSTEMS, PROGRAMS AND/OR PROCEDURES. THE CONTRACTOR'S IMPLEMENTATION OF THE SYSTEMS, PROGRAMS AND/OR PROCEDURES SHALL PROVIDE FOR ADEQUATE TRENCH EXCAVATION, SAFETY PROTECTION THAT COMPLIES WITH AS A MINIMUM, OSHA STANDARDS FOR TRENCH EXCAVATIONS. SPECIFICALLY, CONTRACTOR AND/OR CONTRACTOR'S INDEPENDENTLY RETAINED EMPLOYEE OR SAFETY CONSULTANT SHALL IMPLEMENT A TRENCH SAFETY PROGRAM IN ACCORDANCE WITH OSHA STANDARDS GOVERNING THE PRESENCE AND ACTIVITIES OF INDIVIDUALS WORKING IN AND AROUND TRENCH EXCAVATION.

JOB NUMBER: SA202-0401B-426

18DIVISION 8-11800410

ARD


*

RICHARD W. GRAY III

75617

06/10/2024

NUMBER OF LOTS: 299 SAWS JOB NO. 23-1670

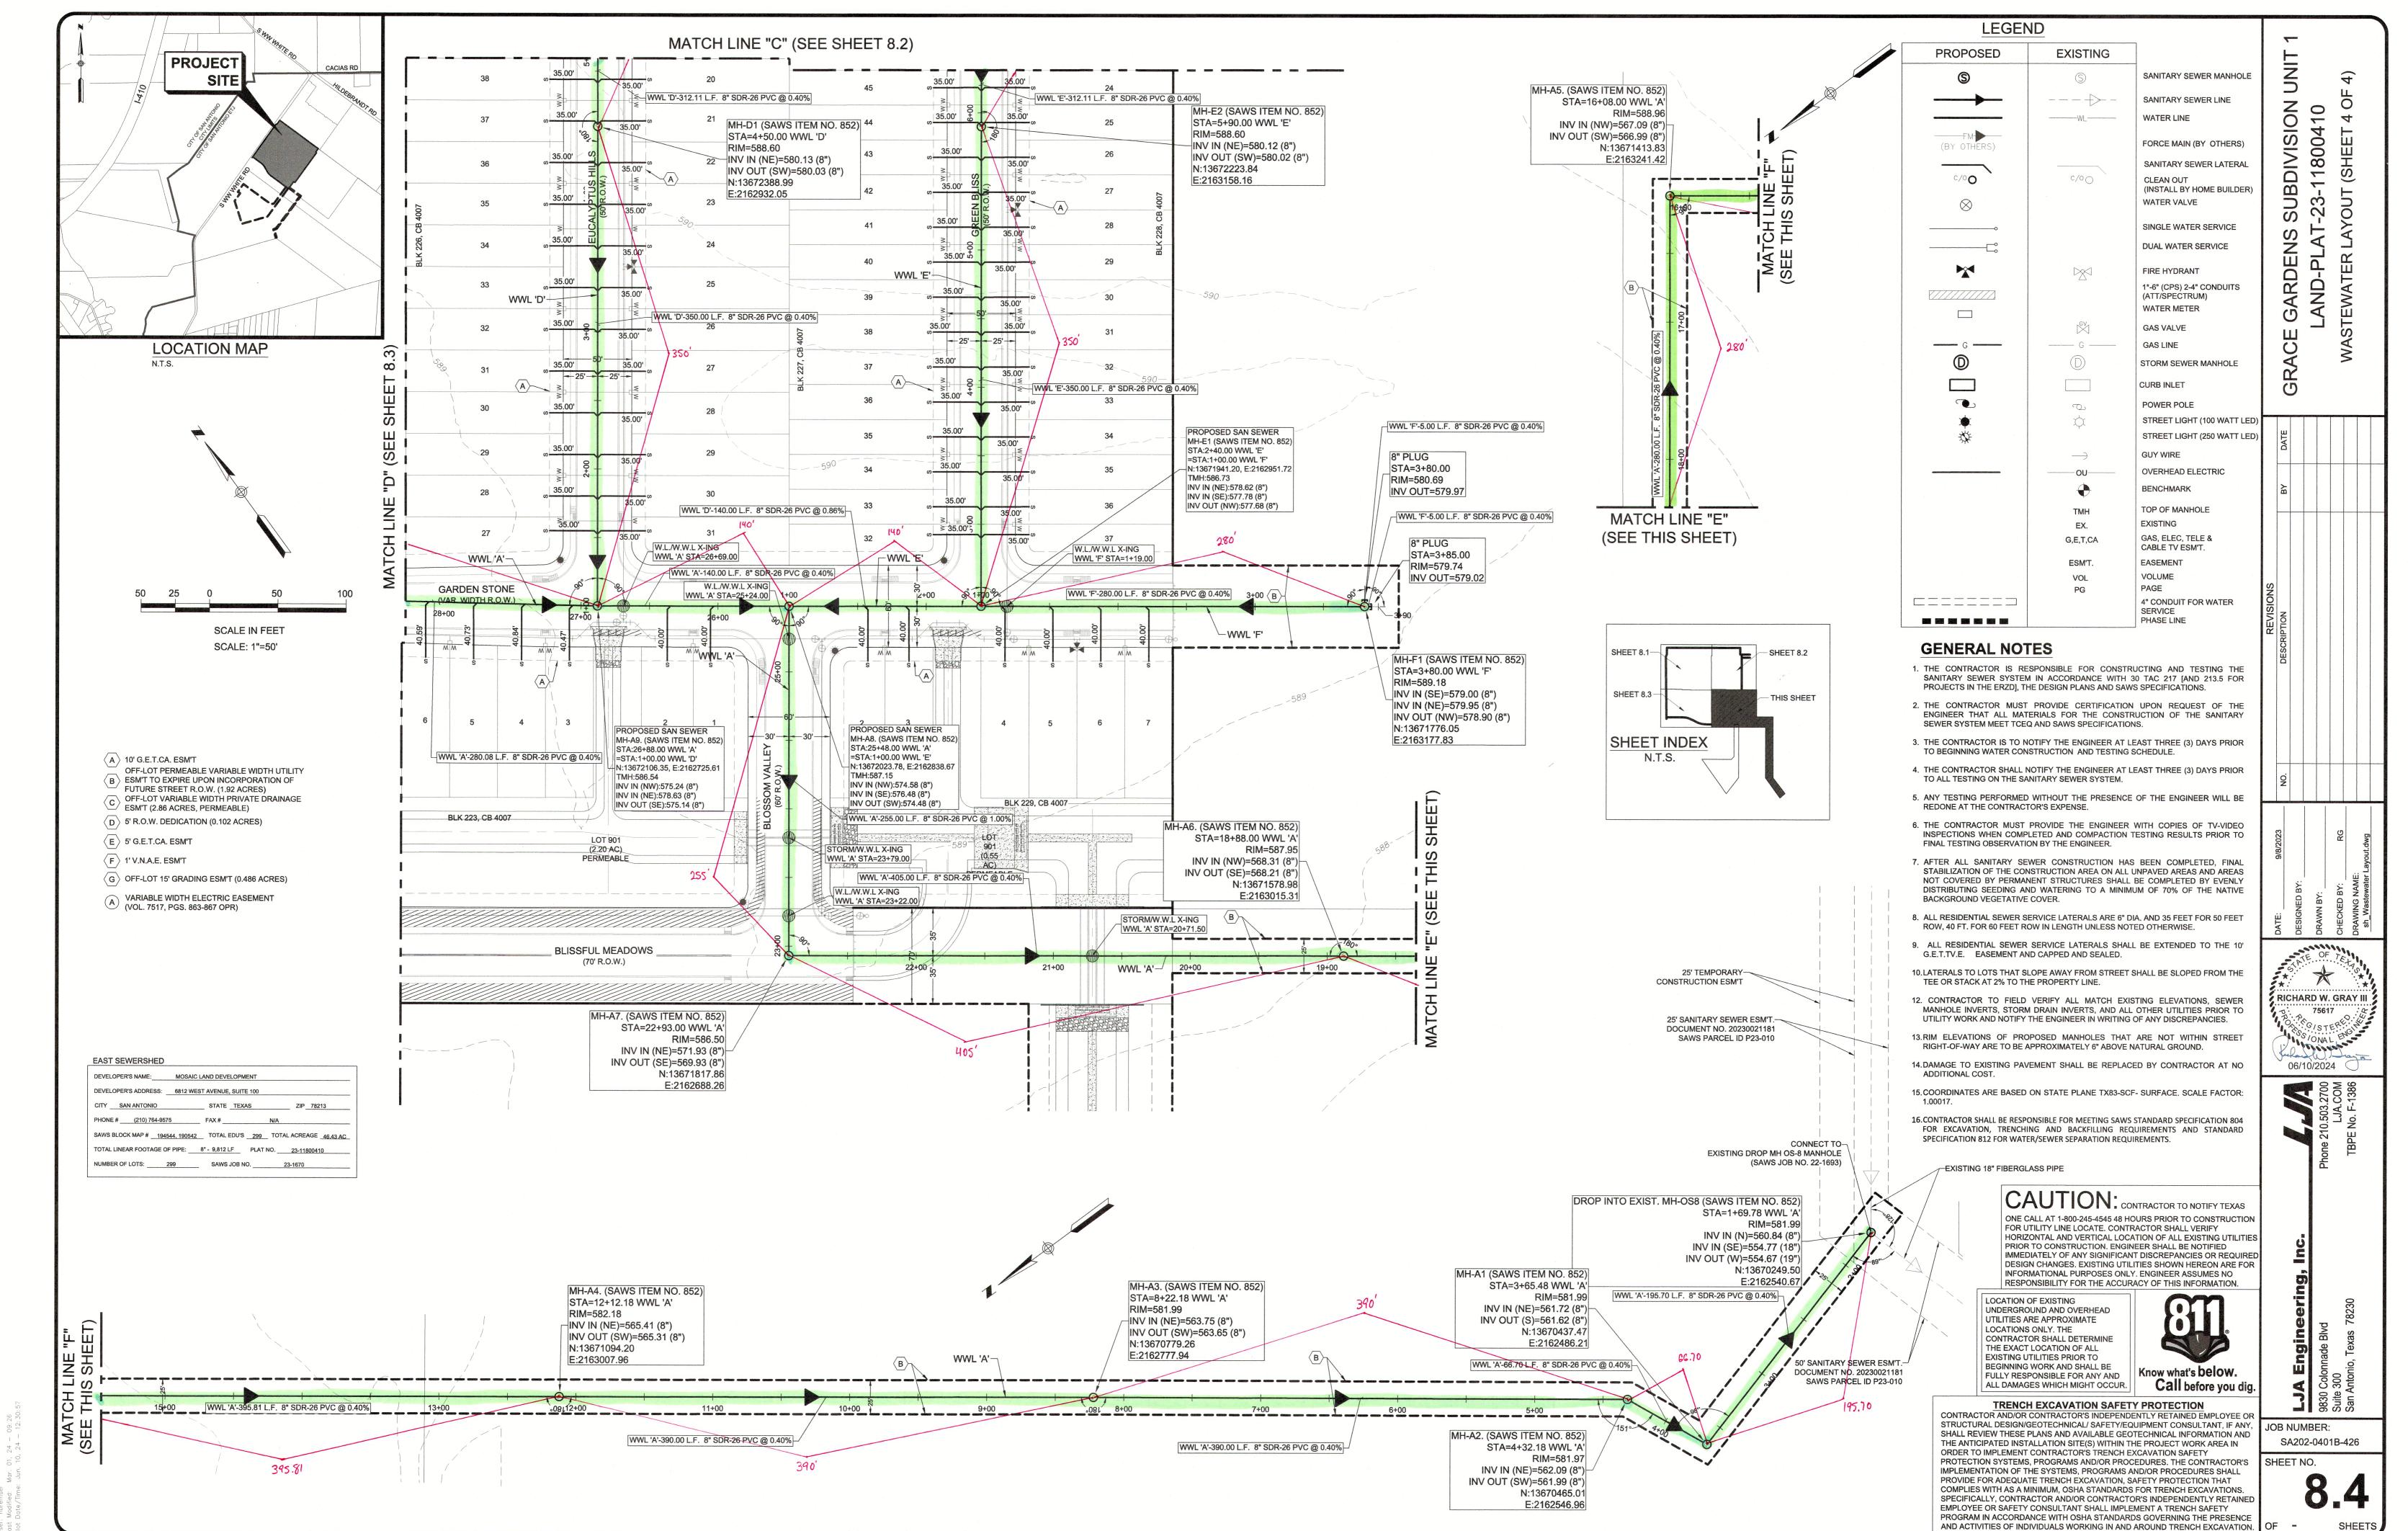

K:\SA202 Mosaic Land Development\0401B Grace Gardens Unit 1\426 Site Development Plo