



Date: Mar 10, 2022, 4:49pm User ID: cburris
File: P:\24\05\01\Design\Civil\DWG 1240501.dwg


THIS DOCUMENT HAS BEEN PRODUCED FROM MATERIAL THAT WAS STORED AND/OR TRANSMITTED ELECTRONICALLY AND MAY HAVE BEEN INADVERTENTLY ALTERED. RELY ONLY ON FINAL HARDCOPY MATERIALS BEARING THE CONSULTANT'S ORIGINAL SIGNATURE AND SEAL. AERIAL IMAGERY PROVIDED BY GOOGLE EARTH UNLESS OTHERWISE NOTED. Imagery © 2016, CAPCO Digital Data, Texas Orthomosaic Program, USDA Farm Service Agency.

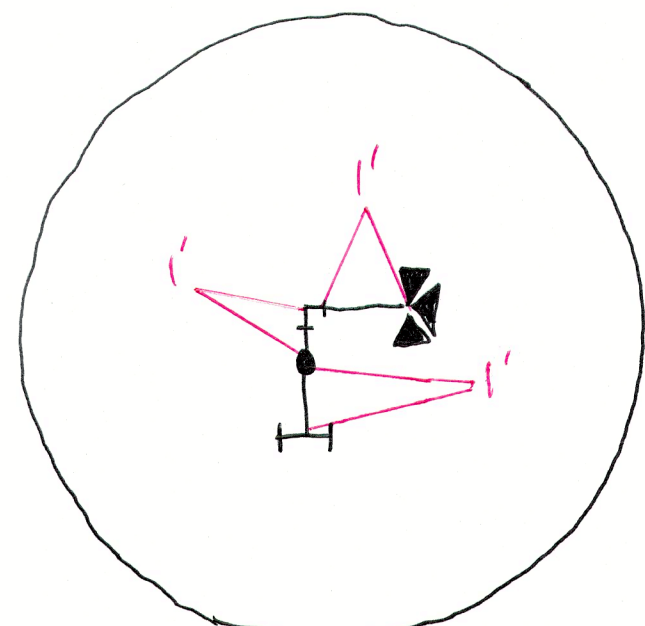

Fire Hydrant Detail (Typ.)

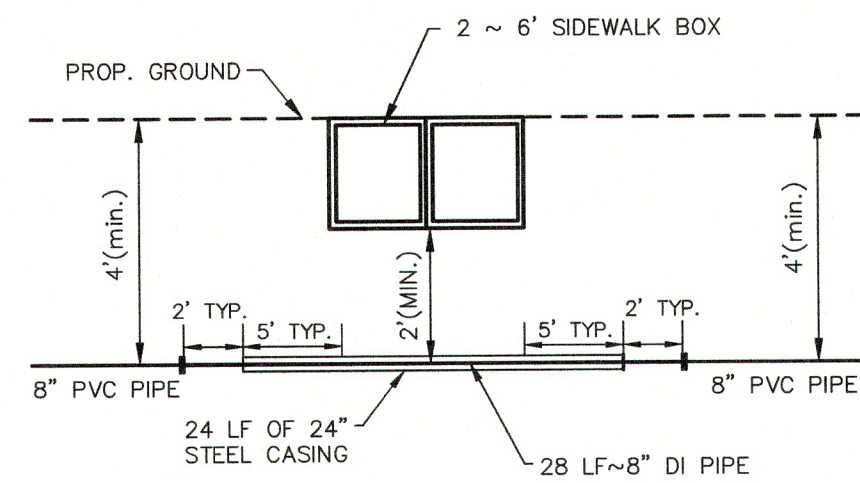

NOTE: ALL RETAINER GLANDS SHALL BE MEG-A-LUG TYPE
WATER/DRAIN CROSSING DETAIL "A"
NOT TO SCALE

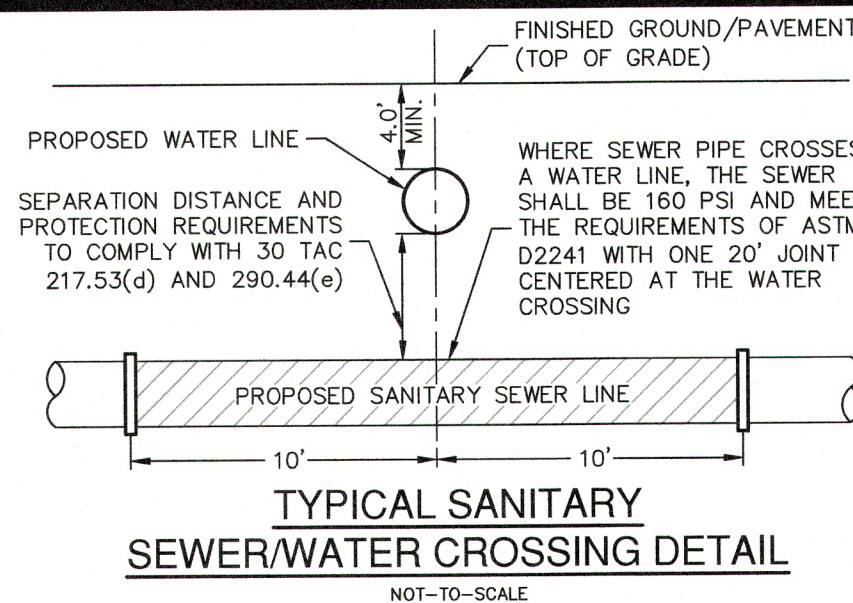


TYPICAL SANITARY
SEWER/WATER CROSSING DETAIL
NOT-TO-SCALE

FIRE FLOW NOTE:


IN AN EFFORT TO MEET THE CITY OF SAN ANTONIO'S FIRE FLOW REQUIREMENTS FOR THE PROPOSED RESIDENTIAL DEVELOPMENT, THE PUBLIC WATER MAIN SYSTEM HAS BEEN DESIGNED FOR A MINIMUM FIRE FLOW DEMAND OF 1500 GPM AT 25 PSI RESIDUAL PRESSURE. THE FIRE FLOW REQUIREMENTS FOR INDIVIDUAL STRUCTURES WILL BE REVIEWED DURING THE BUILDING PERMIT PROCESS IN ACCORDANCE WITH THE PROCEDURES SET FORTH BY THE CITY OF SAN ANTONIO DIRECTOR OF DEVELOPMENT SERVICES DEPARTMENT AND THE SAN ANTONIO FIRE DEPARTMENT FIRE MARSHAL.

ROW PERMIT NOTE:


A BEXAR COUNTY PERMIT MUST BE OBTAINED BEFORE WORKING IN BEXAR COUNTY RIGHTS-OF-WAY.

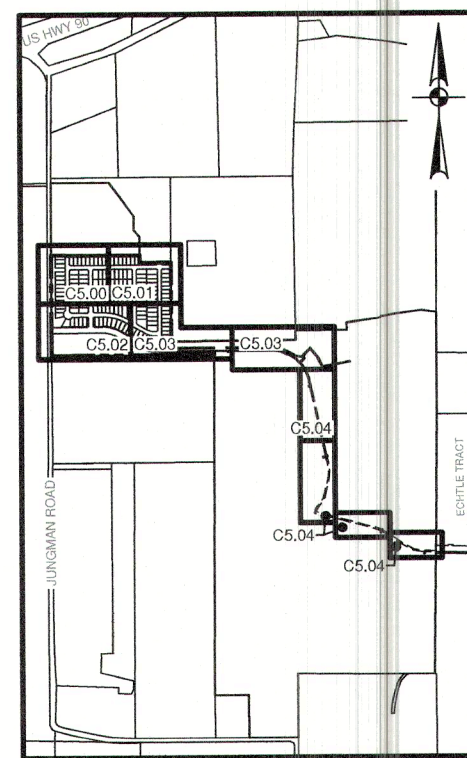

INDEX MAP
NOT-TO-SCALE

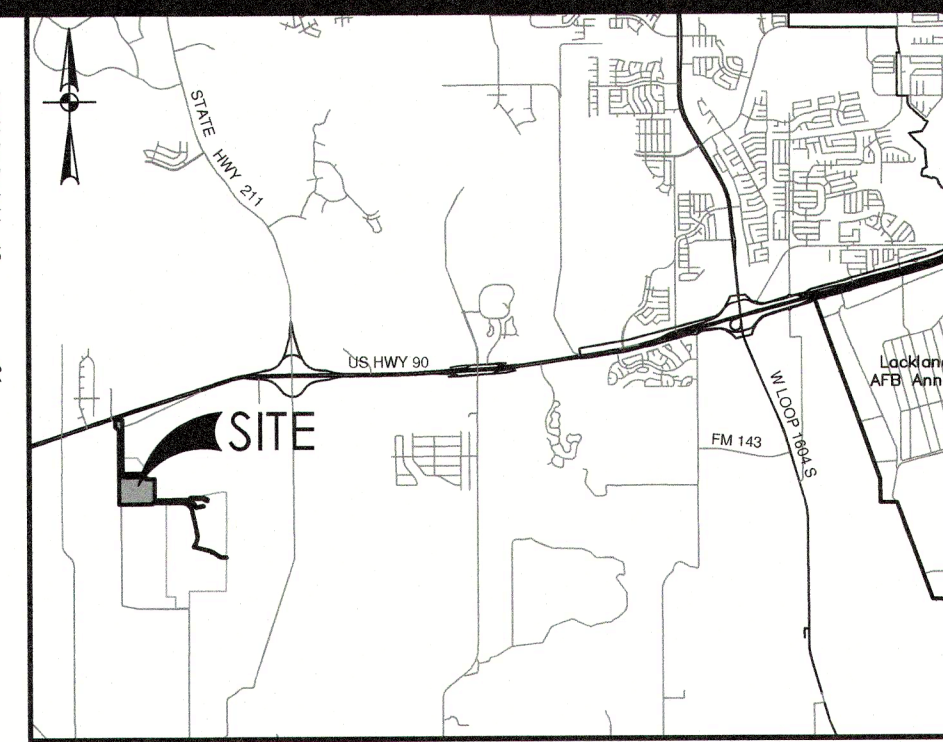

LOCATION MAP
NOT-TO-SCALE

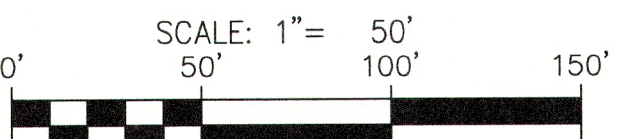

WATER LEGEND

PROJECT LIMITS	---
EXISTING WATER	---
EXISTING SEWER	---
PROPOSED SEWER	---
PROPOSED WATER	---
PROPOSED 3/4" SINGLE SERVICE WITH 5/8" METER	---
SINGLE IRRIGATION SERVICE 3/4" SERVICE WITH 5/8" METER	---
SINGLE IRRIGATION SERVICE 1" SERVICE WITH 1" METER	---
JOINT RESTRAINT	---
VEHICULAR NON-ACCESS EASEMENT	---
1-1/2" METER AND METER BOX	---
1-1/2" TAP WITH SERVICE SADDLE	---
OFFSITE WATERLINE NOTE:	---
OFFSITE WATER LINE TO BE INSTALLED AT 6' BELOW EXISTING GROUND	---
OFFSITE WATER LINE TO BE INSTALLED AT 8.5' BELOW EXISTING GROUND	---

PRESSURE REDUCING VALVE NOTE:

PRESSURE REDUCING VALVE TO BE INSTALLED ON CUSTOMER'S SIDE OF METER BY HOME/BUILDER.

PRESSURE NOTE:

CONTRACTOR TO VERIFY THAT NO PORTION OF THE TRACT IS BELOW GROUND ELEVATION OF 765 FEET WHERE THE STATIC PRESSURE WILL NORMALLY EXCEED 80 PSI. AT ALL SUCH LOCATIONS WHERE THE GROUND LEVEL IS BELOW 765 FEET, THE DEVELOPER OR BUILDER SHALL INSTALL AT EACH LOT, ON THE CUSTOMER'S SIDE OF THE METER, AN APPROVED TYPE PRESSURE REGULATOR IN CONFORMANCE WITH THE PLUMBING CODE OF THE CITY OF SAN ANTONIO. NO DUAL SERVICES ALLOWED FOR ANY LOT(S) IF *PRV IS/ARE REQUIRED FOR SUCH LOT(S), ONLY SINGLE SERVICE CONNECTIONS SHALL BE ALLOWED.
NOTE: A PRESSURE REGULATOR IS ALSO KNOWN AS A PRESSURE REDUCING VALVE (PRV).

JOINT RESTRAINT NOTE:

CONTRACTOR SHALL INSTALL RETAINER GLANDS AT ALL FITTINGS AND PROVIDE JOINT RESTRAINING HARNESSES OR FIELD LOCK GASKETS AT ALL JOINTS WITHIN THE LENGTH SHOWN. CONTRACTOR SHALL INSURE THAT ALL TEES, BENDS, VALVES, ETC. HAVE A MINIMUM OF 5 FT OF PIPE WITH NO JOINTS ON EACH SIDE OF THE FITTING. JOINT RESTRAINTS AND RETAINER GLANDS SHALL BE CALCULATED BY SAWS APPROVED PROGRAMS. THERE WILL BE NO SEPARATE PAY ITEM FOR RETAINER GLANDS AND OTHER JOINT RESTRAINING HARNESSES AND GASKETS, BUT SHALL BE SUBSIDIARY TO THE UNIT COST PER LINEAL FOOT OF PIPE INSTALLED.

TRENCH EXCAVATION SAFETY PROTECTION:

CONTRACTOR AND/OR CONTRACTOR'S INDEPENDENTLY RETAINED EMPLOYEE OR STRUCTURAL DESIGN/ GEOTECHNICAL/ SAFETY/EQUIPMENT CONSULTANT, IF ANY, SHALL REVIEW THESE PLANS AND ANY AVAILABLE GEOTECHNICAL INFORMATION AND THE ANTICIPATED INSTALLATION SITES WITHIN THE PROJECT WORK AREA IN ORDER TO IMPLEMENT CONTRACTOR'S TRENCH EXCAVATION SAFETY PROTECTION SYSTEMS, PROGRAMS AND /OR PROCEDURES FOR THE PROJECT DESCRIBED IN THE CONTRACT DOCUMENTS. THE CONTRACTOR'S IMPLEMENTATION OF THESE SYSTEMS, PROGRAMS AND/OR PROCEDURES SHALL PROVIDE FOR ADEQUATE TRENCH EXCAVATION SAFETY PROTECTION THAT COMPLY WITH AS A MINIMUM, OSHA STANDARDS FOR TRENCH EXCAVATIONS. SPECIFICALLY, CONTRACTOR AND/OR CONTRACTOR'S INDEPENDENTLY RETAINED EMPLOYEE OR SAFETY CONSULTANT SHALL IMPLEMENT A TRENCH SAFETY PROGRAM IN ACCORDANCE WITH OSHA STANDARDS GOVERNING THE PRESENCE AND ACTIVITIES OF INDIVIDUALS WORKING IN AND AROUND TRENCH EXCAVATION.

WATER (PRESSURE ZONE DSP 950W)

DEVELOPER'S NAME: STARLIGHT HOMES TEXAS, LLC
ADDRESS: 17319 SAN PEDRO AVENUE, SUITE 140
CITY: SAN ANTONIO STATE: TEXAS ZIP: 78232
PHONE# (210) 941-1838 FAX#
SAWS BLOCK MAP# 070550 TOTAL EBU'S 178 TOTAL ACREAGE 40.46
TOTAL LINEAR FOOTAGE OF PIPE: 5,101 LF - 12" PVC
NUMBER OF LOTS 163 SAWS JOB NO. 22-1021




SAN ANTONIO | AUSTIN | HOUSTON | FORT WORTH | DALLAS
2000 NW LOOP 410 | SAN ANTONIO, TX 78213 | 210.375.9000
TEXAS ENGINEERING FIRM #470 | TEXAS SURVEYING FIRM #10028600

JUNGMAN TRACT UNIT-1
SAN ANTONIO, TEXAS

OVERALL WATER DISTRIBUTION PLAN
DATE: 8-8-23
BY: [Signature]
CHECKED BY: [Signature]
DESIGNED BY: [Signature]

PLAT NO. 21-11800652
JOB NO. 12405-01
DATE JANUARY 2022
DESIGNER CB
CHECKED BS DRAWN BR
SHEET C5.00

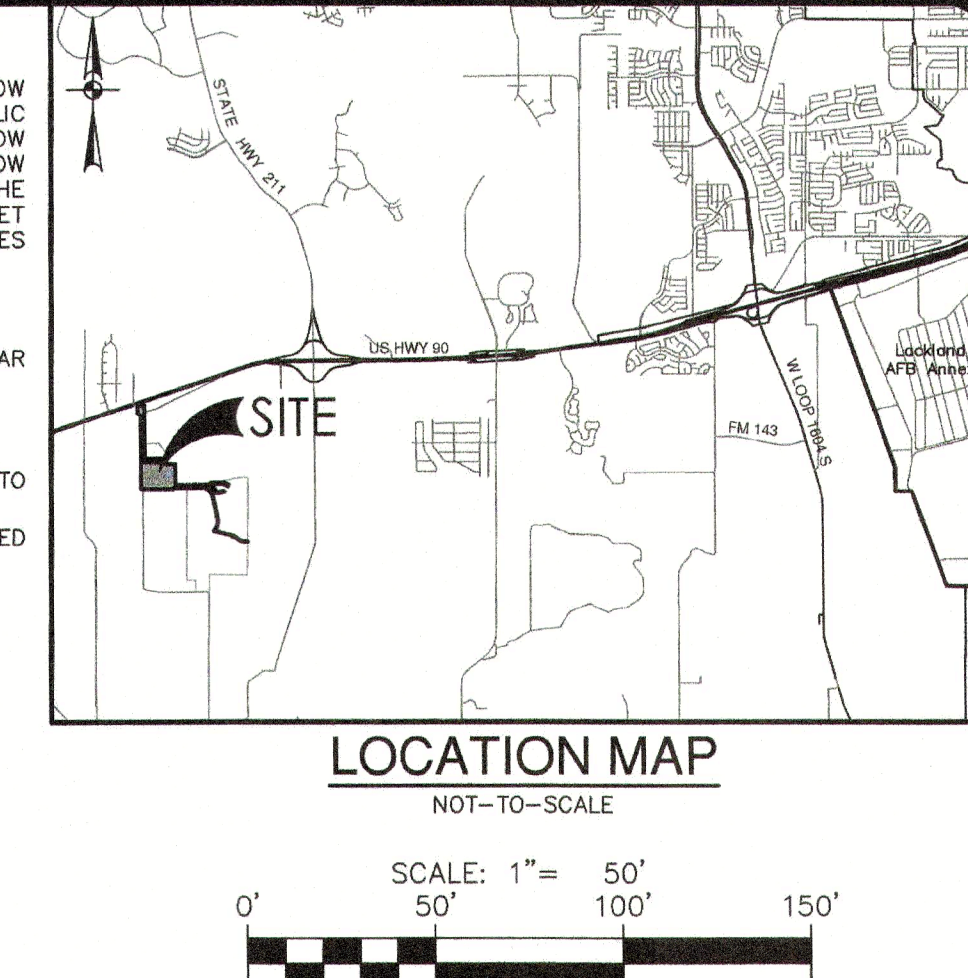

WATER LEGEND

PROJECT LIMITS
EXISTING WATER
EXISTING SEWER
PROPOSED SEWER
PROPOSED WATER

SINGLE 3/4" SINGLE SERVICE
WITH 5/8" METER

SINGLE IRRIGATION SERVICE
3/4" SERVICE WITH 5/8" METER

SINGLE IRRIGATION SERVICE
1" SERVICE WITH 1" METER

JOINT RESTRAINT

VEHICULAR NON-ACCESS EASEMENT

1-1" METER AND METER BOX
1-1" TAP WITH SERVICE SADDLE

OFFSITE WATERLINE NOTE:
OFFSITE WATER LINE TO BE INSTALLED
AT 6" BELOW EXISTING GROUND

~~VARIABLE WIDTH LINE TO BE INSTALLED
AT 6" BELOW EXISTING GROUND~~

VAR WID CVE

FINISHED GROUND/PAVEMENT
(TOP OF GRADE)

PROPOSED WATER LINE

SEPARATION DISTANCE AND
PROTECTION REQUIREMENTS
TO COMPLY WITH 30 TAC
217.53(a) AND 290.44(a)

WHERE SEWER PIPE CROSSES
A WATER LINE, THE SEWER
SHALL BE 180 PSI AND MEET
THE REQUIREMENTS OF ASTM
D2241 WITH ONE 20" JOINT
CENTERED AT THE WATER
CROSSING

PROPOSED SANITARY SEWER LINE

10' 10'

TYPICAL SANITARY

SEWER/WATER CROSSING DETAIL

NOT-TO-SCALE

PRESSURE REDUCING VALVE NOTE:

PRESSURE REDUCING VALVE TO BE INSTALLED ON CUSTOMER'S SIDE OF METER BY HOMEOWNER.

PRESSURE NOTE:

CONTRACTOR TO VERIFY THAT NO PORTION OF THE SITE IS BELOW GROUND ELEVATION OF 765 FEET WHERE THE STATIC PRESSURE WILL NORMALLY EXCEED 80 PSI. AT ALL SUCH LOCATIONS WHERE THE GROUND LEVEL IS BELOW 765 FEET, THE DEVELOPER OR BUILDER SHALL INSTALL AT LEAST ONE (1) PORT ON THE CUSTOMER'S SIDE OF THE METER, AN APPROVED TYPE PRESSURE REGULATOR IN CONFORMANCE WITH THE PLUMBING CODE OF THE CITY OF SAN ANTONIO. NO DUAL SERVICES ALLOWED FOR ANY SINGLE LOT. IF PRV IS NOT REQUIRED FOR SUCH LOT(S), ONLY SINGLE SERVICE CONNECTIONS SHALL BE ALLOWED.

*NOTE: A PRESSURE REGULATOR IS ALSO KNOWN AS A PRESSURE REDUCING VALVE (PRV).

JOINT RESTRAINT NOTE:

CONTRACTOR SHALL INSTALL RETAINER GLANDS AT ALL FITTINGS AND PROVIDE JOINT RESTRAINING HARNESSSES OR FIELD LOCK GASKETS AT ALL JOINTS WITHIN THE LENGTH SHOWN. CONTRACTOR SHALL INSURE THAT ALL TEES, BONDS, VALVES, ETC. HAVE A MINIMUM OF 5 FT OF PIPE WITH NO JOINTS ON EACH SIDE OF THE FITTING. JOINT RESTRAINTS AND RETAINER GLANDS SHALL BE CALCULATED BY SAWS APPROVED PROGRAMS. THERE WILL BE NO SEPARATE PAY ITEM FOR RETAINER GLANDS AND OTHER JOINT RESTRAINING HARNESSSES AND GASKETS, BUT SHALL BE SUBSIDIARY TO THE UNIT COST PER LINEAL FOOT OF PIPE INSTALLED.



TRENCH EXCAVATION SAFETY PROTECTION:

CONTRACTOR AND/OR CONTRACTOR'S INDEPENDENTLY RETAINED EMPLOYER OR STRUCTURAL DESIGN/ GEOTECHNICAL/ SAFETY/EQUIPMENT CONSULTANT IF ANY, SHALL REVIEW THESE PLANS AND ANY AVAILABLE GEOTECHNICAL INFORMATION AND THE ANTICIPATED INSTALLATION SITES WITHIN THE PROJECT WORK AREA IN ORDER TO IMPLEMENT CONTRACTOR'S TRENCH EXCAVATION SAFETY PROTECTION SYSTEMS, PROGRAMS AND/OR PROCEDURES FOR THE PROJECT DESCRIBED IN THE CONTRACT DOCUMENTS. THE CONTRACTOR'S IMPLEMENTATION OF THESE SYSTEMS, PROGRAMS AND/OR PROCEDURES SHALL PROVIDE FOR ADEQUATE TRENCH EXCAVATION SAFETY PROTECTION THAT COMPLY WITH THE MINIMUM OSHA STANDARDS FOR TRENCH EXCAVATIONS. SPECIFICALLY, CONTRACTOR AND/OR CONTRACTOR'S INDEPENDENTLY RETAINED EMPLOYEE OR SAFETY CONSULTANT SHALL IMPLEMENT A TRENCH SAFETY PROGRAM IF ANY ACTIVITY TAKES PLACE WITHIN A TRENCH. THE PRESENCE AND ACTIVITIES OF INDIVIDUALS WORKING IN AND AROUND TRENCH EXCAVATION.

WATER (PRESSURE ZONE DSP 950W)

DEVELOPER'S NAME: STARLIGHT HOMES TEXAS, LLC	
ADDRESS: 17319 SAN PEDRO AVENUE, SUITE 140	
CITY: SAN ANTONIO	STATE: TEXAS ZIP: 78232
PHONE: (210)941-1838	FAX:
SAWS BLOCK PAGE 070550_TOTAL EDU'S 178 TOTAL ACREAGE 40.46	
TOTAL LINEAR FOOTAGE OF PIPE=18005.67' PLAT NO.21-1800567	
NUMBER OF LOTS: 163	SAWS JOB NO. 22-1021

[illegible]

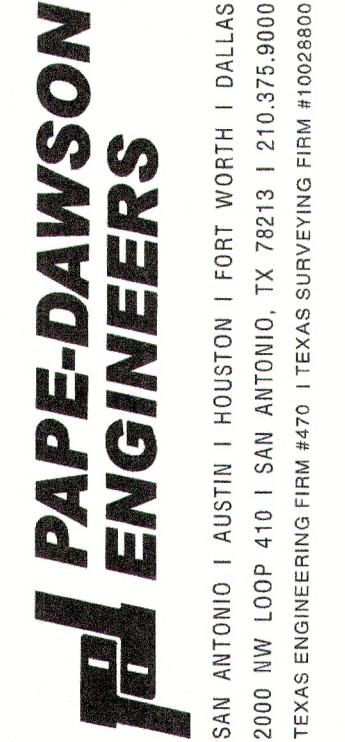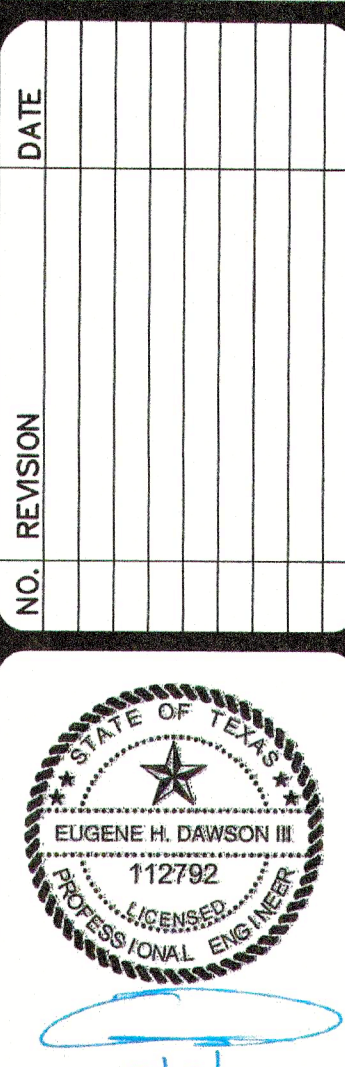

JUNGMAN TRACT UNIT-1
SAN ANTONIO, TEXAS

OVERALL WATER DISTRIBUTION PLAN

PLAT NO. 21-11800652
 JOB NO. 12405-01
 DATE JANUARY 2022
 DESIGNER CB
 CHECKED BS DRAWN BR
 SHEET C5.04