
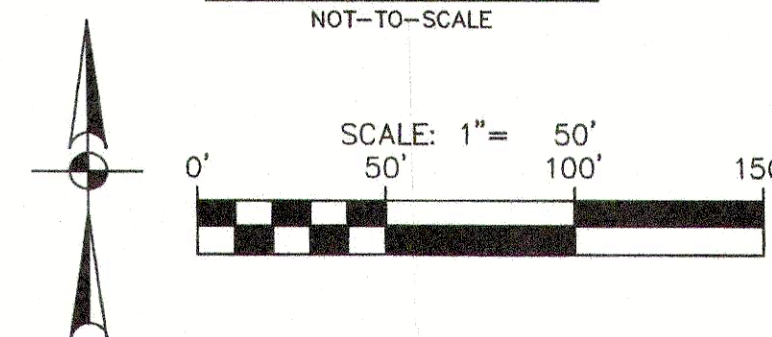
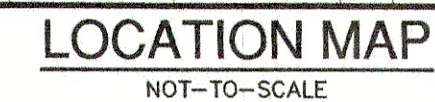


A BEXAR COUNTY PERMIT MUST BE OBTAINED BEFORE WORKING IN BEXAR COUNTY RIGHTS-OF-WAY.

[illegible]

DEVELOPER'S NAME: STARLIGHT HOMES TEXAS, LLC
ADDRESS: 17319 SAN PEDRO AVENUE, SUITE 140
CITY: SAN ANTONIO STATE: TEXAS ZIP: 78232
PHONE# (210)941-1838 EMAIL
SAWS BLOCK MAP# 070550 TOTAL EDU'S 134 TOTAL ACREAGE 29.35
TOTAL LINEAR FOOTAGE OF PIPE: 4,284 LF 8" PVC PLAT NO. 22-1180012
NUMBER OF LOTS 128 SAWS JOB NO. 22-1119

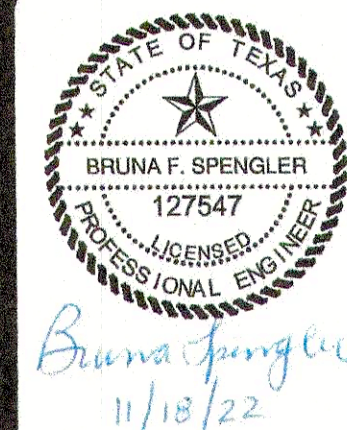

**PAPE-DAWSON
ENGINEERS**

JUNGMAN TRACT UNIT-2
SAN ANTONIO, TEXAS

OVERALL WATER DISTRIBUTION PLAN

PLAT NO. 22-11800112
JOB NO. 12405-02
DATE APRIL 2022
DESIGNER CB
CHECKED BS DRAWN BR
SHEET C5.00