

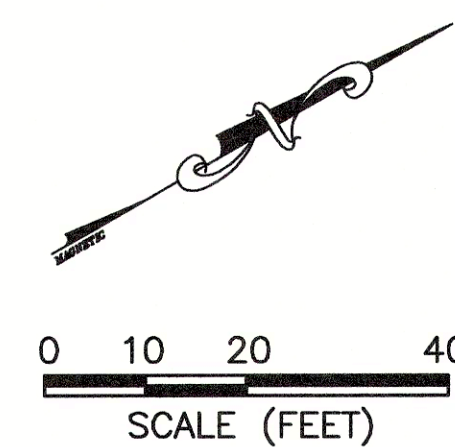
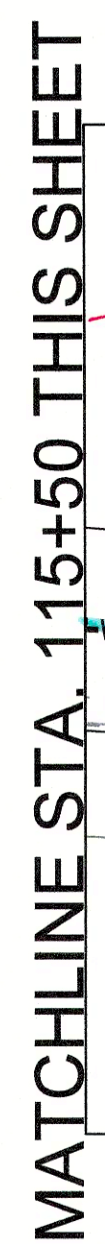


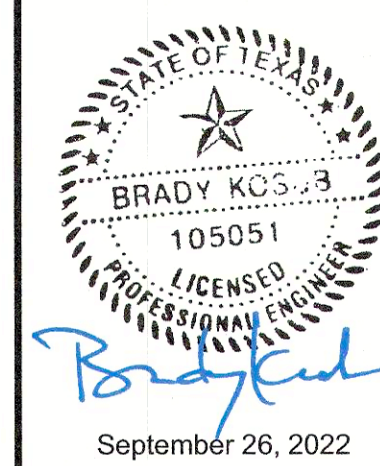

NOTES:
1. REFER TO SHEET G1.0 REGARDING
EXISTING UTILITIES.

TRENCH EXCAVATION SAFETY PROTECTION

CONTRACTOR AND/OR CONTRACTOR'S INDEPENDENTLY RETAINED EMPLOYEE OR STRUCTURAL ENGINEER/GEOTECHNICAL/SAFETY EQUIPMENT CONSULTANT, IF ANY, SHALL PROVIDE THESE SERVICES AND AVAILABLE GEOTECHNICAL INFORMATION AND THE ANTICIPATED INSTALLATION SITES WITHIN THE PROJECT WORK AREA TO THE CITY OF LOS ANGELES CONTRACTOR'S TRENCH EXCAVATION SAFETY PROTECTION SYSTEMS, PROGRAMS, AND PROCEDURES IN ORDER TO IMPLEMENT THE CITY OF LOS ANGELES CONTRACTOR'S IMPLEMENTATION OF THESE SYSTEMS, PROGRAMS AND/OR PROCEDURES SHALL BE REQUIRED TO ADOPT THE CITY OF LOS ANGELES CONTRACTOR'S TRENCH EXCAVATION SAFETY PROTECTION THAT COMPLIES WITH AS A MINIMUM, OSHA STANDARDS FOR CONSTRUCTION ENVIRONMENTS, AND THE CITY OF LOS ANGELES SPECIFICALLY, CONTRACTOR AND/OR CONTRACTOR'S INDEPENDENTLY RETAINED EMPLOYEE OR SAFETY CONSULTANT SHALL BE REQUIRED TO TRAIN ALL PERSONNEL IN ACCORDANCE WITH OSHA STANDARDS GOVERNING THE PRESENCE AND ACTIVITIES OF PERSONNEL WORKING IN AND AROUND TRENCH EXCAVATION.

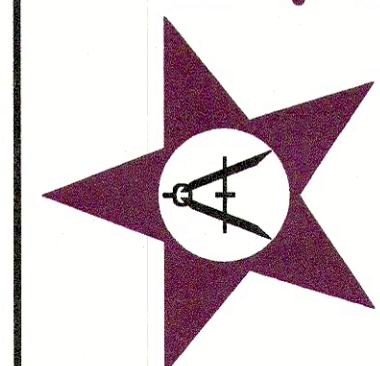

**KYNDWOOD SUBDIVISION WATER
MAIN EXTENSION**

WATERLINE PLAN STA. 110+50
TO STA. 120+50

JOB: 14CCSUD001		
DATE: AUGUST 2022		
DRAWN: KJV	PM:	CP
DESIGN: CB	DM:	BK
PEER:	OTHER:	
REVISIONS:		
DELTA	DESCRIPTION	DATE


SHEET:

WM1.1


Date: Sep 26, 2022, 9:30am User ID: krogler
File: S:\Active Projects\14CCSUD001 - General Engineering Services\2021-10 Kyndwood WL\wg14ccs\UD01-KV WATER MAIN-003.dwg

MATCHLINE STA. 125+50 THIS SHEET

MATCHLINE STA. 120+50 SEE SHEET WM1.1

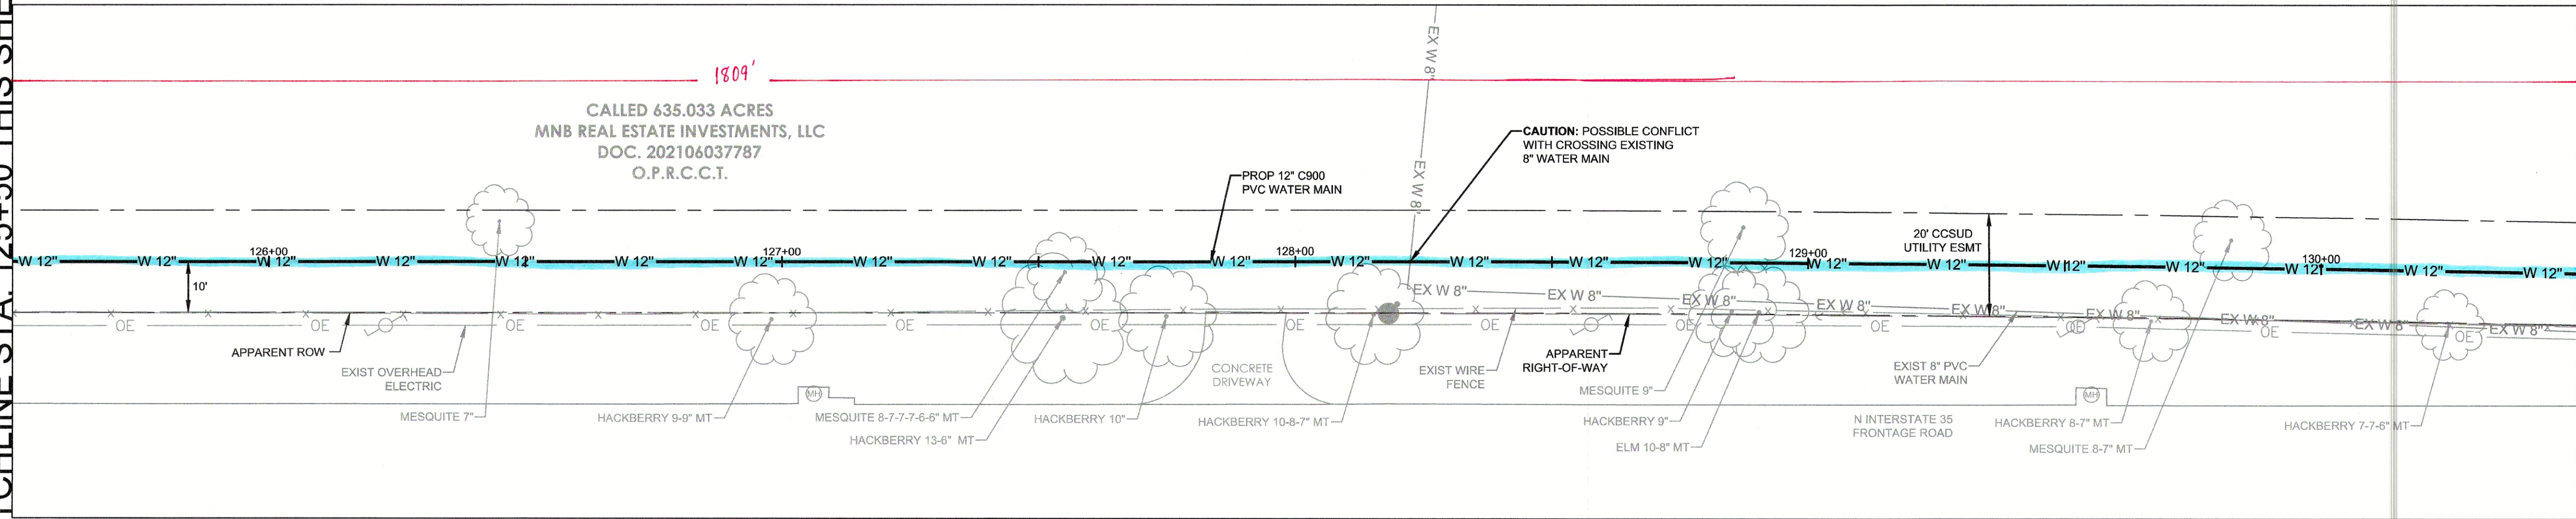


MATCHLINE STA. 130+50 SEE SHEET WM1.3

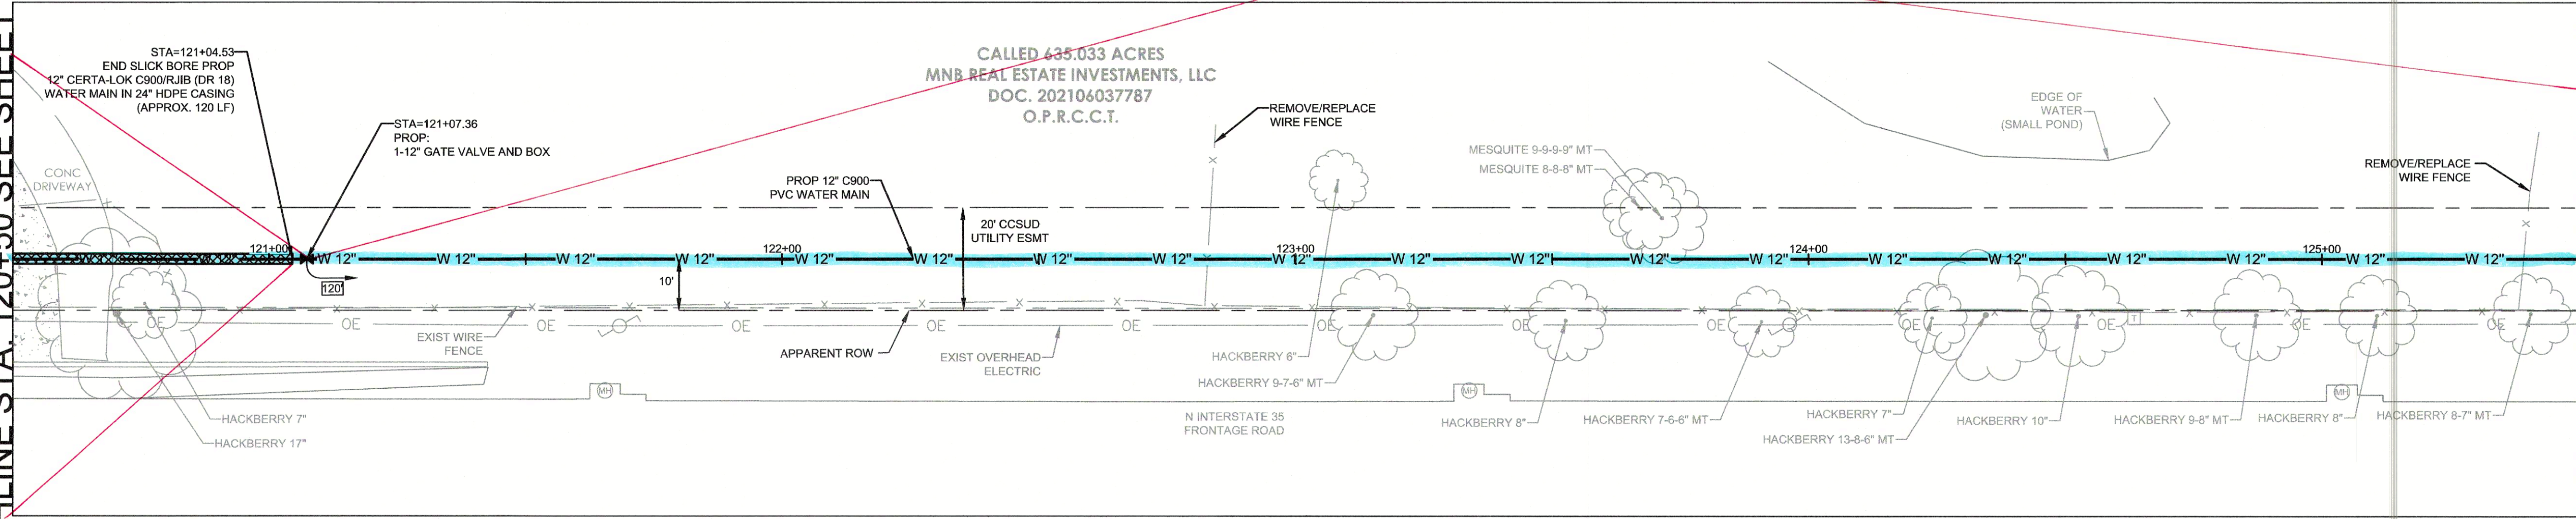

MATCHLINE STA. 125+50 THIS SHEET

NOTES:
1. REFER TO SHEET G1.0 REGARDING EXISTING UTILITIES.

TRENCH EXCAVATION SAFETY PROTECTION
CONTRACTOR AND/OR CONTRACTOR'S INDEPENDENTLY RETAINED EMPLOYEE OR STRUCTURAL DESIGN/GEOTECHNICAL/SAFETY EQUIPMENT CONSULTANT, IF ANY, SHALL REVIEW THESE PLANS AND AVAILABLE GEOTECHNICAL INFORMATION AND THE ANTICIPATED INSTALLATION SITES WITHIN THE PROJECT WORK AREA IN ORDER TO IMPLEMENT CONTRACTOR'S TRENCH EXCAVATION SAFETY PROTECTION SYSTEMS, PROGRAMS, AND/OR PROCEDURES. THE CONTRACTOR'S IMPLEMENTATION OF THESE SYSTEMS, PROGRAMS AND/OR PROCEDURES SHALL PROVIDE FOR ADEQUATE TRENCH EXCAVATION SAFETY PROTECTION THAT COMPLIES WITH AS A MINIMUM, OSHA STANDARDS FOR TRENCH EXCAVATIONS. SPECIFICALLY, CONTRACTOR AND/OR CONTRACTOR'S INDEPENDENTLY RETAINED EMPLOYEE OR SAFETY CONSULTANT SHALL IMPLEMENT A TRENCH SAFETY PROGRAM IN ACCORDANCE WITH OSHA STANDARDS GOVERNING THE PRESENCE AND ACTIVITIES OF INDIVIDUALS WORKING IN AND AROUND TRENCH EXCAVATION.

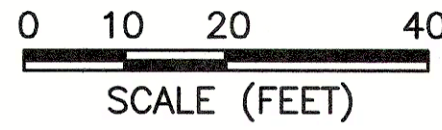


KYNDWOOD SUBDIVISION WATER MAIN EXTENSION

WATERLINE PLAN STA. 120+50 TO STA. 130+50

JOB: 14CCSUD001	
DATE: AUGUST 2022	
DRAWN: KJV	PM: CP
DESIGN: CB	DM: BK
PEER:	OTHER:
REVISIONS:	
DELTA	DESCRIPTION DATE

SHEET:


WM1.2

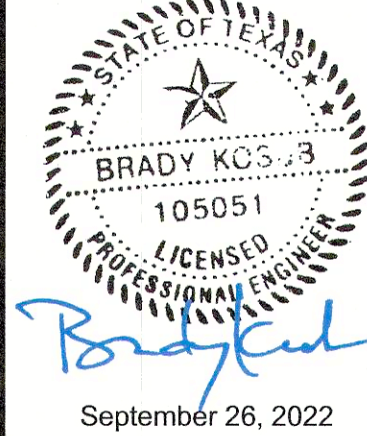


Dates: Sep 26, 2022, 9:30am User ID: kvogler
File: S:\Active Projects\14CCSUD001 - General Engineering Services\2021-10 Kyndwood WL.kwg\14CCSUD001-KW VAWATER MAIN-004.dwg

MATCHLINE STA. 135+50 THIS SHEET

MATCHLINE STA. 130+50 SEE SHEET WM1.2

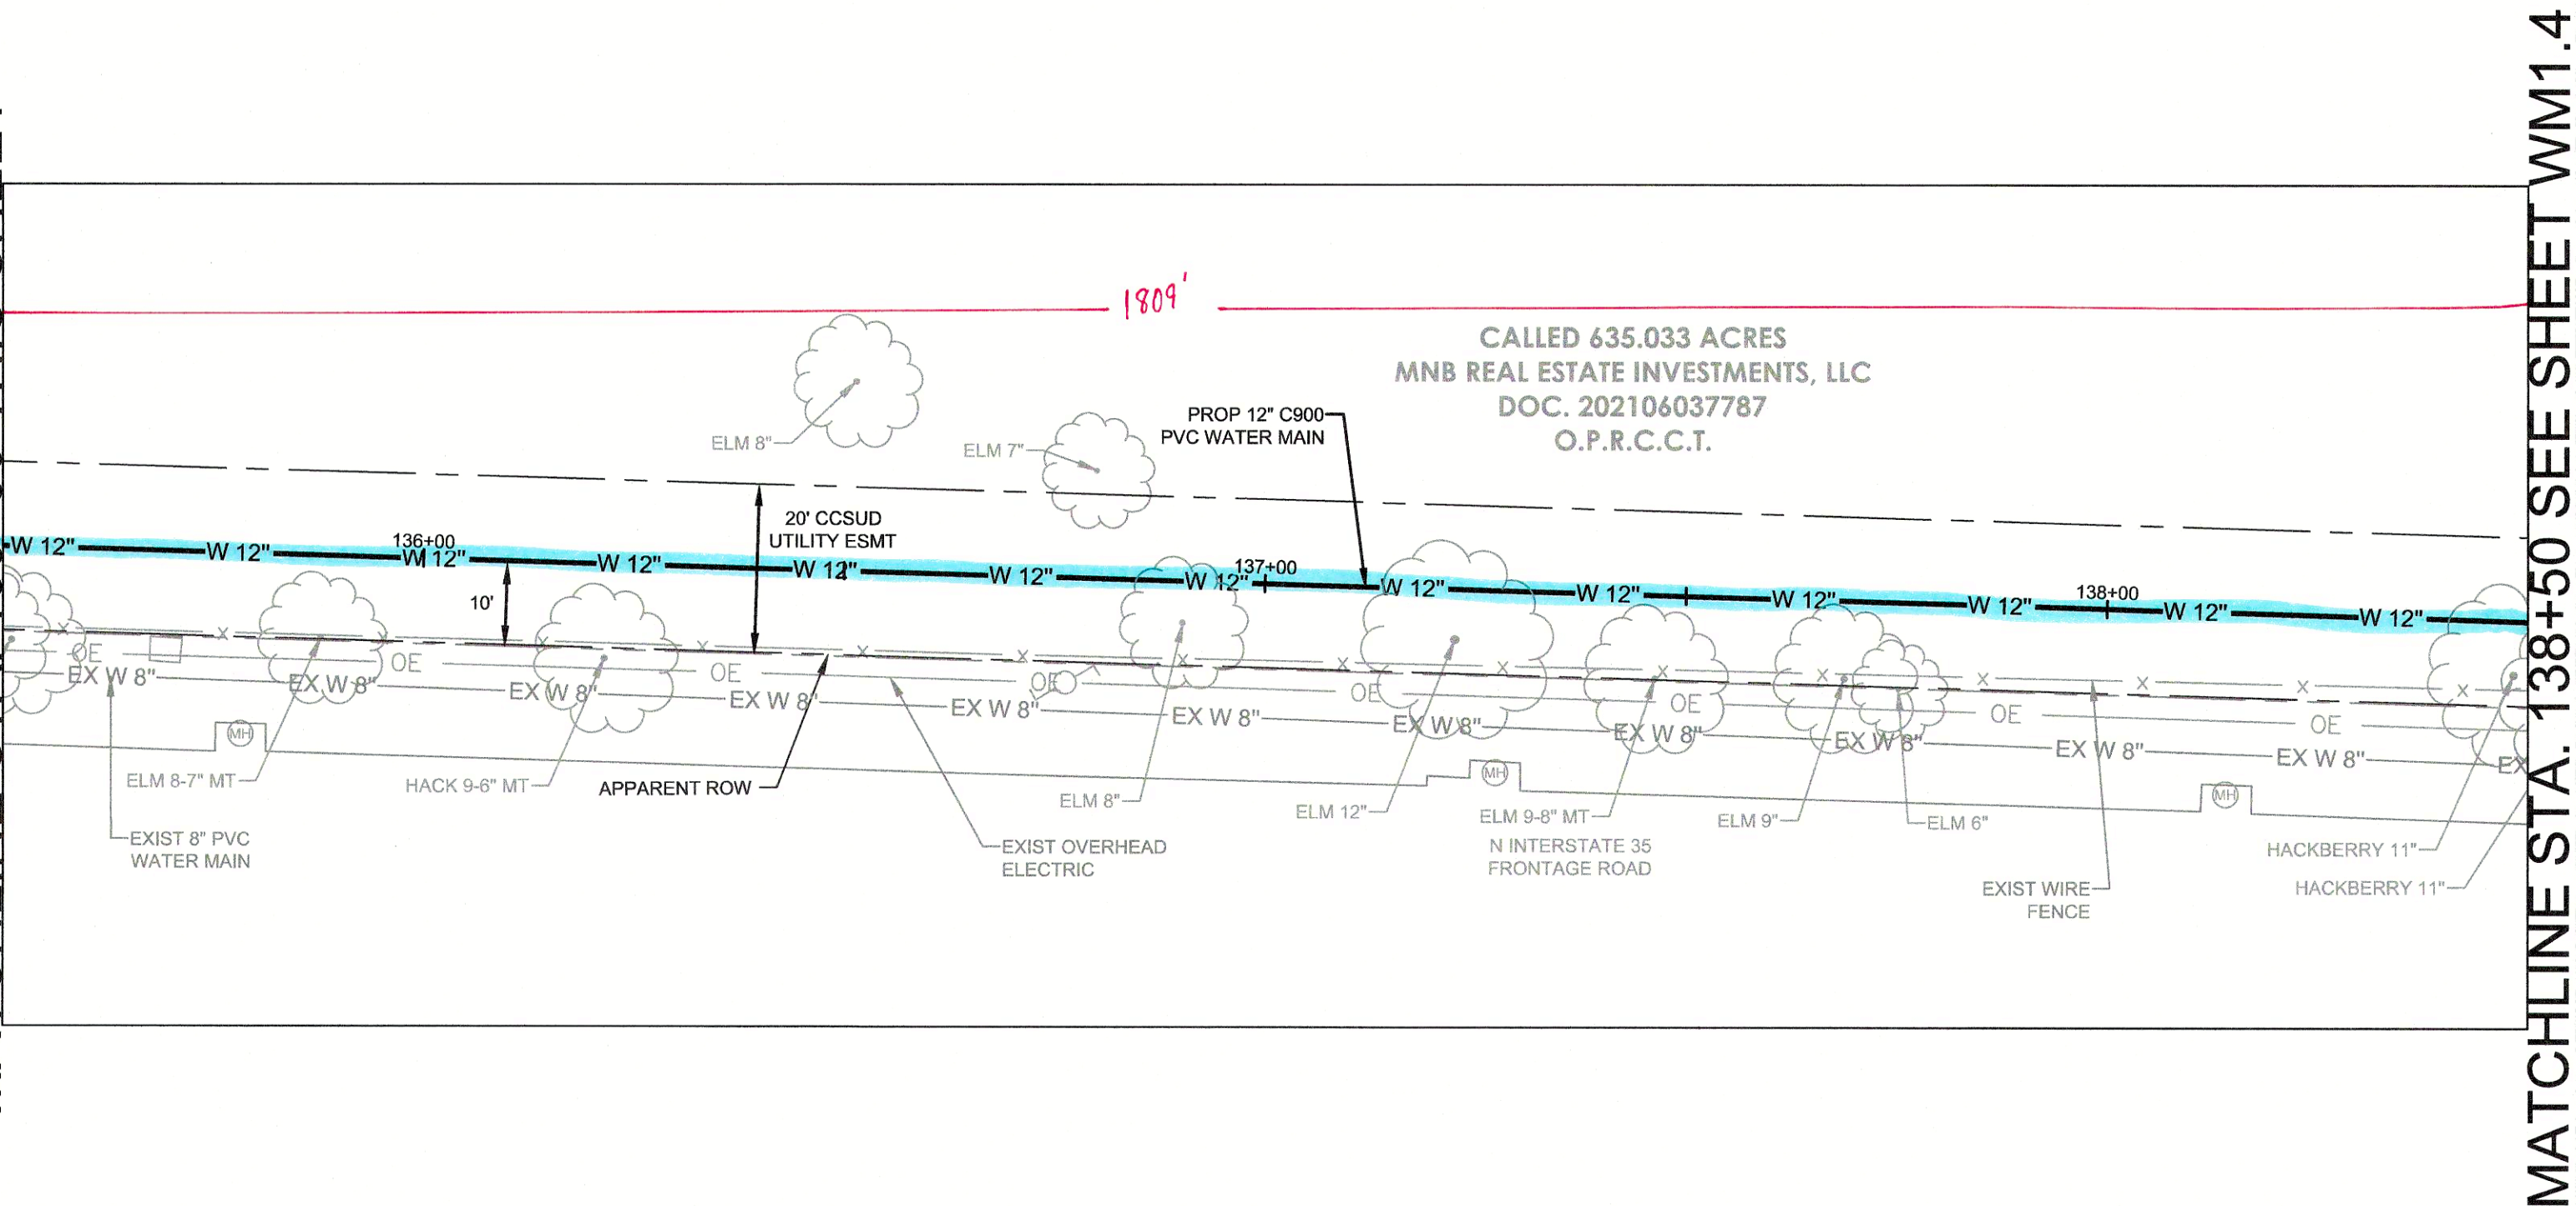


MATCHLINE STA. 138+50 SEE SHEET WM1.4

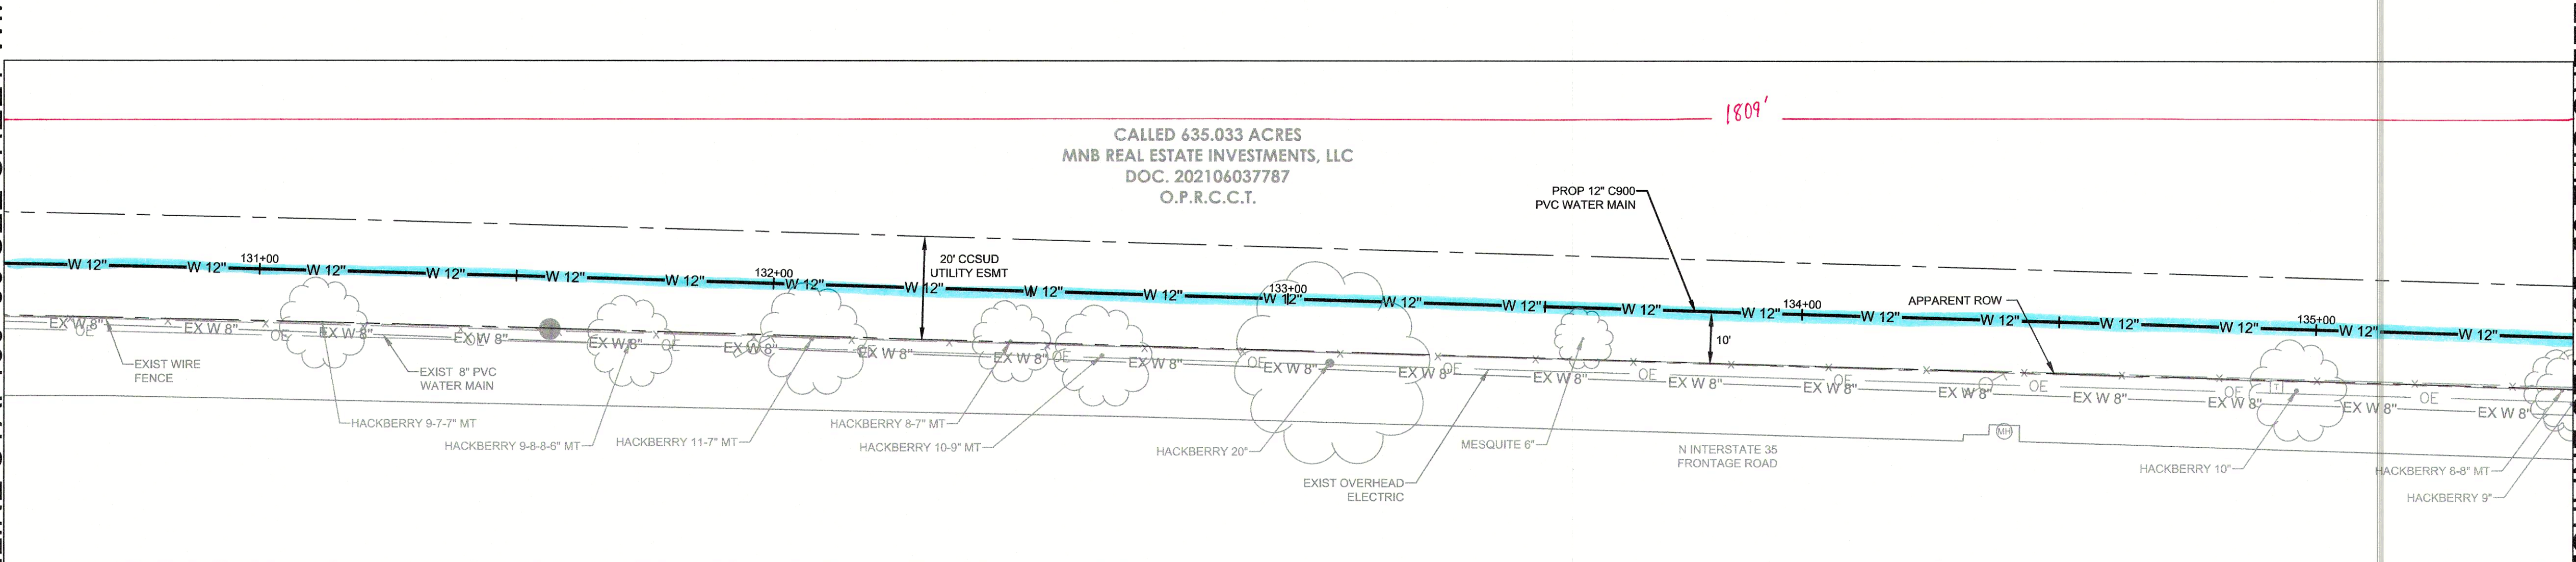

MATCHLINE STA. 135+50 THIS SHEET

NOTES:
1. REFER TO SHEET G1.0 REGARDING EXISTING UTILITIES.

TRENCH EXCAVATION SAFETY PROTECTION
CONTRACTOR AND/OR CONTRACTOR'S INDEPENDENTLY RETAINED EMPLOYEE OR STRUCTURAL DESIGN/GEOTECHNICAL/SAFETY EQUIPMENT CONSULTANT, IF ANY, SHALL REVIEW THESE PLANS AND AVAILABLE GEOTECHNICAL INFORMATION AND THE ANTICIPATED INSTALLATION SITES WITHIN THE PROJECT WORK AREA IN ORDER TO IMPLEMENT CONTRACTOR'S TRENCH EXCAVATION SAFETY PROTECTION SYSTEMS, PROGRAMS, AND/OR PROCEDURES. THE CONTRACTOR'S IMPLEMENTATION OF THESE SYSTEMS, PROGRAMS AND/OR PROCEDURES SHALL PROVIDE FOR ADEQUATE TRENCH EXCAVATION SAFETY PROTECTION THAT COMPLIES WITH AS A MINIMUM, OSHA STANDARDS FOR TRENCH EXCAVATIONS. SPECIFICALLY, CONTRACTOR AND/OR CONTRACTOR'S INDEPENDENTLY RETAINED EMPLOYEE OR SAFETY CONSULTANT SHALL IMPLEMENT A TRENCH SAFETY PROGRAM IN ACCORDANCE WITH OSHA STANDARDS GOVERNING THE PRESENCE AND ACTIVITIES OF INDIVIDUALS WORKING IN AND AROUND TRENCH EXCAVATION.

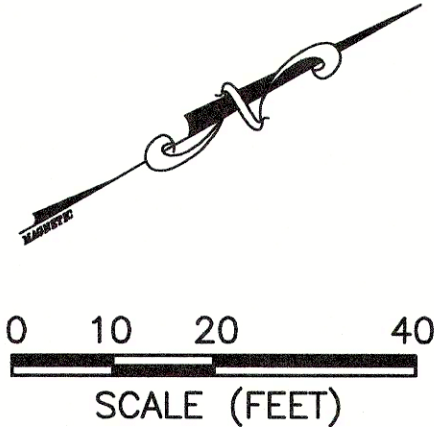

KYNDWOOD SUBDIVISION WATER MAIN EXTENSION


WATERLINE PLAN STA. 130+50 TO STA. 138+50

JOB: 14CCSUD001	
DATE: AUGUST 2022	
DRAWN: KJV	PM: CP
DESIGN: CB	DM: BK
PEER:	OTHER:
REVISIONS:	
DELTA	DESCRIPTION DATE

SHEET:


WM1.3

M&S ENGINEERING
ELECTRICAL | CIVIL | MEP
TXENG FIRM # F-1394 | TBPELS FIRM #10169800
WWW.MSENGR.COM | (850) 228-5446

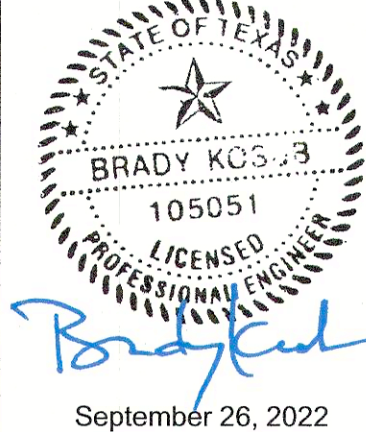

Date: Sep 26, 2022 9:30am User: JD_Krogler
File: S:\Active Projects\14CCSUD001 - Kyndwood Waterline\14CCSUD001-KW WATER MAIN.dwg

CALLLED 635.033 ACRES
MMB REAL ESTATE INVESTMENTS, LLC
DOC. 202106037787
O.P.R.C.C.T.

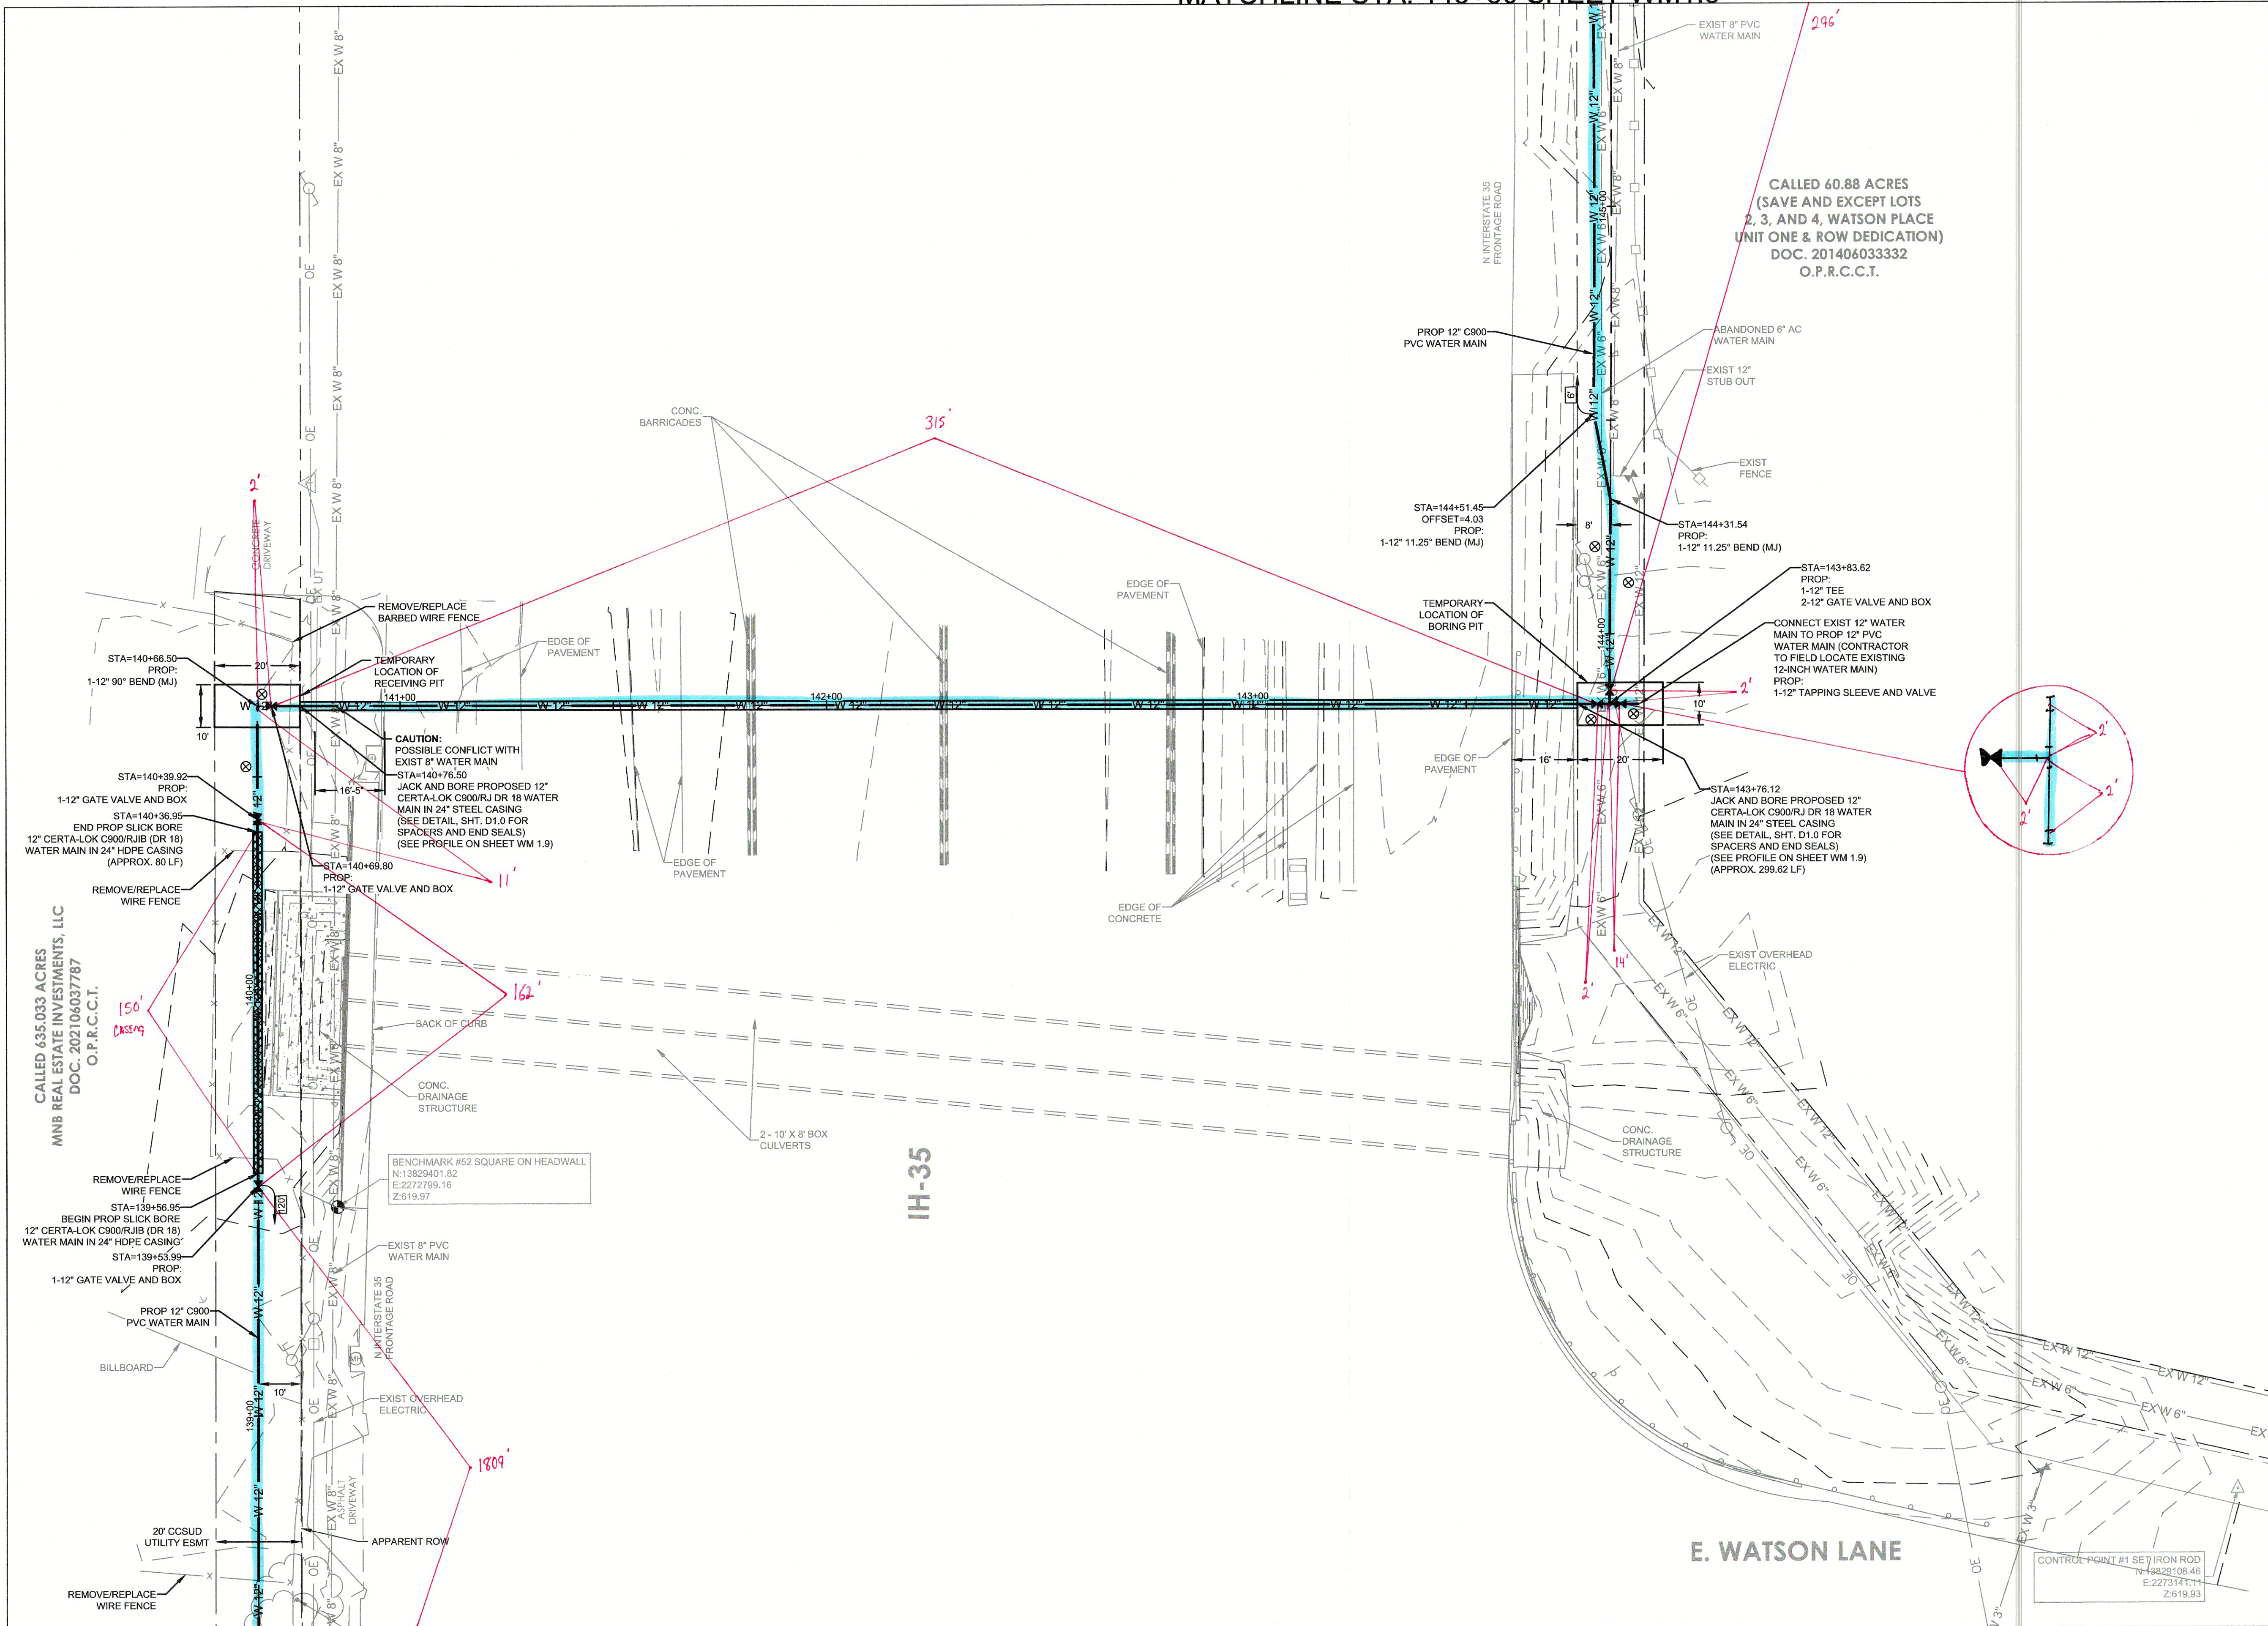


MATCHLINE STA. 138+50 SEE SHEET WM1.3

MATCHLINE STA. 145+50 SHEET WM1.5

- NOTES:
- CAUTION: POSSIBLE CONFLICT WITH EXISTING WATER LATERALS.
 - CUT, PLUG, AND ABANDON THE EXISTING 8-INCH WATER MAIN AFTER RELEASE FOR SERVICE OF PROPOSED 12-INCH WATER MAIN. COORDINATE WITH CCSUD STAFF.
 - EXISTING SERVICES TO BE RECONNECTED TO 12-INCH WATER MAIN ONLY AFTER PROPOSED MAIN IS RELEASED FOR SERVICE.
 - ASBESTOS-CONTAINING MATERIAL (ACM) PIPE CONTAINS ASBESTOS-CONTAINING MATERIAL (ACM) AND IS LOCATED WITHIN THE PROJECT LIMITS. SPECIAL WASTE MANAGEMENT PROCEDURES, HEALTH AND SAFETY REQUIREMENTS ARE APPLICABLE WHEN HANDLING, REMOVING, AND DISPOSING OF THIS PIPE. PAYMENT FOR SUCH WORK IS TO BE MADE UNDER SECTION 02800 - HANDLING ASBESTOS CEMENT PIPE OF THESE PROJECT SPECIFICATIONS.
 - REFER TO SHEET G1.0 REGARDING EXISTING UTILITIES.

TRENCH EXCAVATION SAFETY PROTECTION

CONTRACTOR AND/OR CONTRACTOR'S INDEPENDENTLY RETAINED EMPLOYEE OR STRUCTURAL DESIGN/GEOTECHNICAL/SAFETY EQUIPMENT CONSULTANT, IF ANY, SHALL REVIEW THESE PLANS AND AVAILABLE GEOTECHNICAL INFORMATION AND THE ANTICIPATED INSTALLATION SITES WITHIN THE PROJECT WORK AREA IN ORDER TO IMPLEMENT CONTRACTOR'S TRENCH EXCAVATION SAFETY PROTECTION SYSTEMS, PROGRAMS, AND/OR PROCEDURES. THE CONTRACTOR'S IMPLEMENTATION OF THESE SYSTEMS, PROGRAMS AND/OR PROCEDURES SHALL PROVIDE FOR ADEQUATE TRENCH EXCAVATION SAFETY PROTECTION THAT COMPLIES WITH AS A MINIMUM, OSHA STANDARDS FOR TRENCH EXCAVATIONS. SPECIFICALLY, CONTRACTOR AND/OR CONTRACTOR'S INDEPENDENTLY RETAINED EMPLOYEE OR SAFETY CONSULTANT SHALL IMPLEMENT A TRENCH SAFETY PROGRAM IN ACCORDANCE WITH OSHA STANDARDS GOVERNING THE PRESENCE AND ACTIVITIES OF INDIVIDUALS WORKING IN AND AROUND TRENCH EXCAVATION.

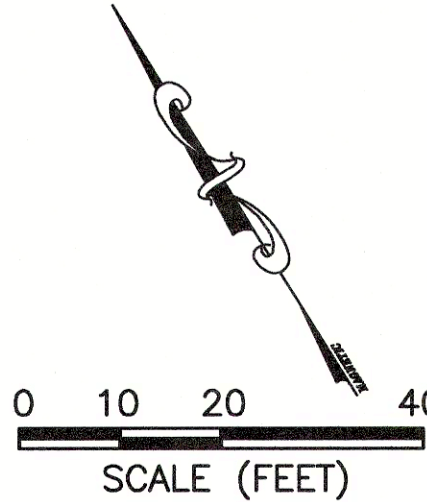


KYNDWOOD SUBDIVISION WATER
MAIN EXTENSION

JOB: 14CCSUD001
DATE: AUGUST 2022
DRAWN: KJV PM: CP
DESIGN: CB DM: BK
PEER: OTHER:
REVISIONS:
DELTA DESCRIPTION DATE

SHEET:
WM1.4

M&S ENGINEERING
ELECTRICAL | CIVIL | MEP
TXENG FIRM # E-1394 | TBPELS FIRM #10169800
WWW.MISENGR.COM | (830) 228-3446

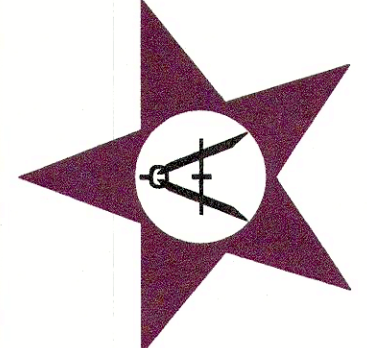



September 26, 2022

WATERLINE PLAN STA. 138+50
TO STA. 145+50



MATCHLINE STA. 145+50 SHEET WM1.4


MATCHLINE STA. 150+50 THIS SHEET

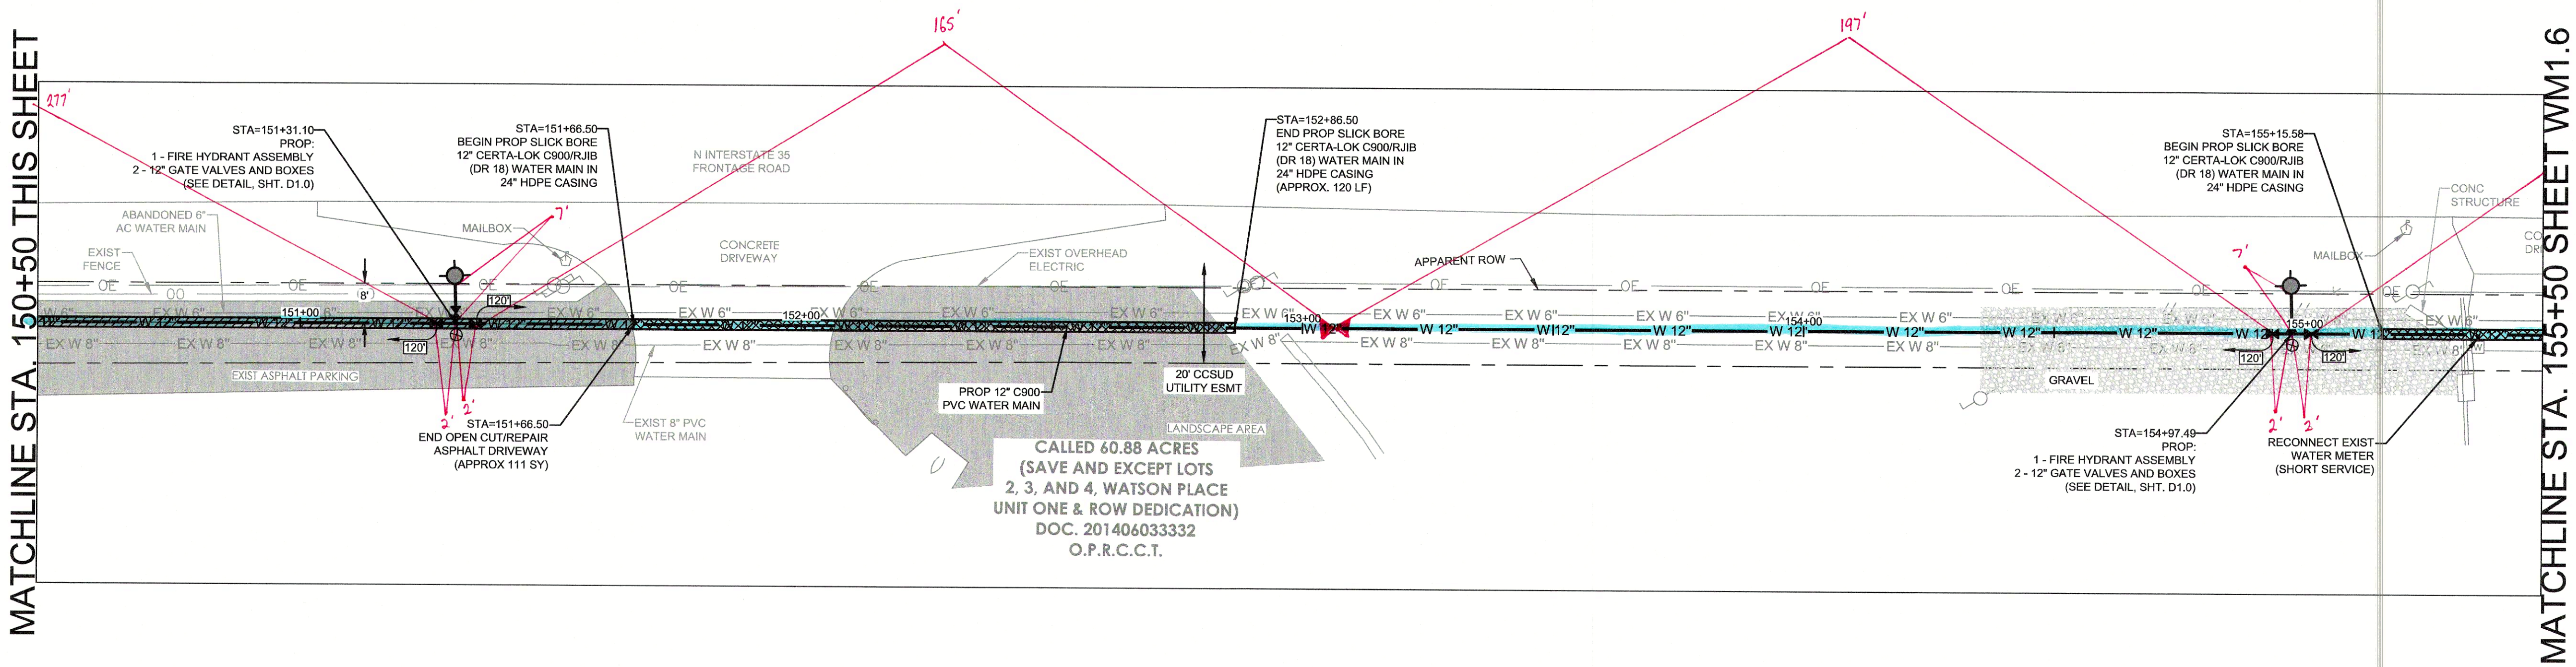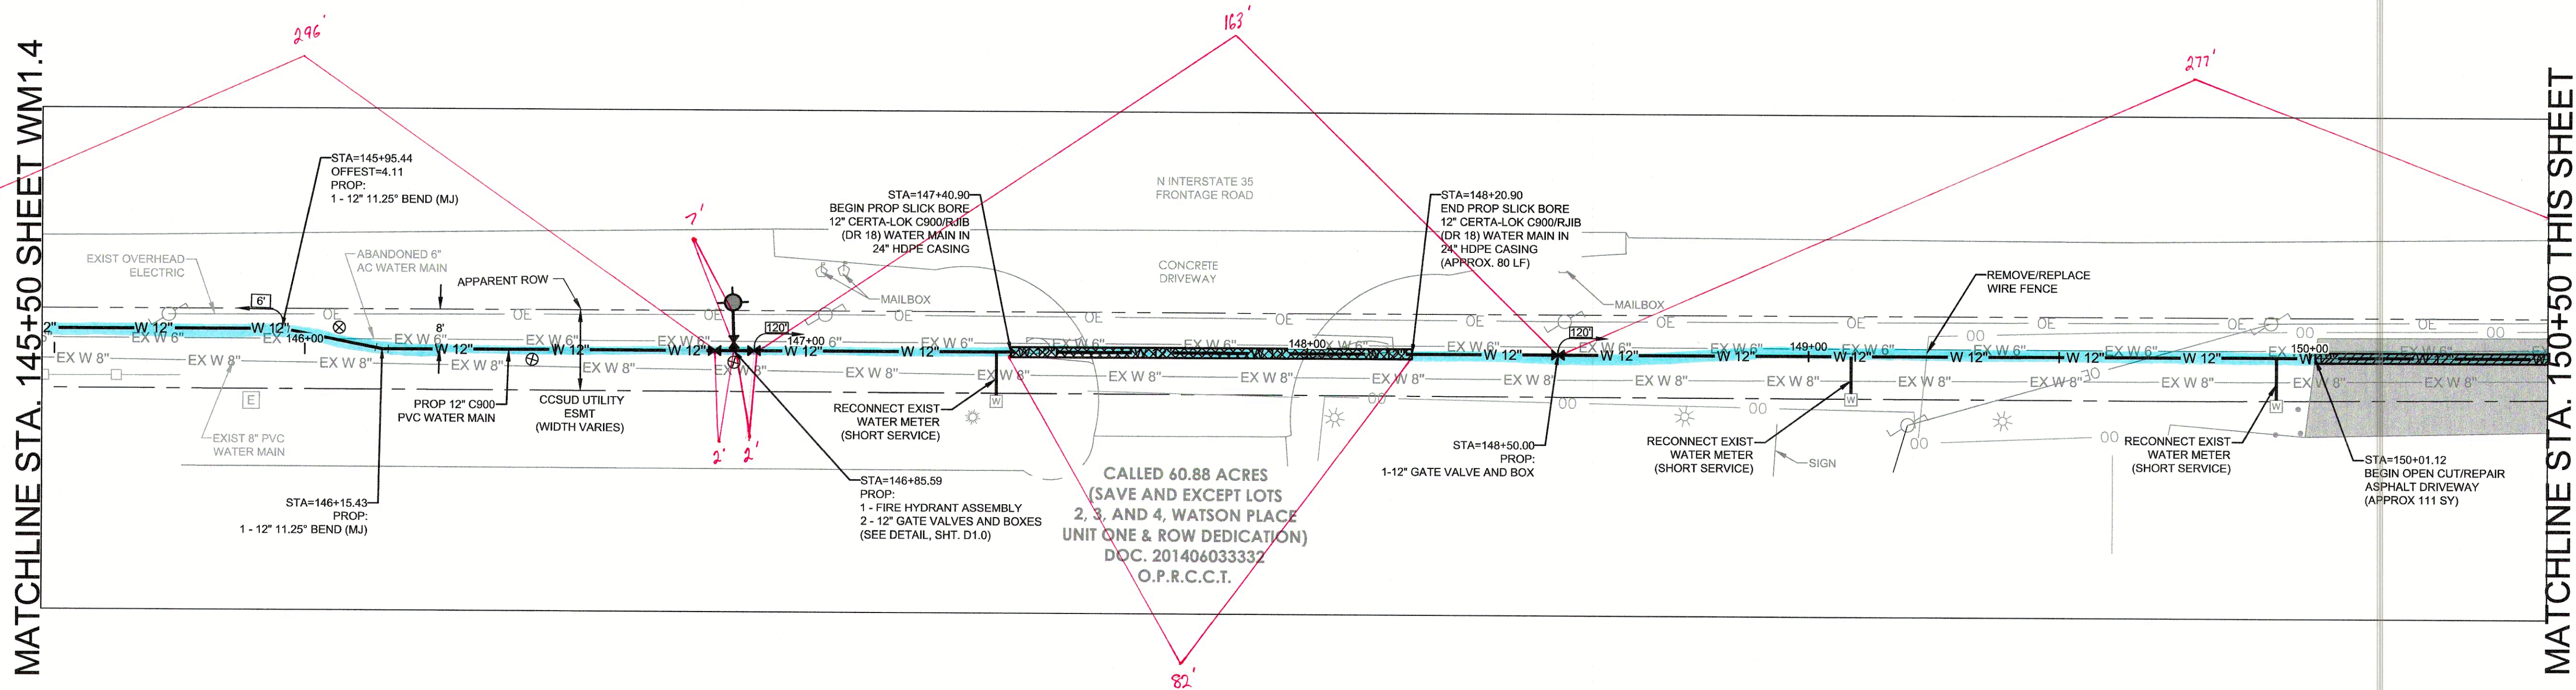

- NOTES:
1. CAUTION: POSSIBLE CONFLICT WITH EXISTING WATER LATERALS.
 2. CUT, PLUG, AND ABANDON THE EXISTING 8-INCH WATER MAIN AFTER RELEASE FOR SERVICE OF PROPOSED 12-INCH WATER MAIN. COORDINATE WITH CCSUD STAFF.
 3. EXISTING SERVICES TO BE RECONNECTED TO 12-INCH WATER MAIN ONLY AFTER PROPOSED MAIN IS RELEASED FOR SERVICE.
 4. ASBESTOS CEMENT (AC) PIPE CONTAINS ASBESTOS-CONTAINING MATERIAL (ACM) AND IS LOCATED WITHIN THE PROJECT LIMITS. SPECIAL WASTE MANAGEMENT PROCEDURES, HEALTH AND SAFETY REQUIREMENTS ARE APPLICABLE WHEN HANDLING, REMOVING, AND DISPOSING OF THIS PIPE. PAYMENT FOR SUCH WORK IS TO BE MADE UNDER SECTION 02800 - HANDLING ASBESTOS CEMENT PIPE OF THESE PROJECT SPECIFICATIONS.
 5. REFER TO SHEET G1.0 REGARDING EXISTING UTILITIES.

TRENCH EXCAVATION SAFETY PROTECTION

CONTRACTOR AND/OR CONTRACTOR'S INDEPENDENTLY RETAINED EMPLOYEE OR STRUCTURAL DESIGN/GEOTECHNICAL/SAFETY EQUIPMENT CONSULTANT, IF ANY, SHALL REVIEW THESE PLANS AND AVAILABLE GEOTECHNICAL INFORMATION AND THE ANTICIPATED INSTALLATION SITES WITHIN THE PROJECT WORK AREA IN ORDER TO IMPLEMENT CONTRACTOR'S TRENCH EXCAVATION SAFETY PROTECTION SYSTEMS, PROGRAMS, AND/OR PROCEDURES. THE CONTRACTOR'S IMPLEMENTATION OF THESE SYSTEMS, PROGRAMS AND/OR PROCEDURES SHALL PROVIDE FOR ADEQUATE TRENCH EXCAVATION SAFETY PROTECTION THAT COMPLIES WITH AS A MINIMUM, OSHA STANDARDS FOR TRENCH EXCAVATIONS. SPECIFICALLY, CONTRACTOR AND/OR CONTRACTOR'S INDEPENDENTLY RETAINED EMPLOYEE OR SAFETY CONSULTANT SHALL IMPLEMENT A TRENCH SAFETY PROGRAM IN ACCORDANCE WITH THE PRESENCE AND ACTIVITIES OF INDIVIDUALS WORKING IN AND AROUND TRENCH EXCAVATION.

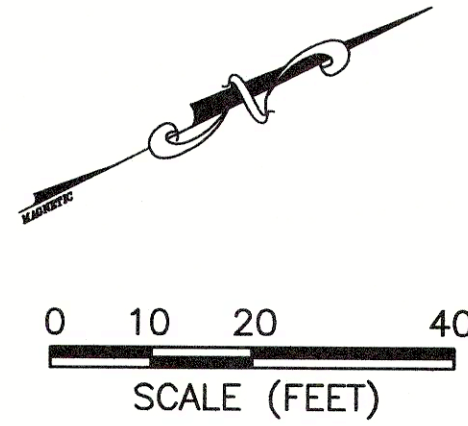

KYNDWOOD SUBDIVISION WATER MAIN EXTENSION

WATERLINE PLAN STA. 145+50 TO STA. 155+50


JOB: 1400SUD001
DATE: AUGUST 2022
DRAWN: KJV PM: CP
DESIGN: CB DM: BK
PEER: OTHER:

REVISIONS:
DELTA | DESCRIPTION | DATE

SHEET:



WM1.5

M&S ENGINEERING
ELECTRICAL | CIVIL | MEP
TXENG FIRM # F-1394 | TBPELS FIRM #10169800
WWW.MSENGR.COM | (830) 228-5446

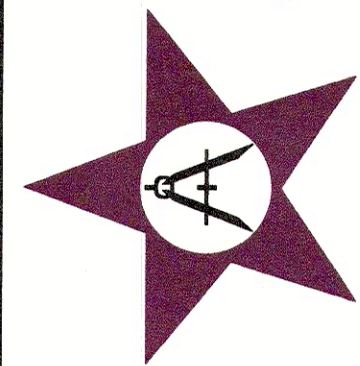

September 26, 2022



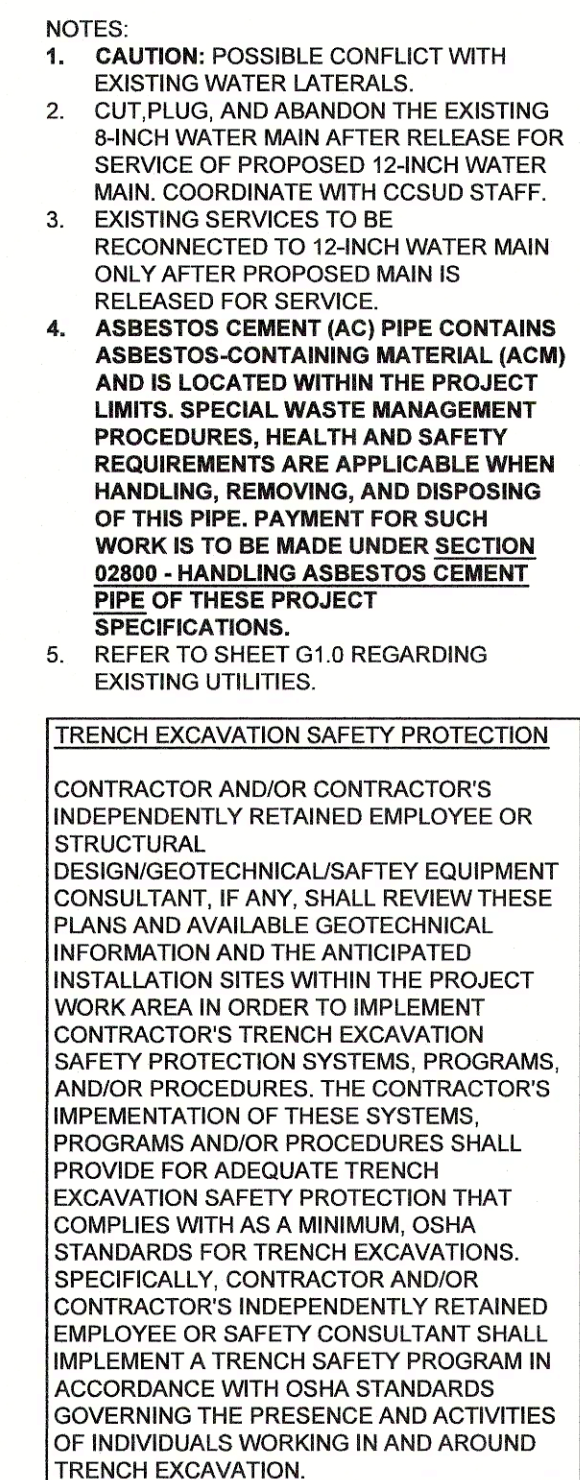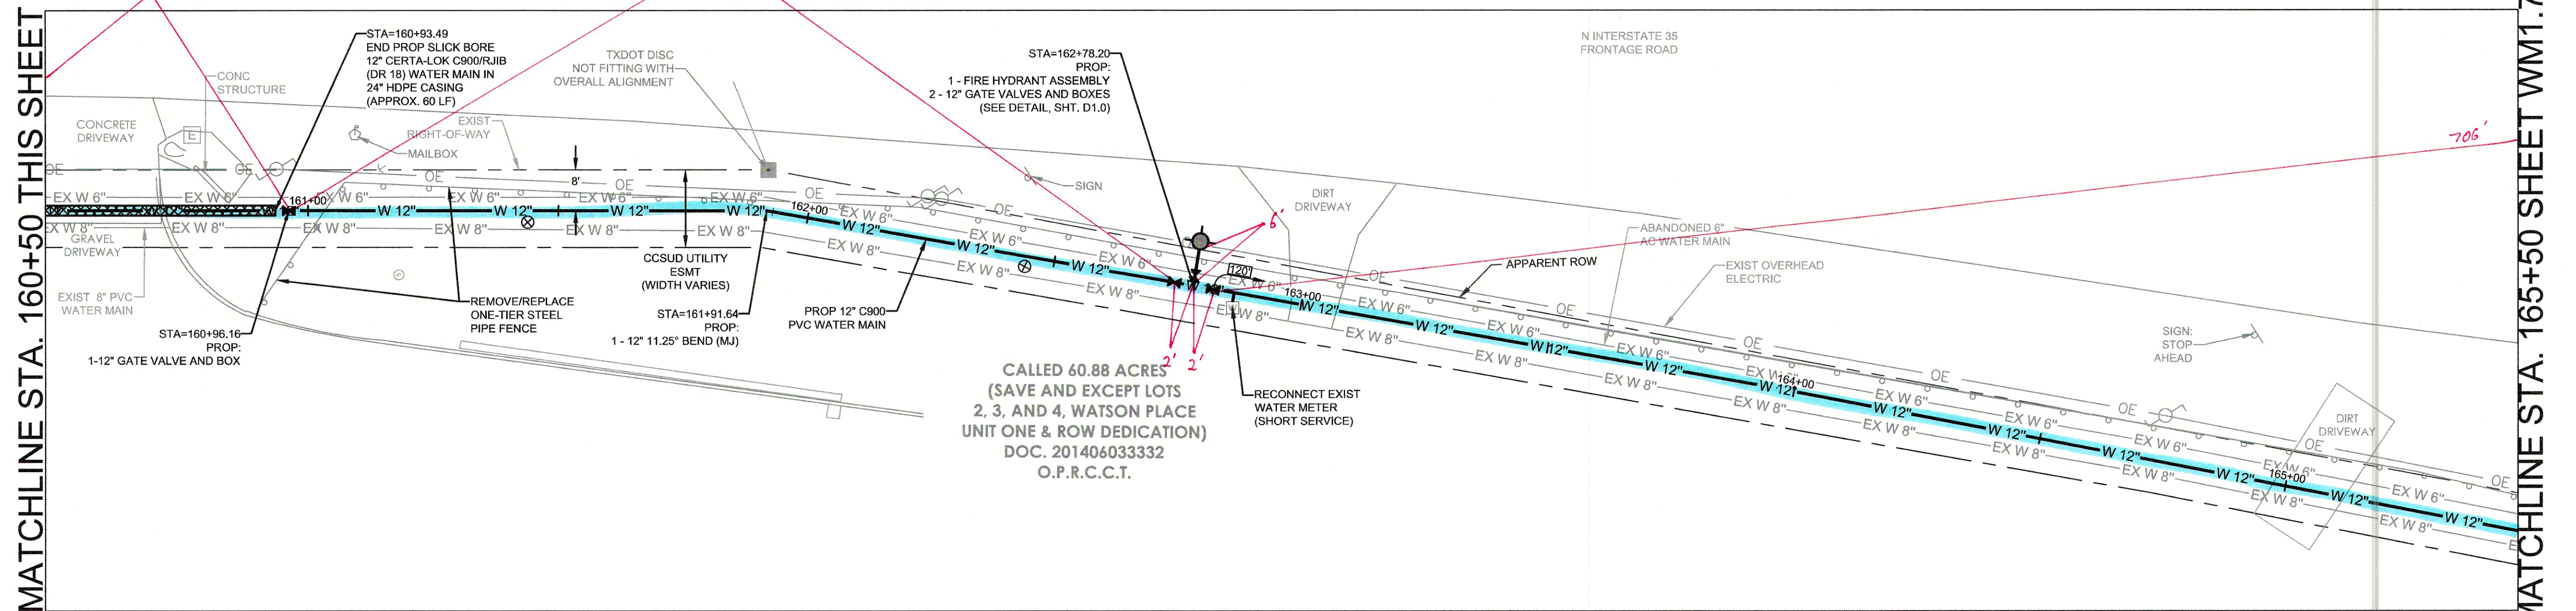

September 26, 2022


**KYNDWOOD SUBDIVISION WATER
MAIN EXTENSION**

JOB: 14CCSUD001		
DATE: AUGUST 2022		
DRAWN: KJV	PM:	
DESIGN: CB	DM:	
PEER:	OTHER:	
REVISIONS:		
DELTA	DESCRIPTION	DATE



SHEET:
WM1.6

MATCHLINE STA. 165+50 SHEET WM1.6


MATCHLINE STA. 170+50 THIS SHEET

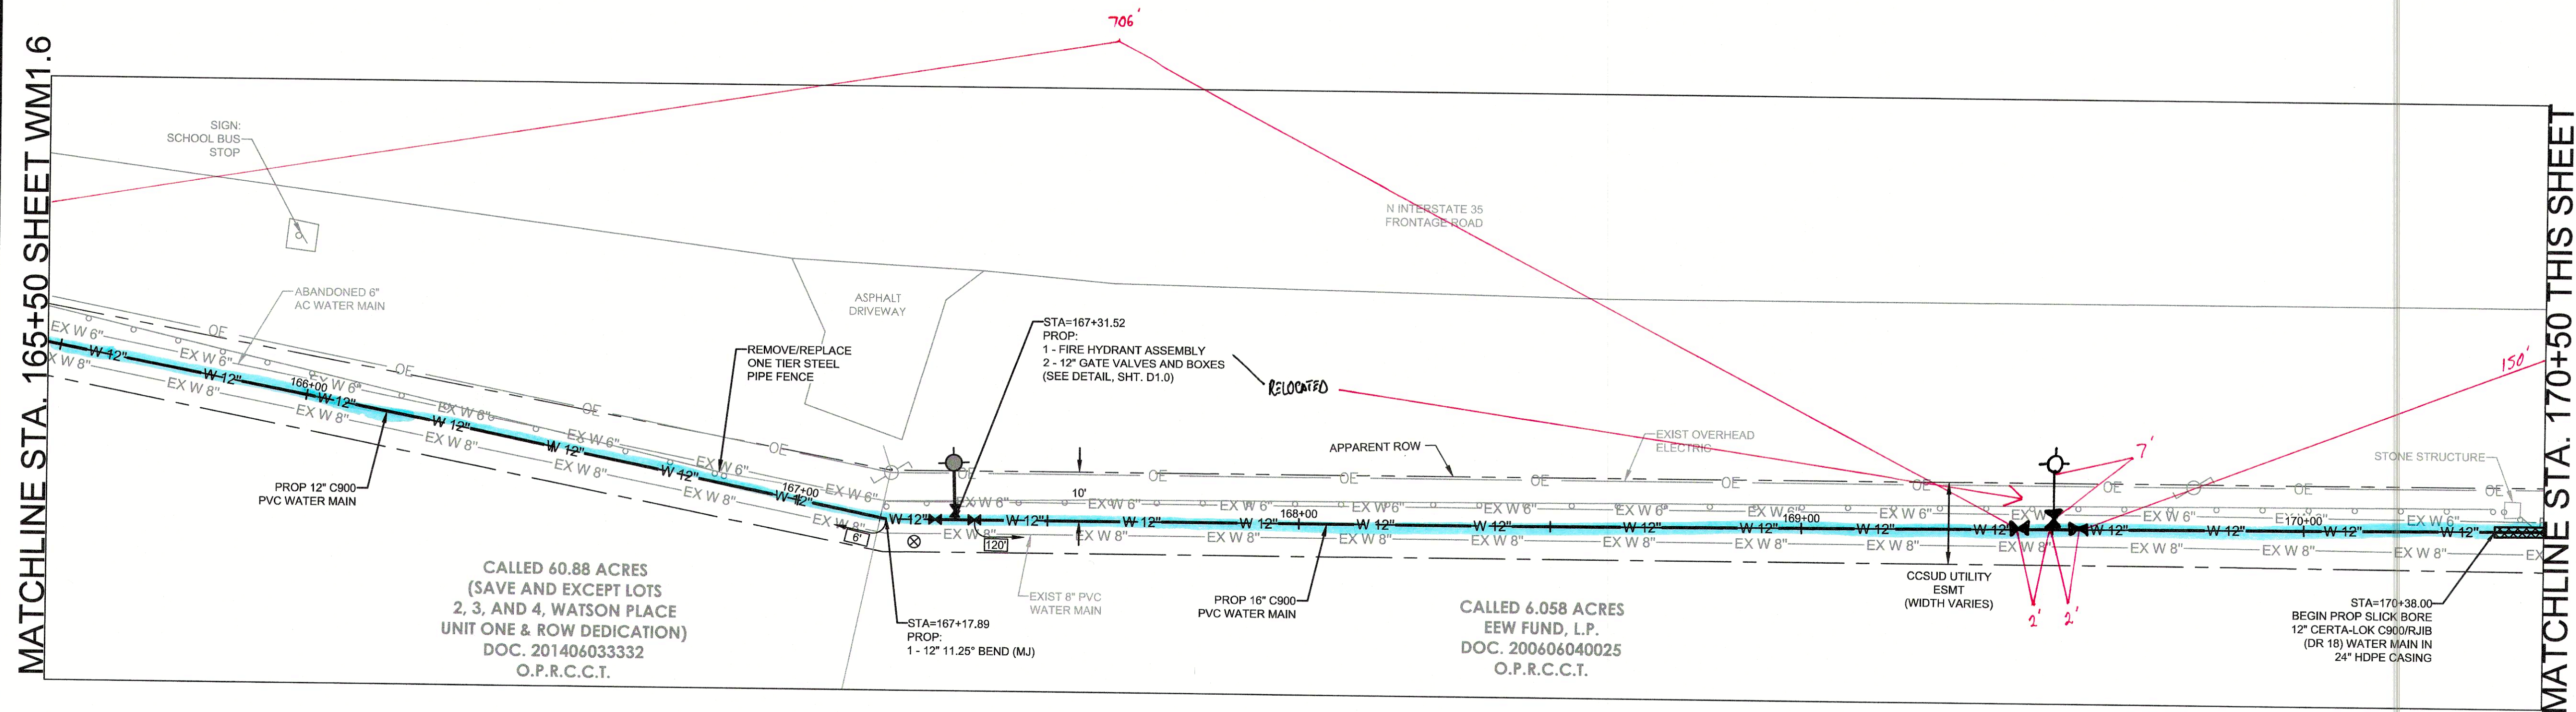

MATCHLINE STA. 170+50 THIS SHEET

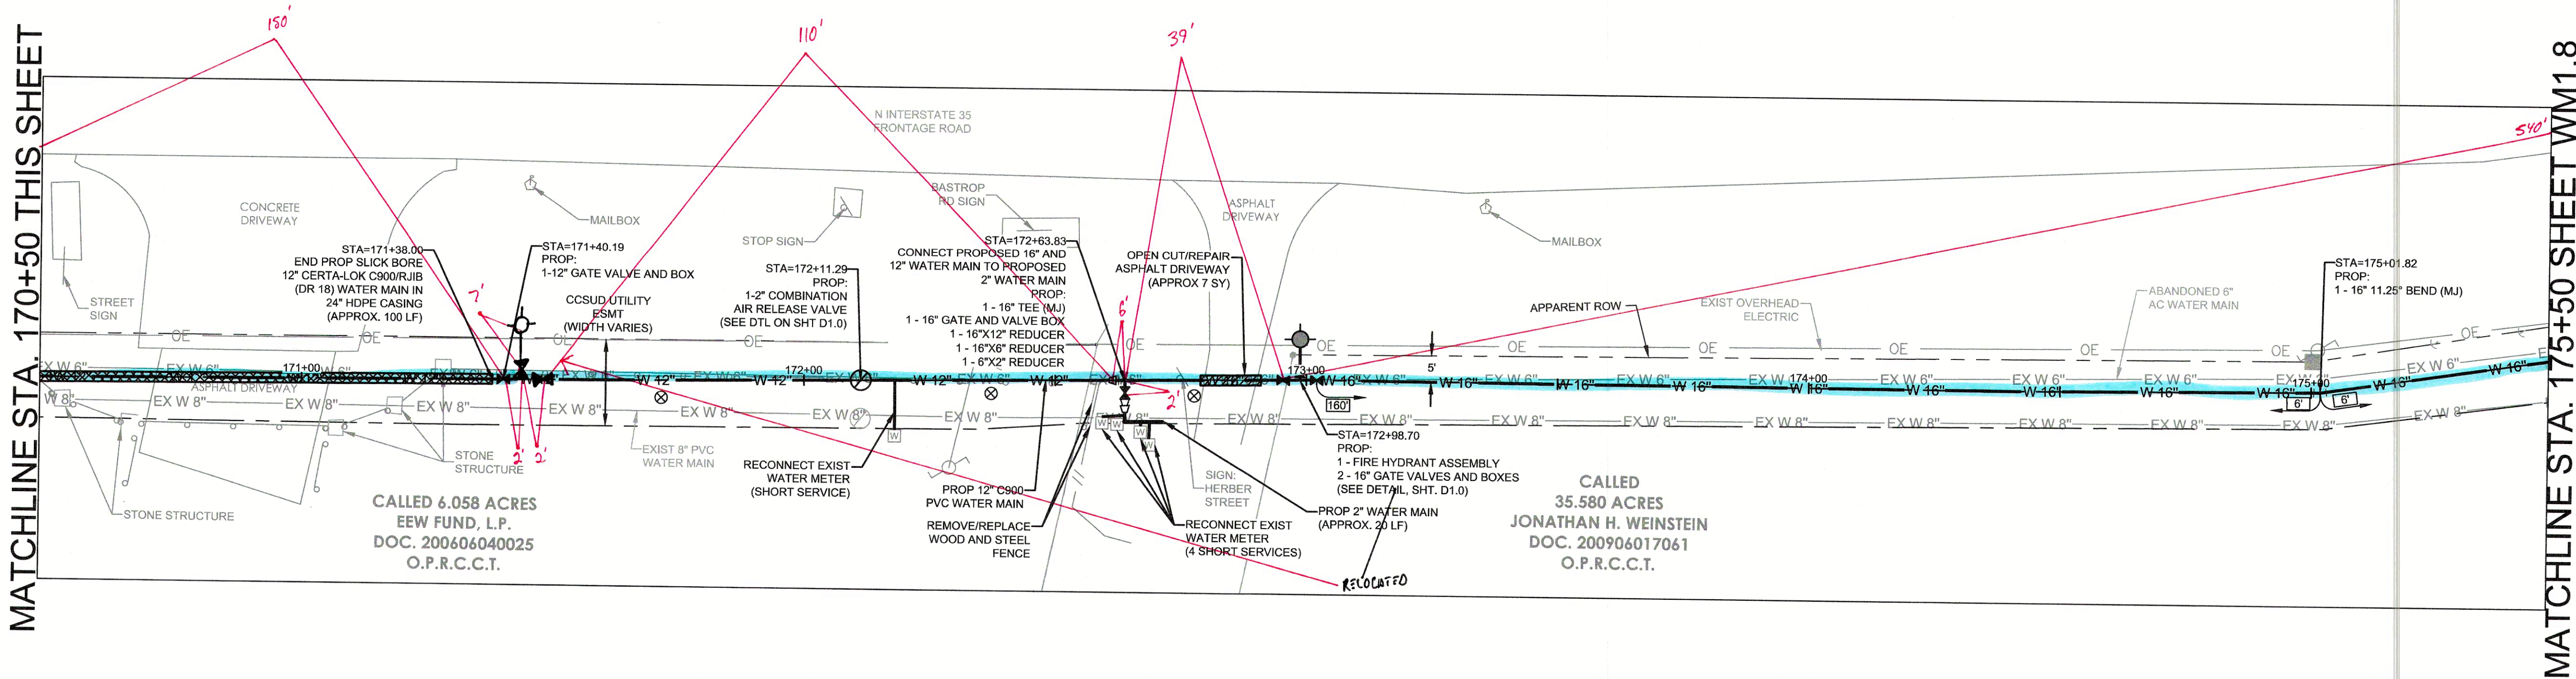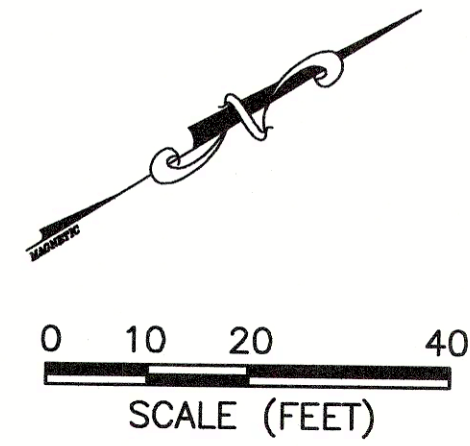

MATCHLINE STA. 175+50 SHEET WM1.8

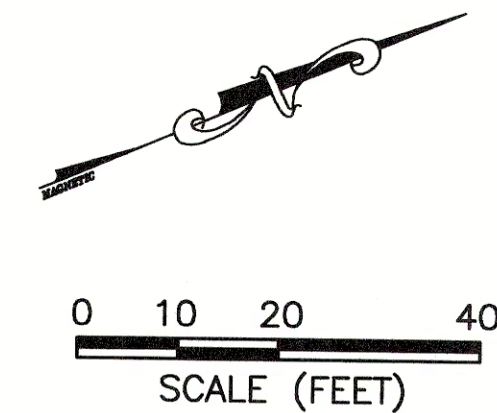

- NOTES:
- CAUTION: POSSIBLE CONFLICT WITH EXISTING WATER LATERALS.
 - CUT, PLUG, AND ABANDON THE EXISTING 8-INCH WATER MAIN AFTER RELEASE FOR SERVICE OF PROPOSED 12-INCH WATER MAIN. COORDINATE WITH CCSUD STAFF.
 - EXISTING SERVICES TO BE RECONNECTED TO 12-INCH WATER MAIN ONLY AFTER PROPOSED MAIN IS RELEASED FOR SERVICE.
 - ASBESTOS CEMENT (AC) PIPE CONTAINS ASBESTOS-CONTAINING MATERIAL (ACM) AND IS LOCATED WITHIN THE PROJECT LIMITS. SPECIAL WASTE MANAGEMENT PROCEDURES, HEALTH AND SAFETY REQUIREMENTS ARE APPLICABLE WHEN HANDLING, REMOVING, AND DISPOSING OF THIS PIPE. PAYMENT FOR SUCH WORK IS TO BE MADE UNDER SECTION 02800 - HANDLING ASBESTOS CEMENT PIPE OF THESE PROJECT SPECIFICATIONS.
 - REFER TO SHEET G1.0 REGARDING EXISTING UTILITIES.

TRENCH EXCAVATION SAFETY PROTECTION

CONTRACTOR AND/OR CONTRACTOR'S INDEPENDENTLY RETAINED EMPLOYEE OR STRUCTURAL DESIGN/GEOTECHNICAL/SAFETY EQUIPMENT CONSULTANT, IF ANY, SHALL REVIEW THESE PLANS AND AVAILABLE GEOTECHNICAL INFORMATION AND THE ANTICIPATED INSTALLATION SITES WITHIN THE PROJECT WORK AREA IN ORDER TO IMPLEMENT CONTRACTOR'S TRENCH EXCAVATION SAFETY PROTECTION SYSTEMS, PROGRAMS, AND/OR PROCEDURES. THE CONTRACTOR'S IMPLEMENTATION OF THESE SYSTEMS, PROGRAMS AND/OR PROCEDURES SHALL PROVIDE FOR ADEQUATE TRENCH EXCAVATION SAFETY PROTECTION THAT COMPLIES WITH AS A MINIMUM, OSHA STANDARDS FOR TRENCH EXCAVATIONS. SPECIFICALLY, CONTRACTOR AND/OR CONTRACTOR'S INDEPENDENTLY RETAINED EMPLOYEE OR SAFETY CONSULTANT SHALL IMPLEMENT A TRENCH SAFETY PROGRAM IN ACCORDANCE WITH OSHA STANDARDS GOVERNING THE PRESENCE AND ACTIVITIES OF INDIVIDUALS WORKING IN AND AROUND TRENCH EXCAVATION.



KYNDWOOD SUBDIVISION WATER MAIN EXTENSION

WATERLINE PLAN STA. 165+50 TO STA. 175+50



JOB: 14CCSUD001
DATE: AUGUST 2022
DRAWN: KJV PM: CP
DESIGN: CB DM: BK
PEER: OTHER:

REVISIONS:
DELTA DESCRIPTION DATE


SHEET:

WM1.7

M&S ENGINEERING
ELECTRICAL | CIVIL | MEP
TXENG FIRM # F-1394 | TBPELS FIRM #10159800
WWW.MSENGR.COM | (830) 228-5446

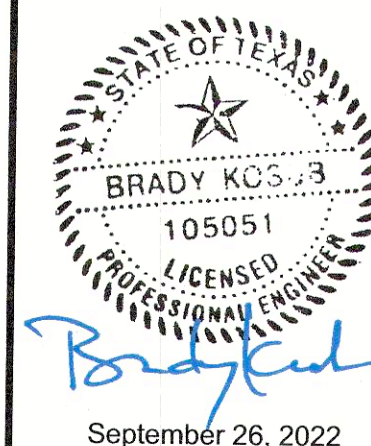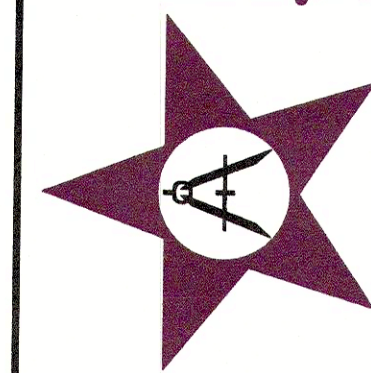

MATCHLINE STA. 175+50 SHEET WM1.7

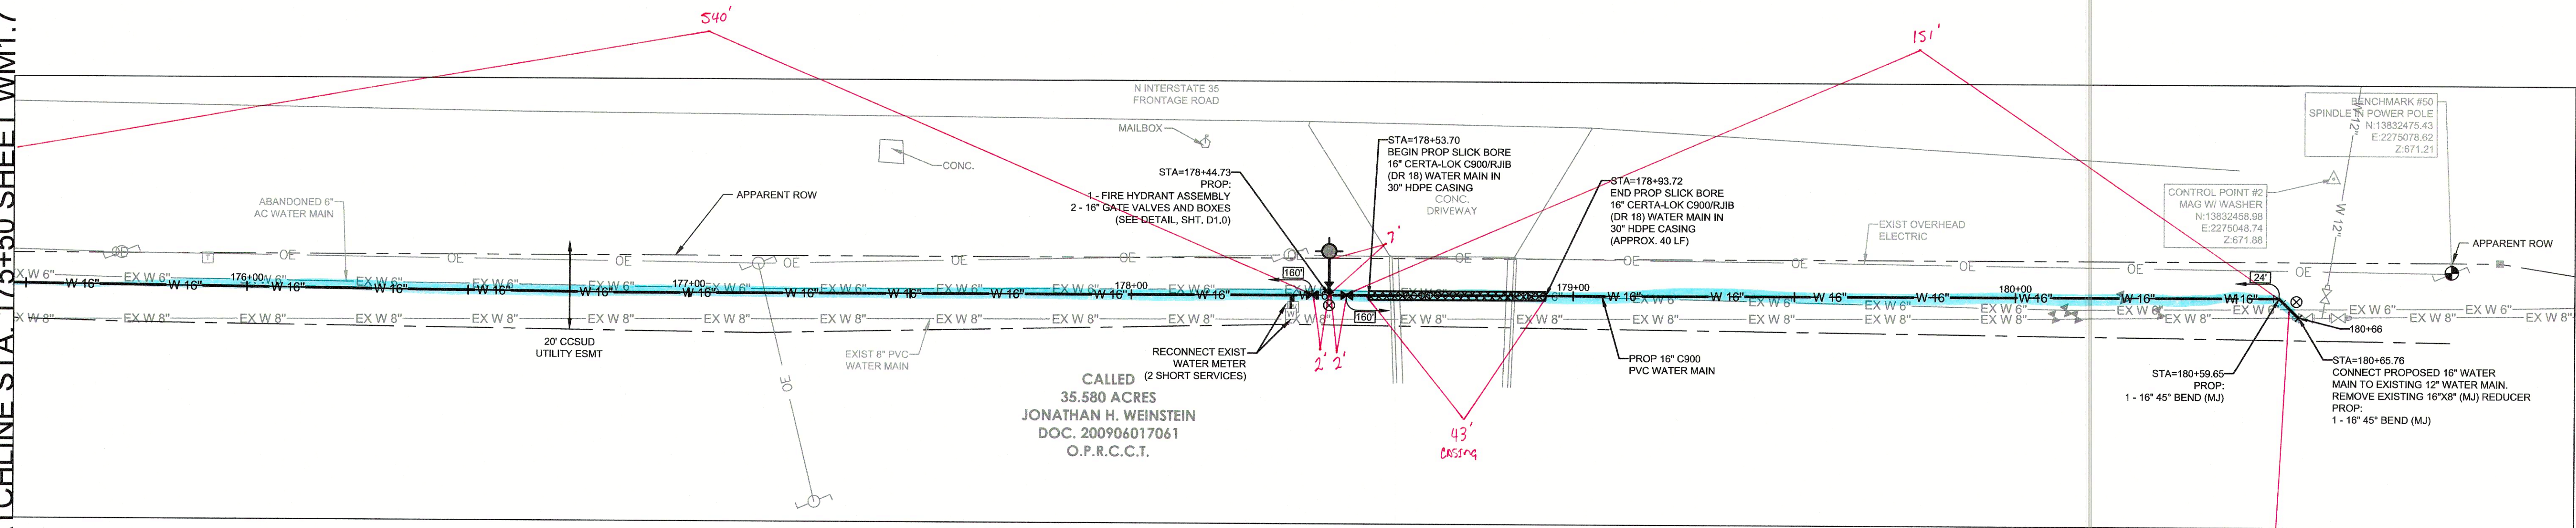

35.580 ACRES
JONATHAN H. WEINSTEIN
DOC. 200904017061
O.P.R.C.C.T.


- NOTES:
1. CAUTION: POSSIBLE CONFLICT WITH EXISTING WATER LATERALS.
 2. CUT PLUG AND ABANDON THE EXISTING 8-INCH WATER MAIN AFTER RELEASE FOR SERVICE OF PROPOSED 12-INCH WATER MAIN. COORDINATE WITH CCSUD STAFF.
 3. EXISTING SERVICES TO BE RECONNECTED TO 12-INCH WATER MAIN ONLY AFTER PROPOSED MAIN IS RELEASED FOR SERVICE.
 4. ASBESTOS CEMENT (AC) PIPE CONTAINS ASBESTOS-CONTAINING MATERIAL (ACM) AND IS LOCATED WITHIN THE PROJECT LIMITS. SPECIAL WASTE MANAGEMENT PROCEDURES, HEALTH AND SAFETY REQUIREMENTS ARE APPLICABLE WHEN HANDLING, REMOVING, AND DISPOSING OF THIS PIPE. PAYMENT FOR SUCH WORK IS TO BE MADE UNDER SECTION 02800 - HANDLING ASBESTOS CEMENT PIPE OF THESE PROJECT SPECIFICATIONS.
 5. REFER TO SHEET G1.0 REGARDING EXISTING UTILITIES.

TRENCH EXCAVATION SAFETY PROTECTION

CONTRACTOR AND/OR CONTRACTOR'S INDEPENDENTLY RETAINED EMPLOYEE OR STRUCTURAL DESIGN/GEOTECHNICAL/SAFETY EQUIPMENT CONSULTANT, IF ANY, SHALL REVIEW THESE PLANS AND AVAILABLE GEOTECHNICAL INFORMATION AND THE ANTICIPATED INSTALLATION SITES WITHIN THE PROJECT WORK AREA IN ORDER TO IMPLEMENT CONTRACTOR'S TRENCH EXCAVATION SAFETY PROTECTION SYSTEMS, PROGRAMS, AND/OR PROCEDURES. THE CONTRACTOR'S IMPLEMENTATION OF THESE SYSTEMS, PROGRAMS AND/OR PROCEDURES SHALL PROVIDE FOR ADEQUATE TRENCH EXCAVATION SAFETY PROTECTION THAT COMPLIES WITH AS A MINIMUM, OSHA STANDARDS FOR TRENCH EXCAVATIONS. SPECIFICALLY, CONTRACTOR AND/OR CONTRACTOR'S INDEPENDENTLY RETAINED EMPLOYEE OR SAFETY CONSULTANT SHALL IMPLEMENT A TRENCH SAFETY PROGRAM IN ACCORDANCE WITH OSHA STANDARDS GOVERNING THE PRESENCE AND ACTIVITIES OF INDIVIDUALS WORKING IN AND AROUND TRENCH EXCAVATION.



M&S ENGINEERING
ELECTRICAL | CIVIL | MEP
TXENG FIRM # F-1394 | TBPELS FIRM #10169800
WWW.MSENGR.COM | (830) 228-5446

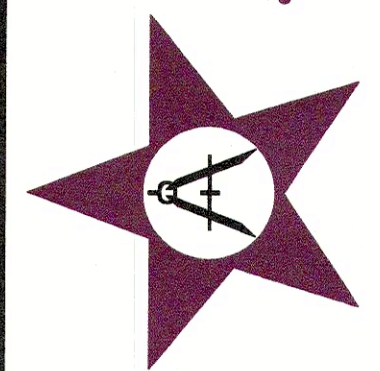

September 26, 2022

KYNDWOOD SUBDIVISION WATER
MAIN EXTENSION

WATERLINE PLAN STA. 175+50
TO END

JOB: 14CCSUD001	
DATE: AUGUST 2022	
DRAWN: KJV	PM: CP
DESIGN: CB	DM: BK
PEER:	OTHER:
REVISIONS:	
DELTA	DESCRIPTION DATE

SHEET:
WM1.8