


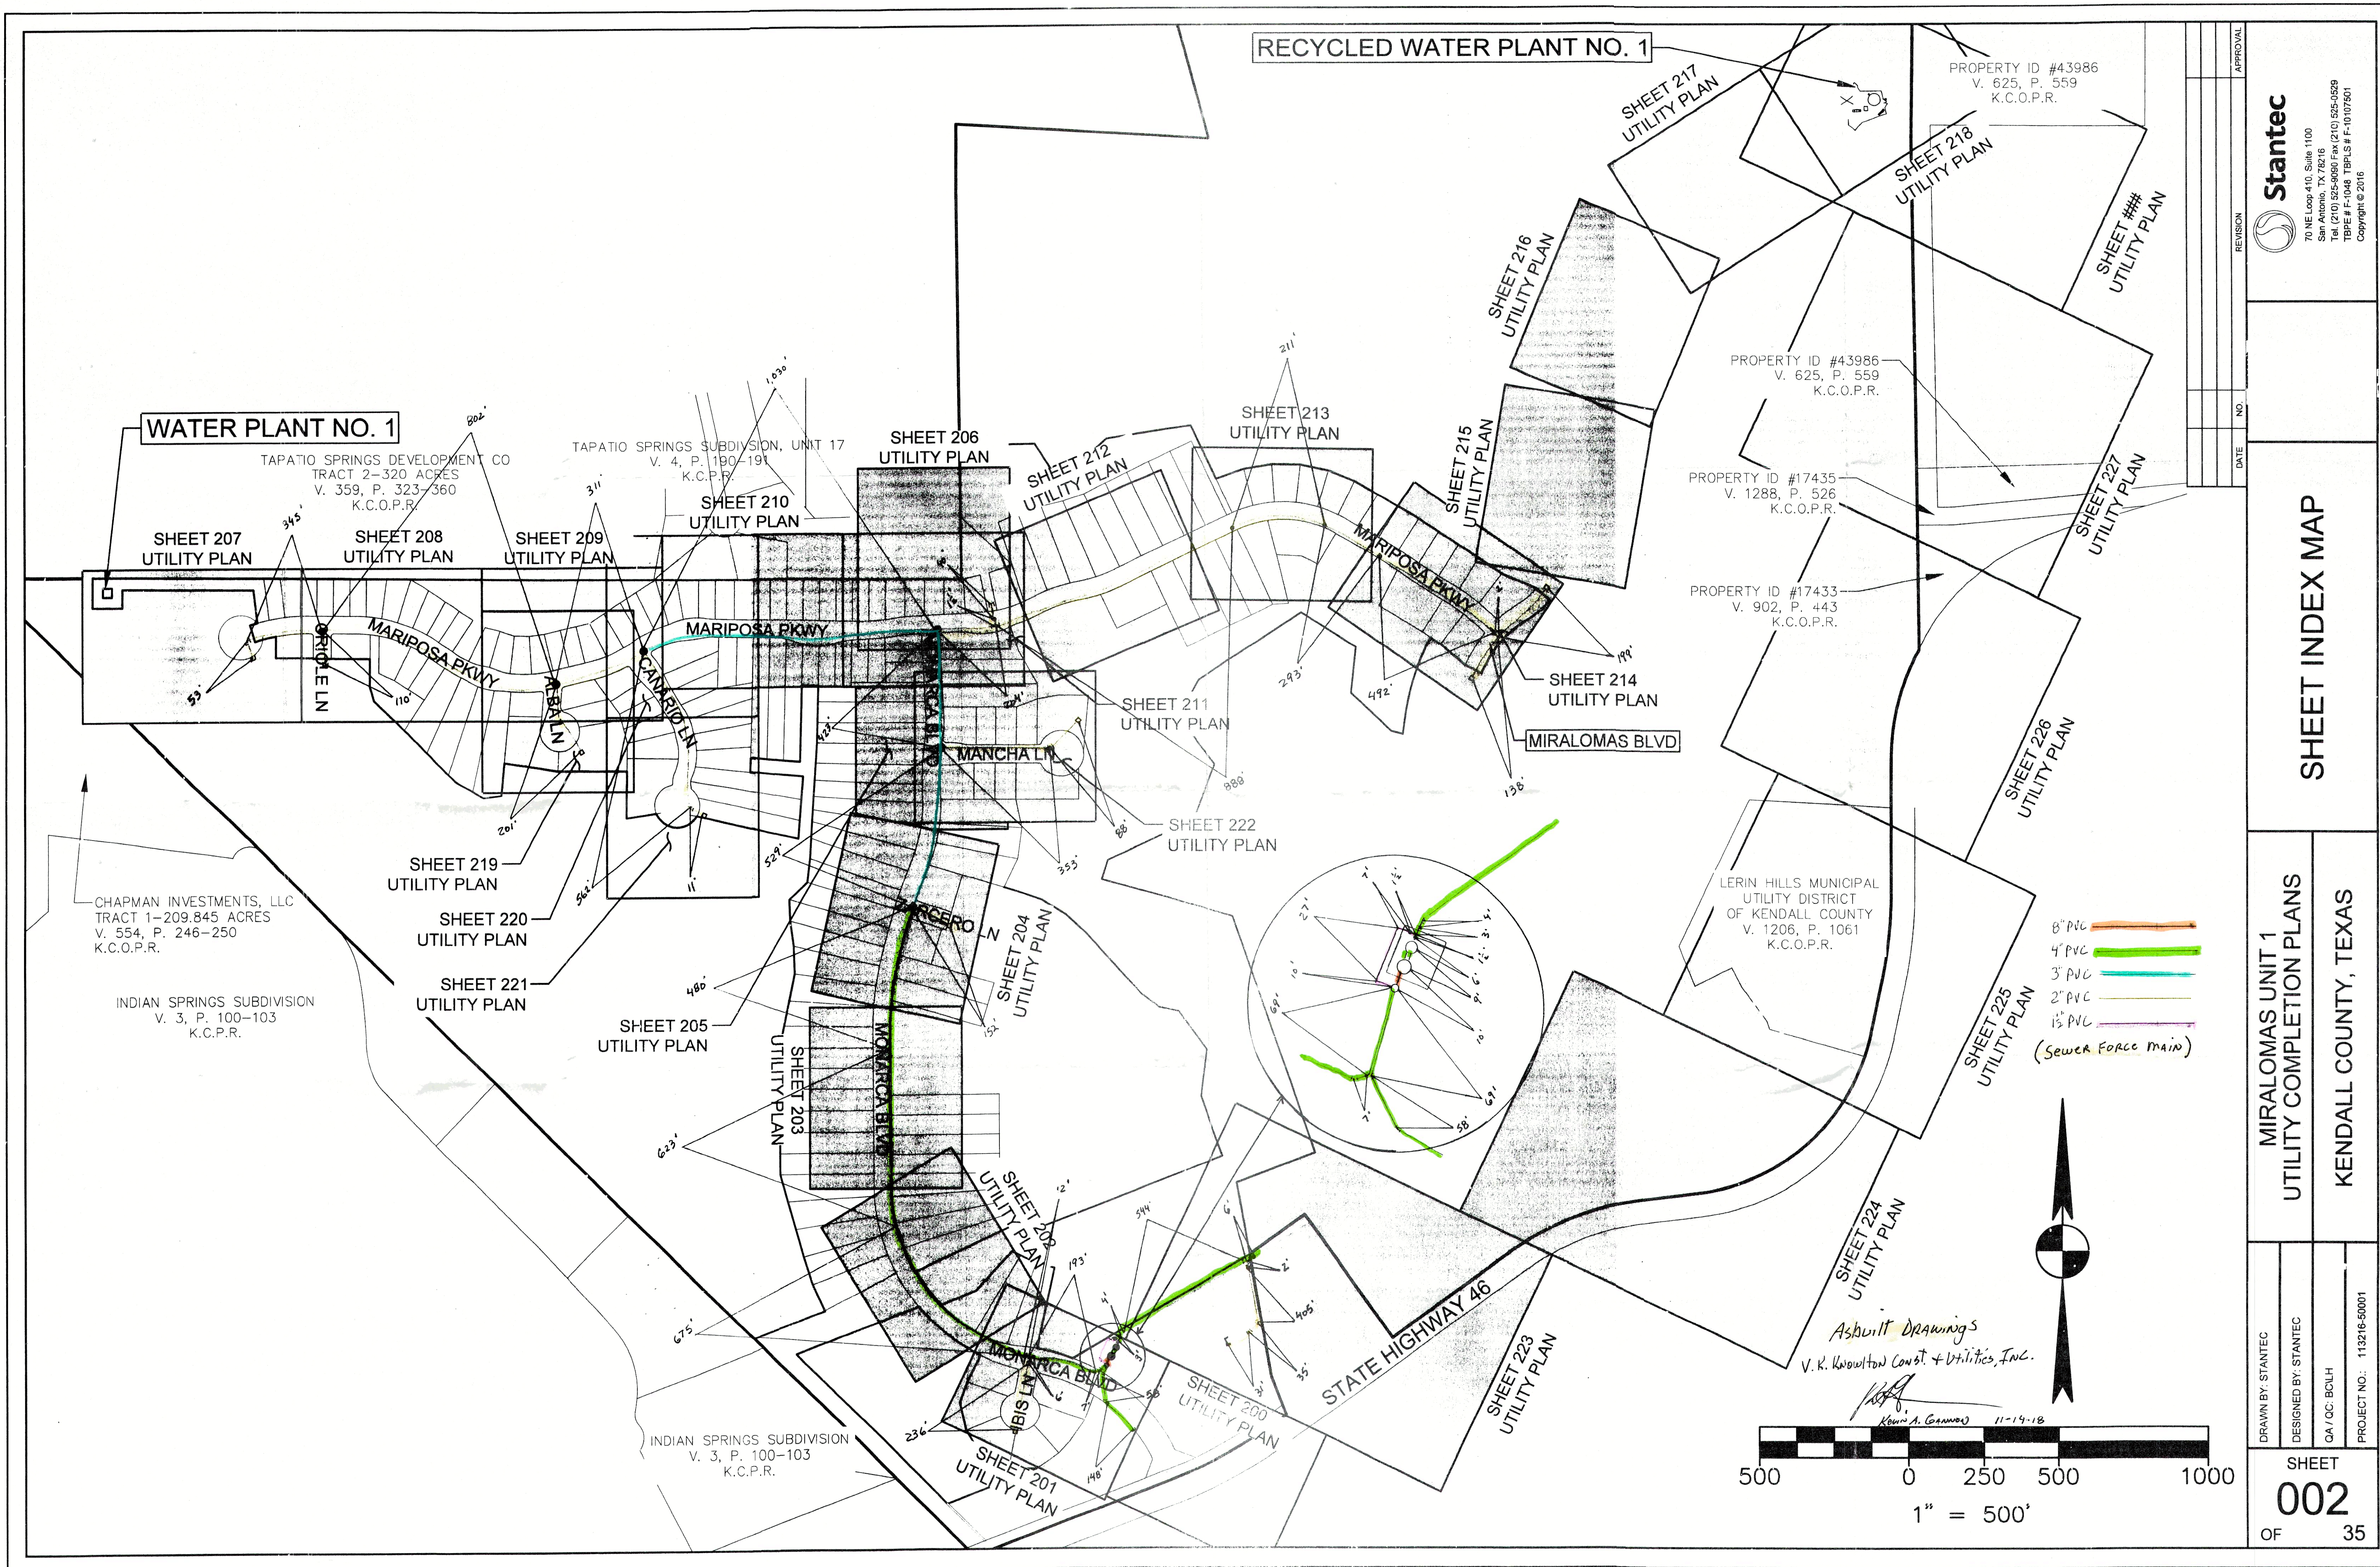

Stantec 70 NE Loop 410, Suite 1100 San Antonio, TX 78216 Tel: (210) 525-9090 Fax: (210) 525-0529 TBE # F-048 TBP # F-107501 Copyright © 2016	
REVISION	NO.
DATE	NO.
SHEET INDEX MAP	
MIRALOMAS UNIT 1 UTILITY COMPLETION PLANS	
KENDALL COUNTY, TEXAS	
DRAWN BY: STANTEC	DESIGNED BY: STANTEC
QA / QC: BOLH	PROJECT NO.: 113216-50001
SHEET 002 OF 35	