


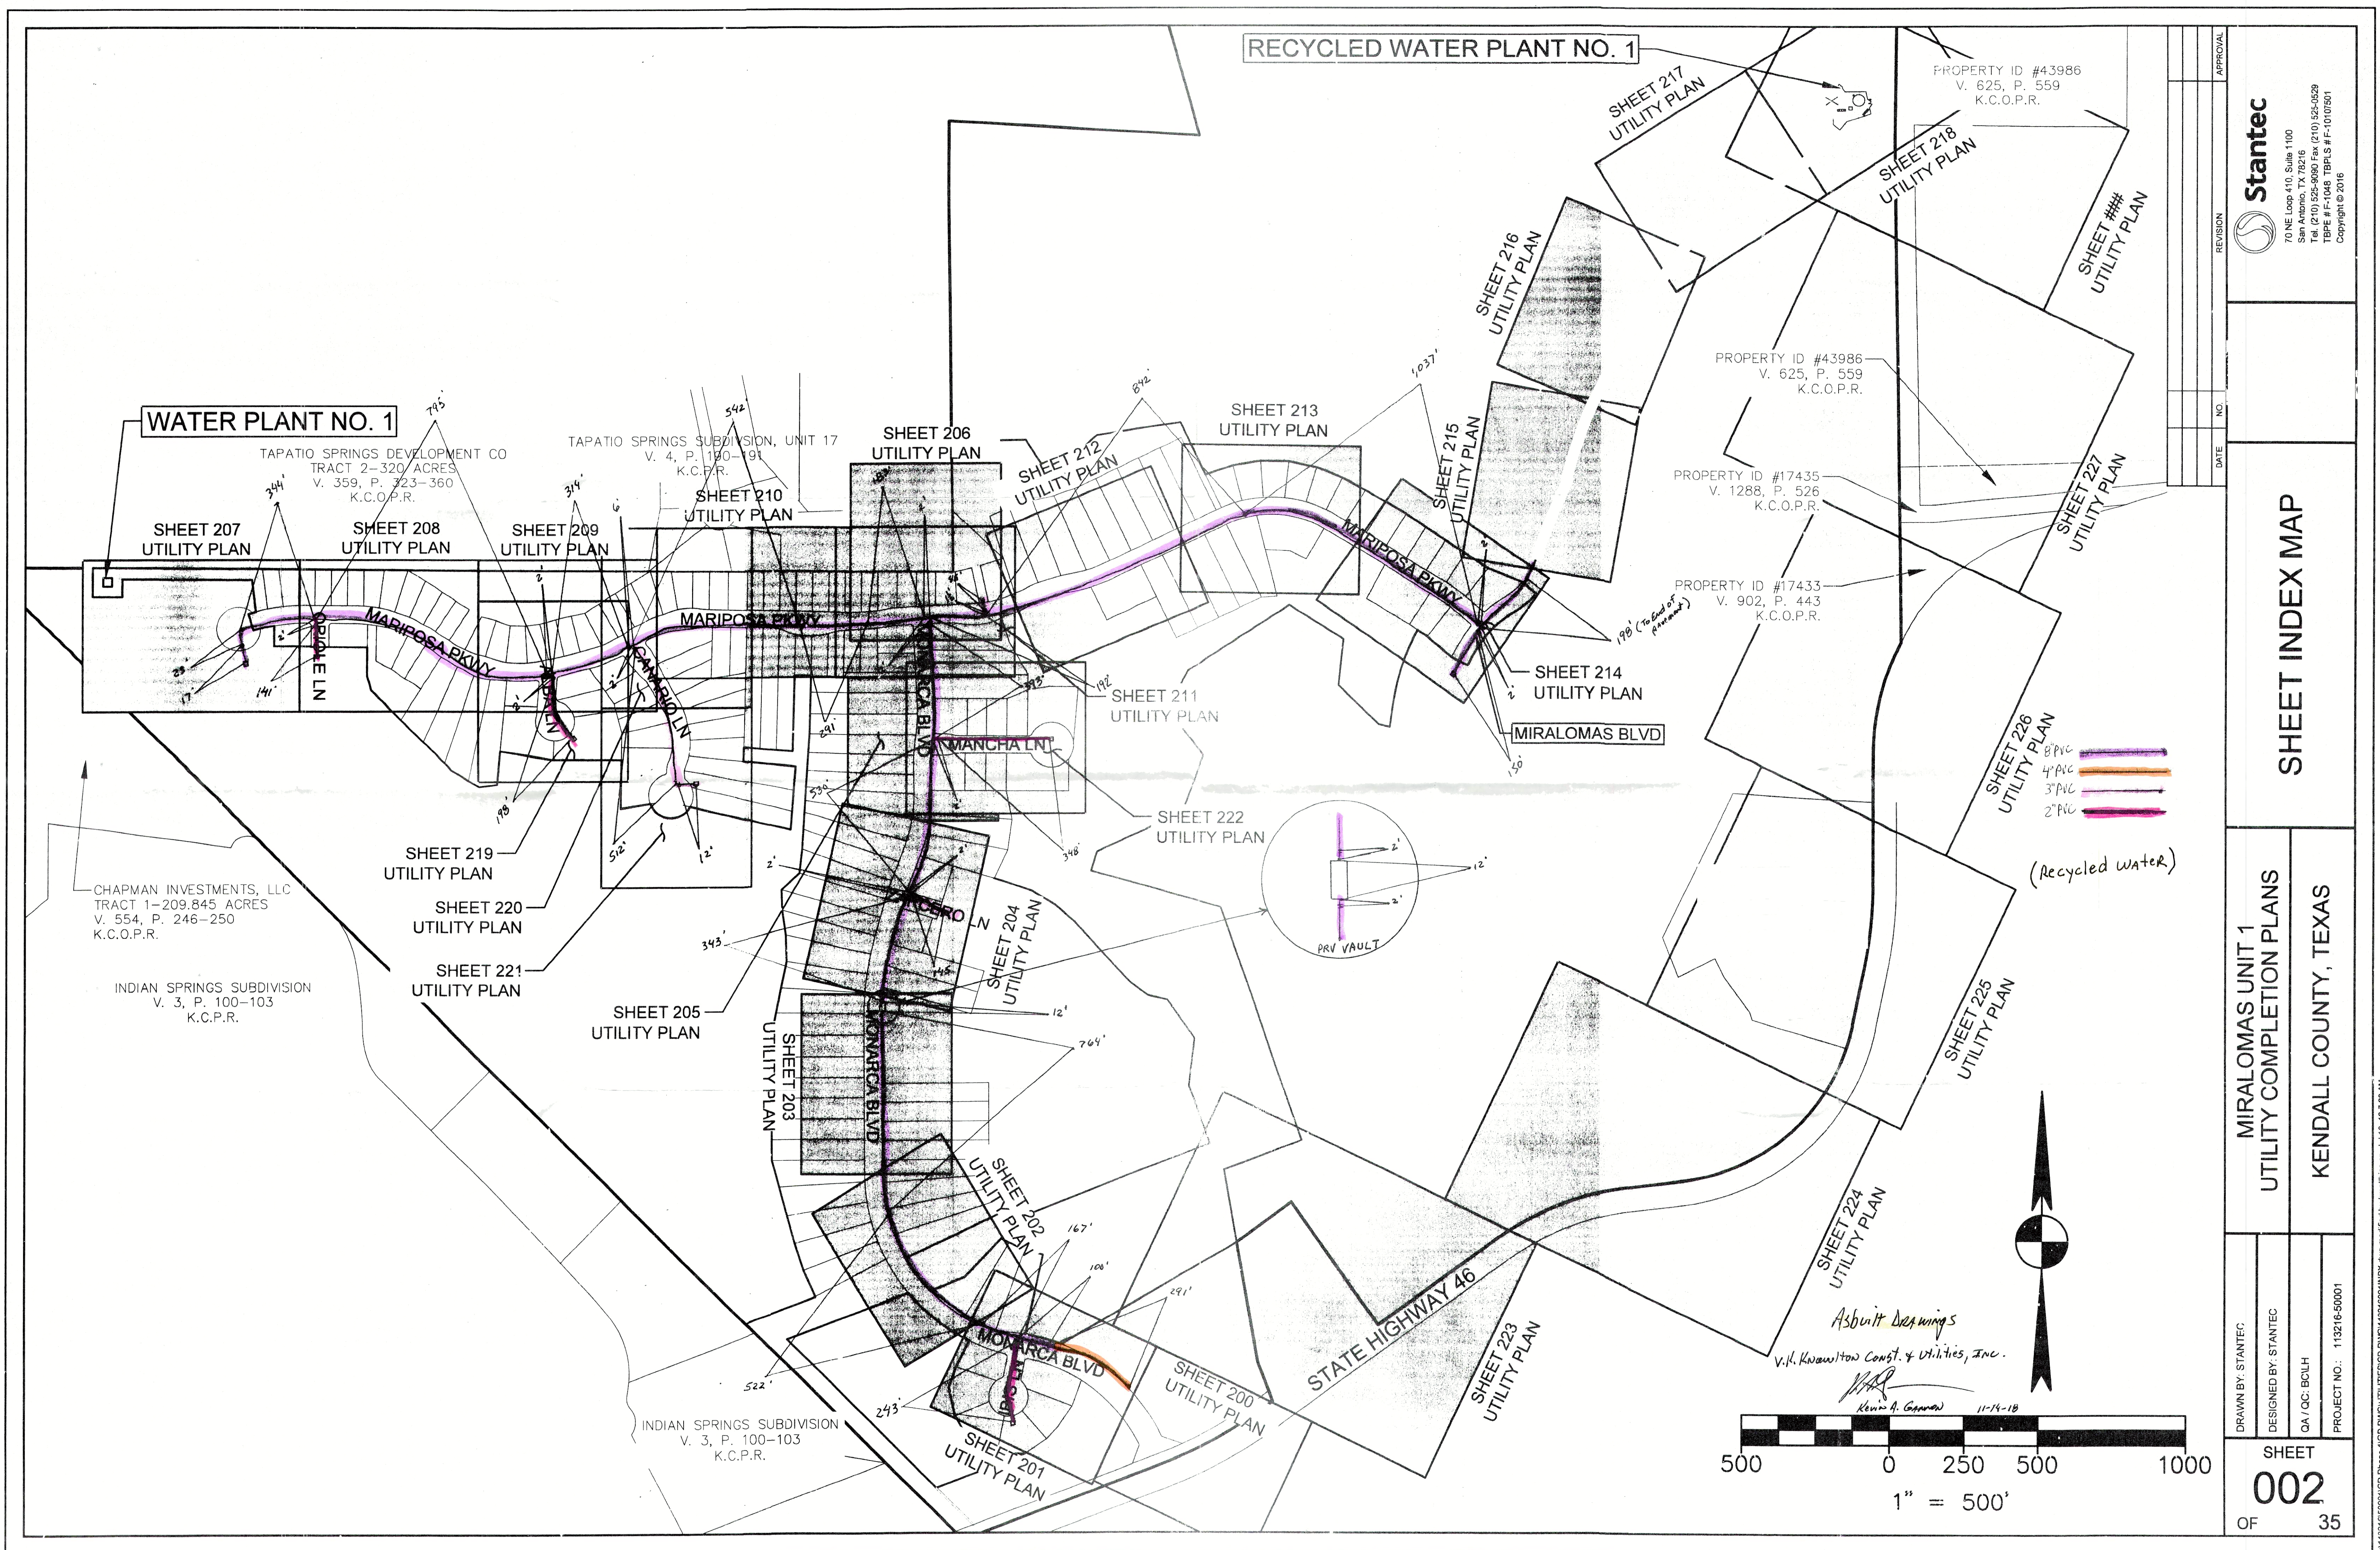


**Stantec**  
70 NE Loop 410, Suite 1100  
San Antonio, TX 78216  
Tel. (210) 525-9090 Fax (210) 525-0529  
TBP# F-1046 TBP# F-10107501  
Copyright © 2016

# SHEET INDEX MAP


MIRALOMAS UNIT 1  
UTILITY COMPLETION PLANS  
KENDALL COUNTY, TEXAS

DRAWN BY: STANTEC  
DESIGNED BY: STANTEC  
QA/QC: BOLH  
PROJECT NO.: 113216-50001

SHEET  
**002**  
OF 35

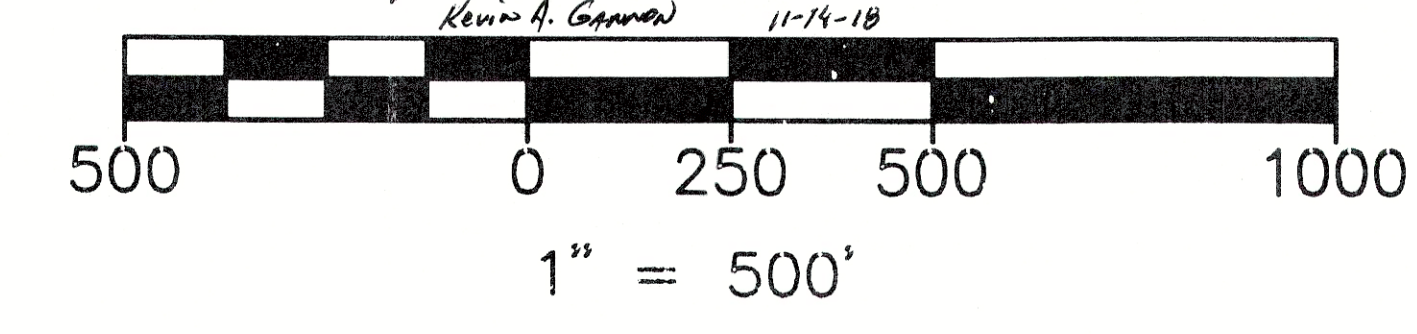

*Asbuilt Drawings*  
V.H. Knowlton Const. & Utilities, Inc.  
*Kevin A. Gannon* 11-14-18

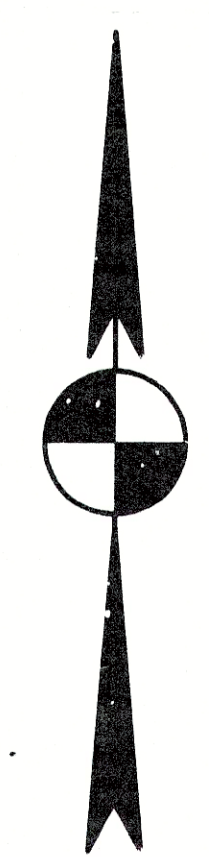

(Recycled water)

- 8\"/>

| DATE | NO. | REVISION | APPROVAL |
|------|-----|----------|----------|
|      |     |          |          |
|      |     |          |          |
|      |     |          |          |