


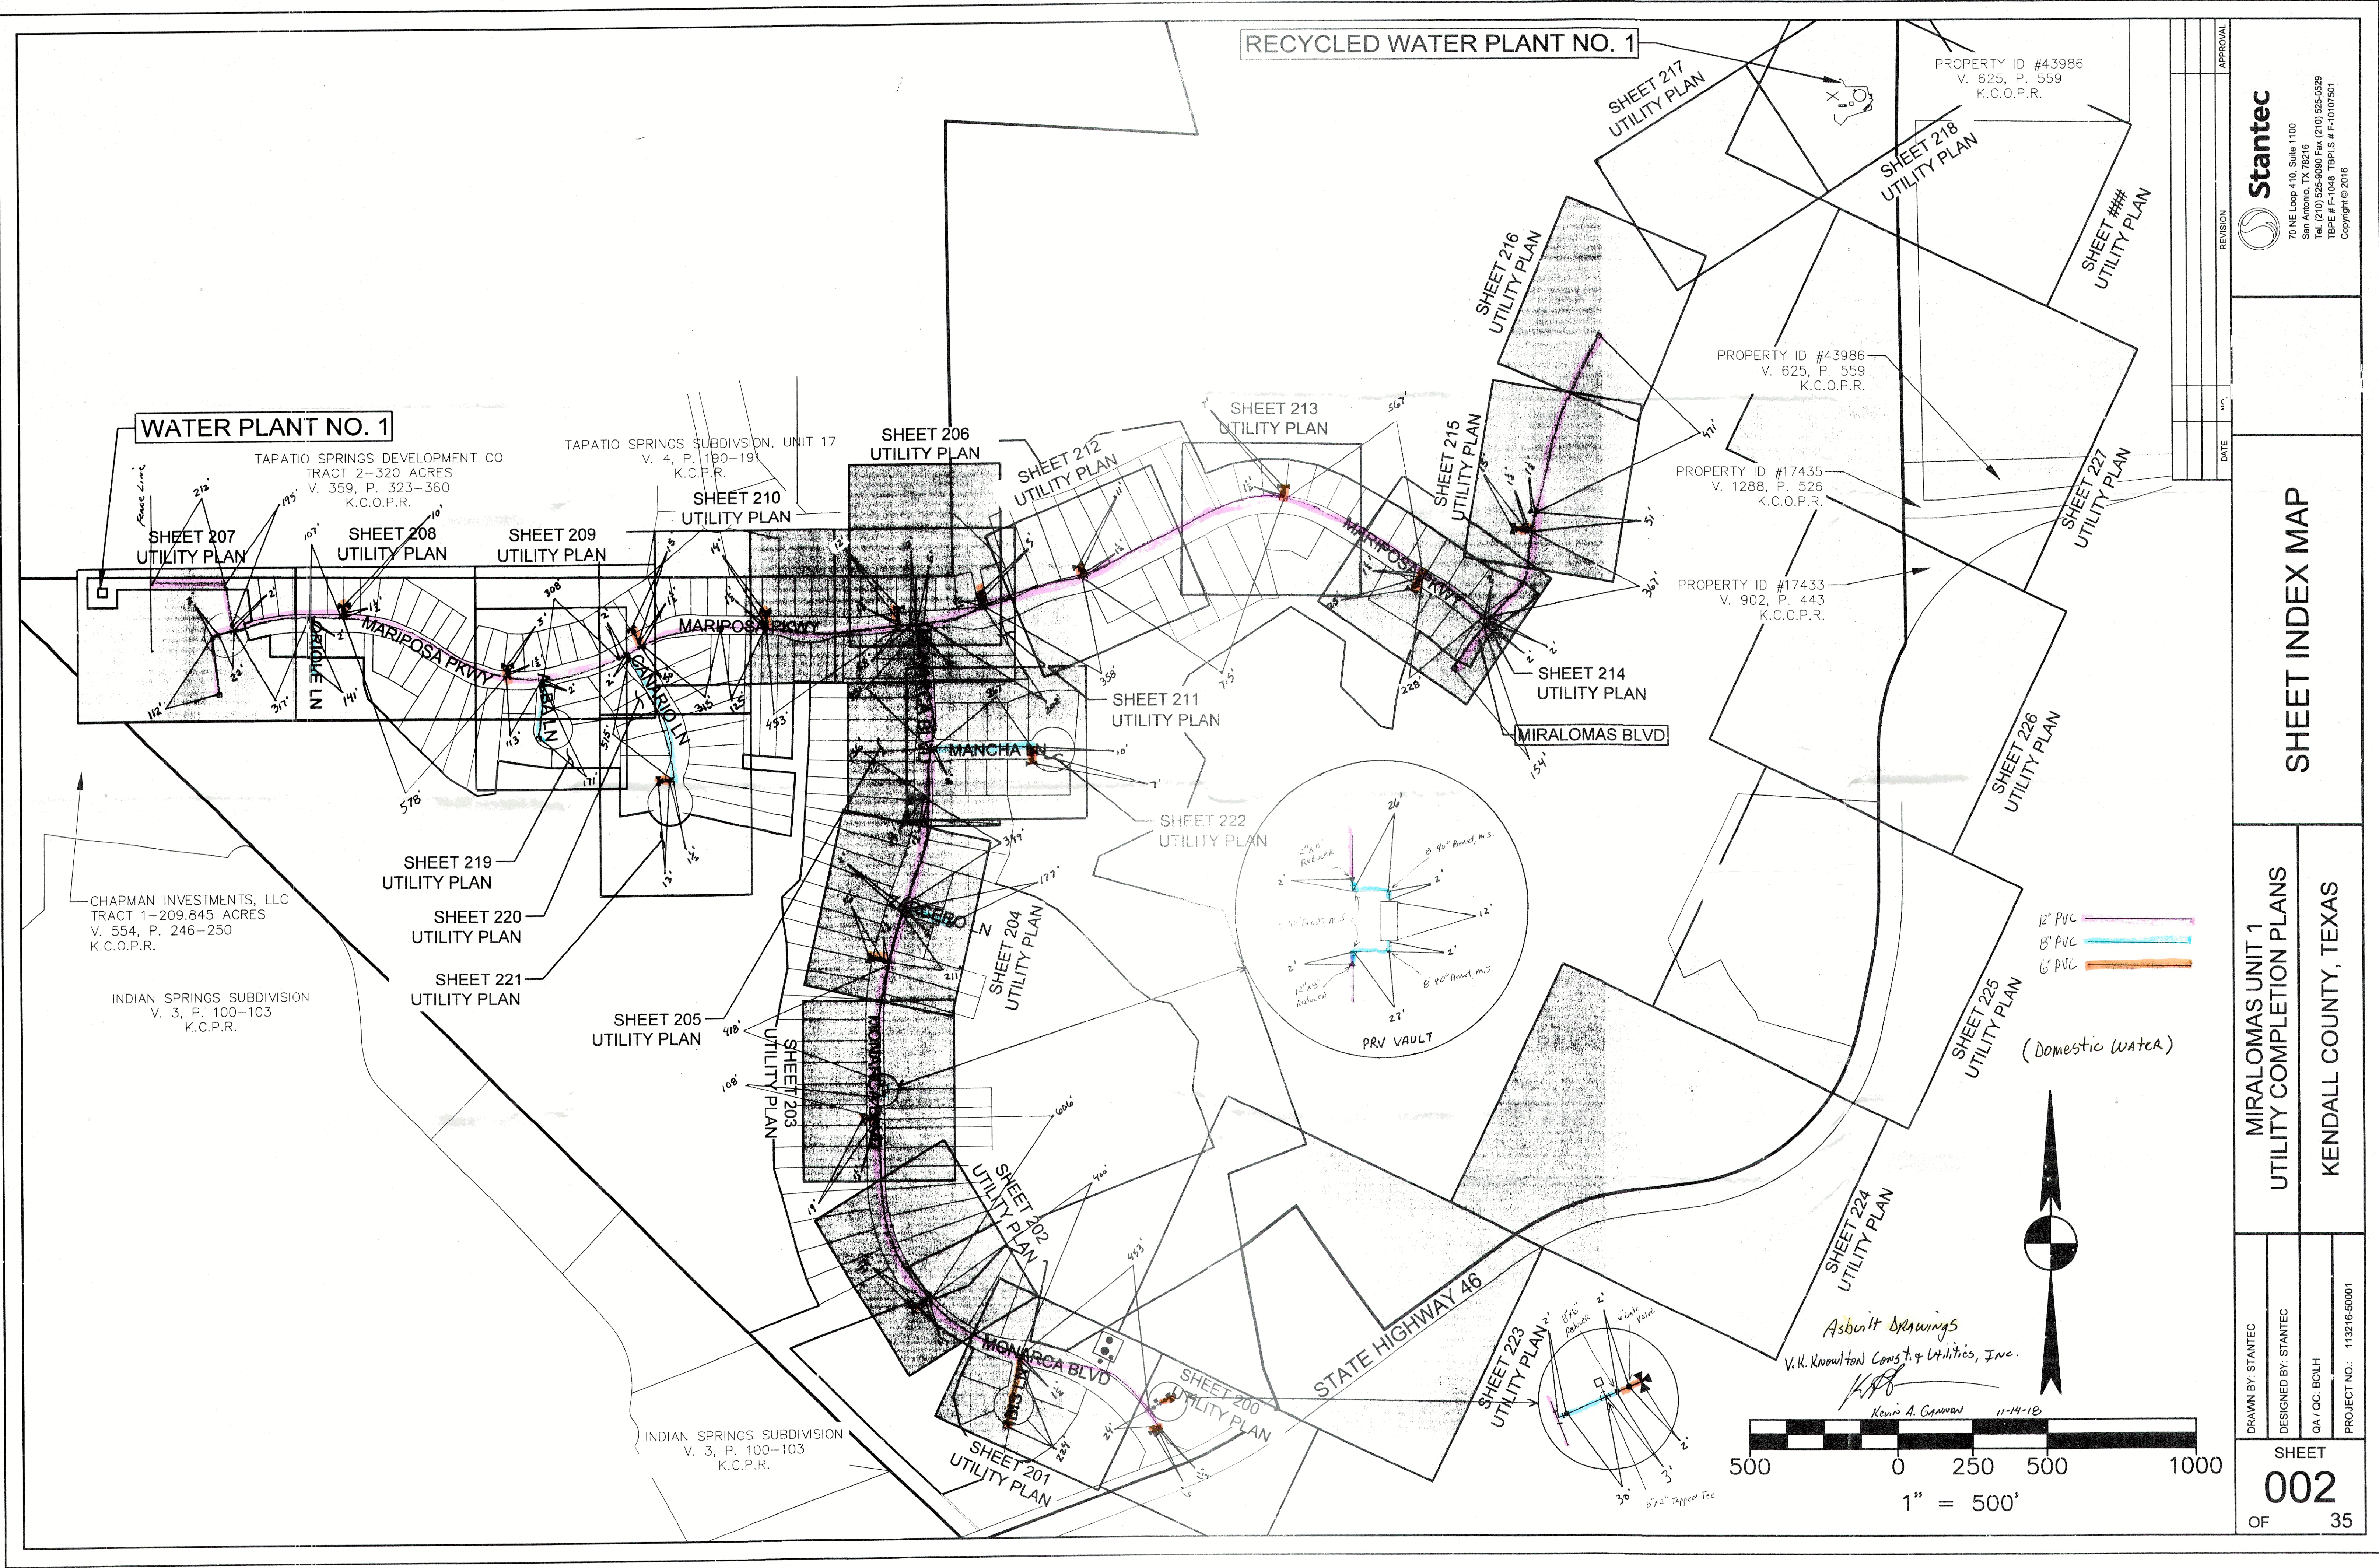

WATER PLANT NO. 1

RECYCLED WATER PLANT NO. 1

TAPATIO SPRINGS DEVELOPMENT CO
TRACT 2-320 ACRES
V. 359, P. 323-360
K.C.O.P.R.

TAPATIO SPRINGS SUBDIVISION, UNIT 17
V. 4, P. 190-191
K.C.P.R.

CHAPMAN INVESTMENTS, LLC
TRACT 1-209.845 ACRES
V. 554, P. 246-250
K.C.O.P.R.

INDIAN SPRINGS SUBDIVISION
V. 3, P. 100-103
K.C.P.R.

INDIAN SPRINGS SUBDIVISION
V. 3, P. 100-103
K.C.P.R.

PROPERTY ID #43986
V. 625, P. 559
K.C.O.P.R.

PROPERTY ID #43986
V. 625, P. 559
K.C.O.P.R.

PROPERTY ID #17435
V. 1288, P. 526
K.C.O.P.R.



PROPERTY ID #17433
V. 902, P. 443
K.C.O.P.R.

12" PVC
8" PVC
6" PVC

(Domestic Water)

Ascent Drawings
V.H. Knowlton Const. & Utilities, Inc.

Kevin A. Cannon 11-14-18

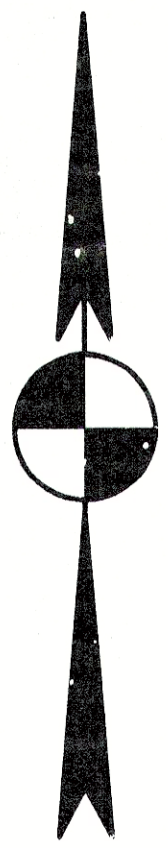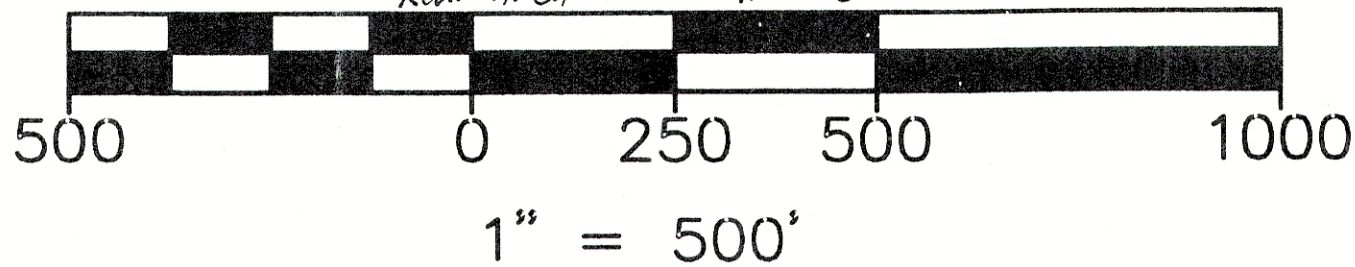

Stantec

70 NE Loop 410, Suite 1100
Southlake, TX 76095
Tel: (214) 555-0000 Fax: (214) 555-0020
Toll Free: 1-800-451-7261
Copyright © 2016

SHEET INDEX MAP

MIRALOMAS UNIT 1
UTILITY COMPLETION PLANS
KENDALL COUNTY, TEXAS

DRAWN BY: STANTEC
DESIGNED BY: STANTEC
QA / QC: BOUH
PROJECT NO.: 113216-50001

SHEET
002
OF 35