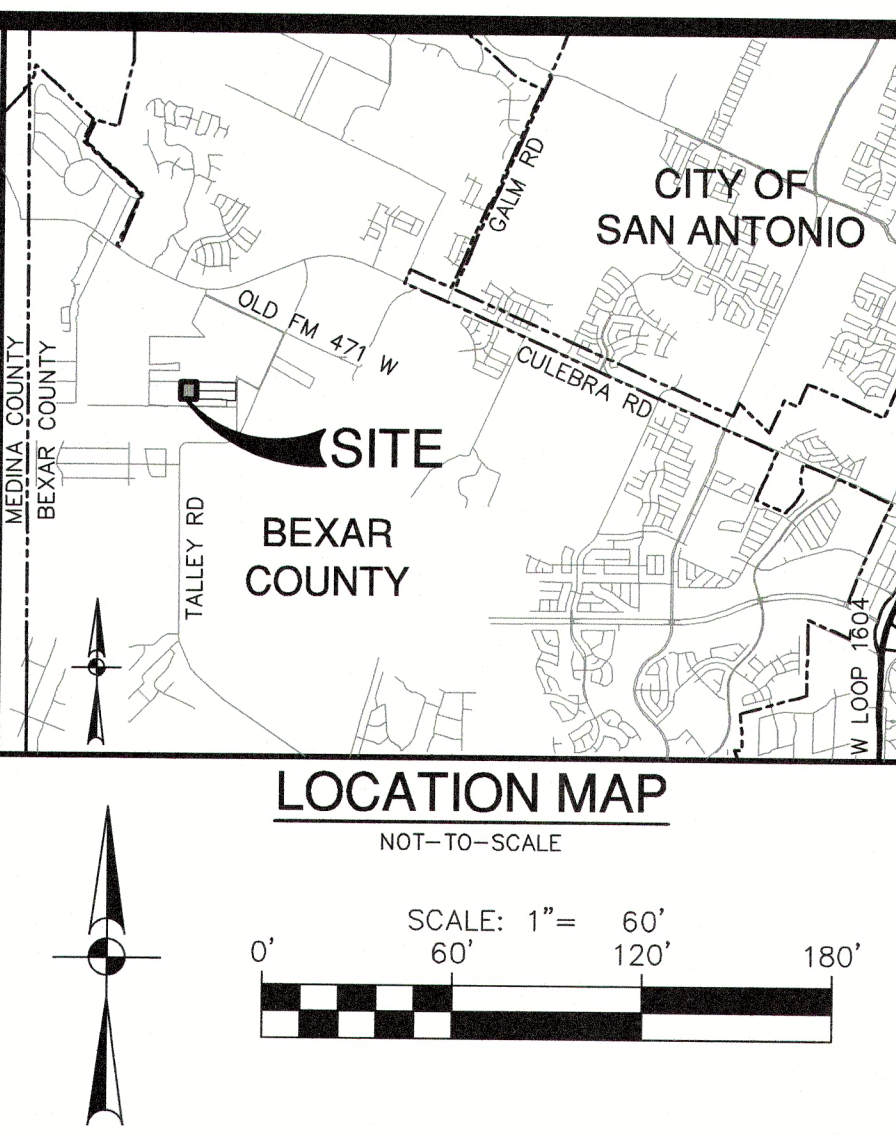
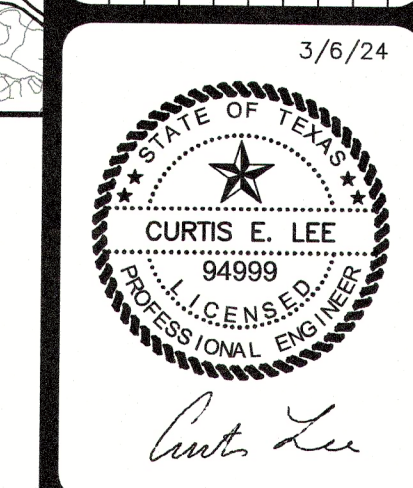


[illegible]

PAPE-DAWSON
PE ENGINEERS

OLD TALLEY, UNIT 3
SAN ANTONIO, TEXAS

PLAT NO. 22-11800442
JOB NO. 11806-05
DATE MARCH 2024
DESIGNER CEL
CHECKED CEL DRAWN JV
C4 00

Date: Mar 06, 2024, 8:44am User ID: BBreazeale
File: P:\118\06\05\Design\Civil\SNDA1180605.dwg

THIS DOCUMENT HAS BEEN PRODUCED FROM MATERIAL THAT WAS STORED AND/OR TRANSMITTED ELECTRONICALLY AND MAY HAVE BEEN INADVERTENTLY ALTERED. RELY ONLY ON FINAL HARDCOPY MATERIALS BEARING THE CONSULTANT'S ORIGINAL SIGNATURE AND SEAL. AERIAL IMAGERY PROVIDED BY GOOGLE© UNLESS OTHERWISE NOTED. Imagery © 2016, CAPCOG/Digital Globe, Texas Orthomapsy Program, USDA Farm Service Agency