


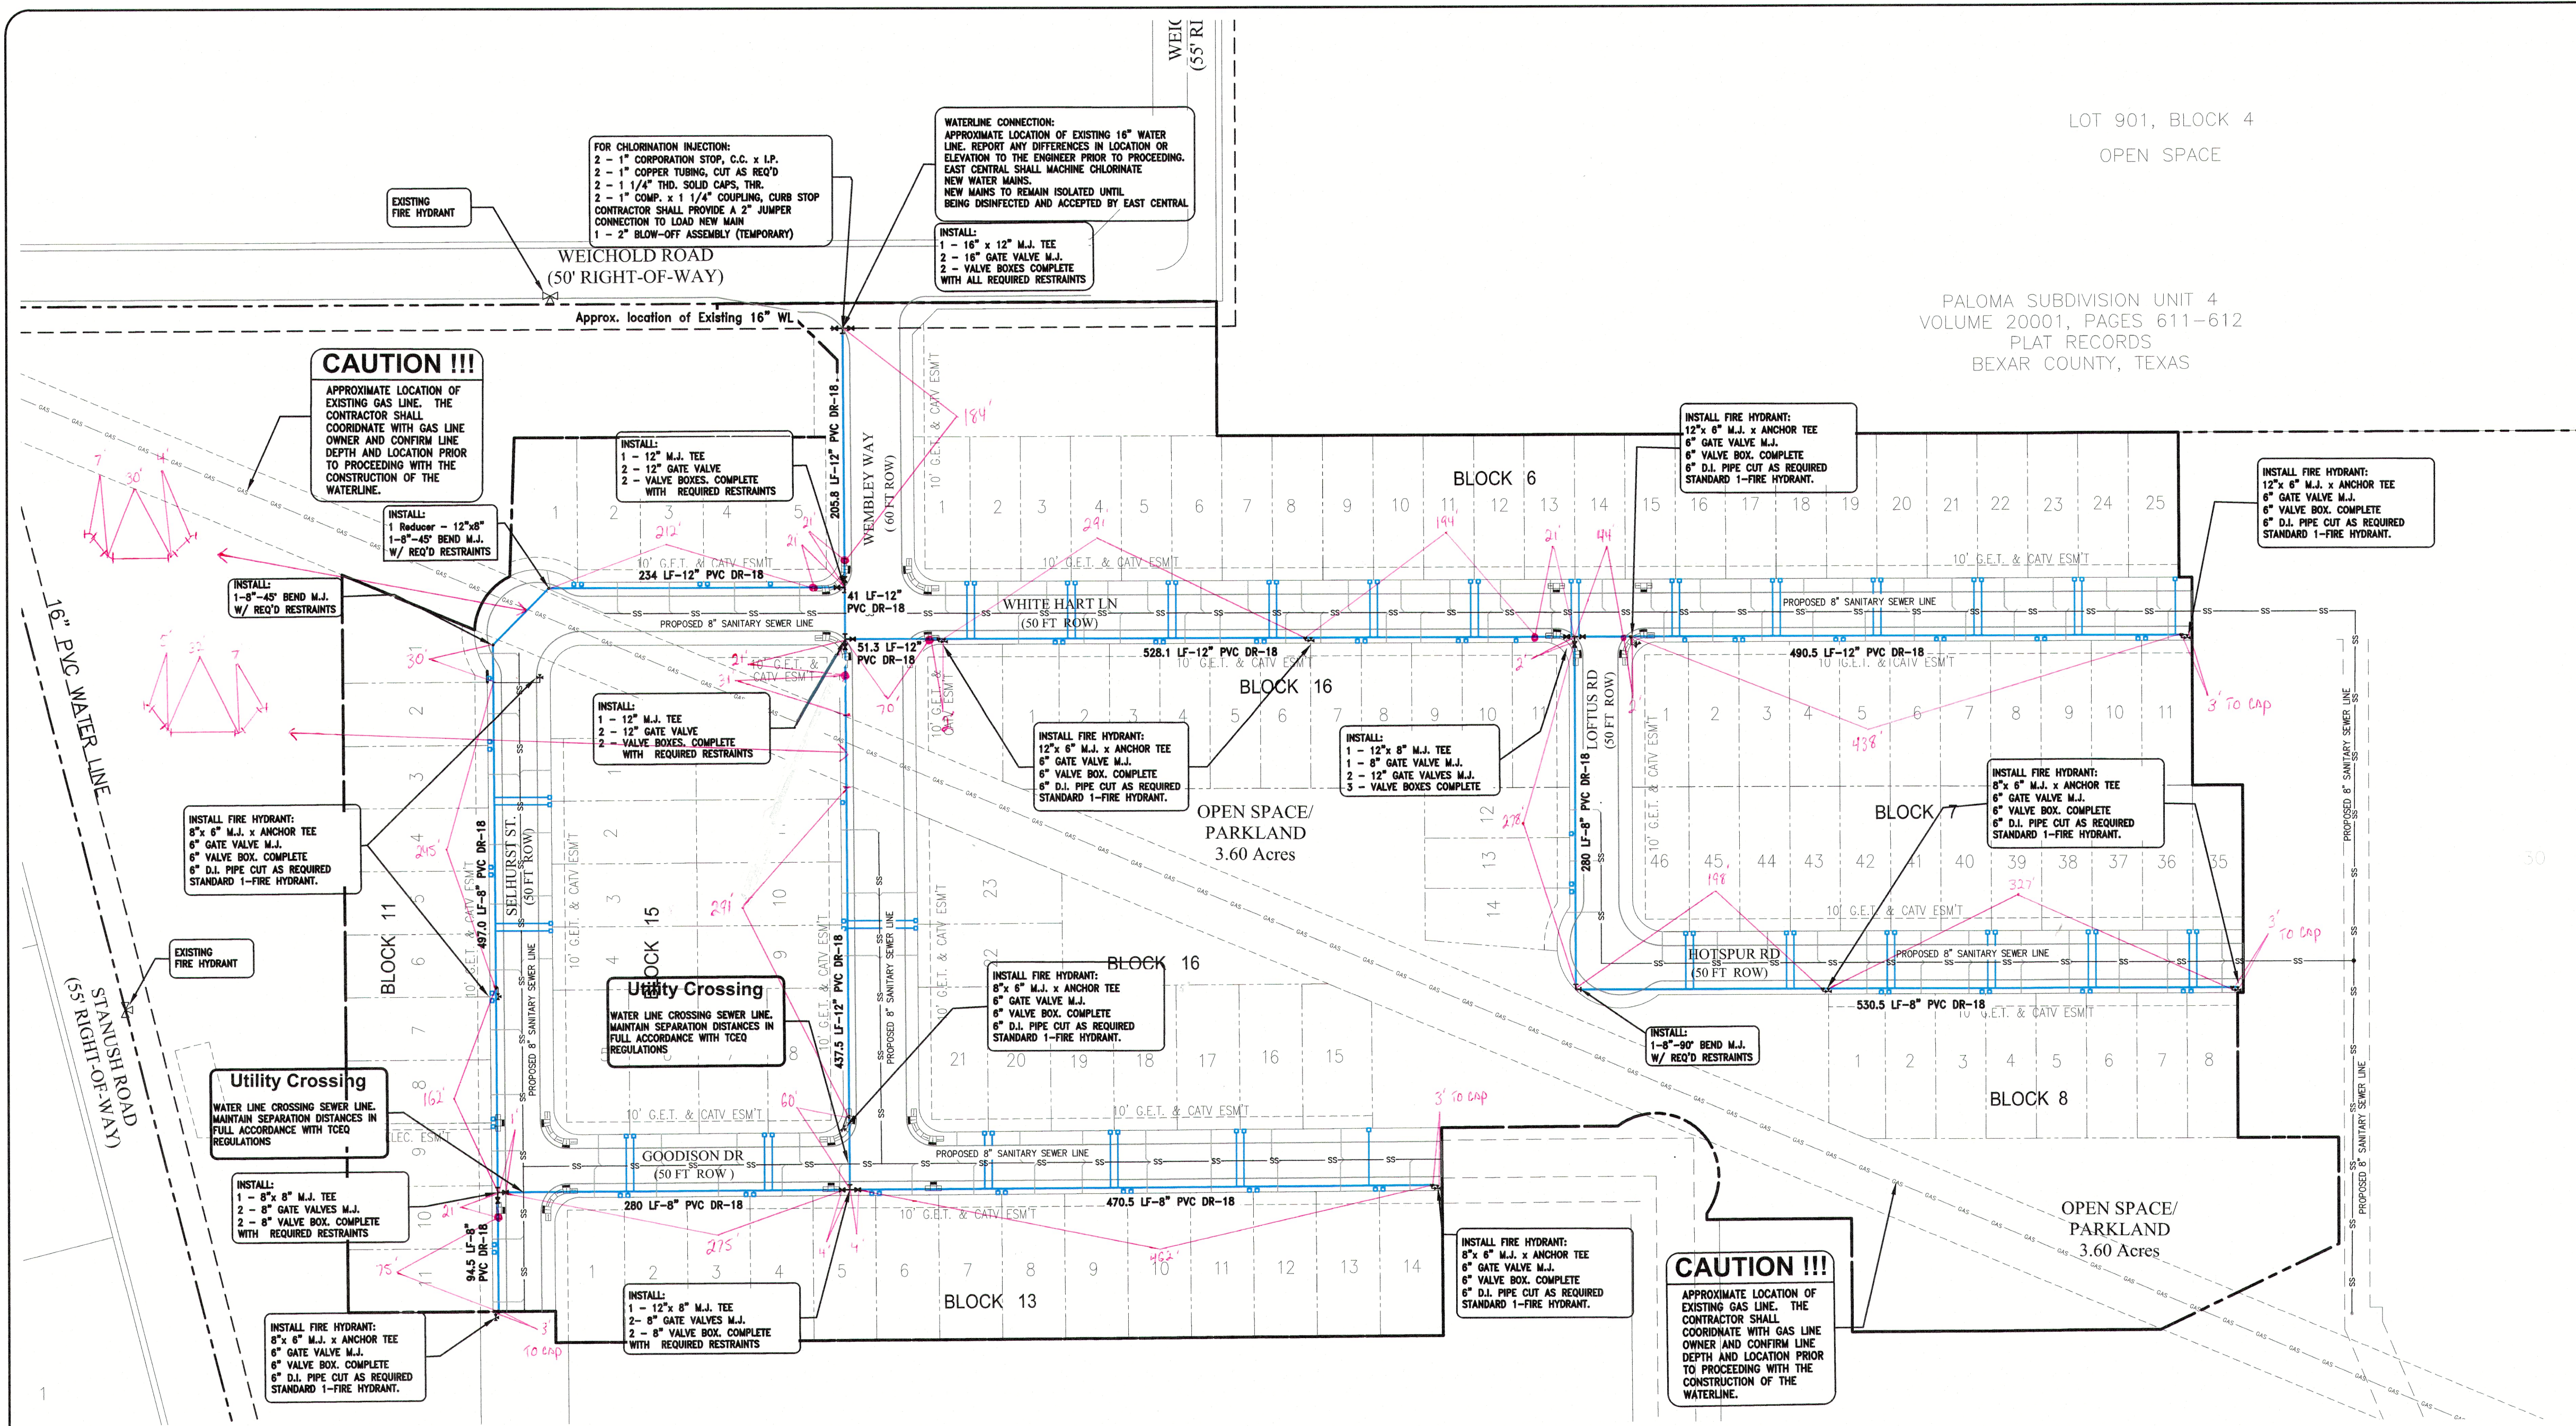

WATER DISTRIBUTION OVERALL PLAN VIEW

PLAN SCALE: 1" = 80' (24X36)

WATER DISTRIBUTION SYSTEM - ESTIMATE OF QUANTITIES			
ITEM	DESCRIPTION	QUANTITY	UNIT
	12" PVC DR-18 PIPE, C-900	1989	LF
	8" PVC DR-18 PIPE, C-900	2152	LF
	SINGLE SERVICE SHORT	66	EA
	SINGLE SERVICE LONG	54	EA
	8" GATE VALVE	5	EA
	FIRE HYDRANT	11	EA
	12" x 8" TEE	2	EA
	8" 90° BEND	1	EA
	16" x 12" TEE	0	EA
	8" CAP, MJ	2	EA
	2" TEMPORARY BLOW-OFF HYDRANT	2	EA
	12" GATE VALVE	6	EA
	16" GATE VALVE	2	EA
	12" TEE	2	EA
	12" x 8" REDUCER	1	EA
	8" TEE	1	EA

Designed By: JPS
Drawn By: RXL
Checked By: EM
Approved By: JPS
File: X:\Open Projects\8314.00 100-Acre Woods Tract\8.0 Cadd\8.4 Plan Sheets




SHERFEY
ENGINEERING
COMPANY, L.L.C.

T.B.P.E. FIRM REGISTRATION No. F-3132

104 Del Court
Suite 400
Laredo, Texas 78041
(956) 791-3511

PALOMA PARK SUBDIVISION
PHASE I
PLAT No. 22-11800343

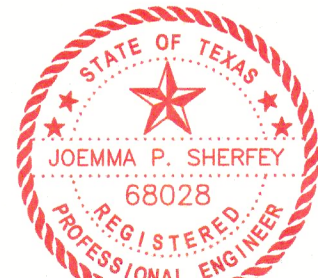

05/23/2023

WATER SYSTEM DISTRIBUTION PLAN

Scale: 1" = 80'

Date: 11/10/2022

Revised: 05/23/2023

PROJ. NO. 8314

4.1

SHEET 4.1 OF 44