

UTILITY LOCATION NOTE

THE EXISTING UTILITIES AS SHOWN ARE FROM INFORMATION PROVIDED BY THE UTILITY COMPANIES AND ARE SHOWN IN THE APPROXIMATE LOCATIONS AS DEPICTED ON UTILITY MAPS AND FIELD OBSERVATIONS FOR THE CONVENIENCE OF THE CONTRACTOR. THE CONTRACTOR SHALL VERIFY THE EXACT LOCATION AND DEPTH OF ALL UTILITIES PRIOR TO COMMENCING EXCAVATION AND TO NOTIFY THE OWNERS OF THOSE UTILITIES AT LEAST FOURTY-EIGHT HOURS IN ADVANCE OF CONSTRUCTION. THE CONTRACTOR SHALL MAKE PROVISIONS TO PROTECT AND SUPPORT ALL EXISTING UTILITIES DURING CONSTRUCTION. ANY DAMAGE TO EXISTING UTILITIES DURING CONSTRUCTION SHALL BE REPAIRED TO THE CURRENT STANDARDS OF THE OWNER OF THE UTILITY AT THE EXPENSE OF THE CONTRACTOR.

TRENCH EXCAVATION SAFETY PROTECTION

CONTRACTOR AND/OR CONTRACTOR'S INDEPENDENTLY RETAINED EMPLOYEE OR STRUCTURAL DESIGN/GEOTECHNICAL/ SAFETY/EQUIPMENT CONSULTANT, IF ANY SHALL REVIEW THESE PLANS AND ANY AVAILABLE GEOTECHNICAL INFORMATION AND THE ANTICIPATED INSTALLATION SITE(S) WITHIN THE PROJECT WORK AREA IN ORDER TO DEVELOP THE CONTRACTOR'S PLANS TO IMPLEMENT THE PROJECT DESCRIBED IN THE CONTRACT DOCUMENTS. THE CONTRACTOR'S PLAN SHALL PROVIDE FOR ADEQUATE TRENCH SAFETY SYSTEMS THAT COMPLY WITH AS MINIMUM, OSHA STANDARDS FOR TRENCH EXCAVATIONS. SPECIFICALLY, CONTRACTOR OF CONTRACTOR'S INDEPENDENTLY RETAINED EMPLOYEE OR SAFETY CONSULTANT SHALL DEVELOP AND IMPLEMENT A TRENCH SAFETY PROGRAM IN ACCORDANCE WITH OSHA STANDARDS GOVERNING THE PRESENCE AND ACTIVITIES OF INDIVIDUALS WORKING IN AND AROUND TRENCH EXCAVATION.

LEGEND

- DOUBLE WATER SERVICE LATERAL
- SINGLE WATER SERVICE LATERAL
- SEWER SERVICE LATERAL
- PROPOSED FIRE HYDRANT
- EXISTING FIRE HYDRANT
- PROPOSED WATER MAIN
- EXISTING WATER MAIN
- PROPOSED SEWER MAIN
- EXISTING SEWER LINE
- PROPOSED SS MANHOLE
- PROPOSED SS CLEANOUT
- PROPOSED STORM DRAINAGE

LOCATOR NOTE


CALL THE TEXAS STATEWIDE ONE CALL LOCATOR # 1-800-344-8377 AT LEAST 48 HOURS BEFORE BEGINNING ANY EXCAVATION.

SEWER SERVICE NOTE

SEWER SERVICES ARE NOT SHOWN FOR CLARITY OF THE DRAWING.

VICINITY MAP

Scale: N.T.S.

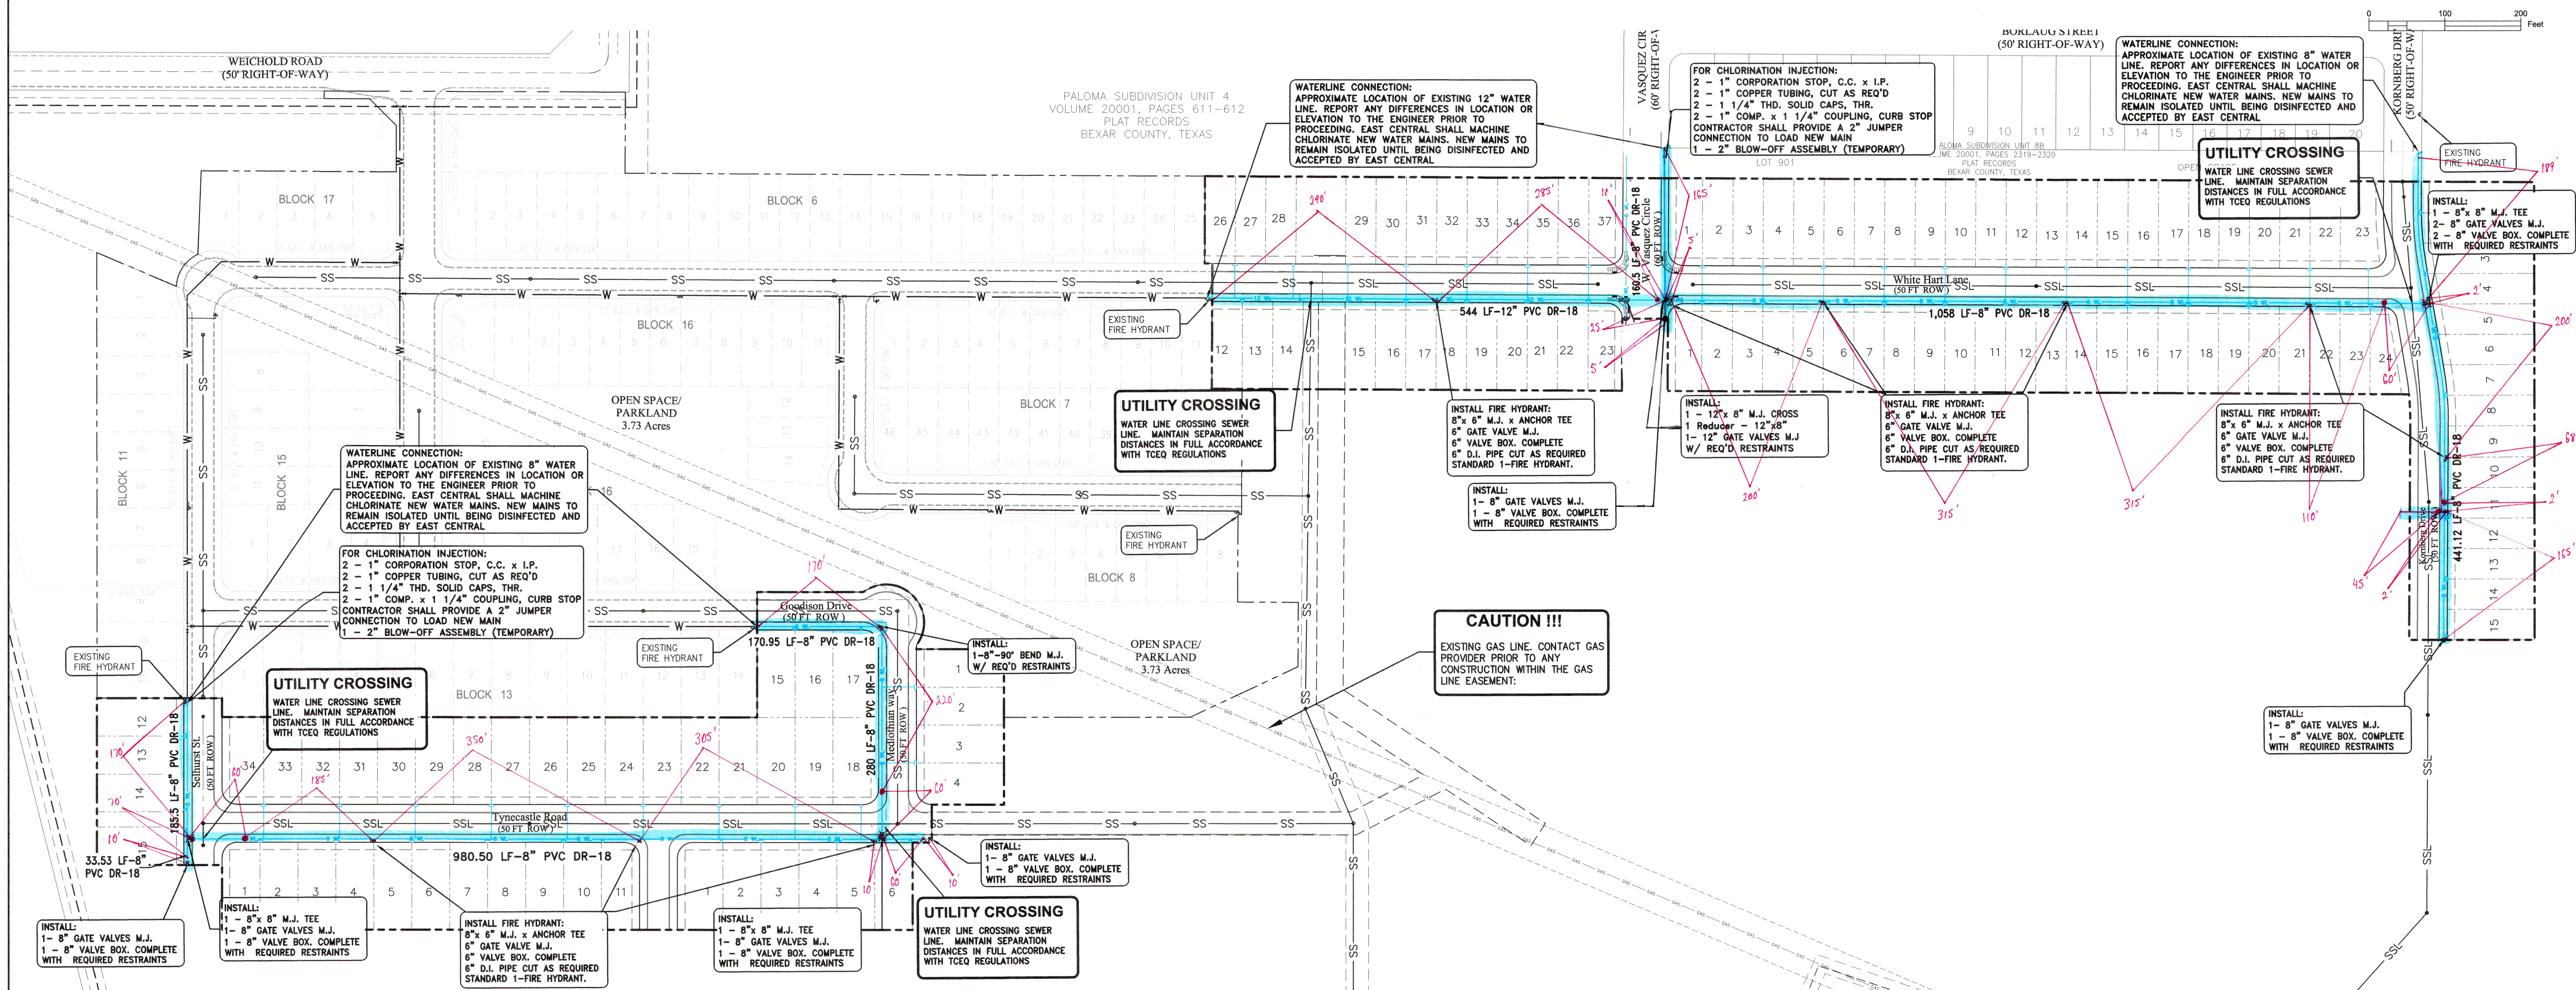


WATER DISTRIBUTION OVERALL PLAN VIEW

PLAN SCALE: 1" =100' (24X36)

Designed By: JPS
 Drawn By: RXL
 Checked By: JPS
 Approved By: JPS
 File: \\open\projects\8314.02 Paloma Park Phase 2\8.0 Civil\8.4 Plan Sheets\WATER SYSTEM DISTRIBUTION PLAN

Revision	Date	Description

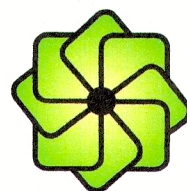


SHERFEY
 ENGINEERING
 COMPANY, L.L.C.

T.B.P.E. FIRM REGISTRATION No. F-3132

104 Del Court
 Suite 400
 Laredo, Texas 78041
 (956) 791-3511

PALOMA PARK SUBDIVISION PHASE II

PLAT No. 24-11800309

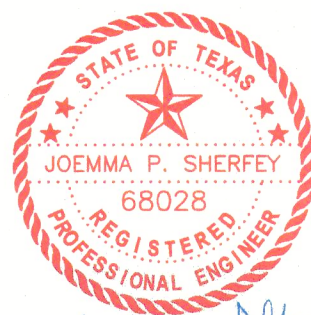

Joemma P. Sherfey
 07/31/2024

WATER SYSTEM DISRIBUTION PLAN

Scale:

Date: 7/31/2024

Revised:

PROJ. NO. 8314.02

4.1

SHEET 4.1 OF 40