


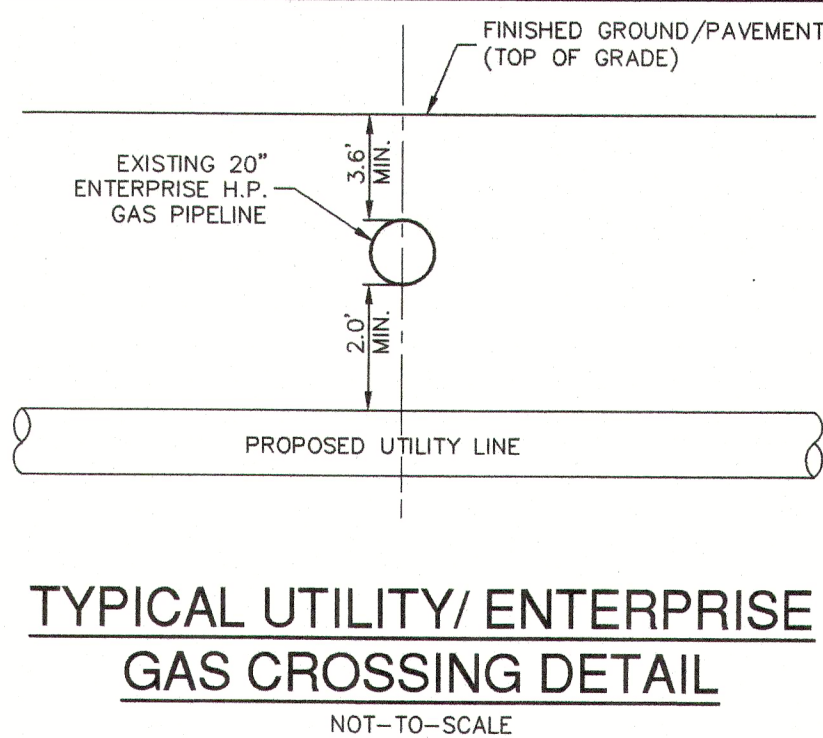


WARNING !!!


HIGH PRESSURE PIPELINE EVACUATION AND/OR CONSTRUCTION PROHIBITED WITHOUT WRITTEN PERMISSION FROM ENTERPRISE.

ADDITIONAL CONSTRUCTION NOTES:

- PRIOR TO SITE MOBILIZATION, CONTRACTOR SHALL OBTAIN A FINAL EXECUTED COPY OF THE "ENTERPRISE TEXAS PIPELINE, LLC-ENCROACHMENT AGREEMENT."
- AS PER "ENCROACHMENT AGREEMENT," CONTRACTOR SHALL PROVIDE 72-HOUR WRITTEN NOTICE PRIOR TO CROSSING OR WORKING WITHIN THE 50' ENTERPRISE PIPELINE EASEMENT.
- LOCAL ENTERPRISE CONTACTS INCLUDE:
 - CHESTER BLAIR (210)240-1157 MOB.
 - JUSTIN THOMAS (210)827-7201 MOB.
 - SAN ANTONIO (210)528-2782 OFF.

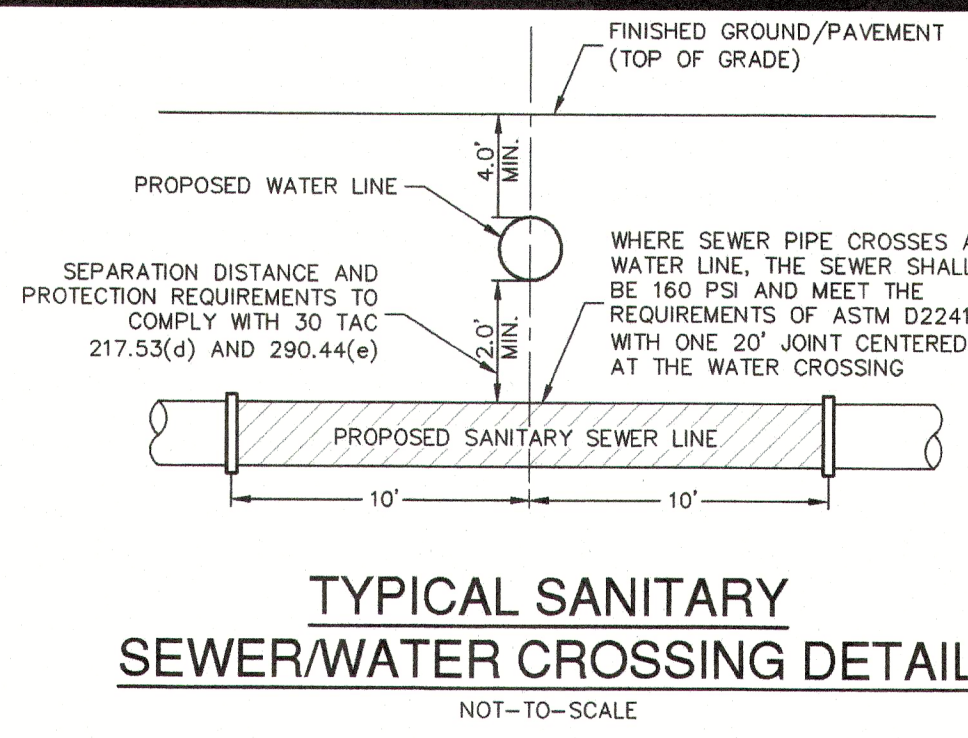

WASTEWATER (NBU JOB NO. WW-209399)			
ITEM	UNIT	QUANTITY	
8" SANITARY SEWER PIPE	LF	4,696	
10" SANITARY SEWER PIPE	LF	691	
LUES	EA	213	
6" WASTEWATER SERVICE	EA	209	
48" MANHOLES	EA	15	
CAPS	EA	-	

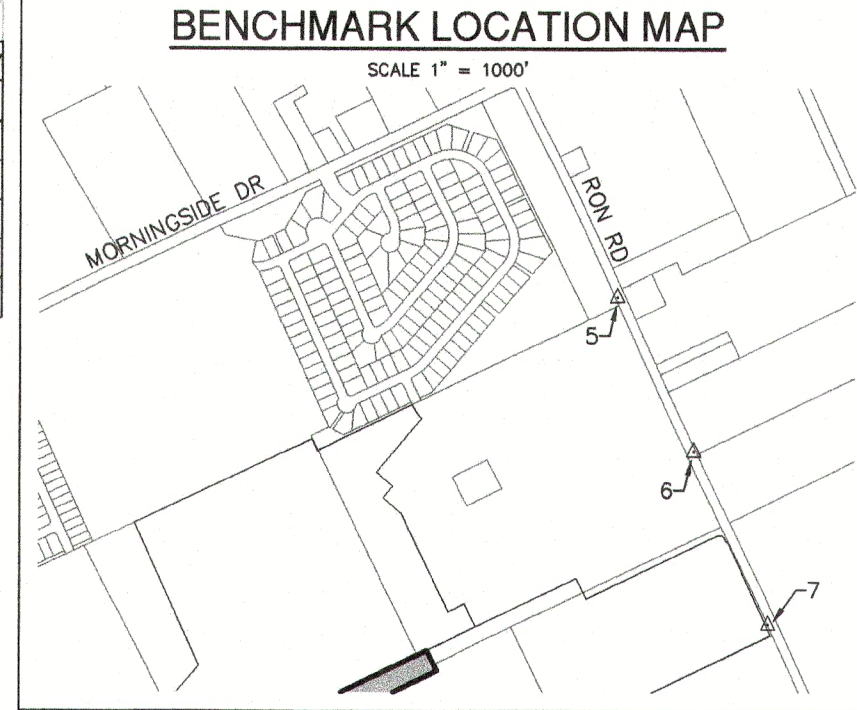

HORIZONTAL AND VERTICAL CONTROL POINTS				
Point #	Northing	Easting	Elevation	Full Description
5	13,790,938.63	2,237,803.08	739.28	SET I.R. REDCAP (TRAV)
6	13,790,126.56	2,238,209.12	729.52	SET I.R. REDCAP (TRAV)
7	13,789,219.89	2,238,601.76	727.47	SET I.R. REDCAP (TRAV)

