

92-6009

12-inch on OLD CORPUS CHRISTI ROAD RICHTER ROAD FROM STREICH ROAD TO RAILROAD TRACKS

1. VERIFY THE EXACT LOCATION OF UNDERGROUND UTILITIES AND DRAINAGE STRUCTURES WHETHER SHOWN ON PLANS OR NOT.
GAS 978-3500 ELECTRIC 978-3500 TELEPHONE 954-4002
2. TRENCH EXCAVATION PROTECTION SHALL BE ACCOMPLISHED AS REQUIRED BY THE PROVISIONS OF PART 1926, SUBPART P-EXCAVATIONS, TRENCHING, AND SHORING OF THE OCCUPATIONAL SAFETY AND HEALTH'S STANDARDS AND INTERPRETATIONS.
3. FURNISH AND INSTALL PERMANENT BLOW-OFF IN ACCORDANCE WITH STANDARD DRAWING DD-10-01 SHEET 3 OF 3, AND JUMPER CONNECTION AS REQUIRED OR AS DIRECTED BY THE CONSTRUCTION INSPECTOR.
4. COMPLY WITH THE REQUIREMENTS CONTAINED IN GC-3.1, CONTRACTOR'S NOTIFICATION, GENERAL CONDITIONS OF THE CONTRACT, STANDARD SPECIFICATIONS FOR WATER WORKS CONSTRUCTION.
5. IF THE CONTRACTOR SHOULD ENCOUNTER A SECTION OF ACEQUIA (EARLY SPANISH IRRIGATION DITCH) OR ANY OTHER ARCHEOLOGICAL DEPOSITS DURING CONSTRUCTION OPERATIONS, THE CONTRACTOR SHALL STOP EXCAVATION IMMEDIATELY, CONTACT THE CONSTRUCTION INSPECTOR AND CALL THE CITY HISTORIC PRESERVATION OFFICER AT 299-8303 FOR AN ARCHEOLOGICAL INVESTIGATION IN ACCORDANCE WITH SECTION 35-432.3 OF THE CITY CODE, "UNIDENTIFIED ARCHEOLOGICAL SITES" AND RELOCATE HIS FORCES TO OTHER SECTIONS WITHIN THE LIMITS OF THE ESTABLISHED AREA OF CONSTRUCTION OPERATIONS. THE CONTRACTOR SHALL NOT RESUME EXCAVATION IN THE CONCERNED SECTION WITHOUT WRITTEN PERMISSION FROM THE CITY HISTORIC PRESERVATION OFFICER. IF MORE THAN THREE DAYS, EXCLUDING HOLIDAYS AND WEEKENDS, ARE REQUIRED FOR INVESTIGATION AND ALSO THE CONTRACTOR CANNOT WORK ON OTHER AREAS, THE CONTRACTOR WILL BE AUTHORIZED TO NEGOTIATE FOR ADDITIONAL CONSTRUCTION TIME UPON WRITTEN REQUEST WITHIN TEN DAYS AFTER THE FIRST NOTICE TO THE CITY REGARDING ARCHEOLOGICAL INVESTIGATION FOR EACH EVENT. IF THE TIME REQUIRED FOR INVESTIGATION IS LESS THAN OR EQUAL TO THREE DAYS FOR EACH EVENT, CONTRACT DURATION WILL NOT BE EXTENDED.


SAN ANTONIO WATER SYSTEM


1. MR. ROYCE McDONALD, CONSTRUCTION INSPECTION DIVISION, OR HIS DESIGNATED REPRESENTATIVE, SHALL NOTIFY AT LEAST 48 HOURS PRIOR TO STARTING CONSTRUCTION:
(A) MR. IVAN SCHULMEIER, BEXAR COUNTY DEPARTMENT OF PUBLIC WORKS, AT 270-6700.
(B) MR. BUDDY CLARK, CITY PUBLIC SERVICE R.O.W. DEPT. AT 978-2341.
2. DISINFECT NEW MAINS BY MACHINE CHLORINATION UNLESS NOTED OTHERWISE ON PLANS.

MAPPED BY:	
DATE:	
MAP NO.'S:	

CONTRACTOR - SACC
INSPECTOR - C. KNEUPPER
COMPLETED - 3-31-95

6"D.I.F.H.	12"D.I.	16"D.I.
12	250	14
1 1/2	59 1/2	189
12	387	2
1 1/2	7	36
12	998	4
1 1/2	4	37 1/2
11	1000 1/2	3
1 1/2	4	332 1/2
11 1/2	451	168 1/2
1 1/2	281	35
4	44	389
1 1/2	4	4
1 1/2	288	996
8	28	4
1 1/2	32	996
8	7	4
1 1/2	997	450
8	4	4
99 1/2'	737	9312 1/2'
	14	
	47	

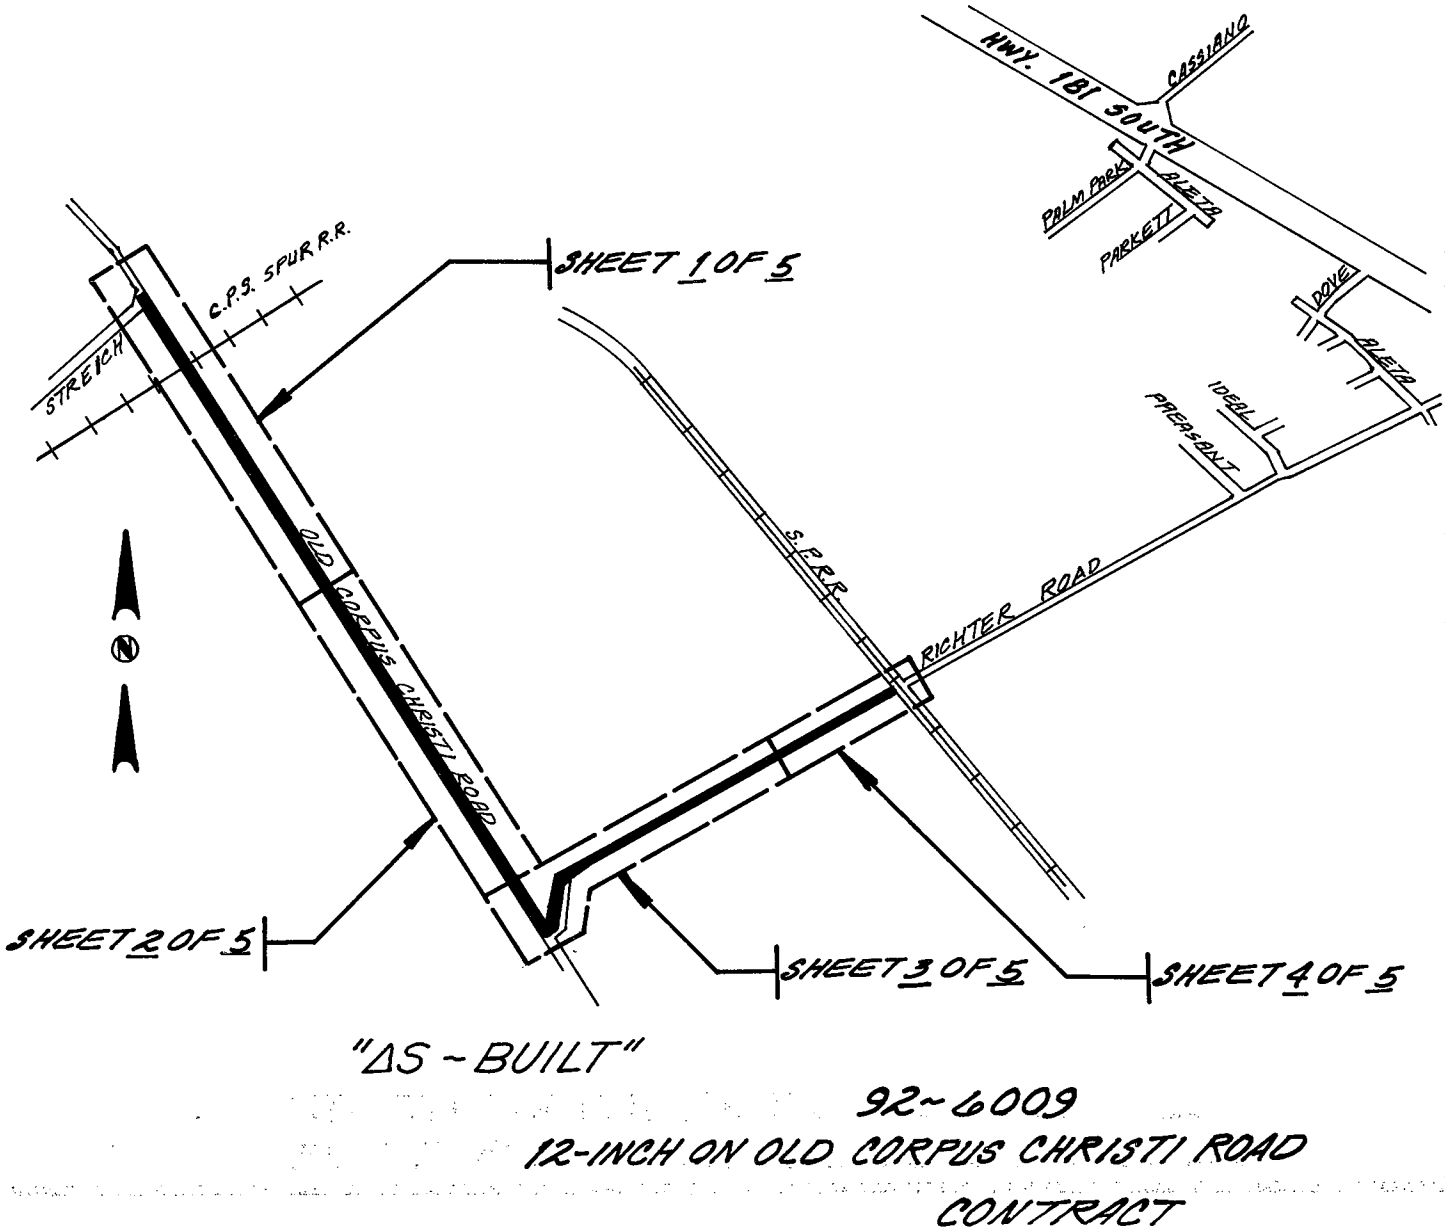


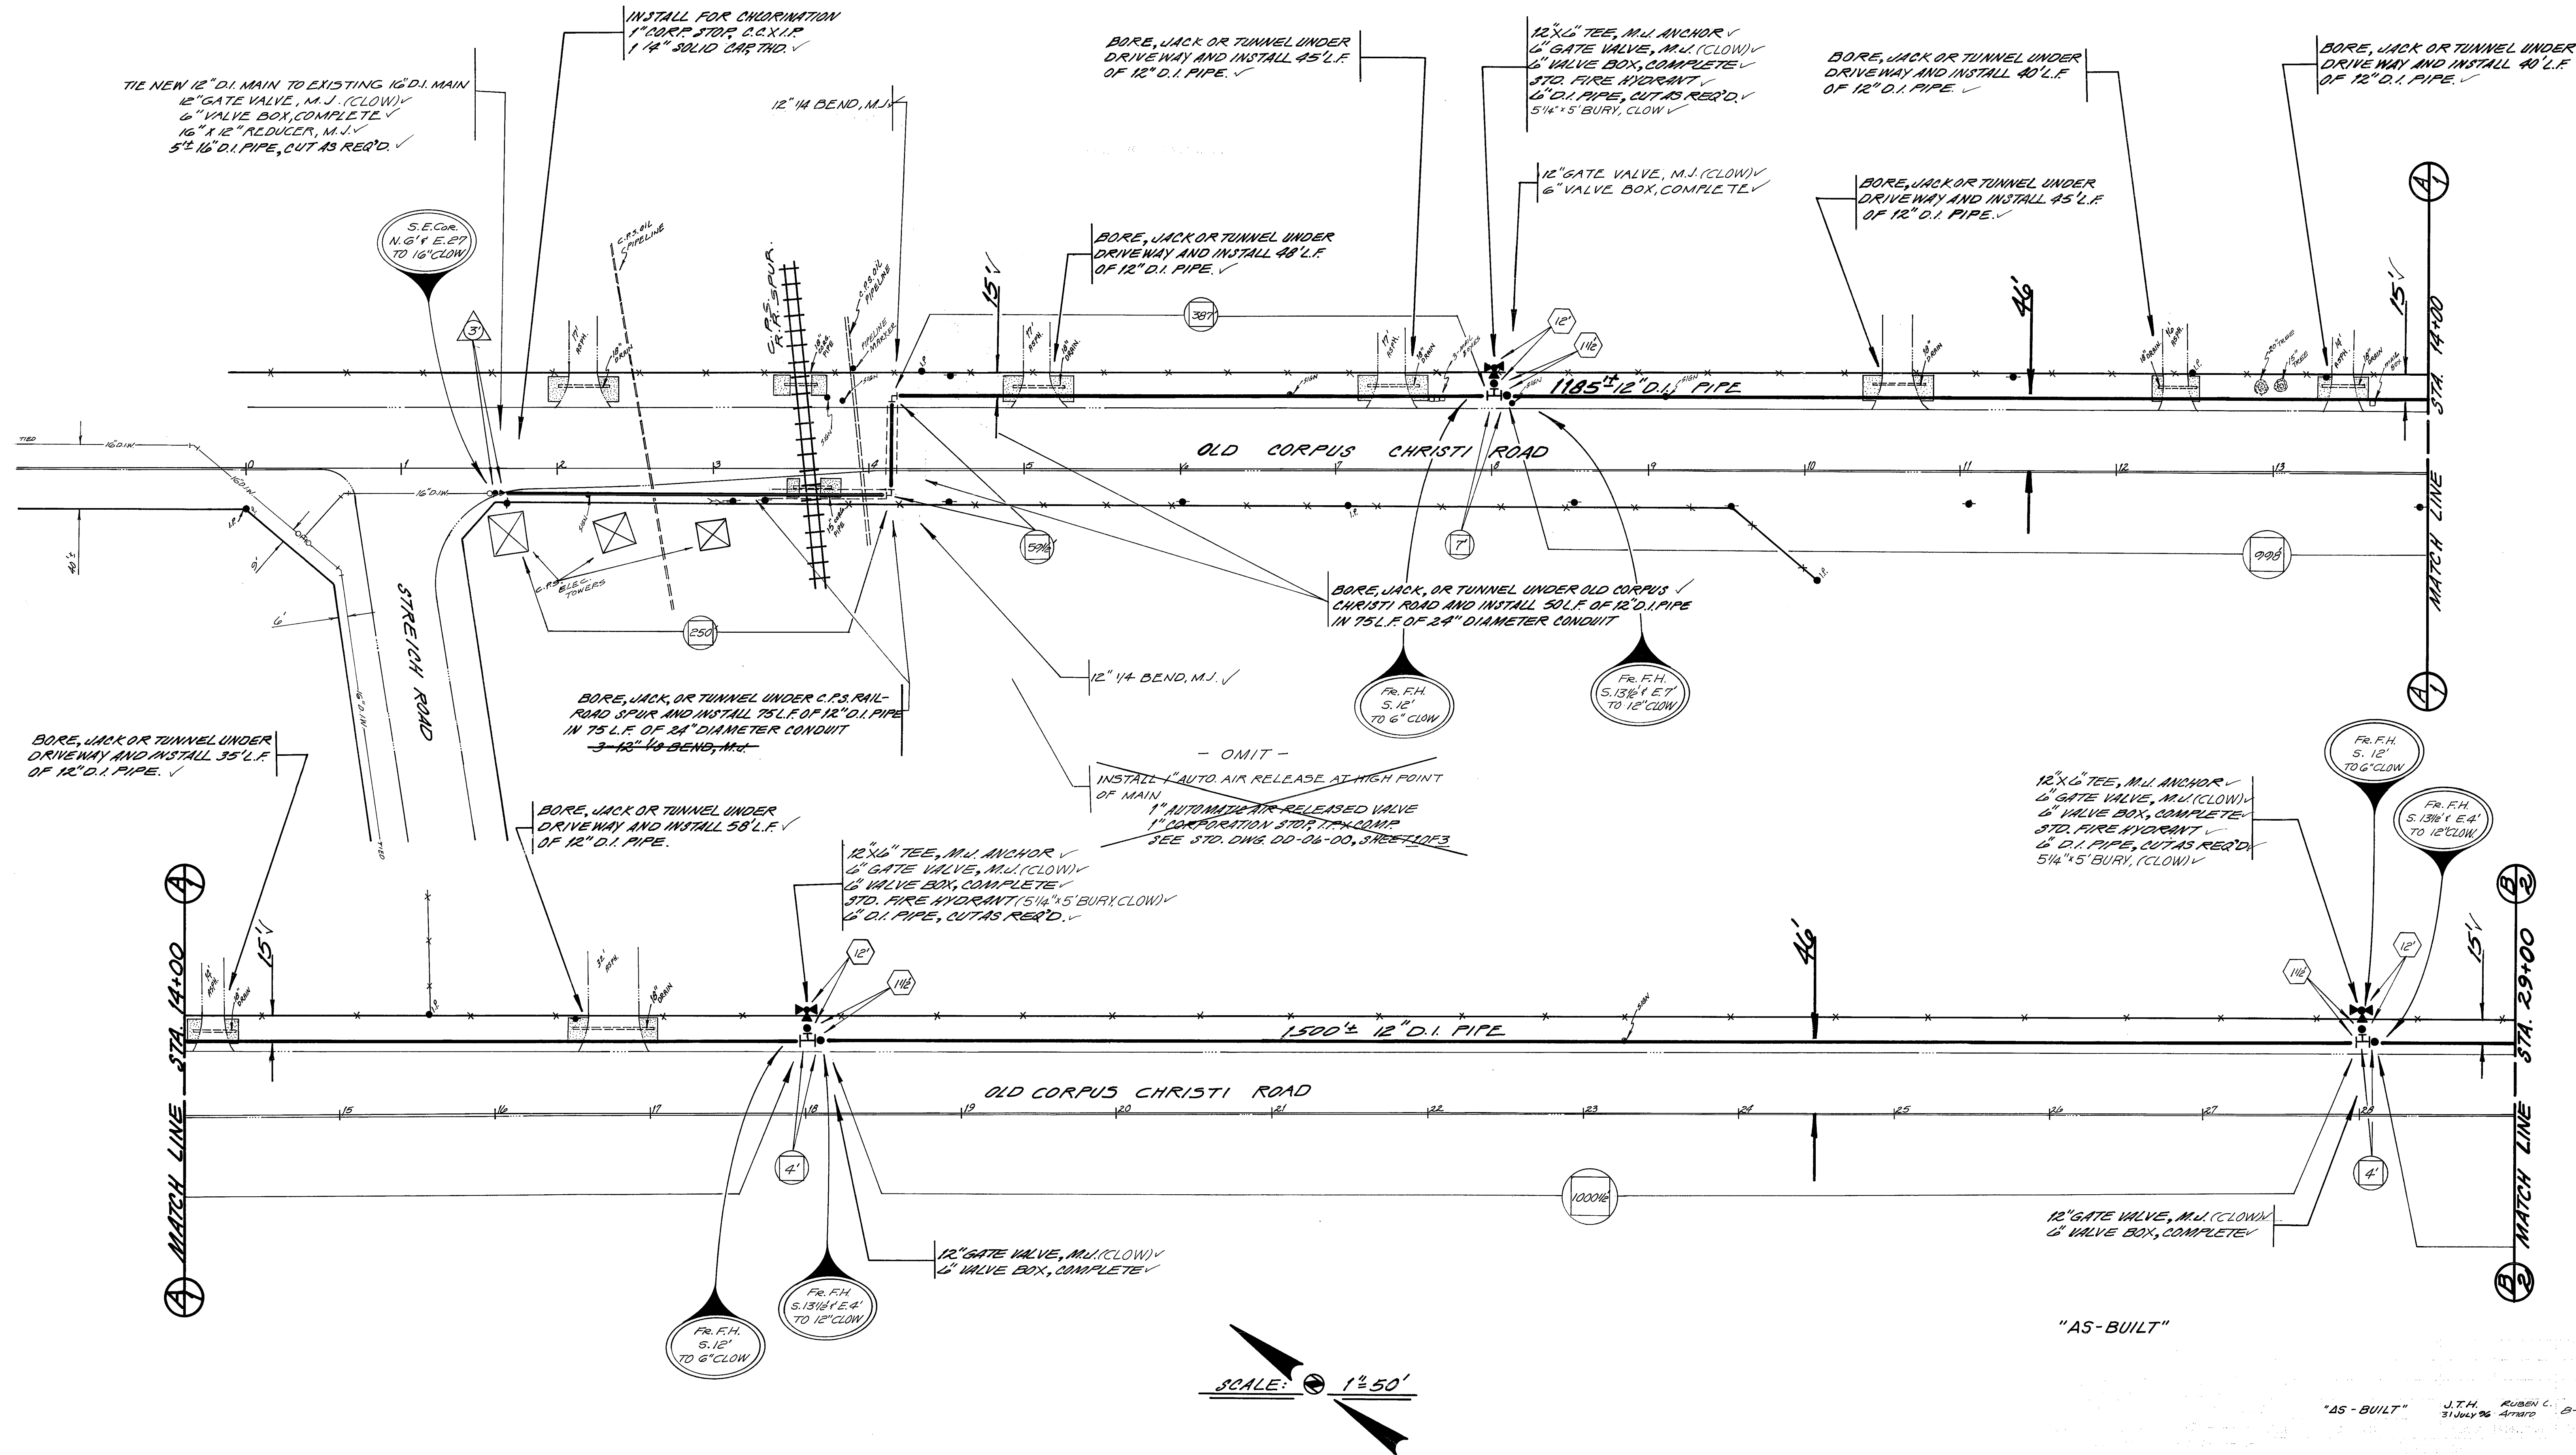

"AS-BUILT"

"45 - BUILT"

J.T.H. RUBEN C.
31 June 64. Attached 8-8-79

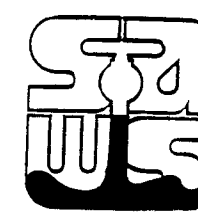

OLD CORPUS CHRISTI RD.
RICHTER RD. FROM STREICH RD.
TO RAILROAD TRACKS

SAN ANTONIO WATER SYSTEM
#54



Steven Linnekin
Ronald L. Pellmar

200-526

200-52

92-6009 5
CONTRACT

1

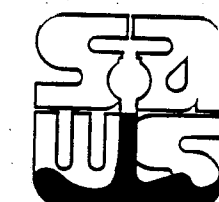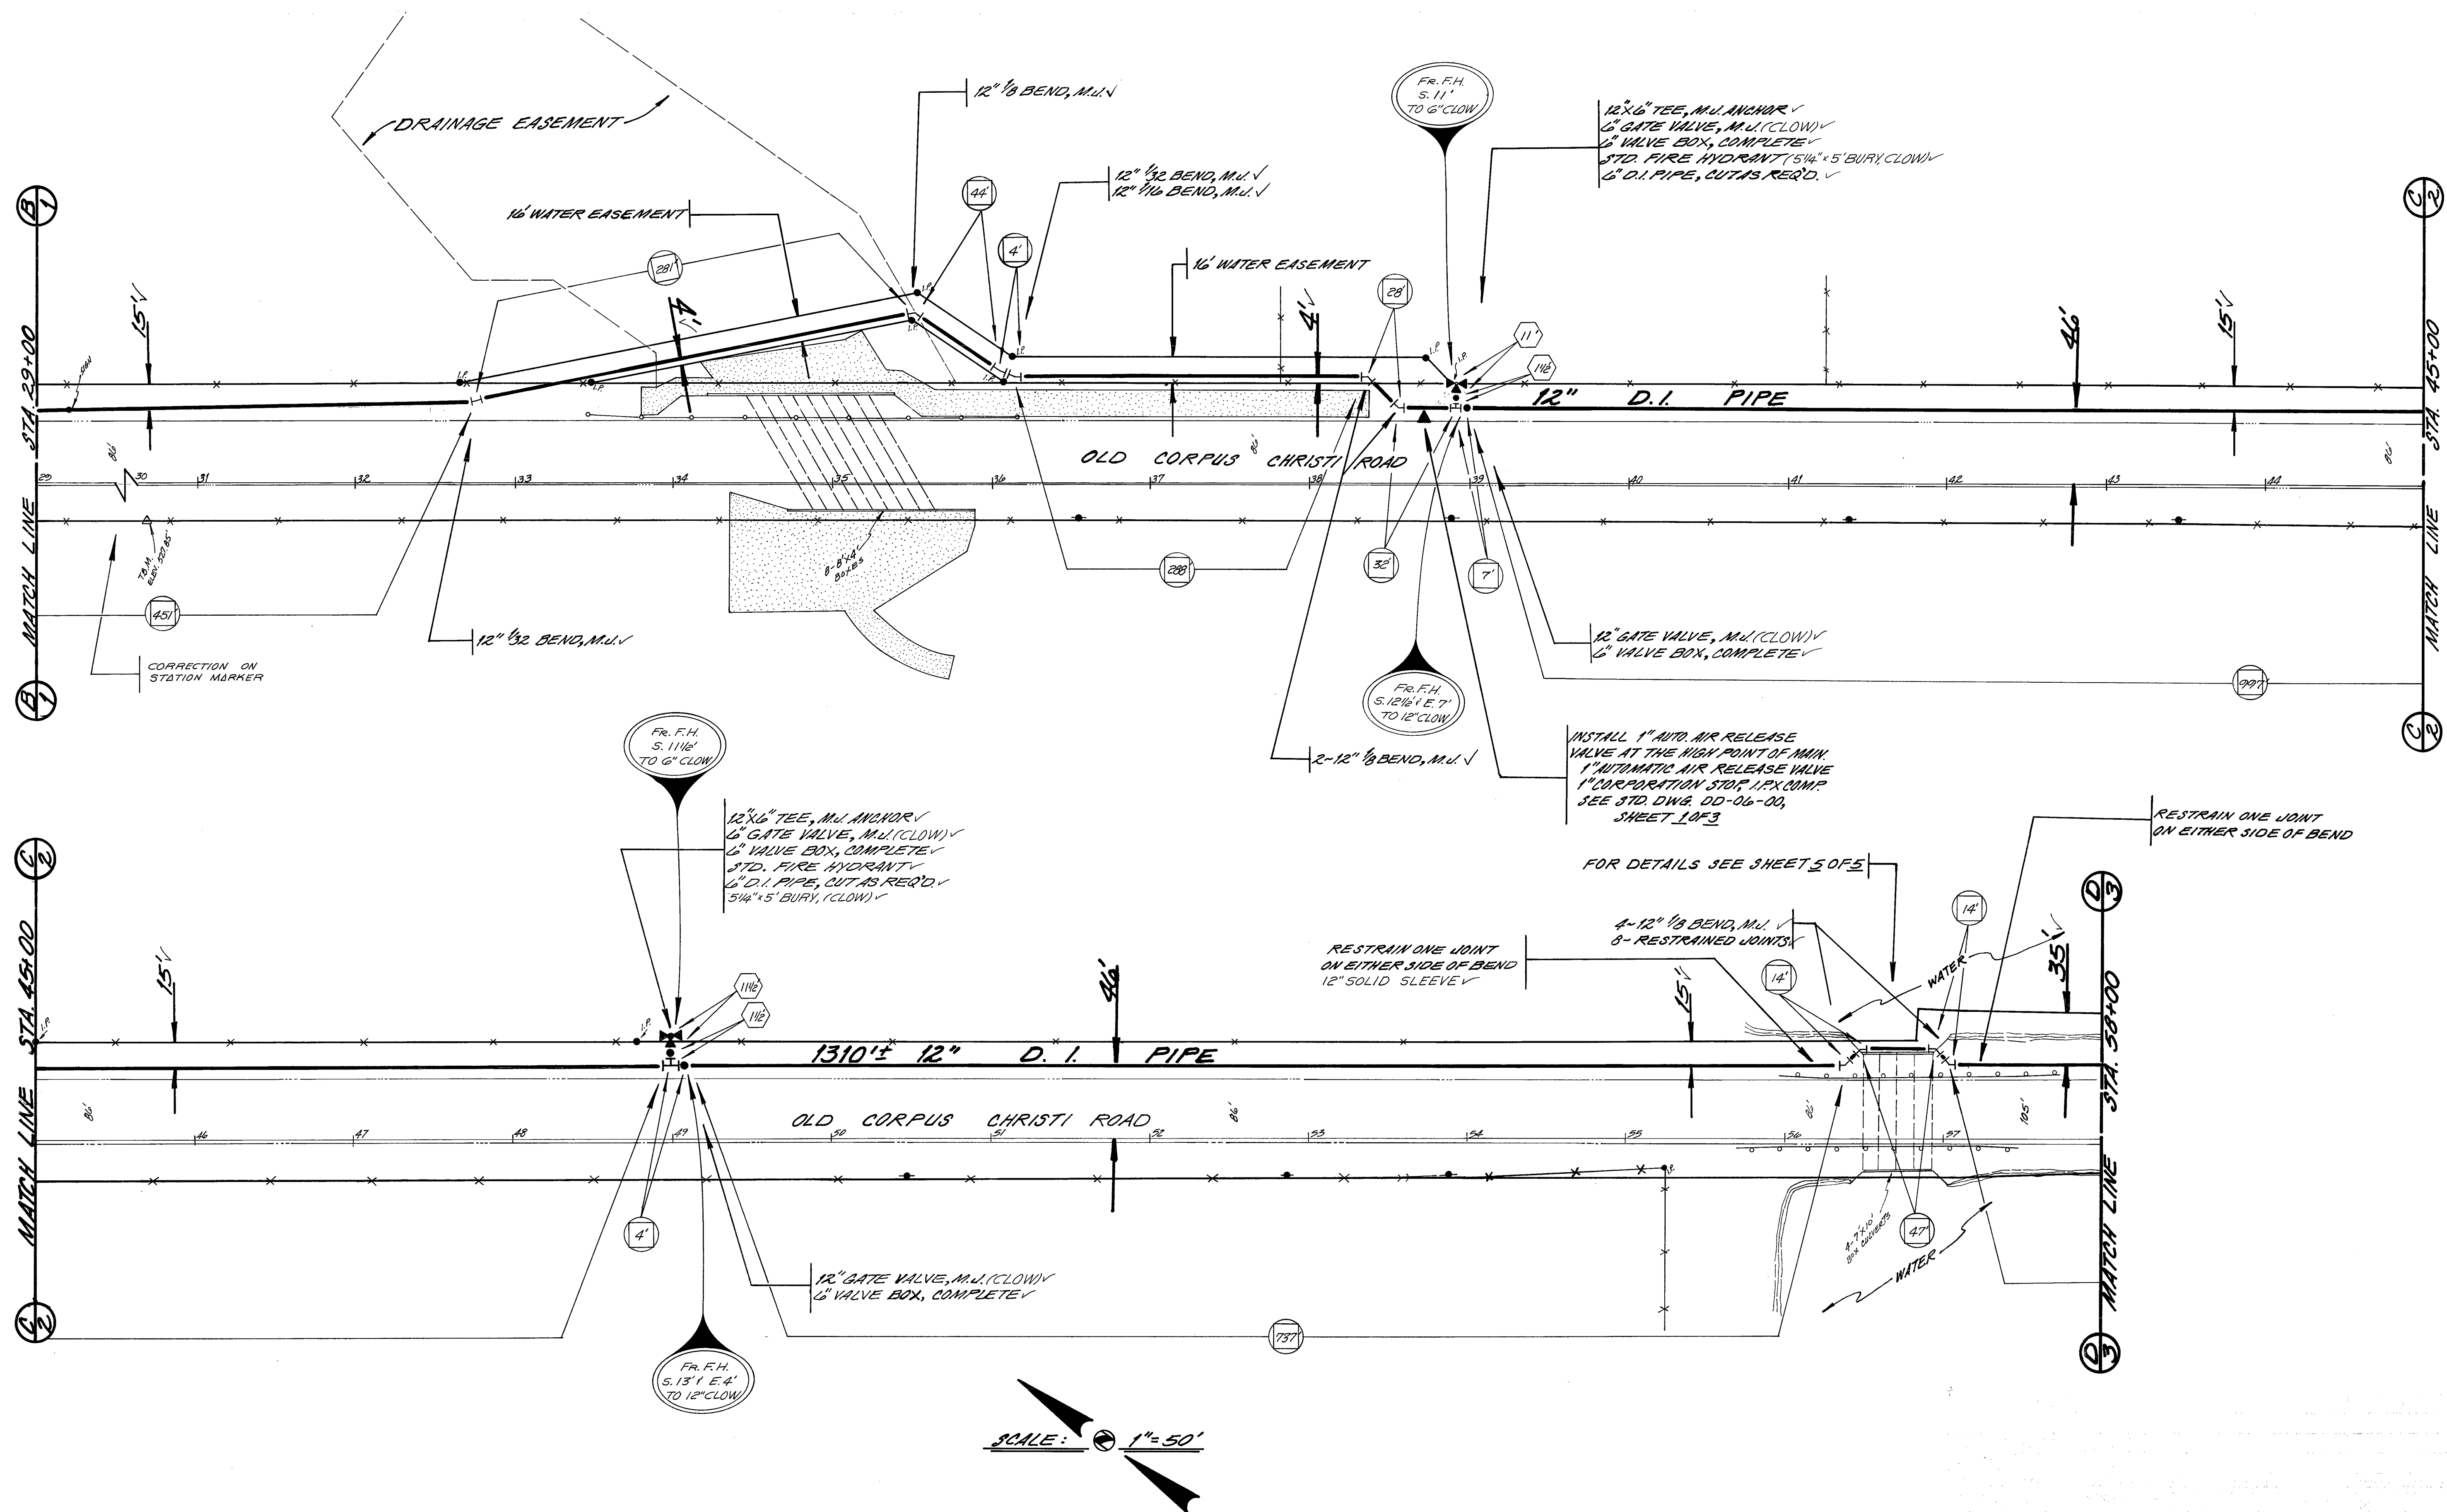

OLD CORPUS CHRISTI RD.
RICHTER RD. FROM STREICH RD.
TO RAILROAD TRACKS

SAN ANTONIO WATER SYSTEM
#54



Steven Rennie

Ronald

200-5
200-
[Signature]
JRM

92-6009 2
CONTRACT 5

25

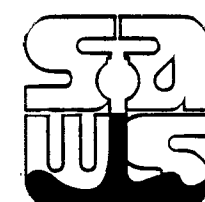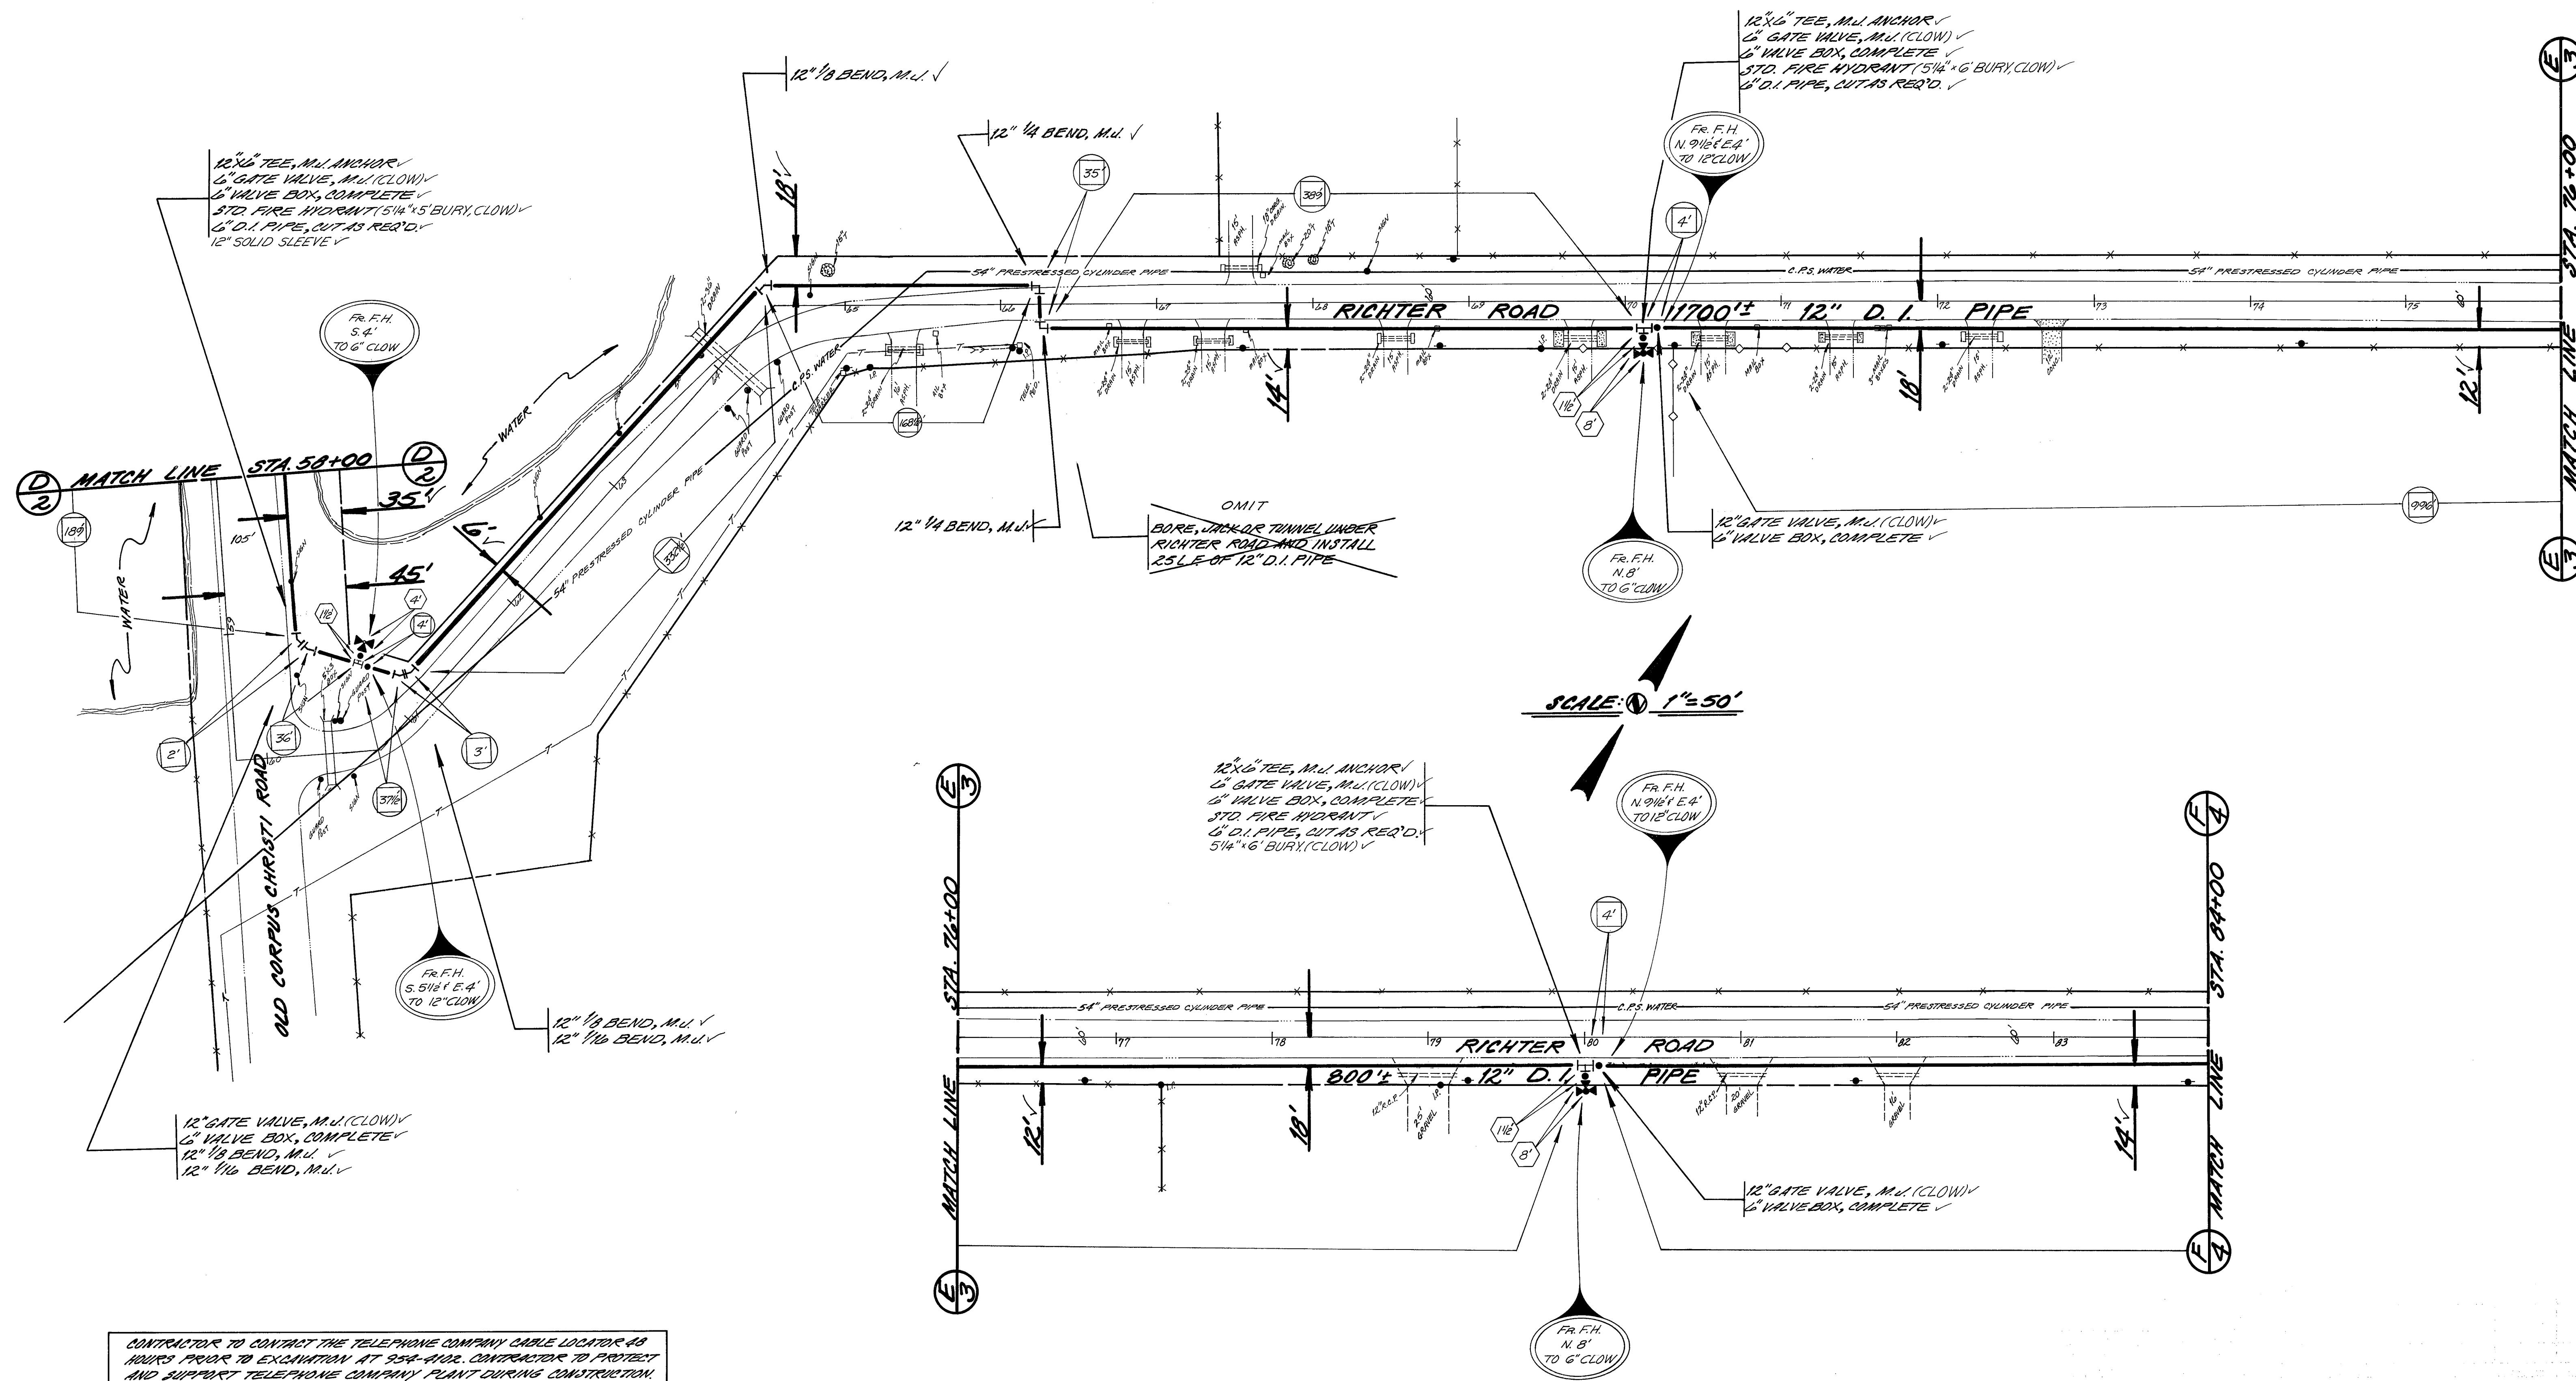


OLD CORPUS CHRISTI RD.
RICHTER RD. FROM STREICH RD.
TO RAILROAD TRACKS
SAN ANTONIO WATER SYSTEM
#54

Steven Rennett
Donald L. Pearsall

204-522
204-522

92-6009 5
CONTRACT

3

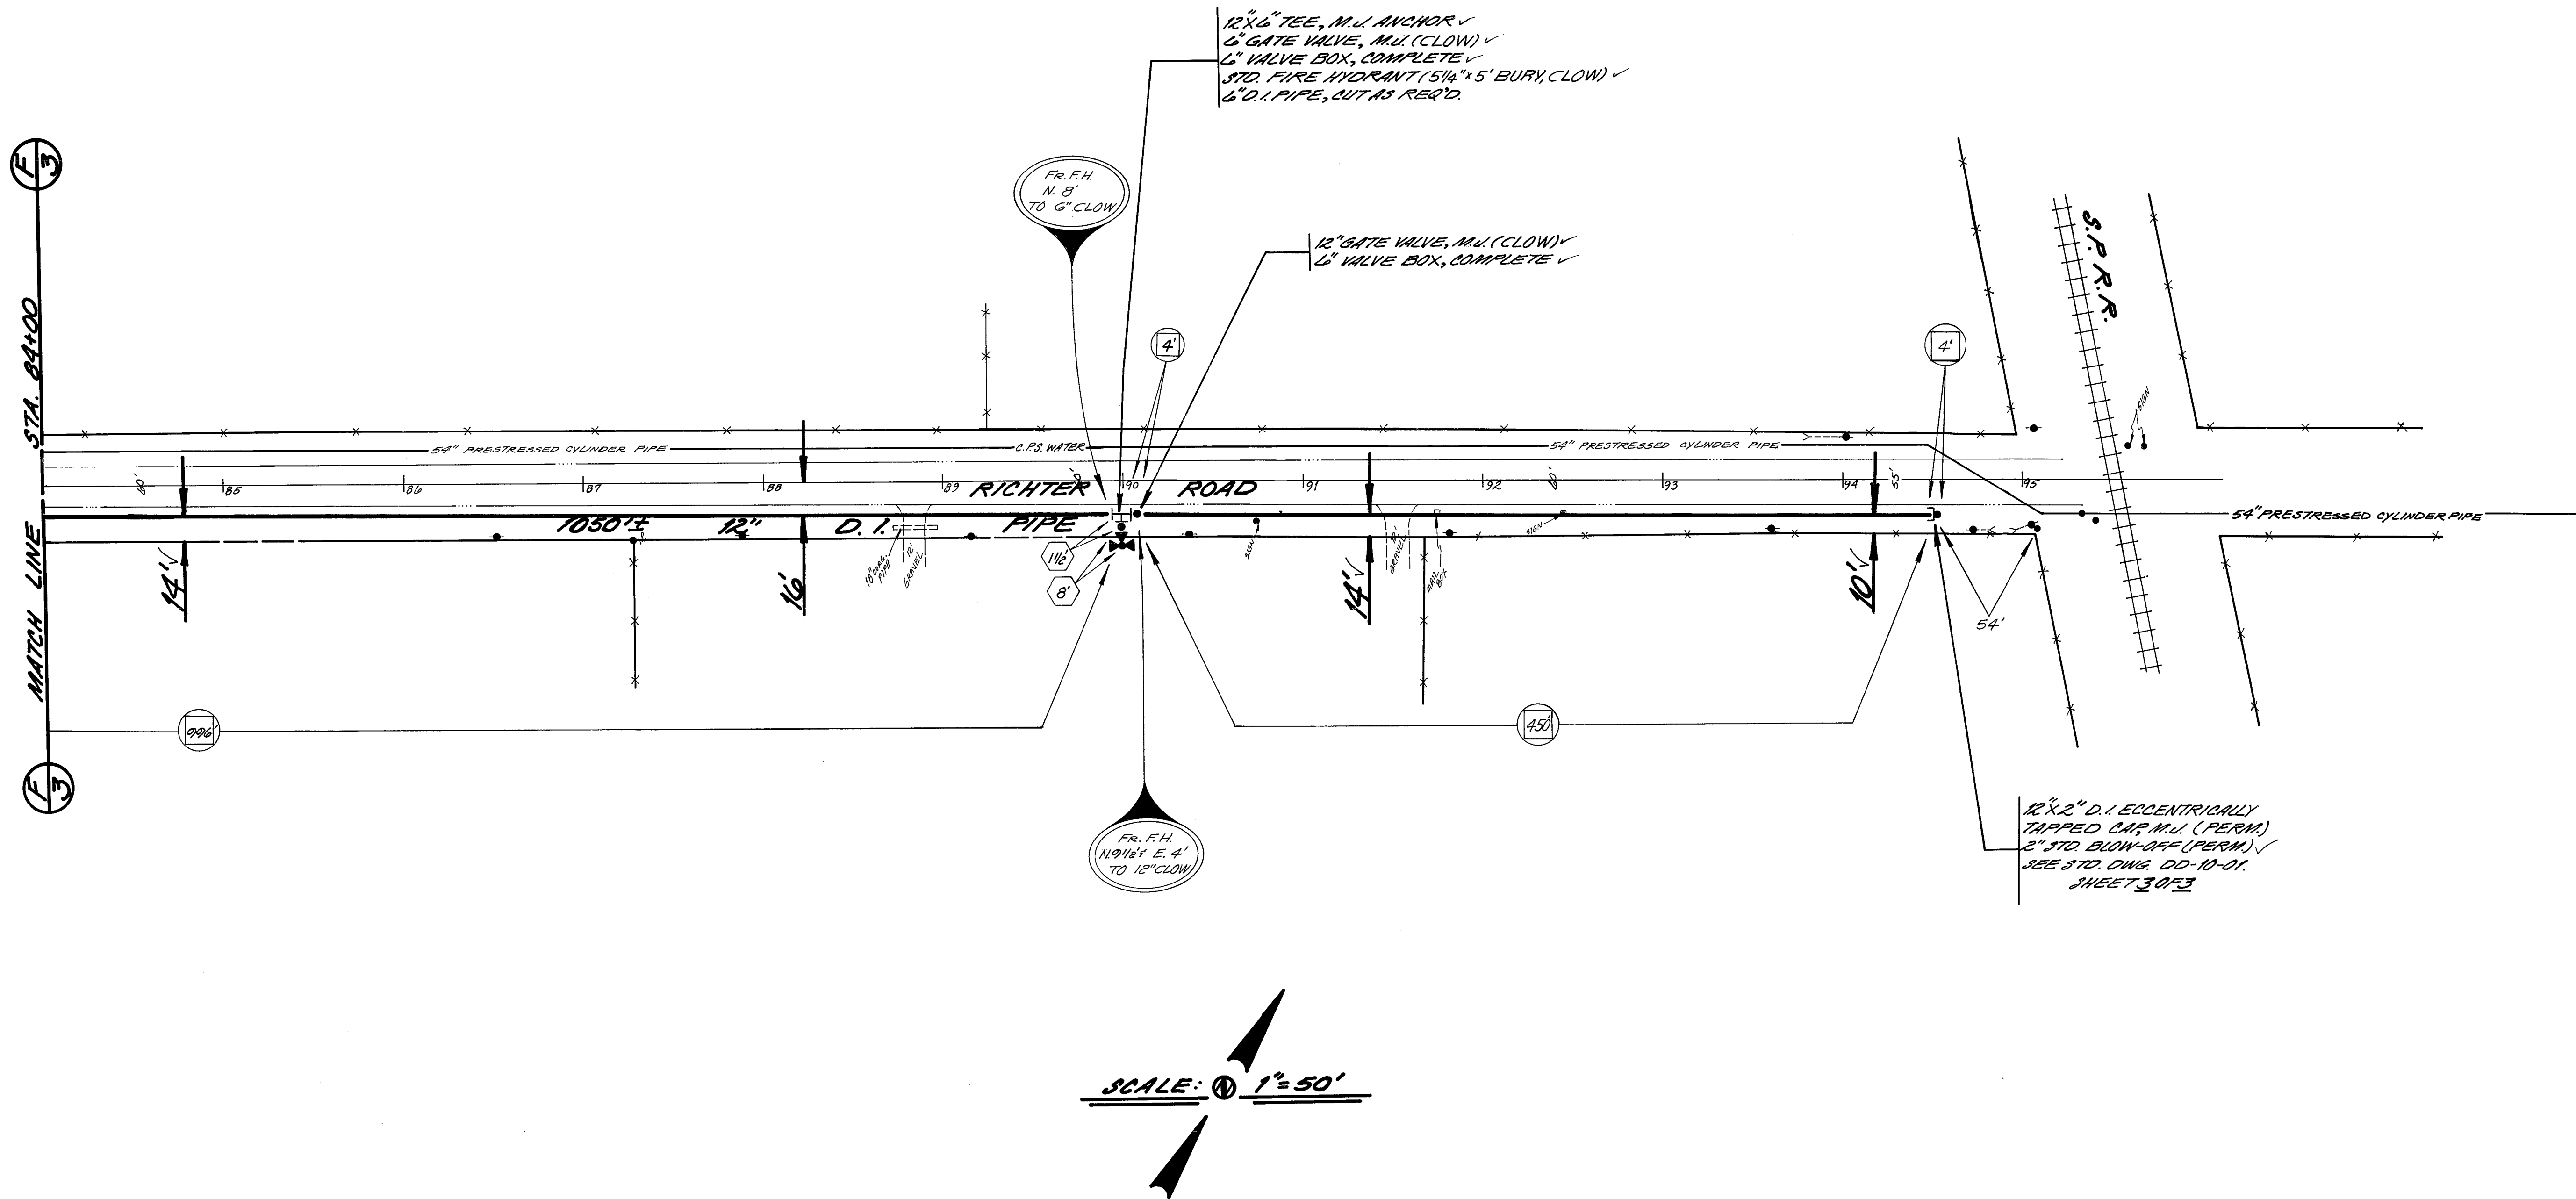

10/28/94
10-18-94

OLD CORPUS CHRISTI RD
RICHTER RD. FROM STREET
TO RAILROAD TRACKS
SAN ANTONIO WATER SYSTEM
#54
Steven Remick
Donald L. Reed
206-522
92-6009
CONTRACT

