# TMM SOMERSET, UNIT 3A

SAN ANTONIO, TX

STREET, DRAINAGE, WATER, SANITARY SEWER, AND UTILITY IMPROVEMENTS




SHEET TITLE	SHEET NUMBER
COVER SHEET	0.0
OVERALL UTILITY PLAN (SHT 1 OF 2)	1.0
OVERALL UTILITY PLAN (SHT 2 OF 2)	
MASTER DRAINAGE PLAN	2.0
OVERALL GRADING PLAN	3.0
DRAIN "A" PLAN & PROFILE	4.0
MUTTON CROSSING PLAN & PROFILE	5.0
COCOON CROSSING & PLATOON POINT PLAN & PROFILE	
TYPICAL STREET DETAILS	5.2
WHEELCHAIR RAMP DETAILS	
CONCRETE DRIVEWAY DETAILS	
TRAFFIC SIGNAGE & PEDESTRIAN ACCESSIBILITY PLAN	
TRAFFIC SIGN MOUNTING DETAILS	
SANITARY SEWER COVER SHEET	6.0
OVERALL SANITARY SEWER PLAN (SHT 1 OF 2)	6.1
OVERALL SANITARY SEWER PLAN (SHT 2 OF 2)	6.2
LINE "A" PLAN & PROFILE	6.3
LINE "A" AND "B" PLAN & PROFILE	6.4
LINE "C" PLAN & PROFILE	6.5
WATER DISTRIBUTION COVER SHEET	7.0
WATER DISTRIBUTION PLAN	
STORM WATER POLLUTION PREVENTION PLAN (SHT 1 OF 2)	8.0
STORM WATER POLLUTION PREVENTION PLAN (SHT 2 OF 2)	
STORM WATER POLLUTION PREVENTION PLAN DETAILS	8.2

Sheet List Table


LOCATION MAP NOT-TO-SCALE


OWNER INFORMATION:
KB HOMES
4800 FREDERICKSBURG RD.
SAN ANTONIO, TX 78229
PHONE: (210) 301 - 5485

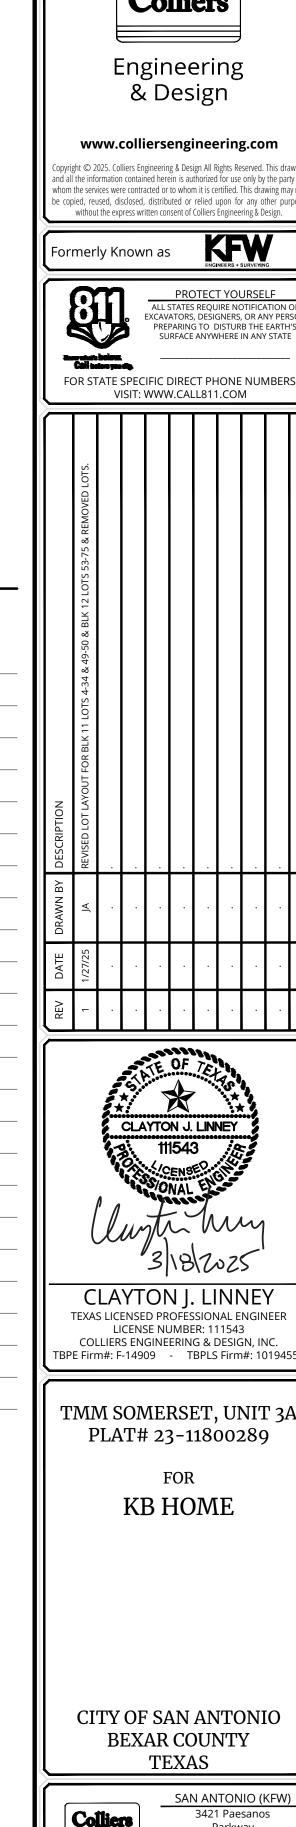



**COVER SHEET** 


San Antonio, TX 78231 Phone: 210.979.8444

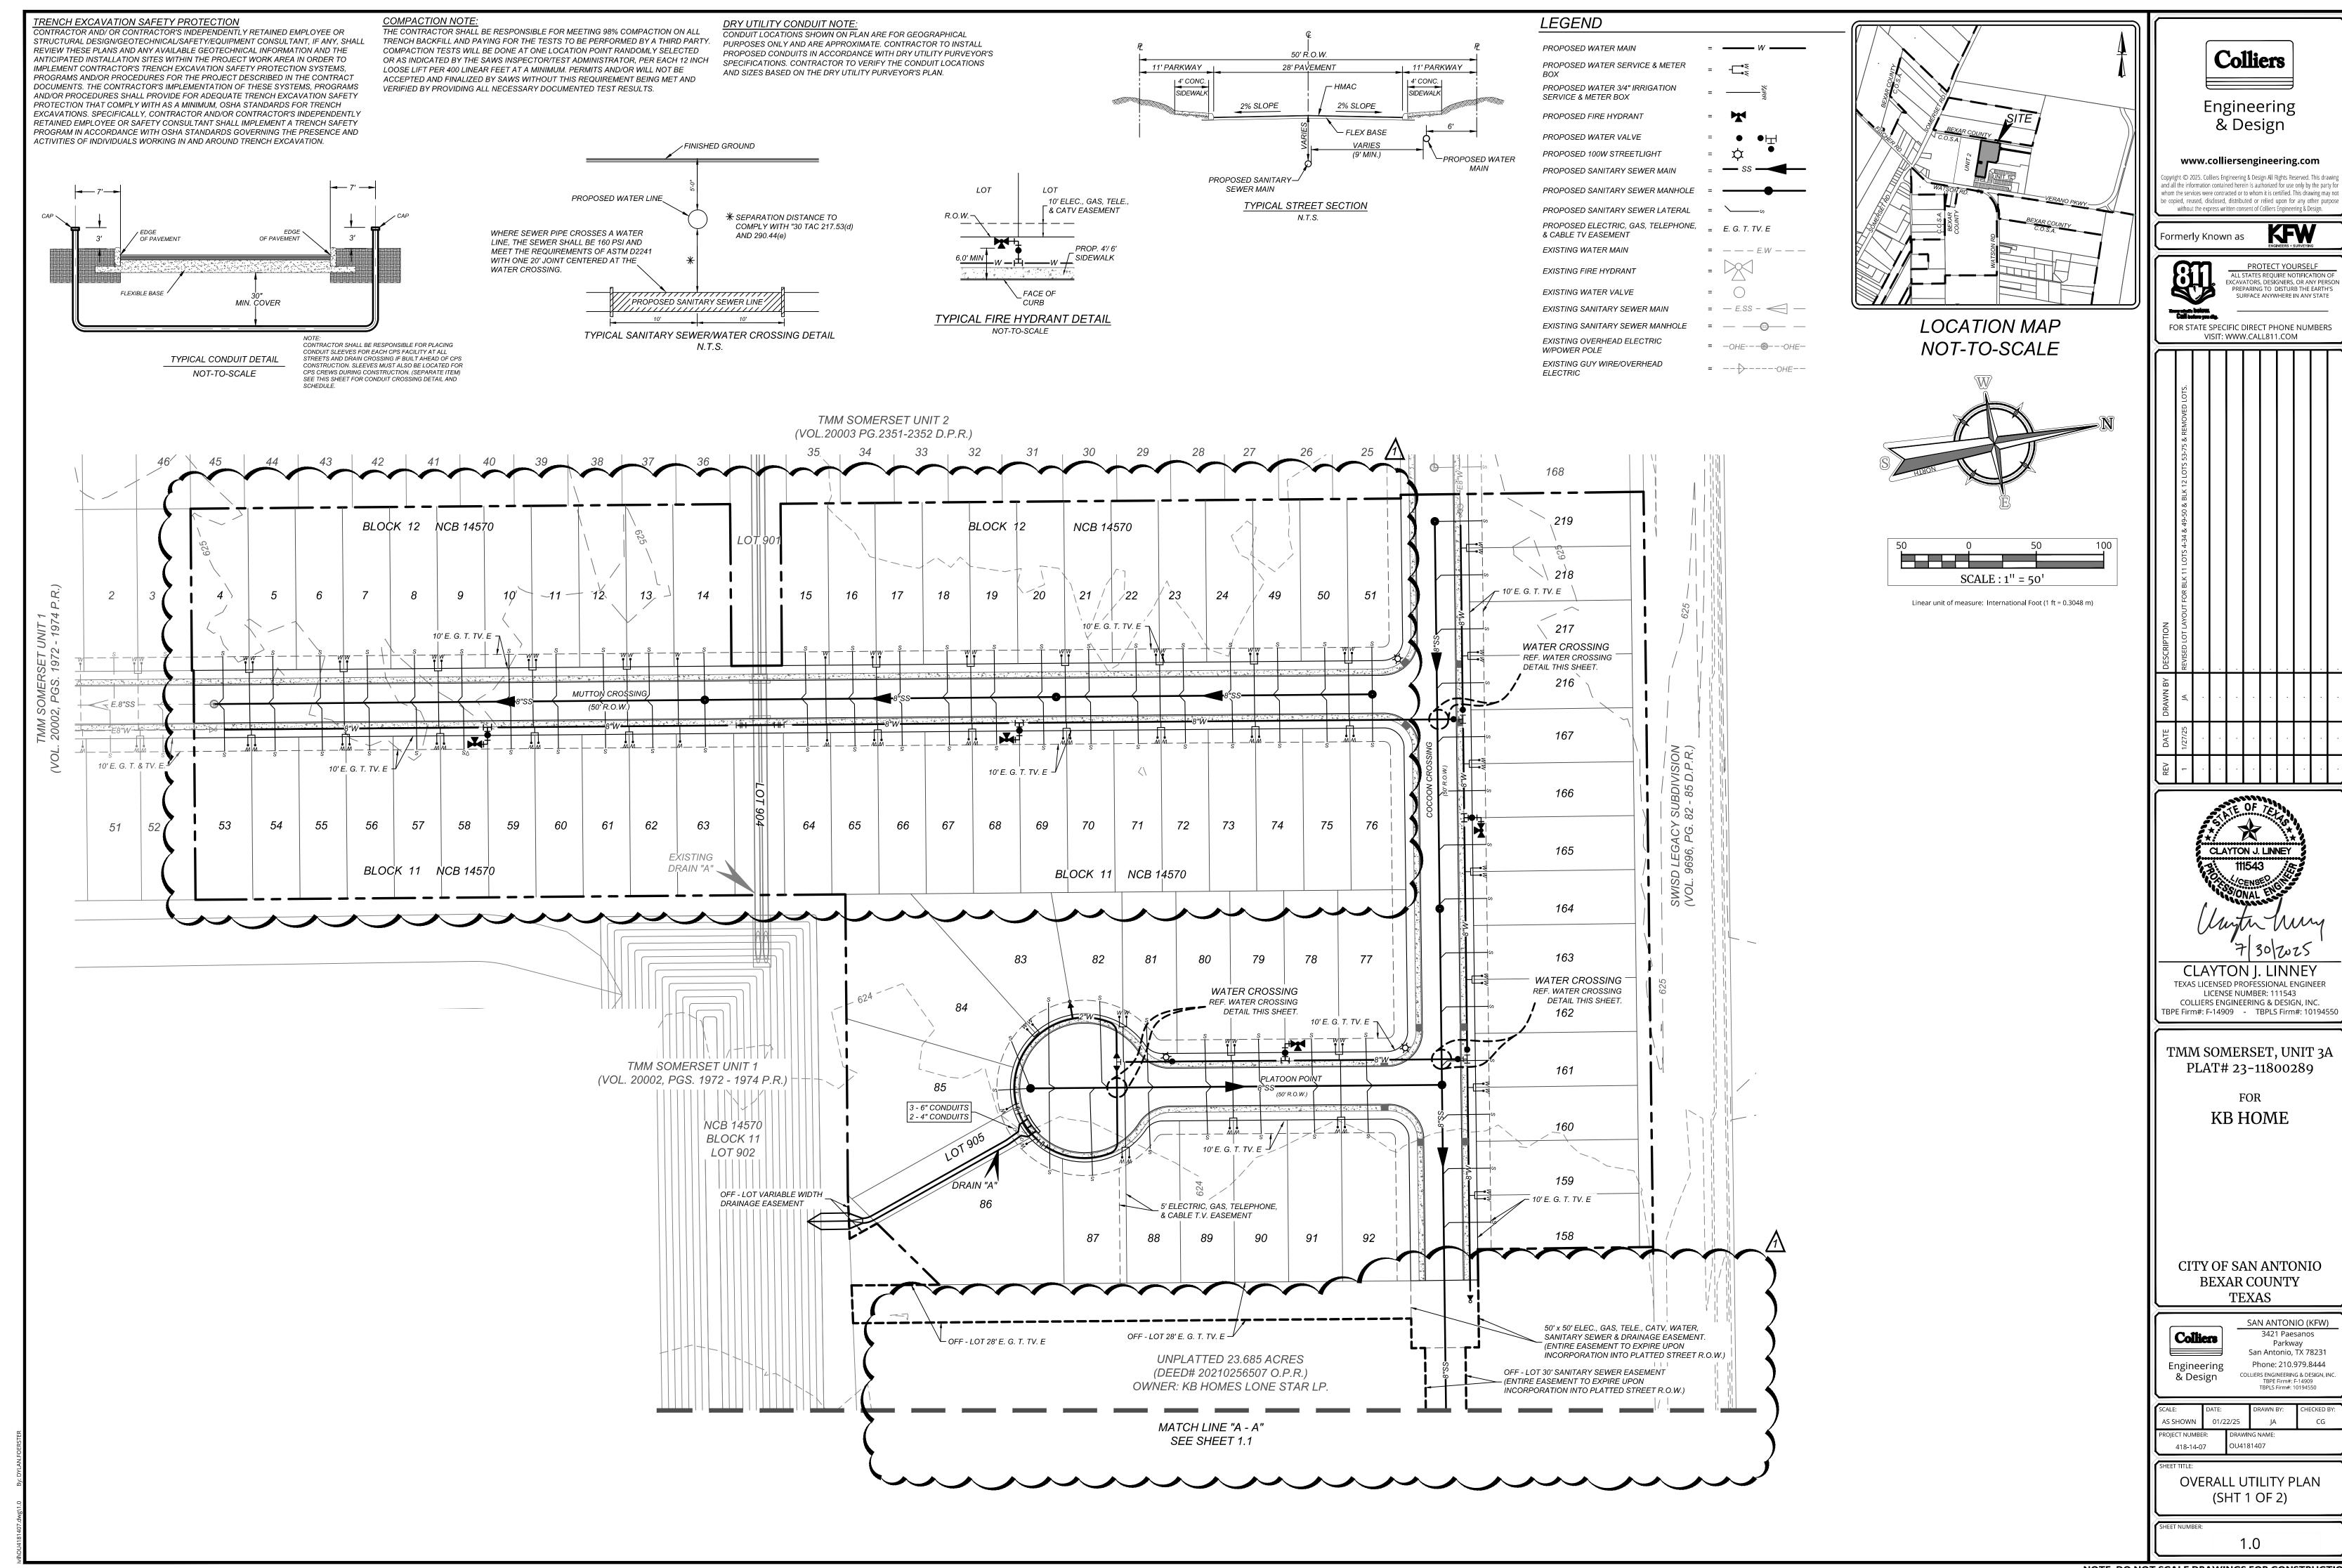


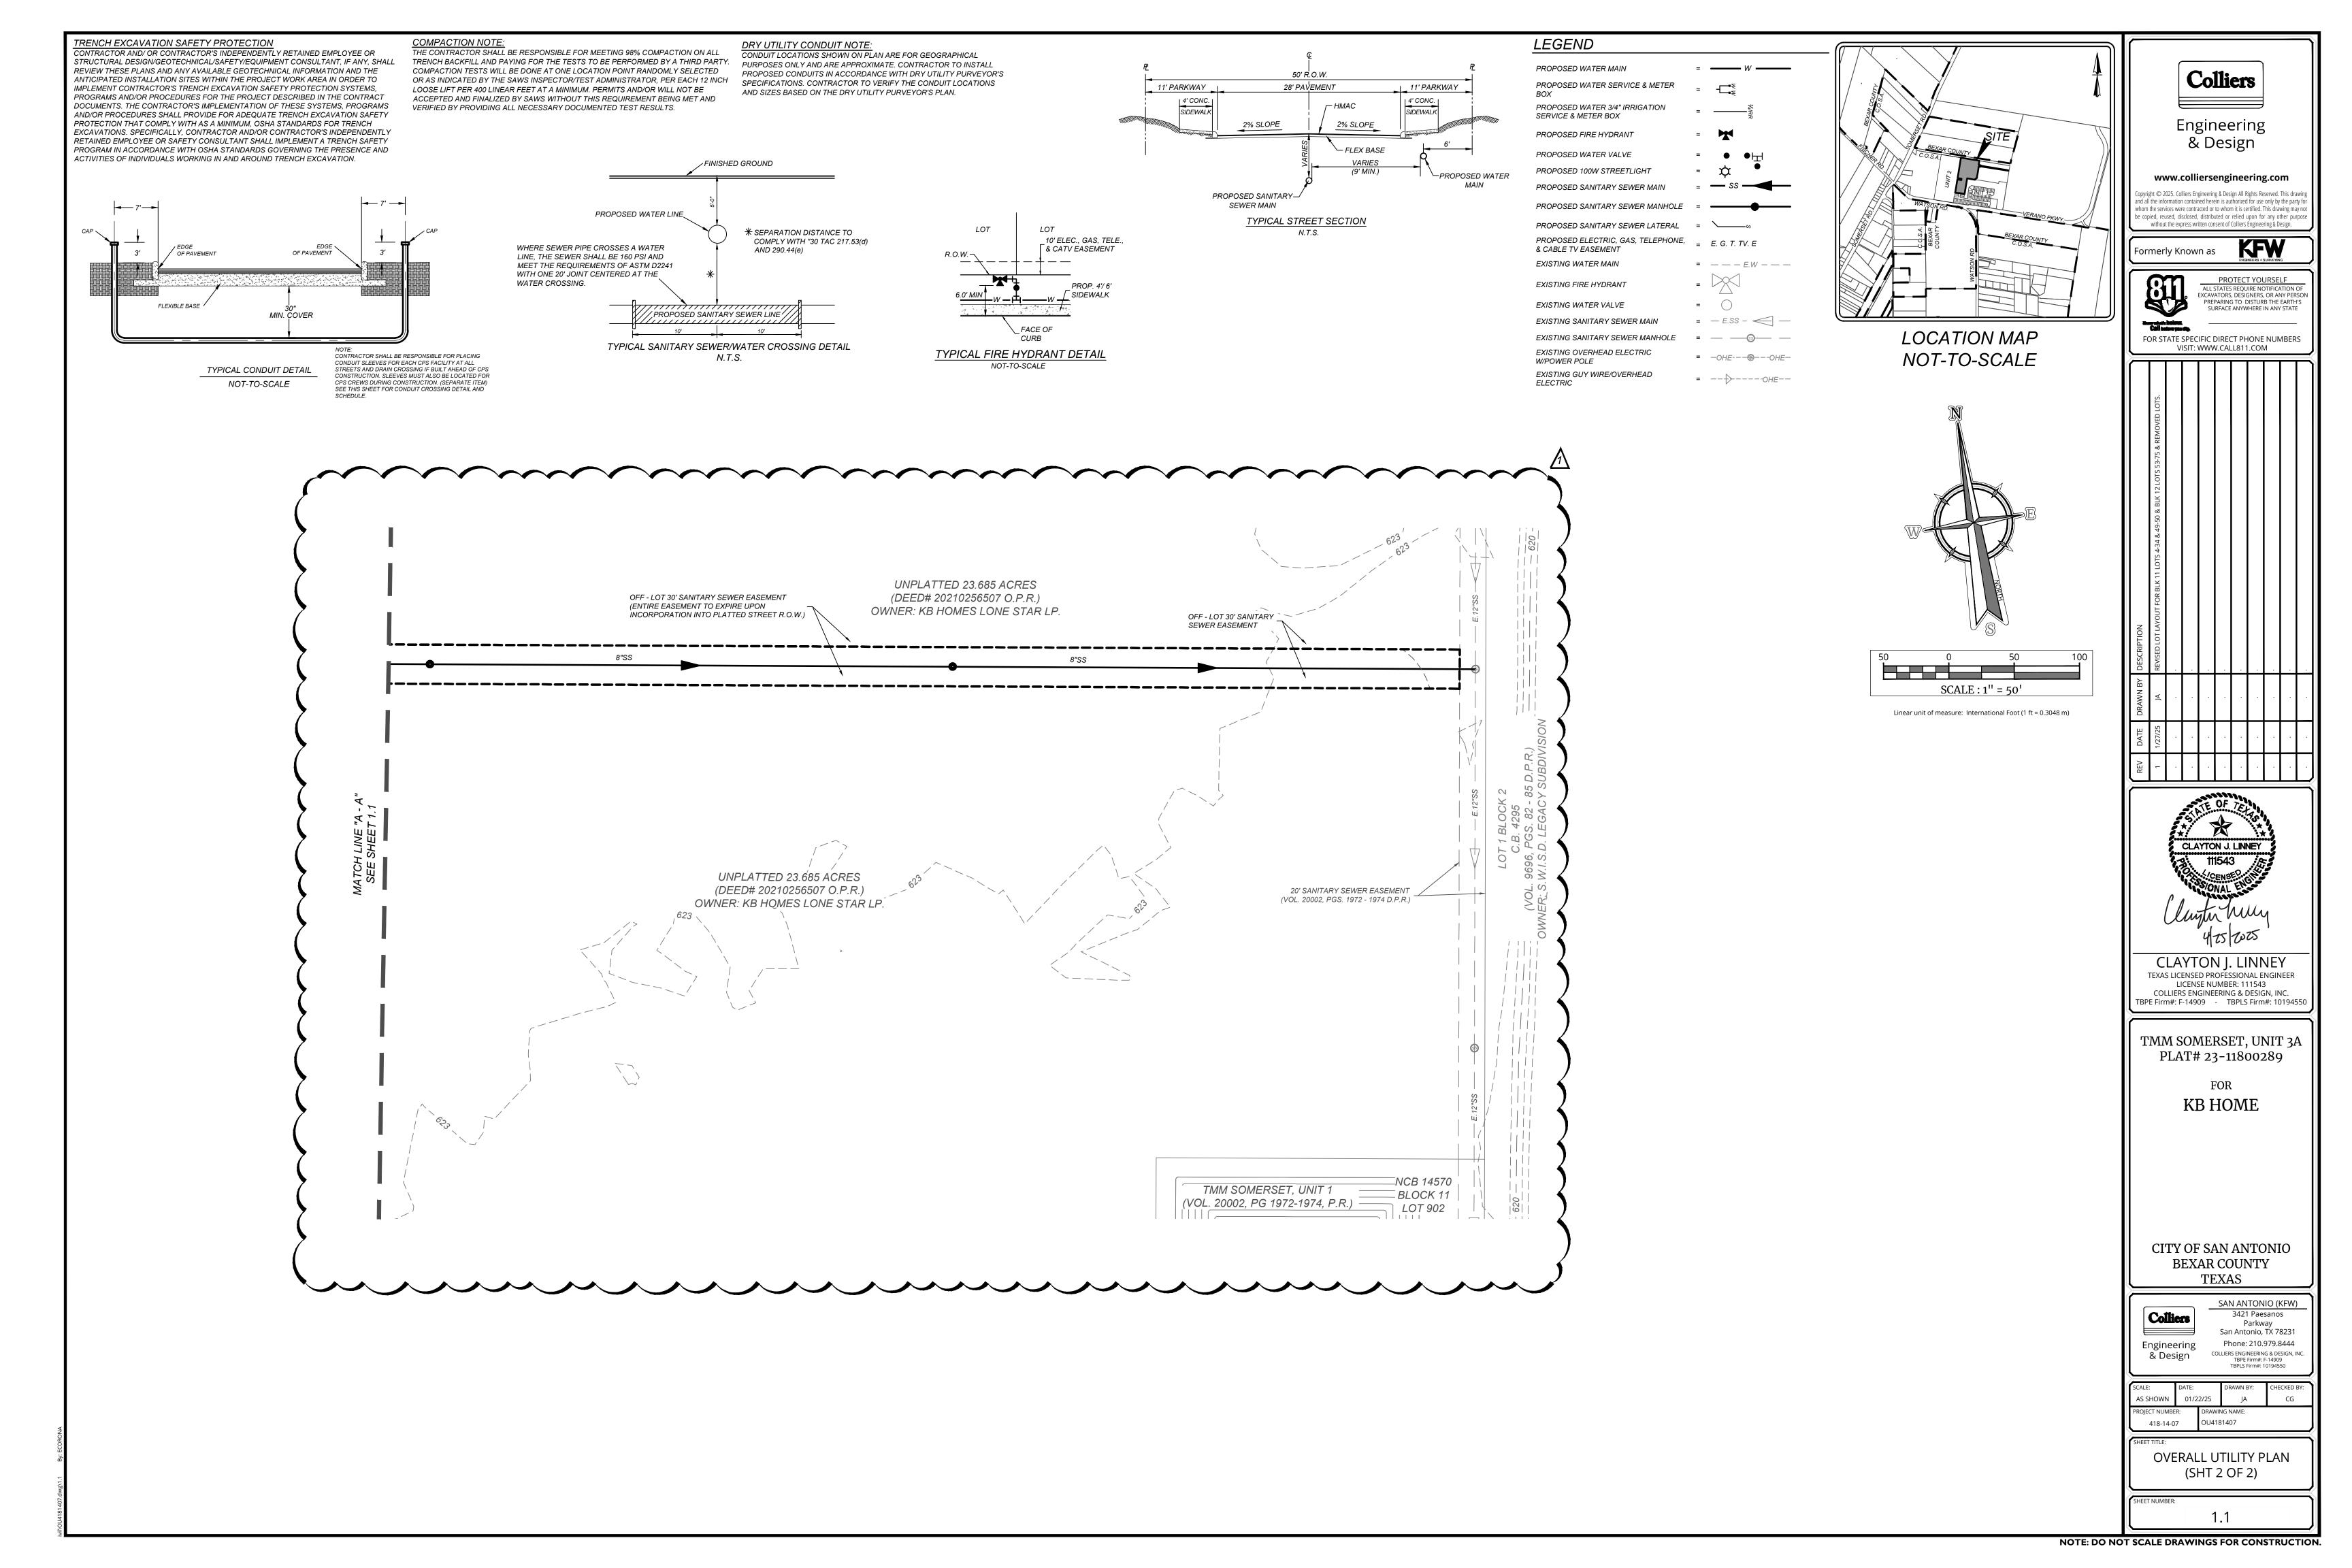


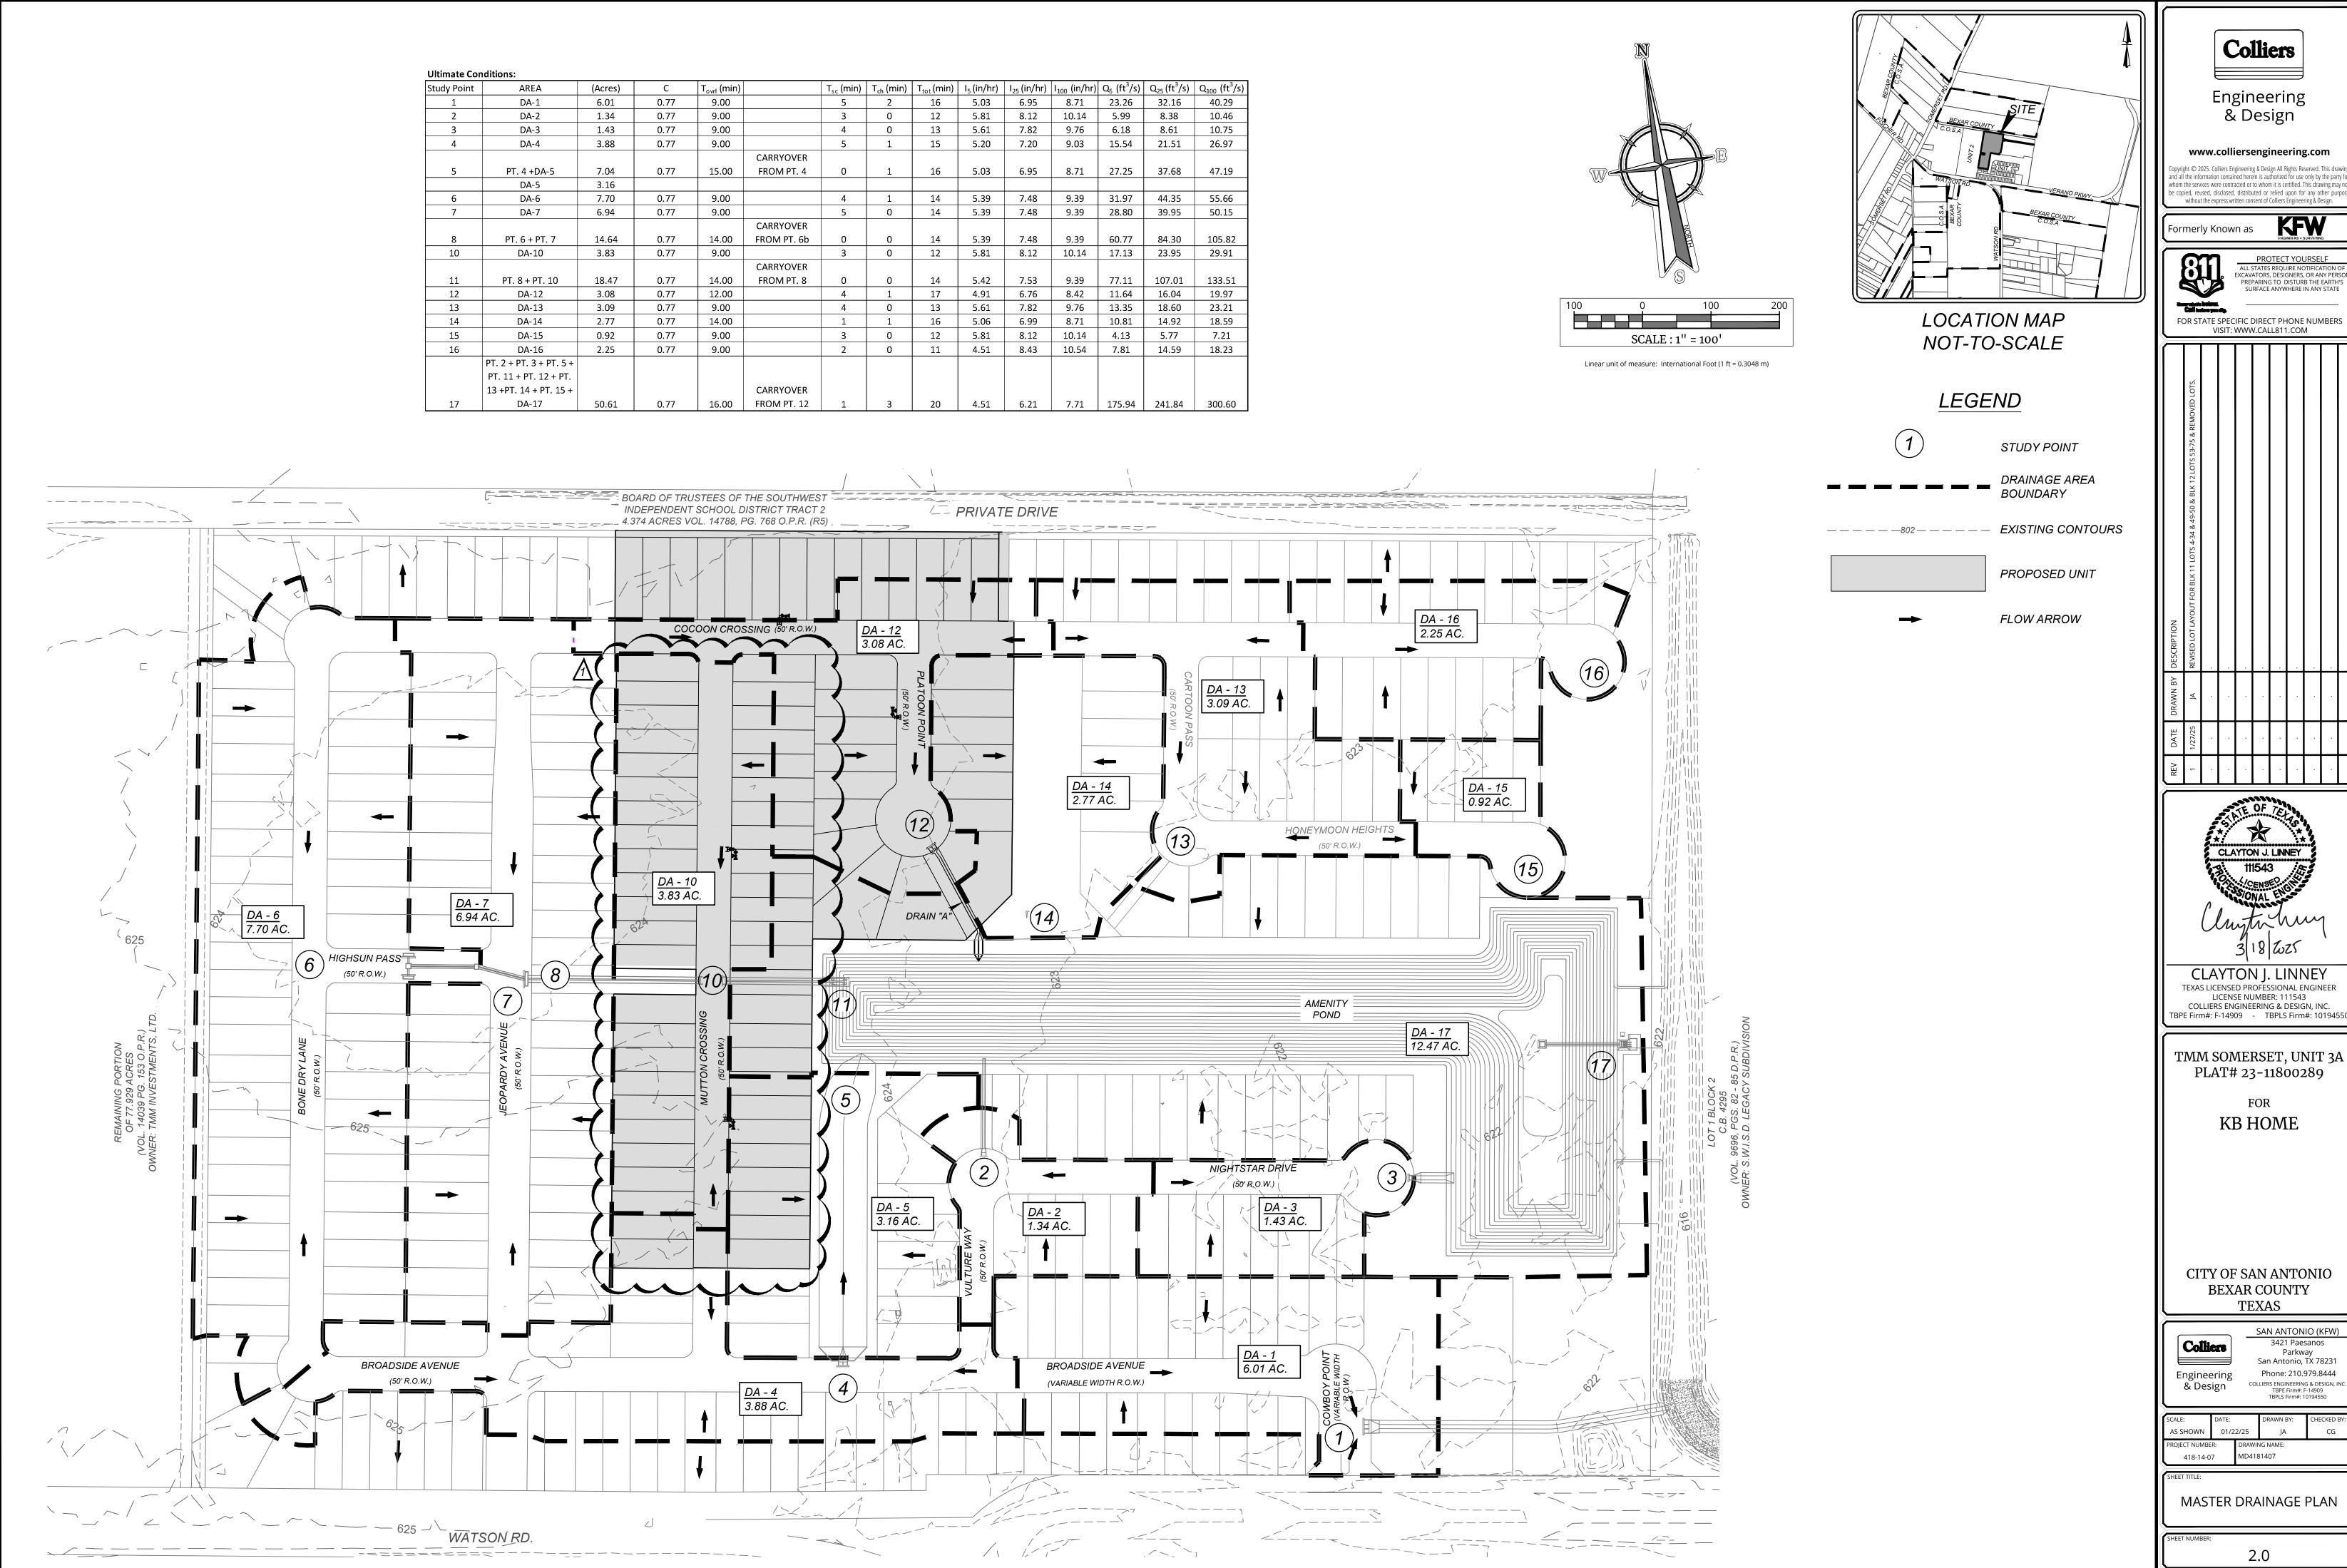


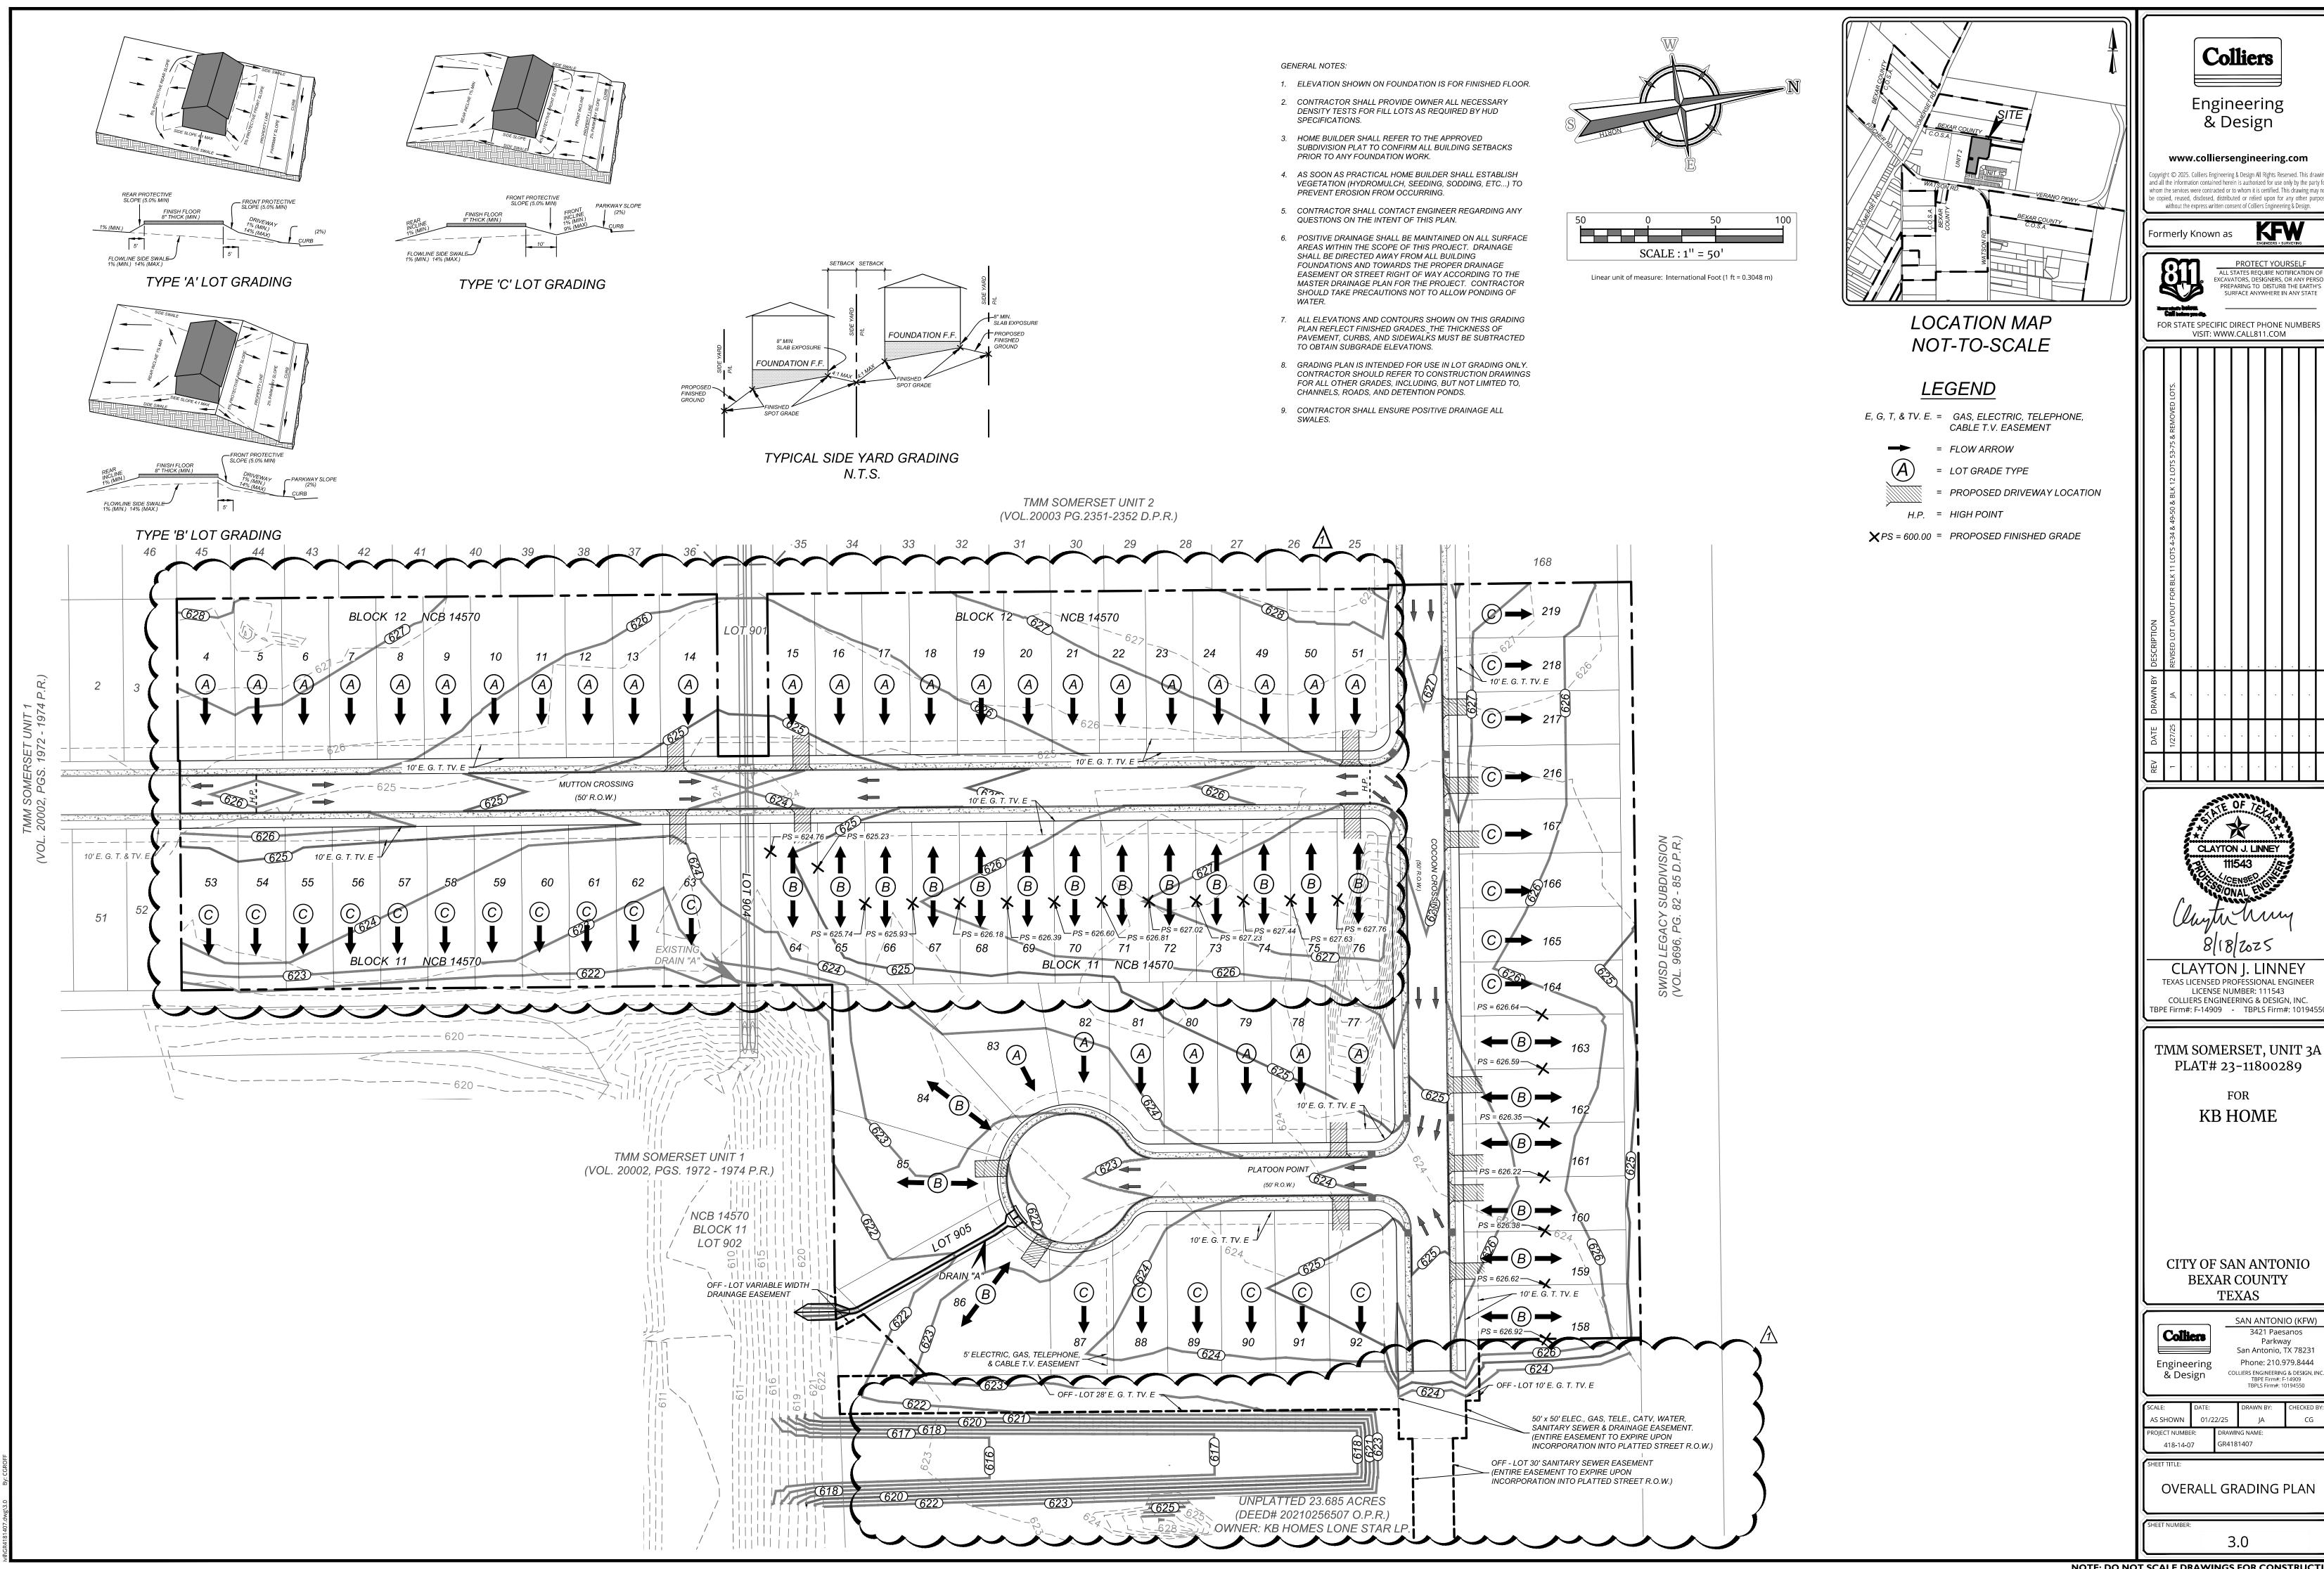

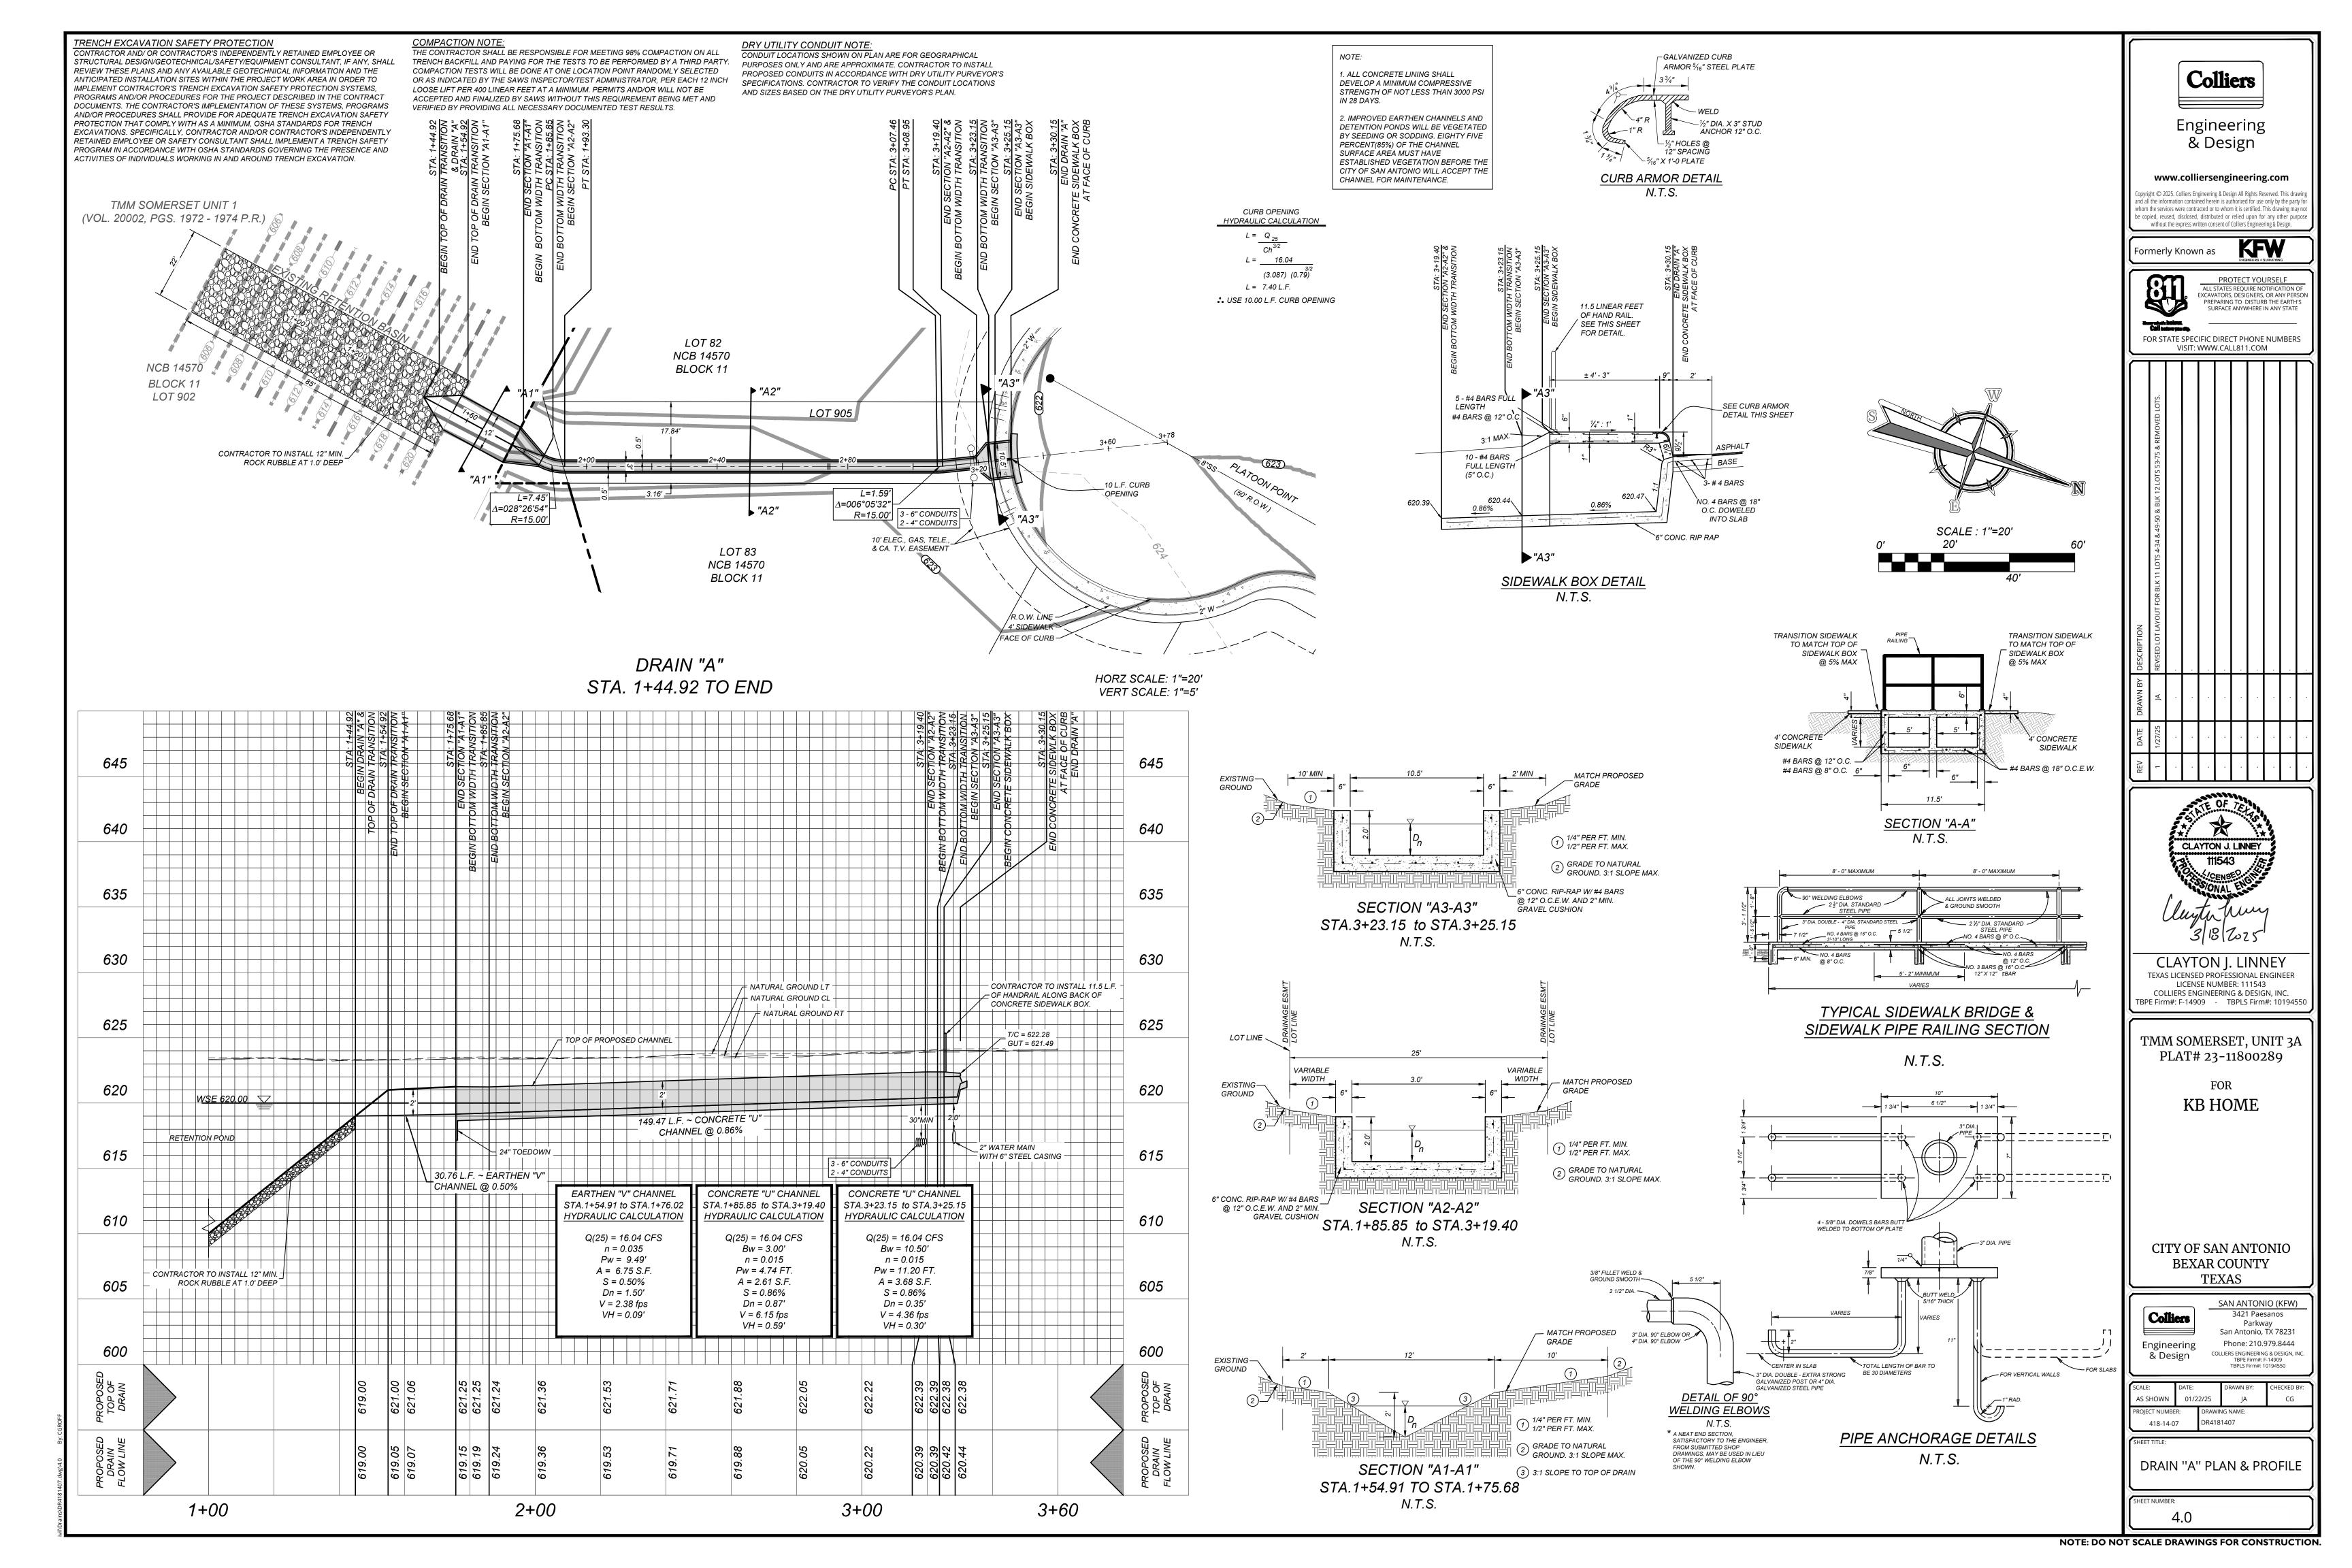

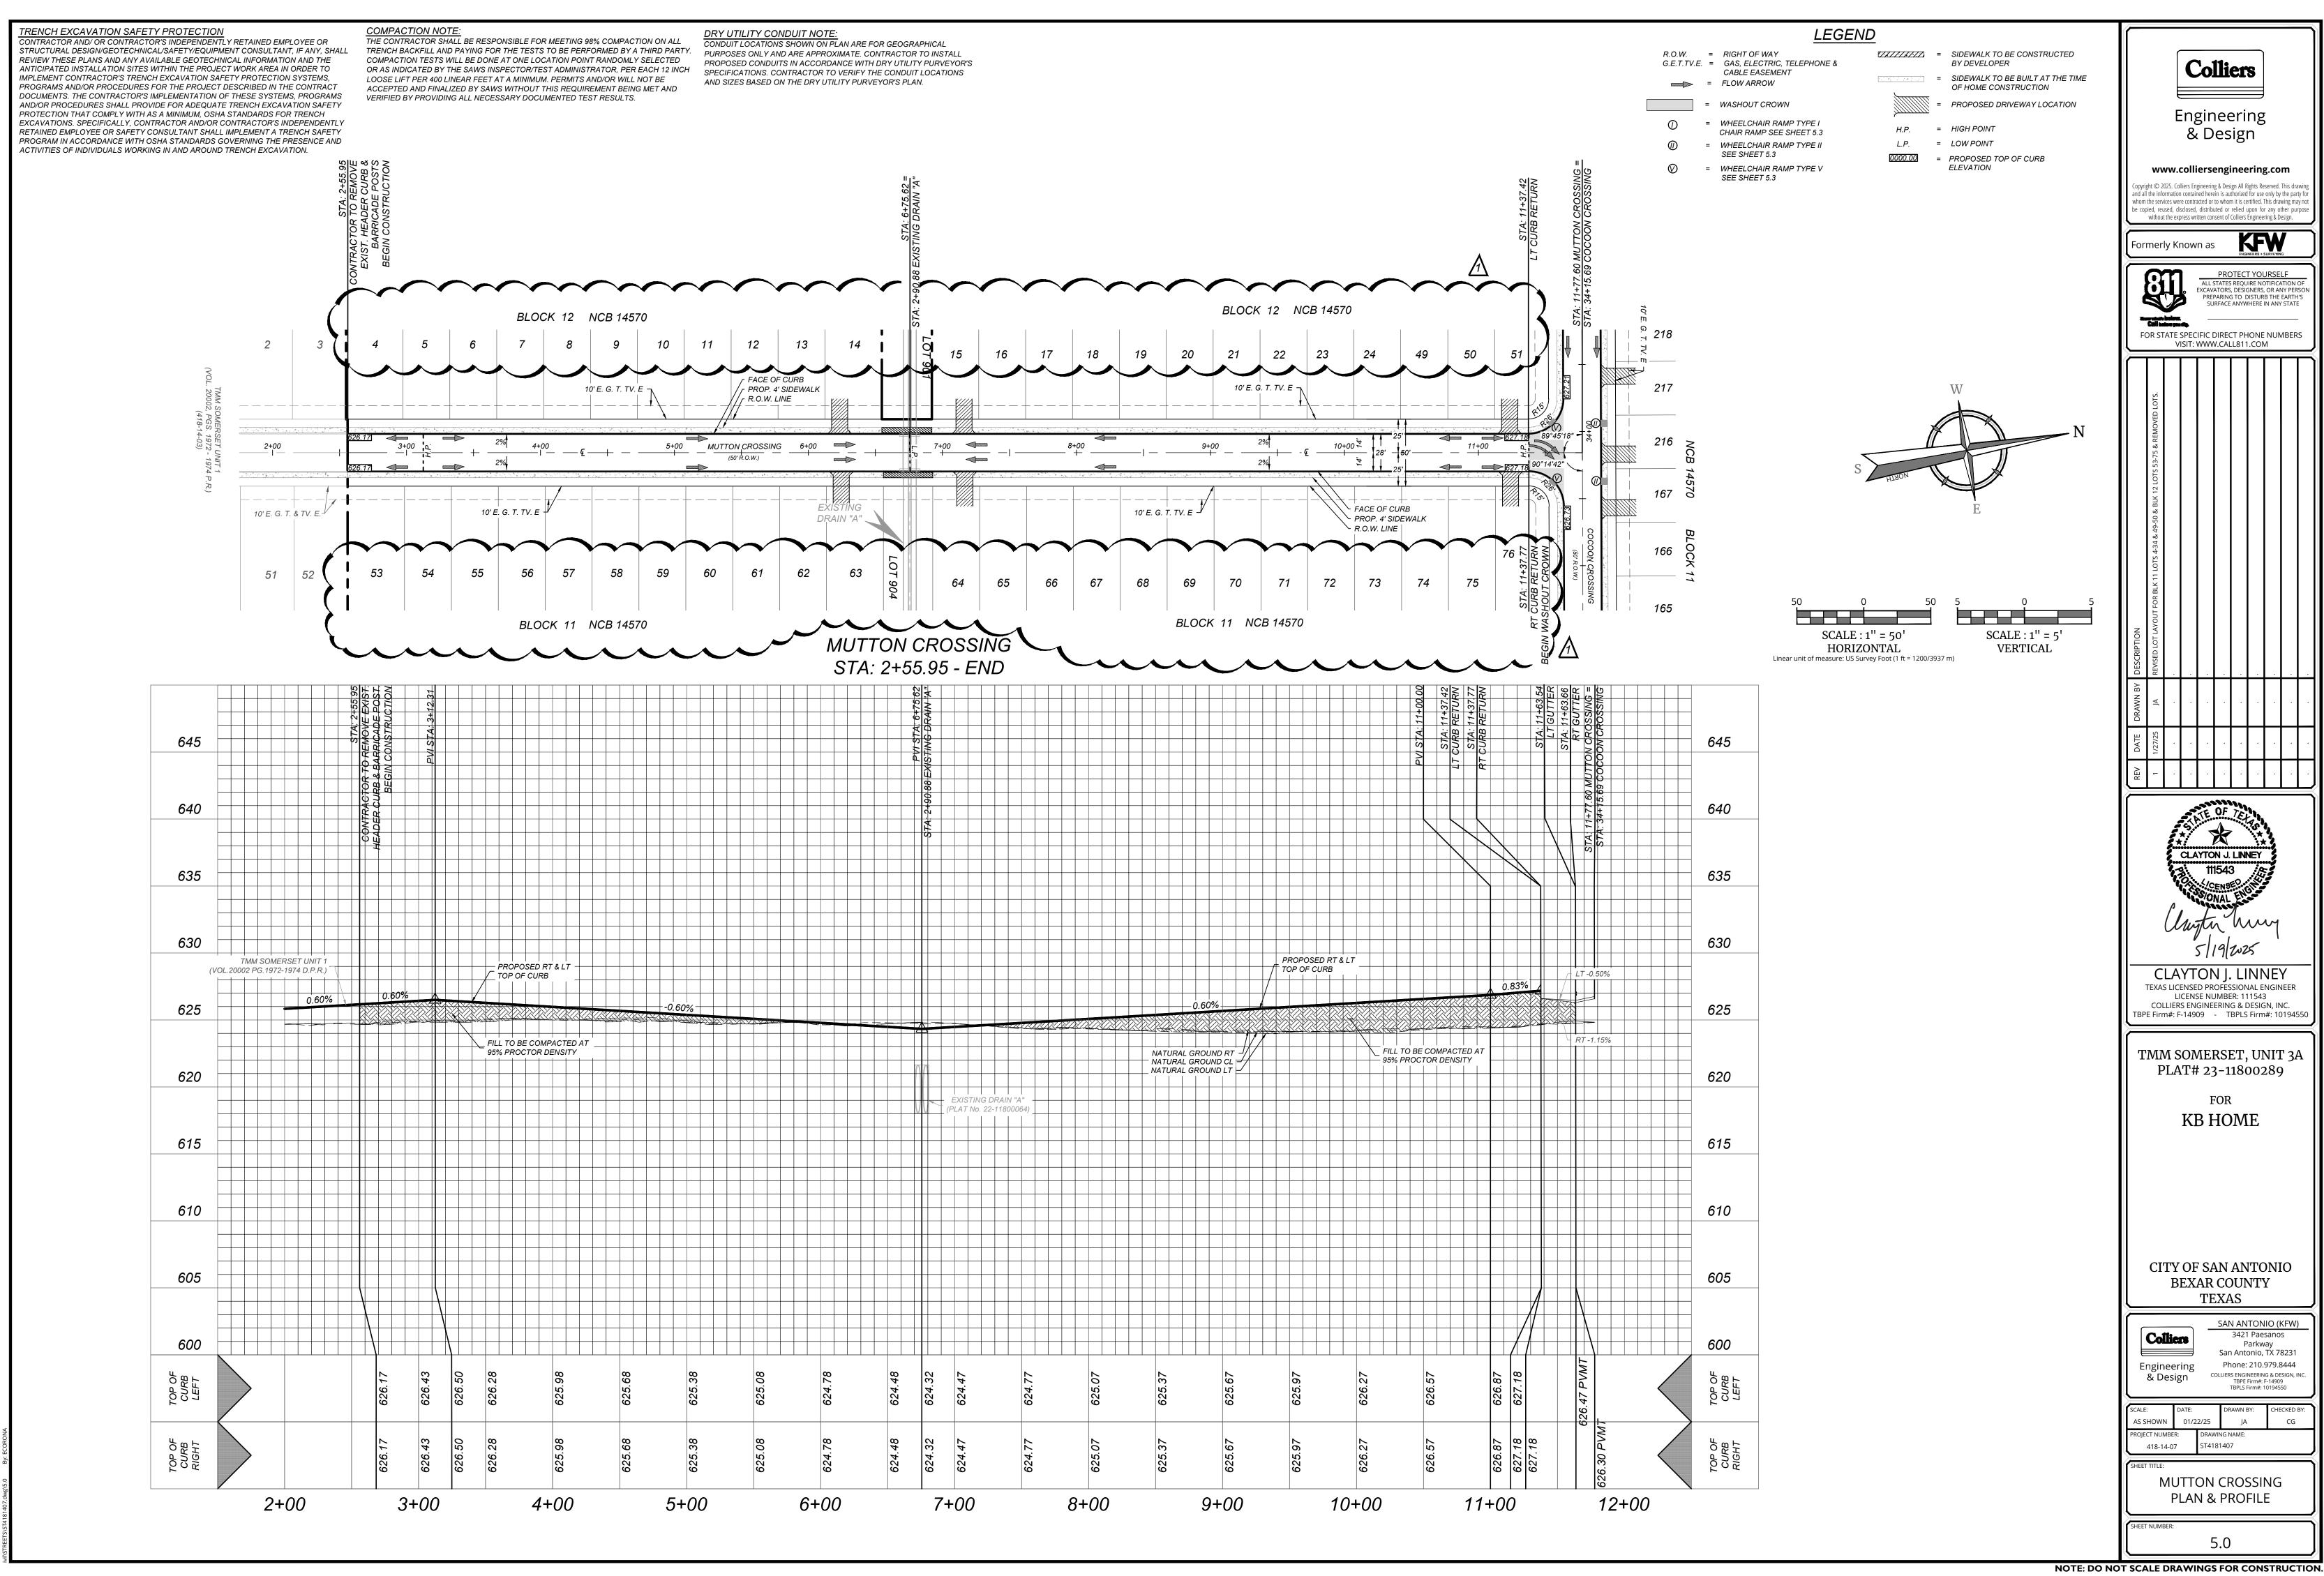

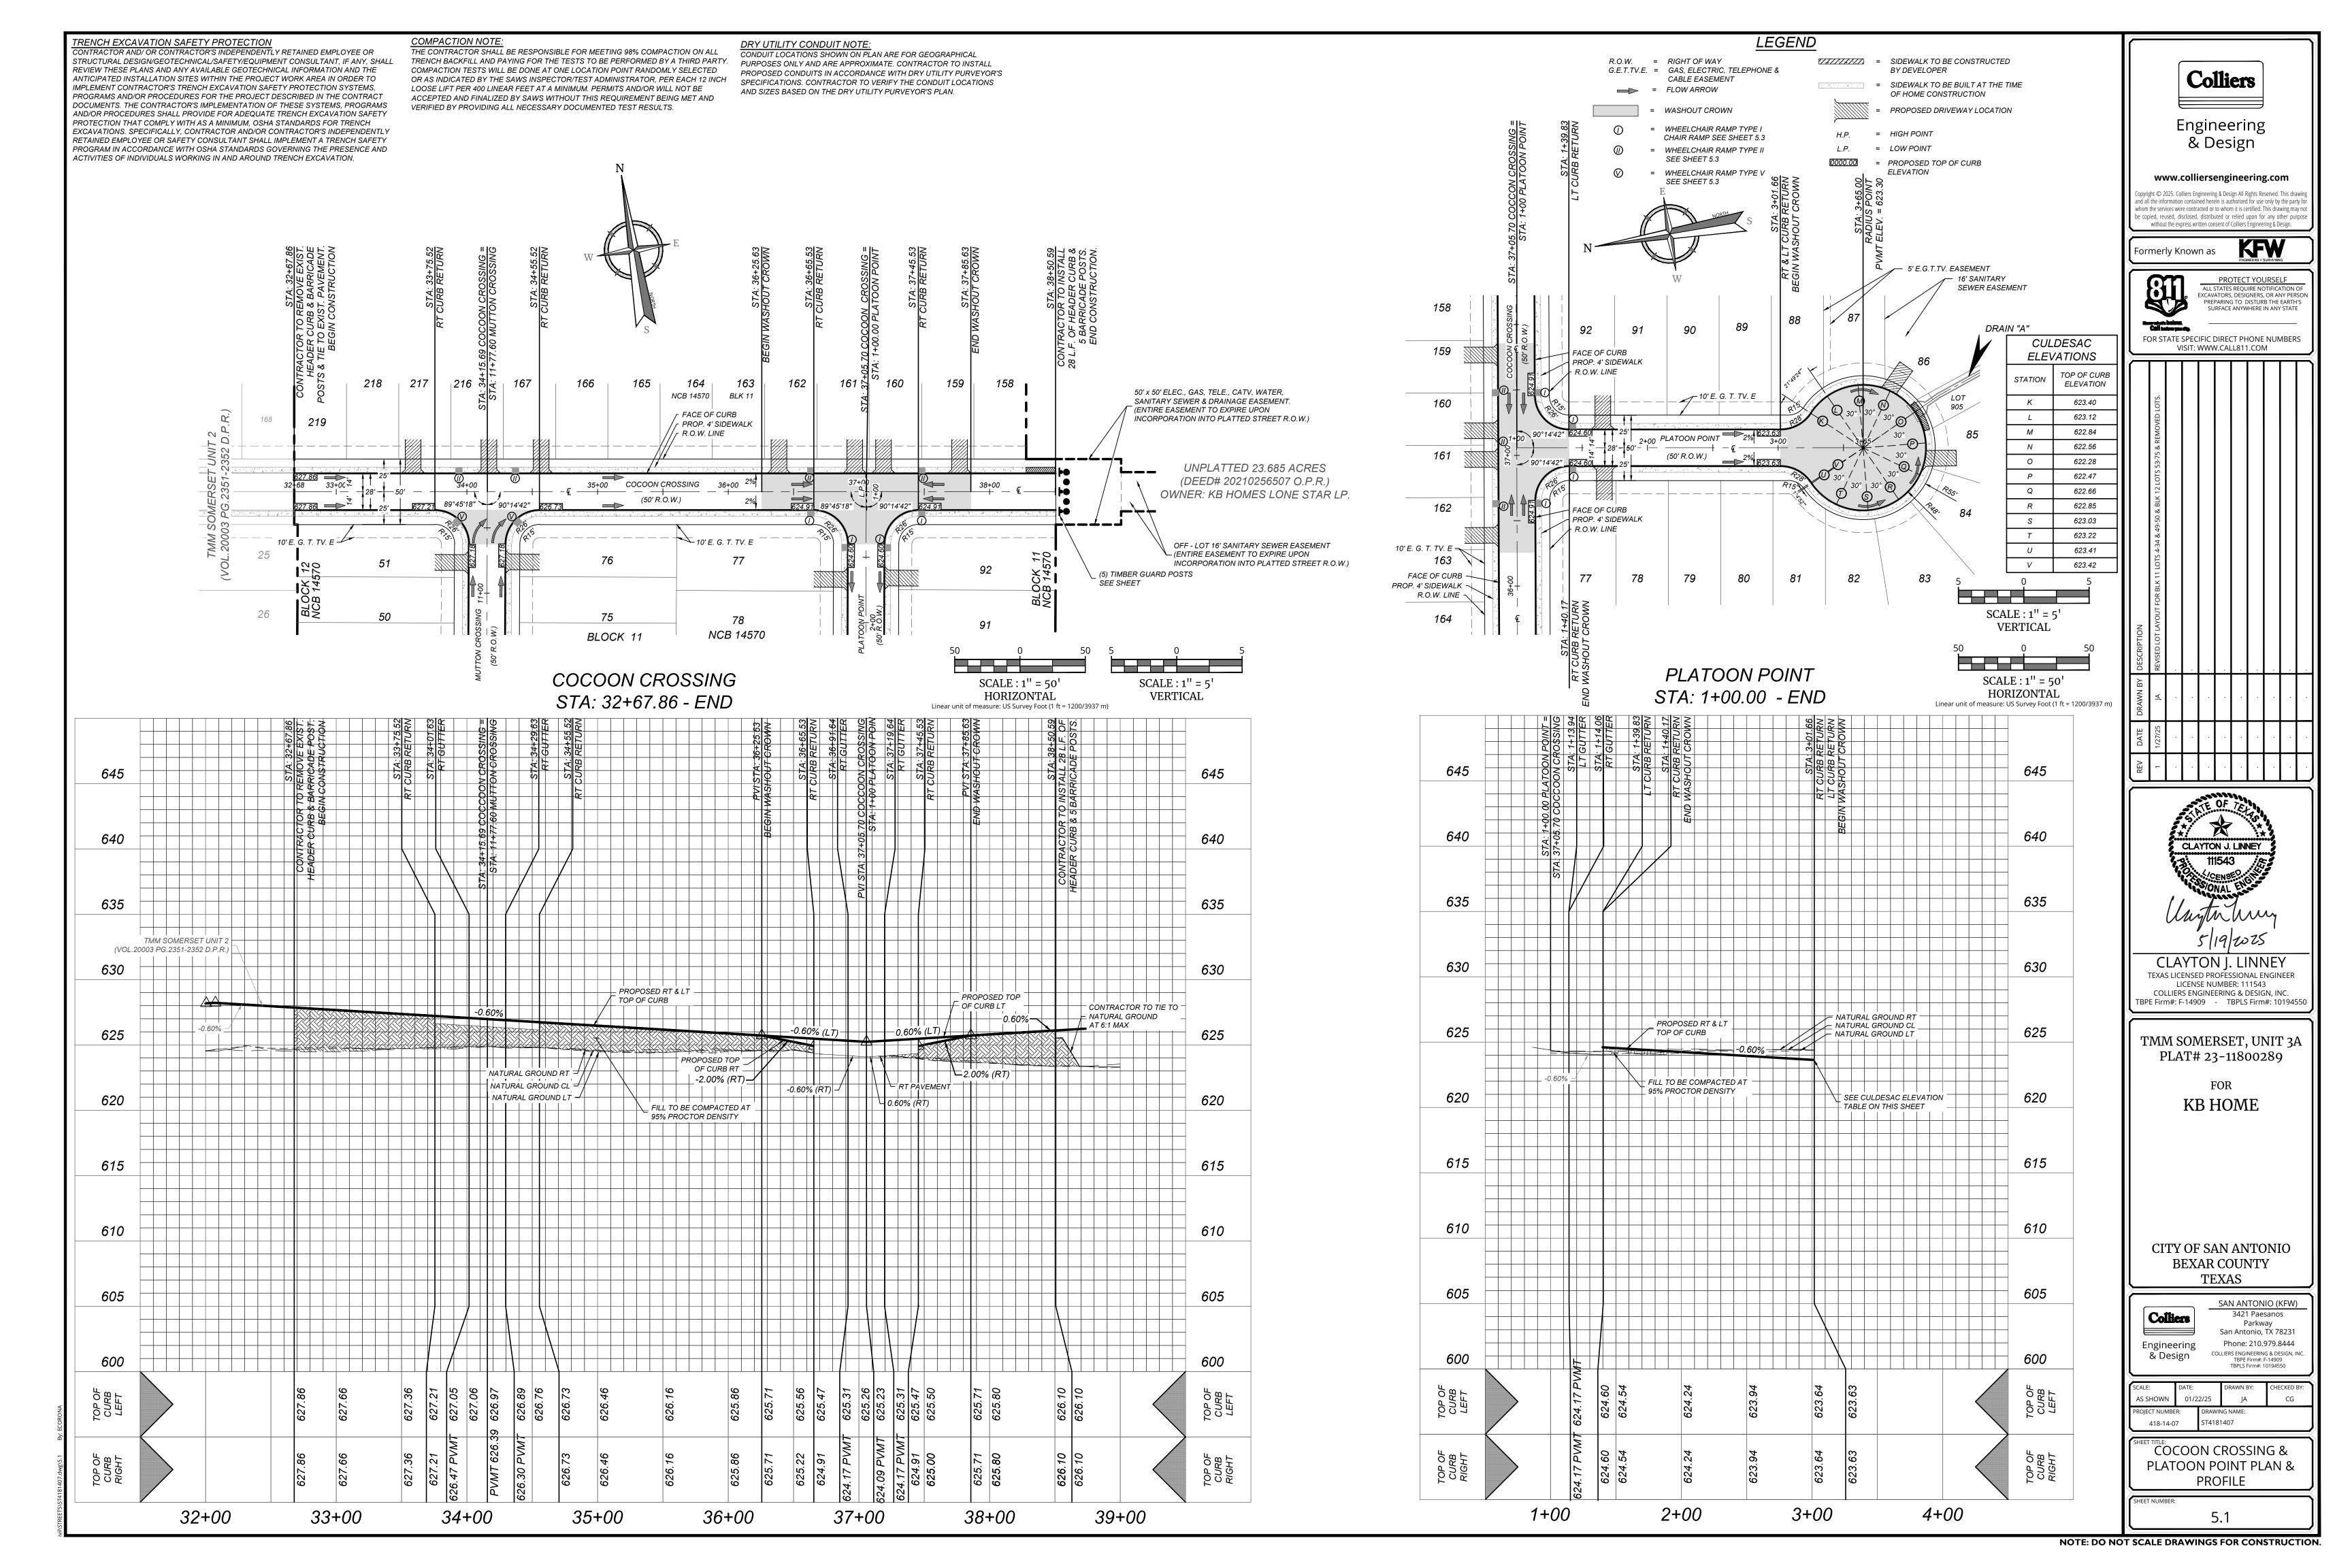

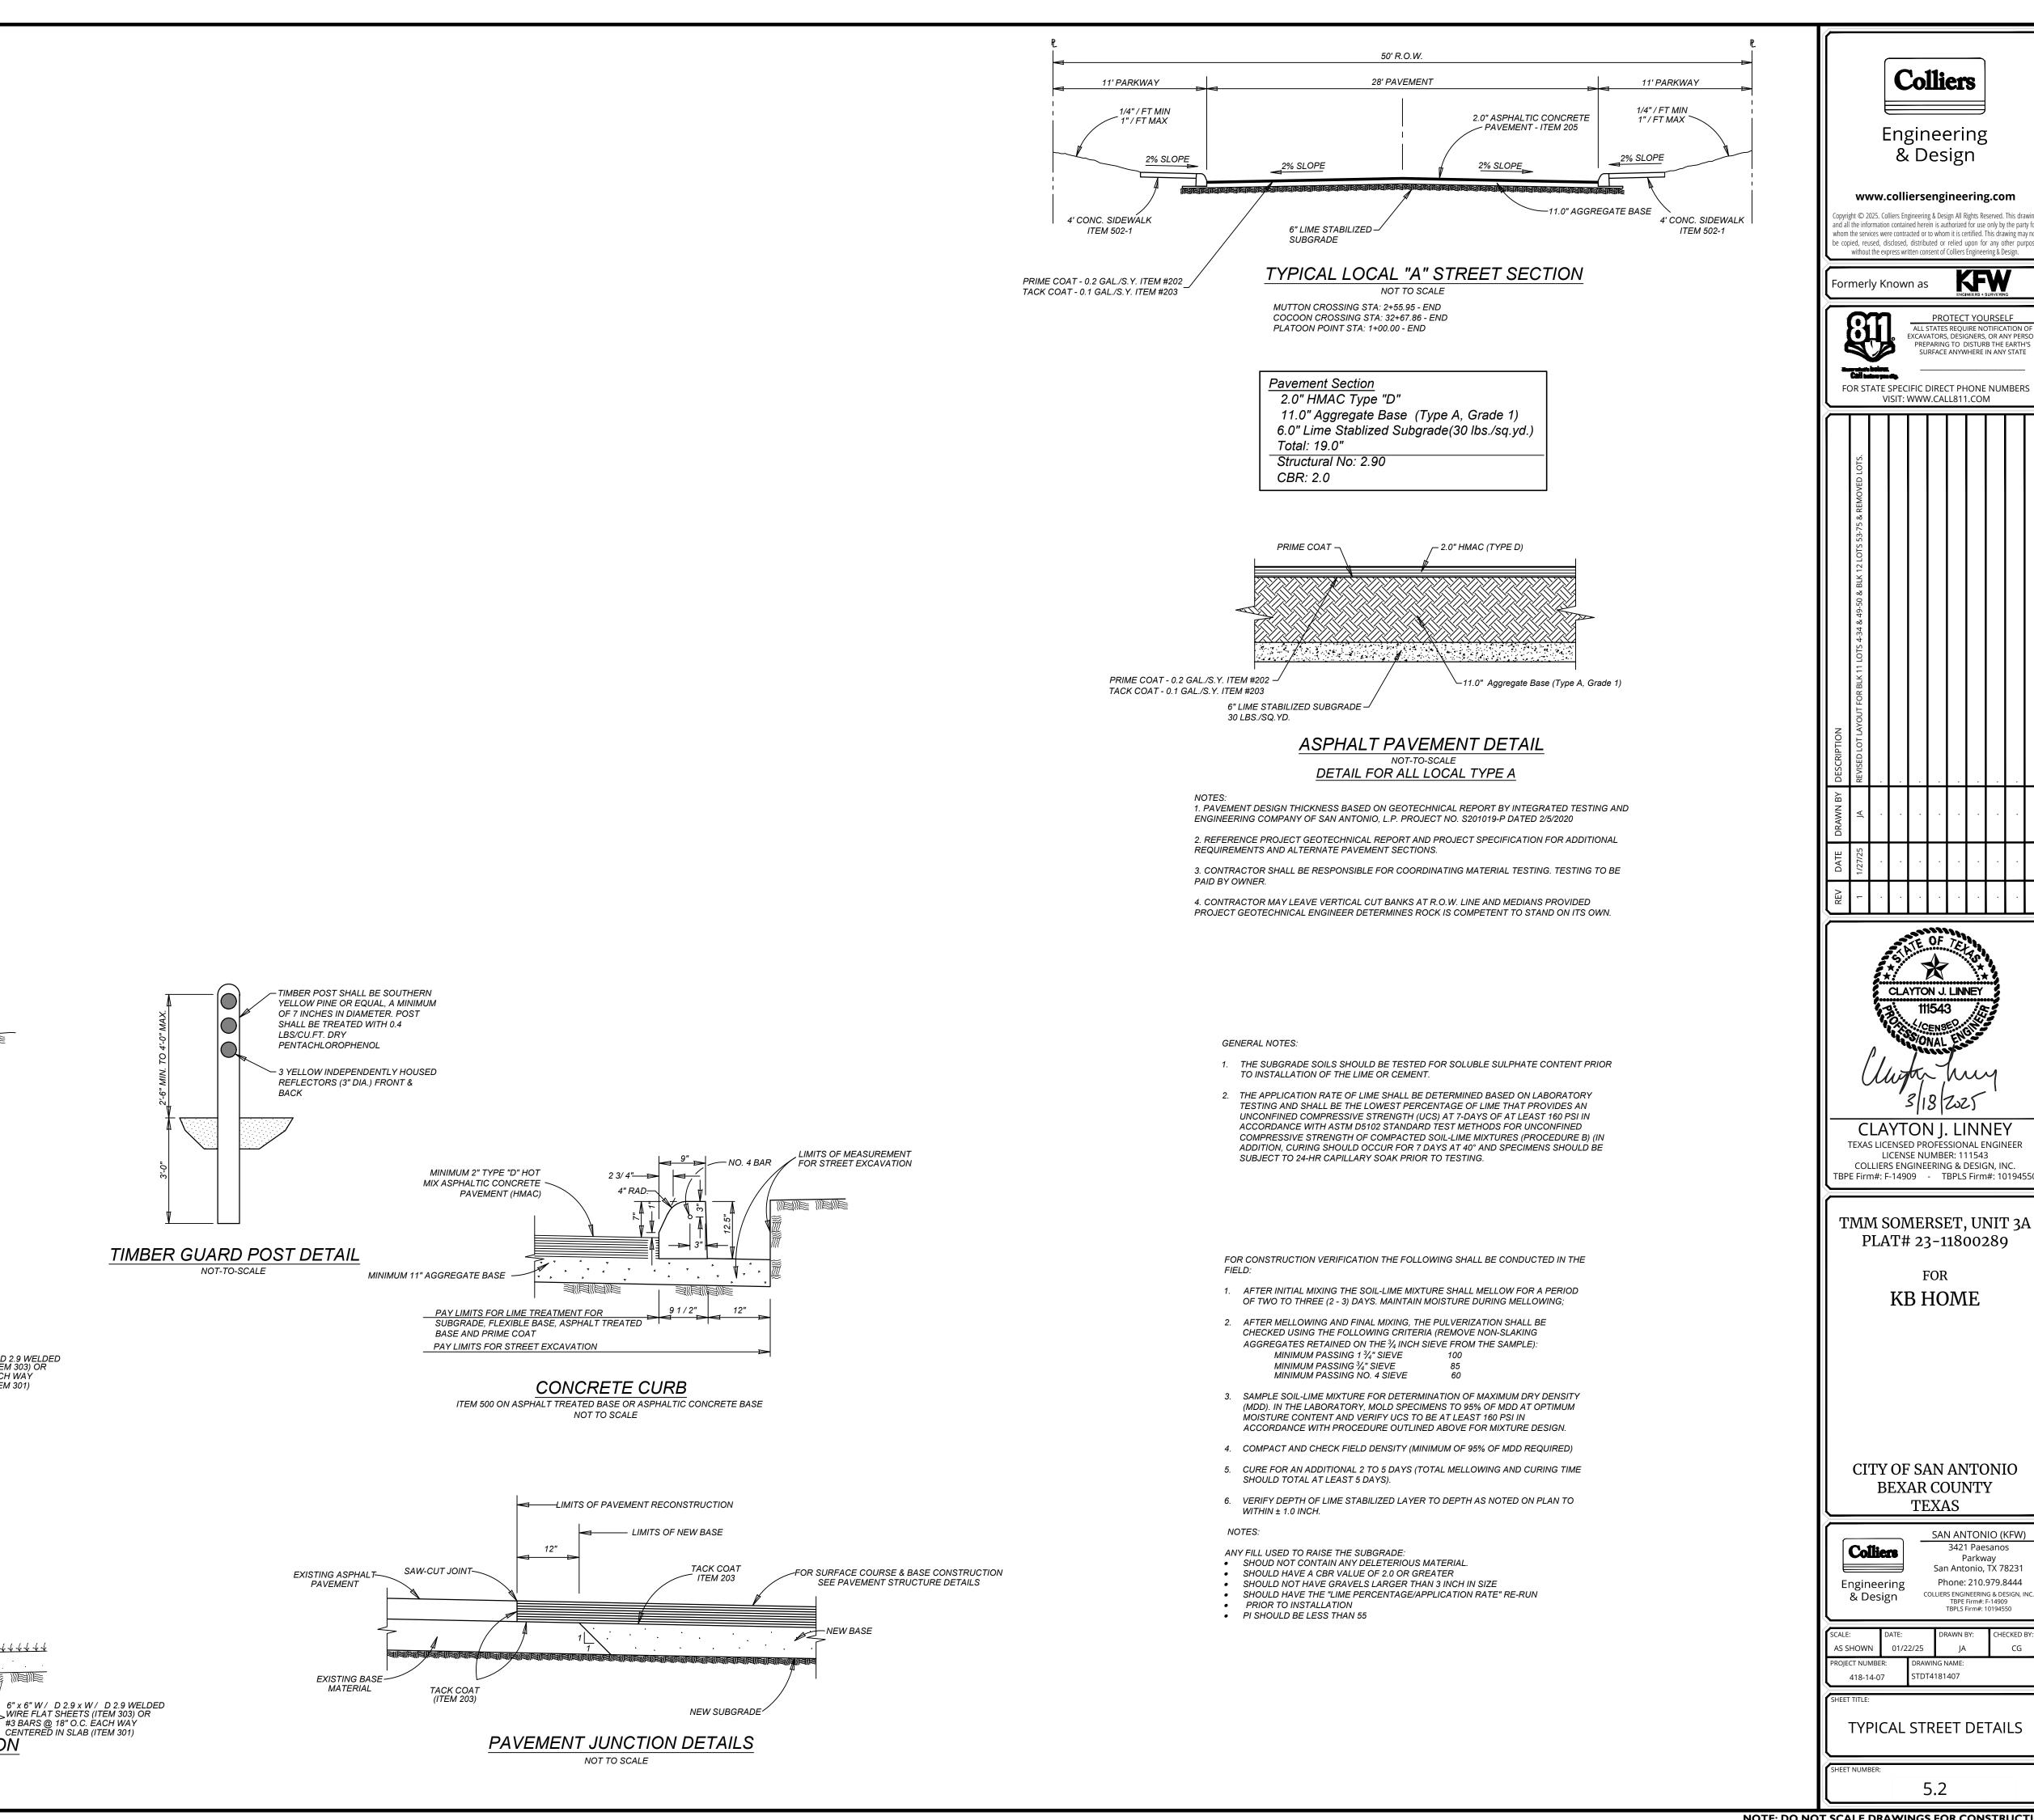

MINIMUM 2" TYPE "D" HOT

4" CLASS "A" CONCRETE\_ SIDEWALK - ITEM 502

NO. 4 BARS DOWEL INTO-

CURB AT 24" O.C.

4" CLASS "A" CONCRETE

2" MINIMUM GRAVEL, CRUSHED ROCK OR FLEXIBLE BASE MATERIAL

444444

HEADER CURB

ITEM 500 ON SAND OR GRAVEL

NOT TO SCALE

CONCRETE SIDEWALK

ABUTTING CURB SECTION

NOT TO SCALE

CONCRETE SIDEWALK SECTION

NOT TO SCALE

∕#3 BARS @ 18" O.C. ÈACH WAY


CENTERED IN SLAB (ITEM 301)


444444

CONCRETE PAVEMENT

MIX ASPHALTIC


MINIMUM 11" AGGREGATE BASE -

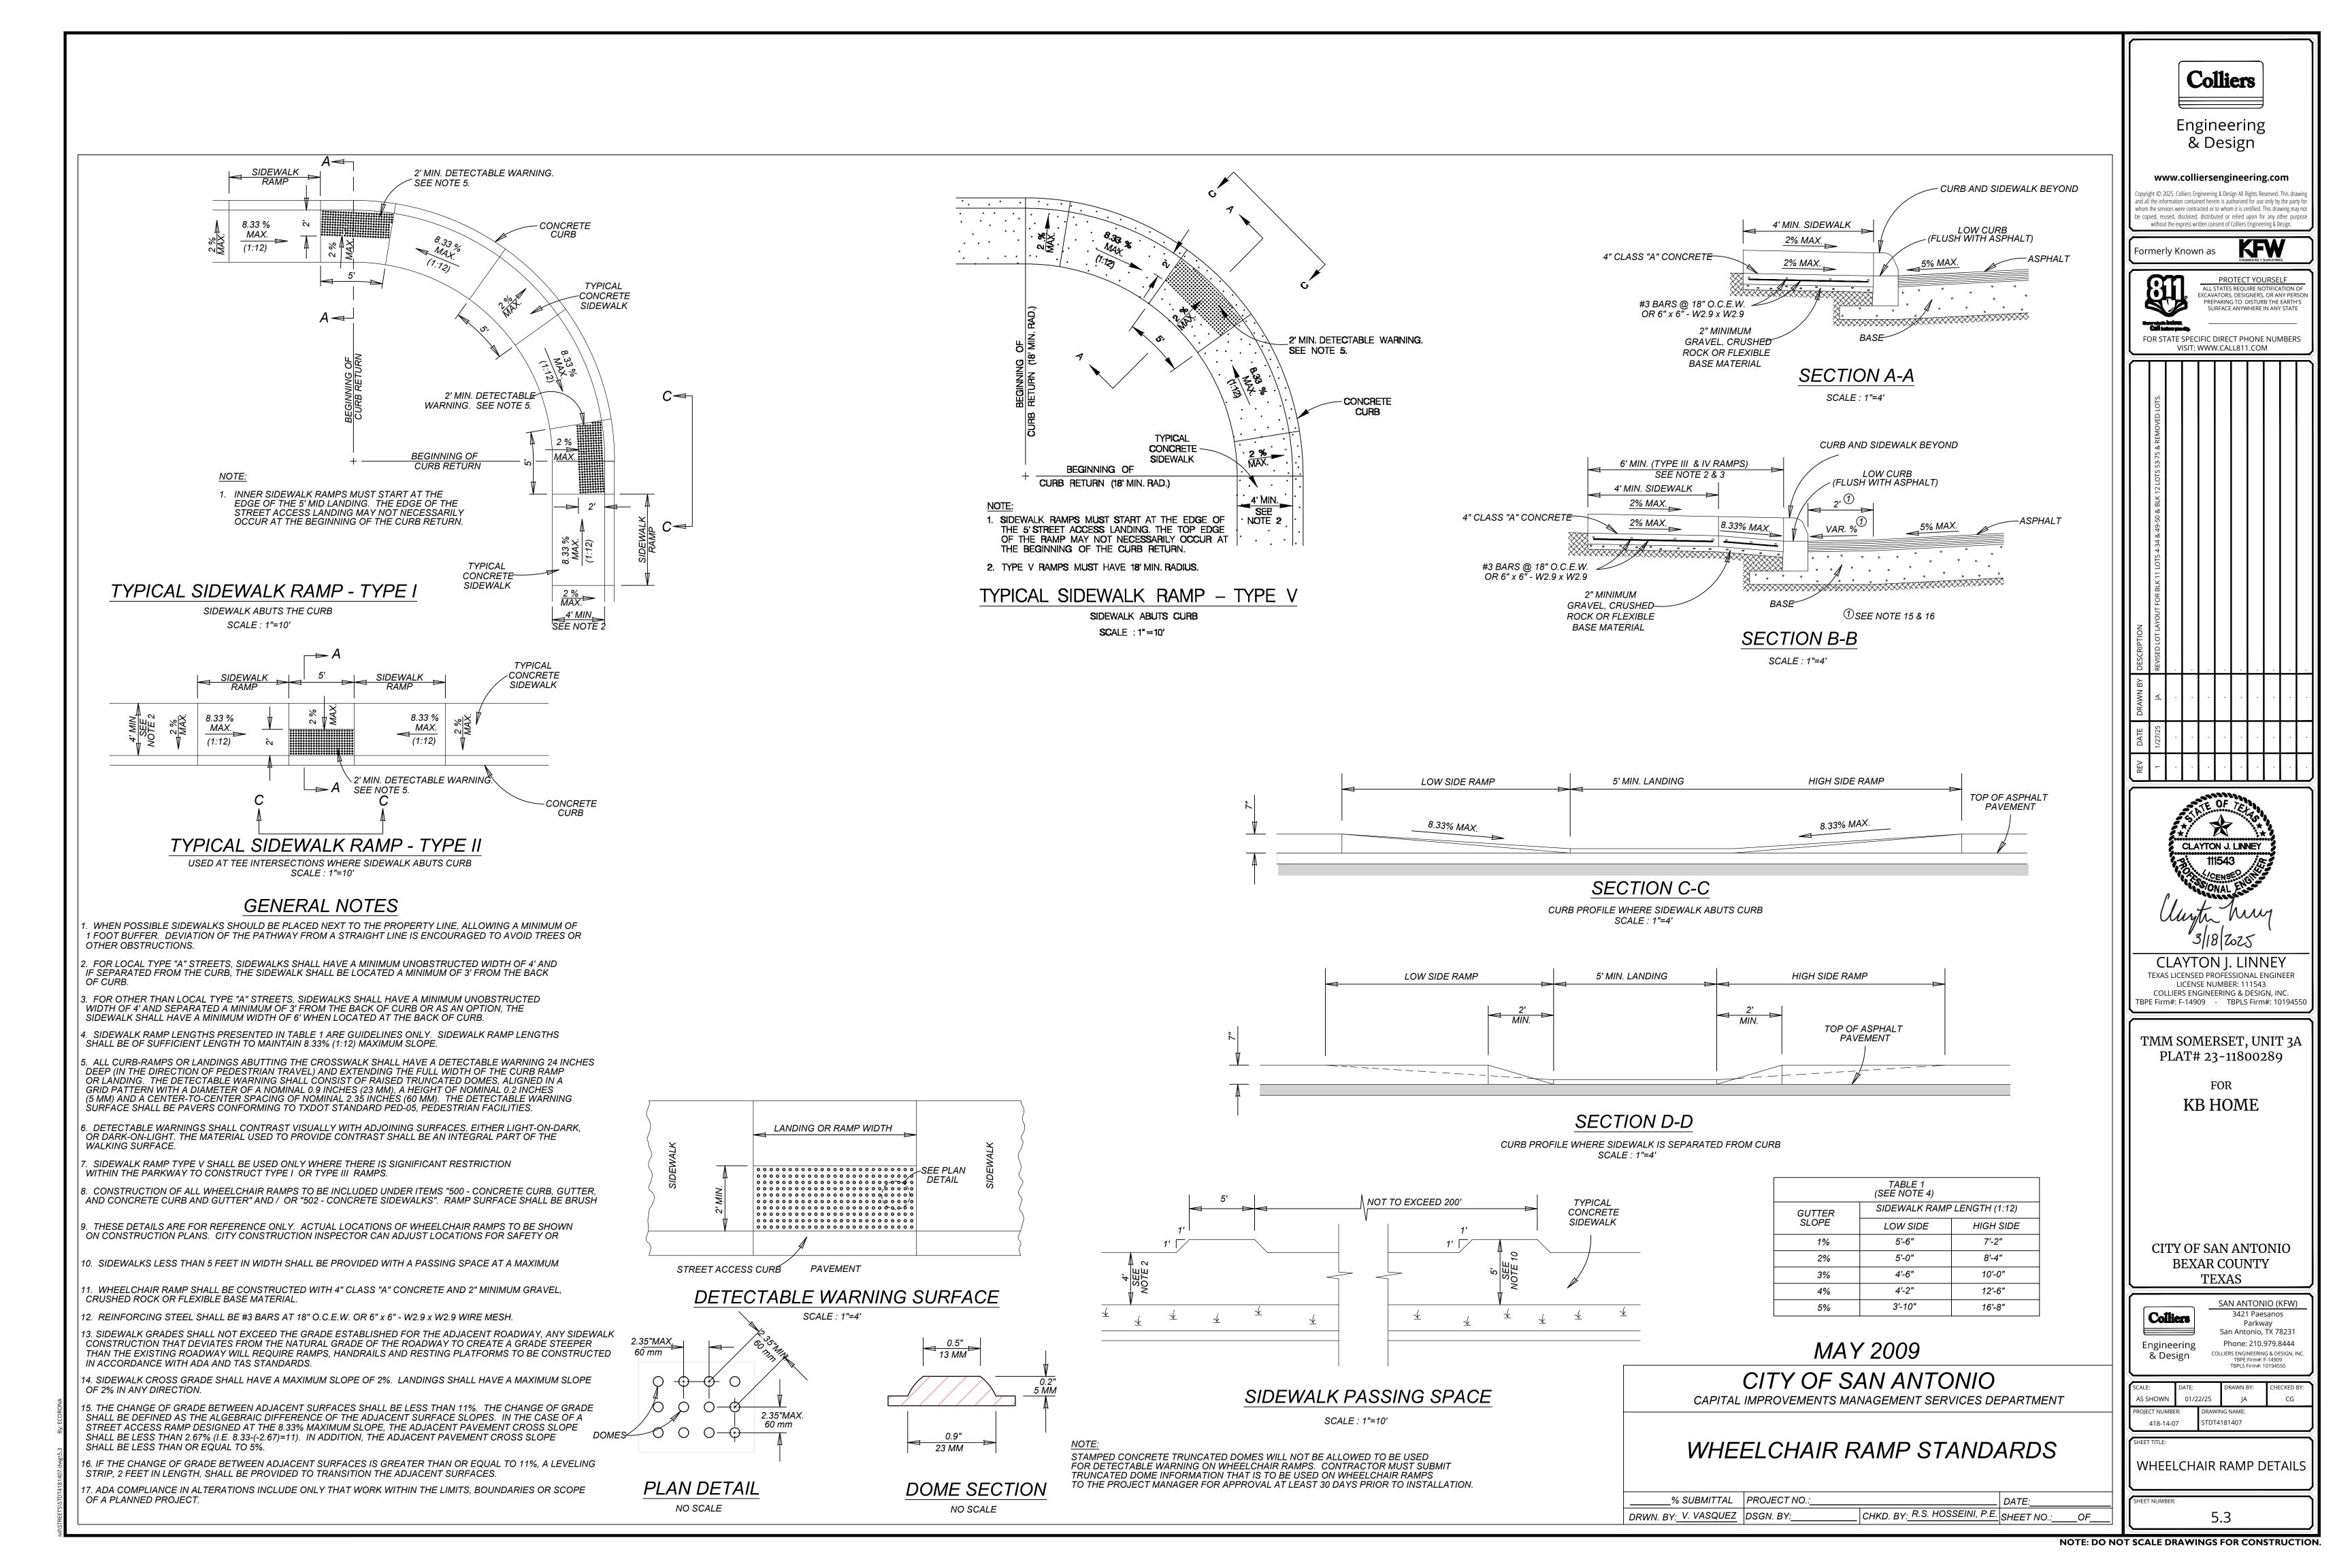

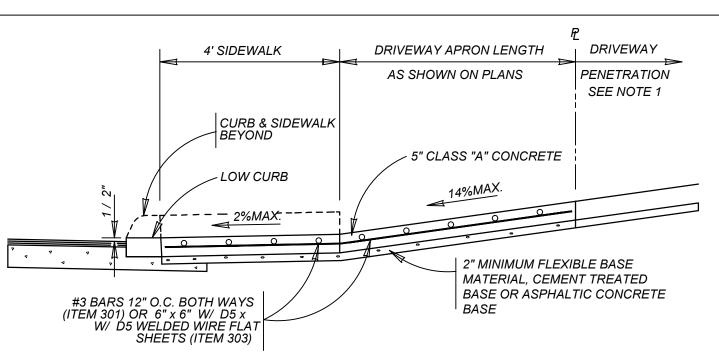


## TYPICAL RESIDENTIAL DRIVEWAY SECTION

WITH SIDEWALK ABUTTING CURB ITEM 503.1

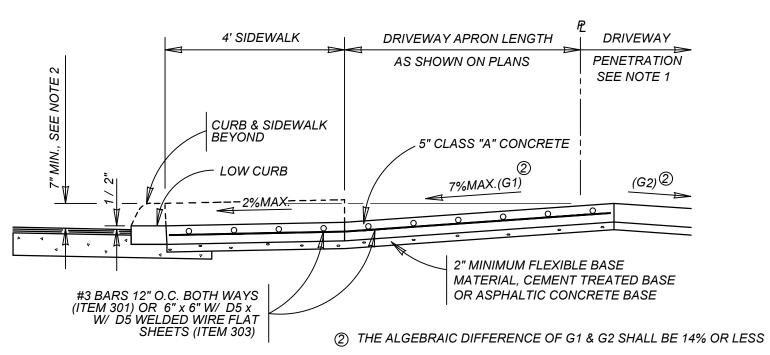

#### TYPICAL RESIDENTIAL DRIVEWAY SECTION

WHERE PROPERTY IS LOWER THAN STREET & SIDEWALK IS ABUTTING CURB ITEM 503.1

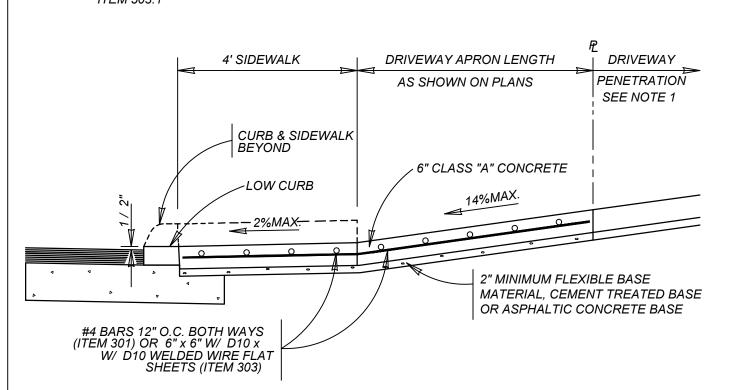

#### TYPICAL COMMERCIAL DRIVEWAY SECTION


WITH SIDEWALK ABUTTING CURB ITEM 503.2

#### CONCRETE DRIVEWAY NOTES

- DRIVEWAY PENETRATION REFERS TO A PORTION OF THE DRIVEWAY THAT MAY BE NECESSARY TO RECONSTRUCT WITHIN PRIVATE PROPERTY TO COMPLY WITH A MAXIMUM DRIVEWAY SLOPE. THIS PORTION OF THE DRIVEWAY SHALL BE PAID FOR UNDER THE FOLLOWING ITEMS AS MAY APPLY:
- A.) CONCRETE DRIVEWAY PAID FOR UNDER ITEM NO. 503.1 OR 503.2. B.) ASPHALTIC CONCRETE DRIVEWAY PAID FOR UNDER ITEM NO. 503.4 AND SHALL INCLUDE A MINIMUM OF 1" ASPHALT TYPE 'D' & 6" FLEXIBLE BASE
- C.) GRAVEL DRIVEWAY PAID FOR UNDER ITEM NO. 503.5 AND SHALL INCLUDE A MINIMUM OF 6" FLEXIBLE BASE
- 2. 7" MINIMUM HEIGHT WILL NOT NECESSARILY OCCUR AT THE PROPERTY LINE. IT MAY OCCUR WITHIN THE RIGHT OF WAY OR WITHIN THE DRIVEWAY PENETRATION ON PRIVATE PROPERTY.
- 3. THE PROPOSED DRIVEWAY SHOULD MATCH THE EXISTING WIDTH AT THE PROPERTY LINE BUT UNLESS AUTHORIZED BY THE CITY TRAFFIC ENGINEER, THE WIDTH SHALL BE WITHIN THE FOLLOWING VALUES:


TYPE	МІМІМИМ	MAXIMUM
RESIDENTIAL	10'	20'
COMMERCIAL - ONE WAY	12'	20'
COMMERCIAL - TWO WAY	24'	30'

- 4. FOR LOCAL TYPE "A" STREETS, SIDEWALK SHALL HAVE A MINIMUM WIDTH OF 4' AND IF SEPARATED FROM THE CURB, THE SIDEWALK SHALL BE LOCATED A MINIMUM OF 3' FROM THE BACK OF CURB.
- 5. FOR OTHER THAN LOCAL TYPE "A" STREETS, THE SIDEWALK SHALL HAVE A MINIMUM WIDTH OF 4' AND SEPARATED A MINIMUM OF 3' FROM THE BACK OF CURB OR, AS AN OPTION, THE SIDEWALK SHALL HAVE A MINIMUM WIDTH OF 6' WHEN LOCATED AT THE BACK OF CURB.
- 6. DUMMY JOINTS PARALLEL TO THE CURB SHALL BE PLACED WHERE THE SIDEWALK MEETS THE DRIVEWAY. DUMMY JOINTS PERPENDICULAR TO THE CURB, AND WITHIN THE BOUNDARIES OF THE PARALLEL DUMMY JOINTS, SHALL BE PLACED AT INTERVALS EQUAL TO THE WIDTH OF THE SIDEWALK.
- 7. A MINIMUM OF TWO ROUND AND SMOOTH DOWEL BARS 3 /8" IN DIAMETER AND 18" IN LENGTH SHALL BE SPACED 18" APART AT EACH EXPANSION JOINT
- 8. SIDEWALK RAMP LENGTHS SHALL BE OF SUFFICIENT LENGTH TO MAINTAIN 8.33% (1:12) MAXIMUM SLOPE. WHERE SIDEWALKS CROSS DRIVEWAYS, SIDEWALK CROSS SLOPE SHALL NOT EXCEED 2%.
- 9. SIDEWALK RAMP SURFACE SHALL BE BRUSH FINISHED.

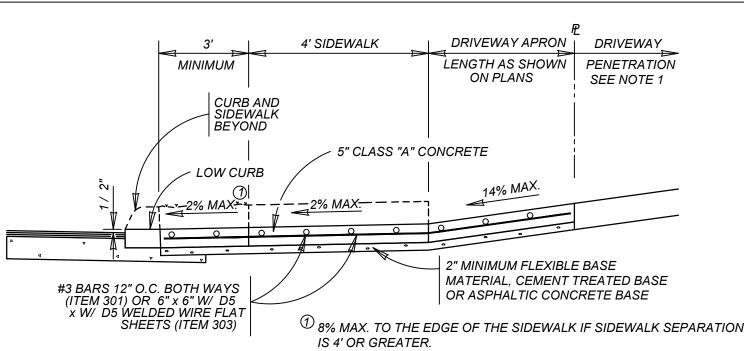

# TYPICAL RESIDENTIAL DRIVEWAY SECTION


WITH SIDEWALK SEPARATED FROM CURB ITEM 503.1

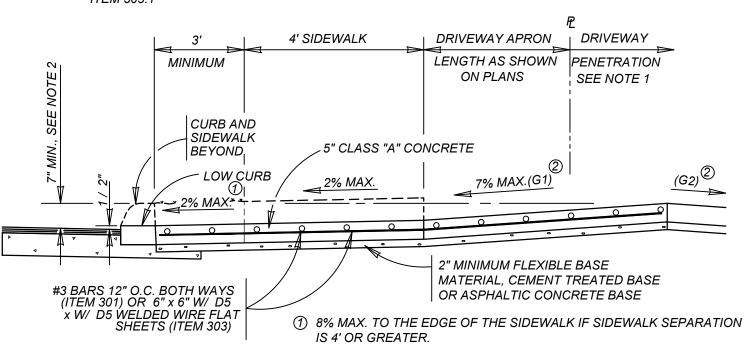

2) THE ALGEBRAIC DIFFERENCE OF G1 & G2 SHALL BE 14% OR LESS

#### TYPICAL RESIDENTIAL DRIVEWAY SECTION

WHERE PROPERTY IS LOWER THAN STREET & SIDEWALK IS SEPARATED FROM CURB

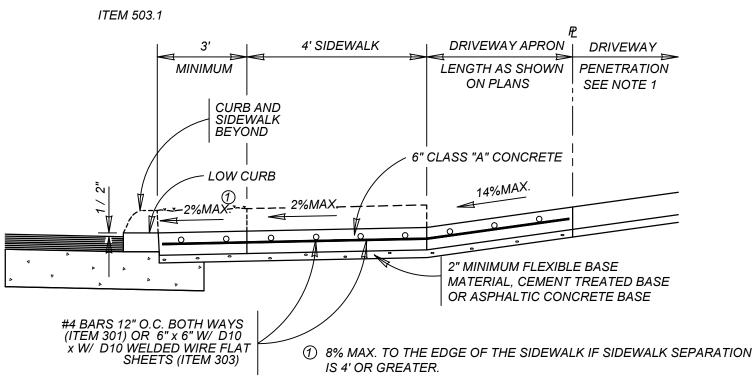


#### TYPICAL COMMERCIAL DRIVEWAY SECTION WITH SIDEWALK SEPARATED FROM CURB

\_\_ 3 / 4" CHAMFER 3 / 4" CHAMFER-6" MINIMUM - 12" MAXIMUM— ASPHALT OR GRAVEL DRIVEWAY --- 2 - #4 BARS CONTINUOUS — #3 BARS @ 12" О.С. MAXIMUM 2 - #4 BARS CONTINUOUS 西三 当一面三 12" MINIMUM - 18" MAXIMUM BELOW FINISHED GRADE 12"

- 1. COST OF REINFORCEMENT TO BE INCLUDED IN UNIT COST OF ITEM 307.1.
- 2. CONCRETE RETAINING WALL COMBINATION TYPE SHALL BE USED FOR

## DRIVEWAY - CONCRETE RETAINING WALL


ON COMPACTED SUBGRADE ITEM 307.1

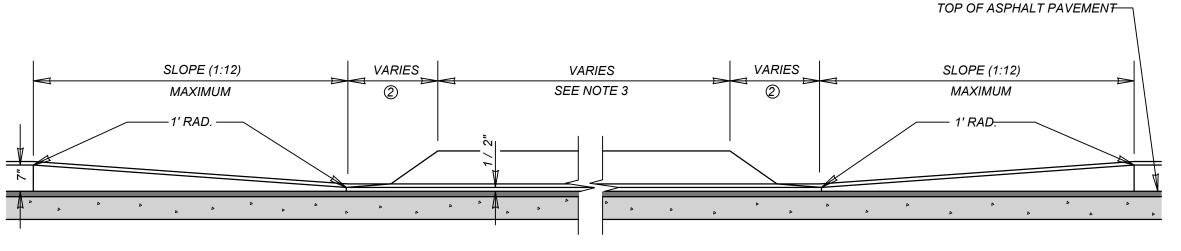

② RESIDENTIAL : 2' MAXIMUM; COMMERCIAL: SEE PLAN VIEW


#### CURB PROFILE AT DRIVEWAY

WITH SIDEWALK ABUTTING CURB

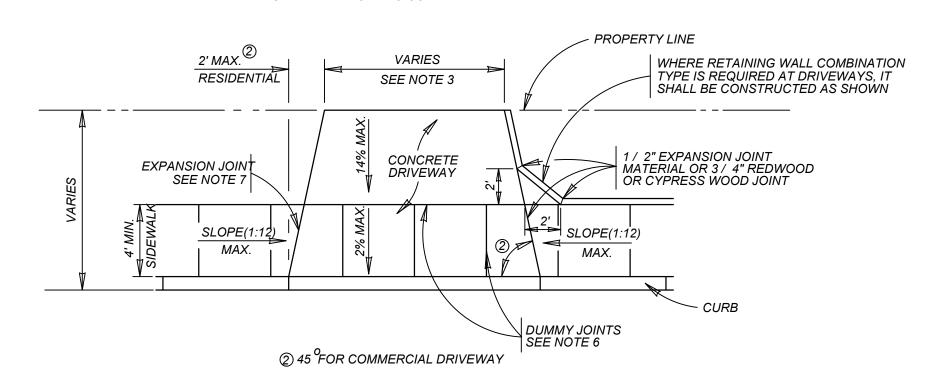

#### TYPICAL DRIVEWAY PLAN VIEW

WITH SIDEWALK ABUTTING CURB

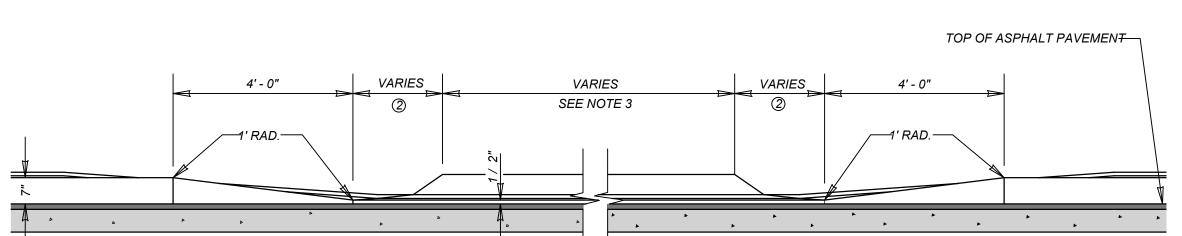

② RESIDENTIAL : 2' MAXIMUM; COMMERCIAL: SEE PLAN VIEW

#### CURB PROFILE AT DRIVEWAY

WITH SIDEWALK SEPARATED FROM CURB WHERE RETAINING WALL COMBINATION TYPE IS REQUIRED AT DRIVEWAYS, IT 2' MAX. SHALL BE CONSTRUCTED AS SHOWN **VARIES** RESIDENTIÁL SEE NOTE 3 - PROPERTY LINE 1 / 2" EXPANSION JOINT EXPANSION JOINT SEE NOTE 7 MATERIAL OR 3 / 4" REDWOOD OR CYPRESS WOOD JOINT CONCRETE DRIVEWAY SLOPE (1:12) SLOPE (1:12) MAX. MAX. A A 3' MIN. SEE NOTE 4 1 8% MAX. TO THE EDGE OF THE SIDEWALK IF SIDEWALK SEPARATION IS 4' OR GREATER.

> ② 45 FOR COMMERCIAL DRIVEWAY TYPICAL DRIVEWAY PLAN VIEW

WITH SIDEWALK SEPARATED FROM CURB

## MAY 2009

CITY OF SAN ANTONIO CAPITAL IMPROVEMENTS MANAGEMENT SERVICES DEPARTMENT

#### CONCRETE DRIVEWAY STANDARDS


\_% SUBMITTAL | PROJECT NO.:\_ DATE: CHKD. BY: R.S. HOSSEINI, P.E. SHEET NO.: OF DRWN. BY: V. VASQUEZ DSGN. BY:

**Colliers** 


Engineering & Design

www.colliersengineering.com

pyright © 2025. Colliers Engineering & Design All Rights Reserved. This drav hom the services were contracted or to whom it is certified. This drawing ma pe copied, reused, disclosed, distributed or relied upon for any other purp without the express written consent of Colliers Engineering & Design.

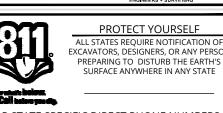

FOR STATE SPECIFIC DIRECT PHONE NUMBERS VISIT: WWW.CALL811.COM

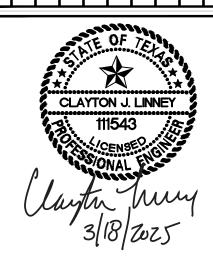

CLAYTON J. LINNEY TEXAS LICENSED PROFESSIONAL ENGINEER LICENSE NUMBER: 111543 COLLIERS ENGINEERING & DESIGN, INC. BPE Firm#: F-14909 - TBPLS Firm#: 1019455

TMM SOMERSET, UNIT 3A PLAT# 23-11800289

**KB HOME** 

CITY OF SAN ANTONIO **BEXAR COUNTY** 

**TEXAS** 

Engineering & Design

418-14-07

3421 Paesanos San Antonio, TX 78231 Phone: 210.979.8444 TBPE Firm#: F-14909


SAN ANTONIO (KFW)


TBPLS Firm#: 10194550 AS SHOWN


ГDT4181407


CONCRETE DRIVEWAY


DETAILS

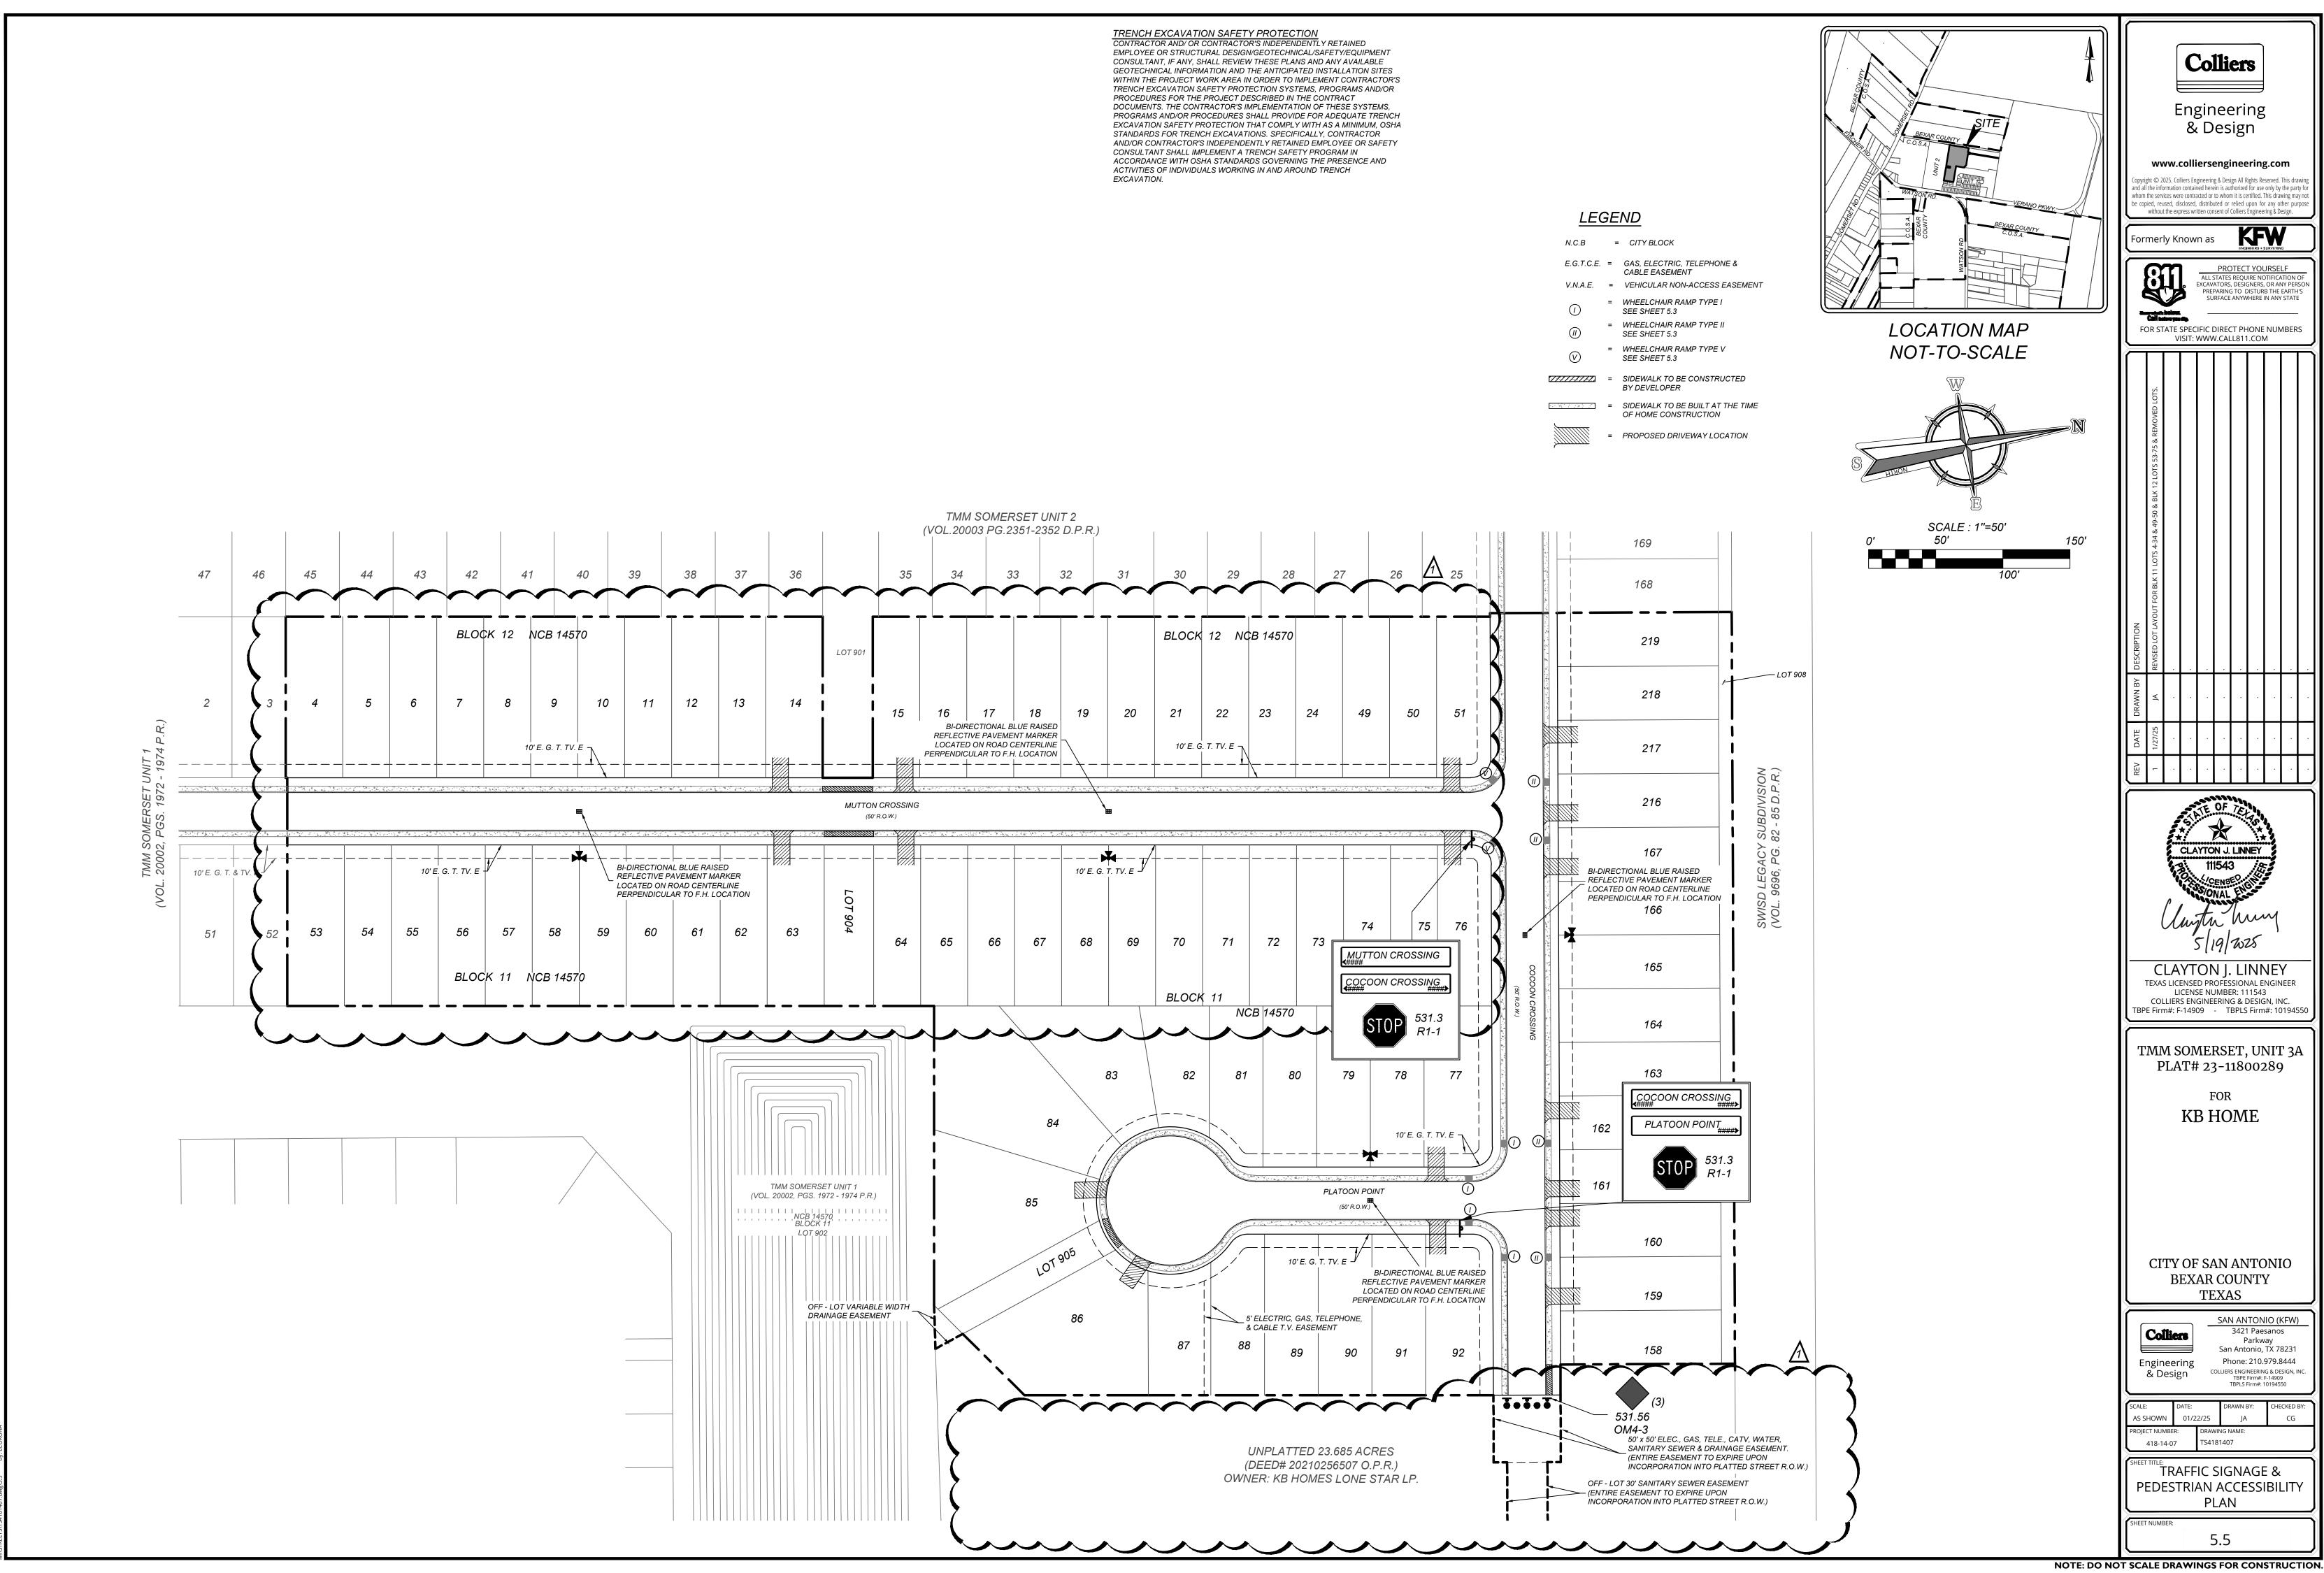

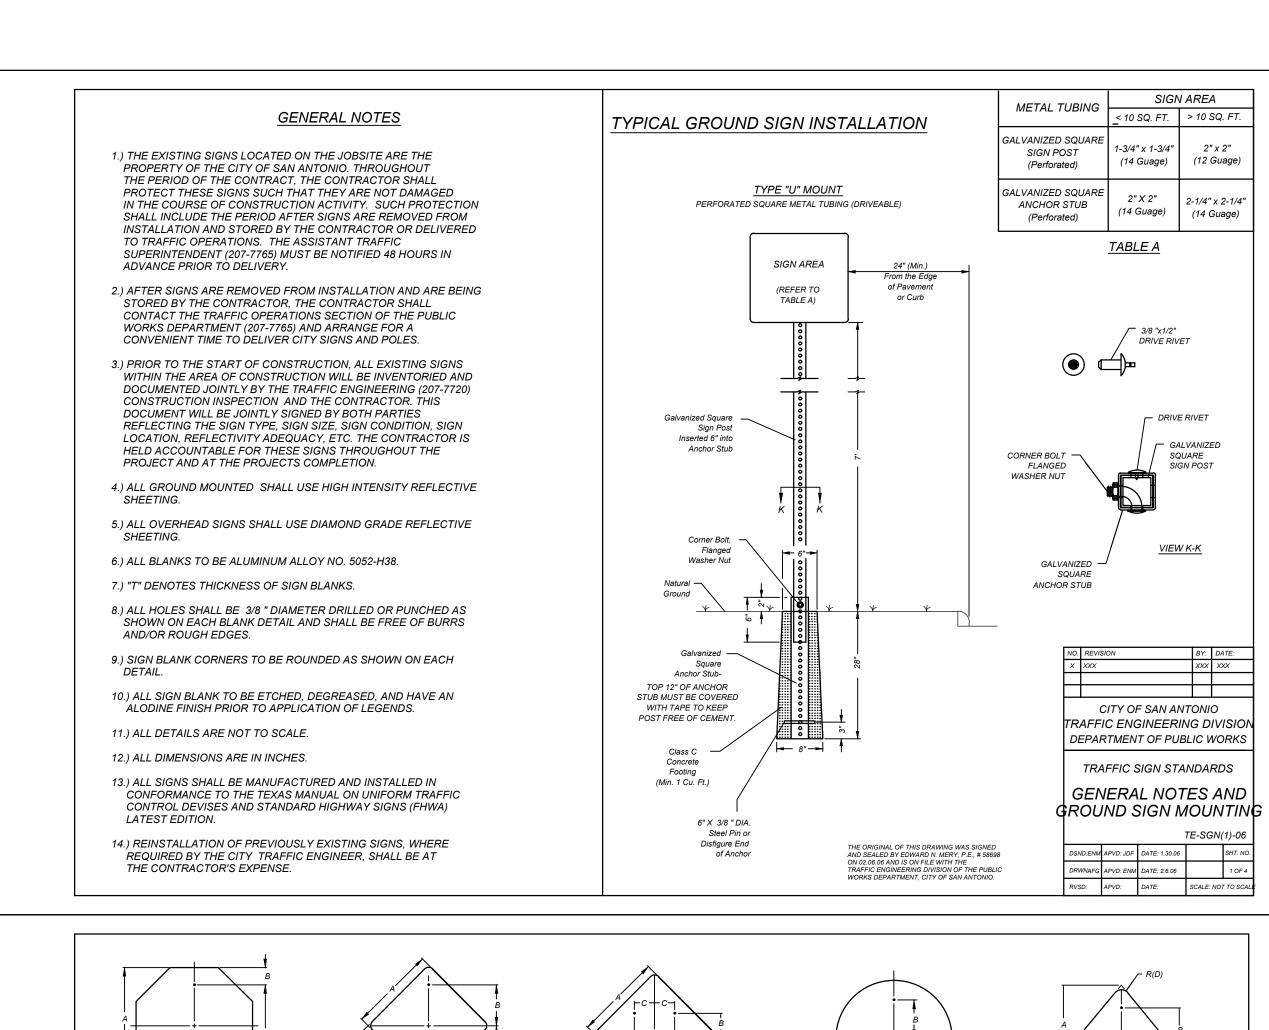

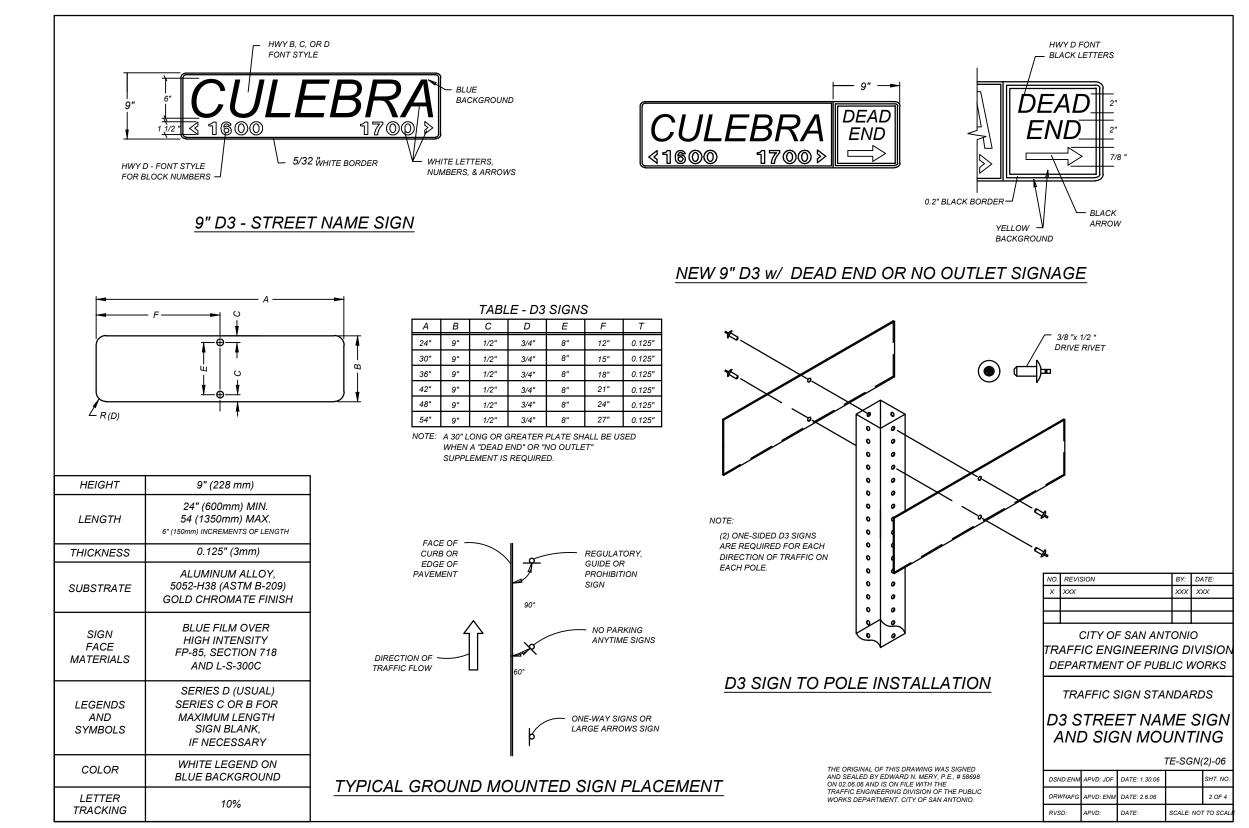

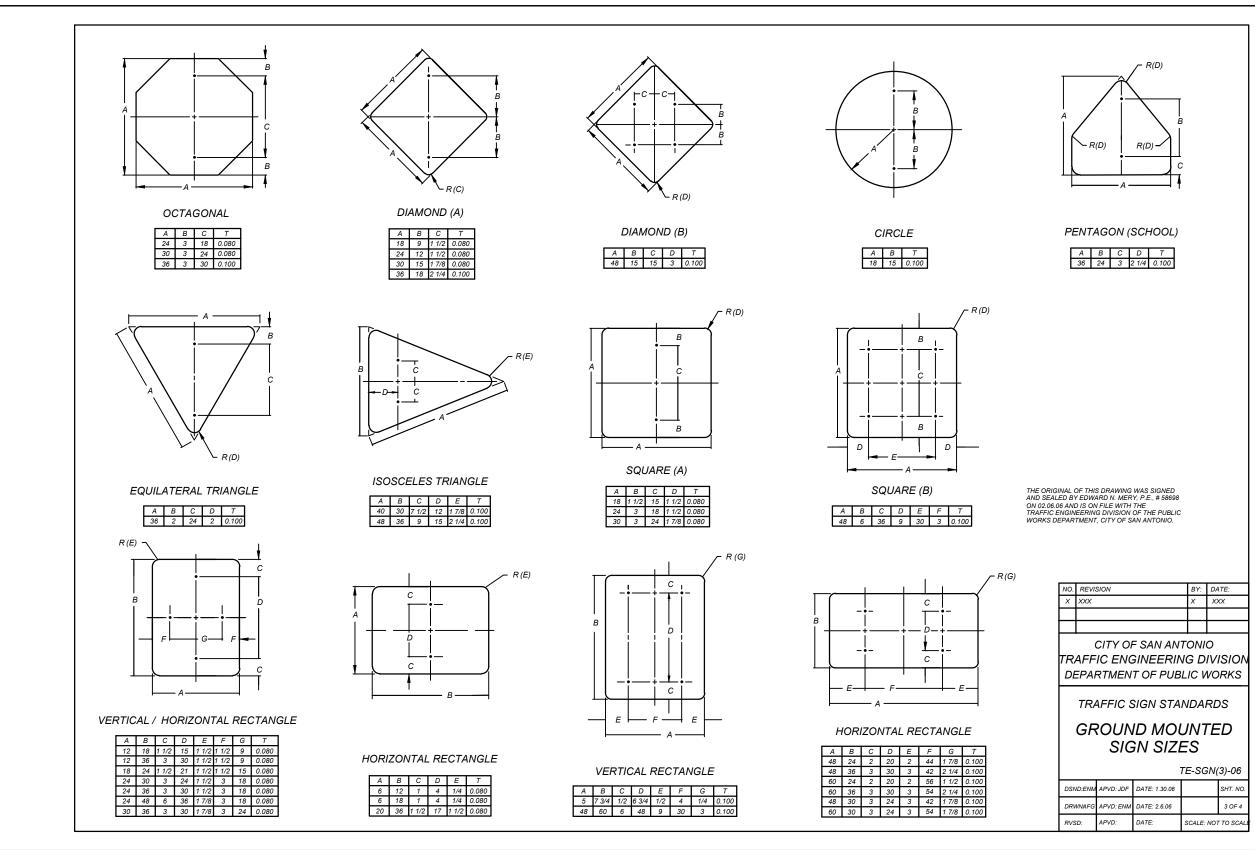

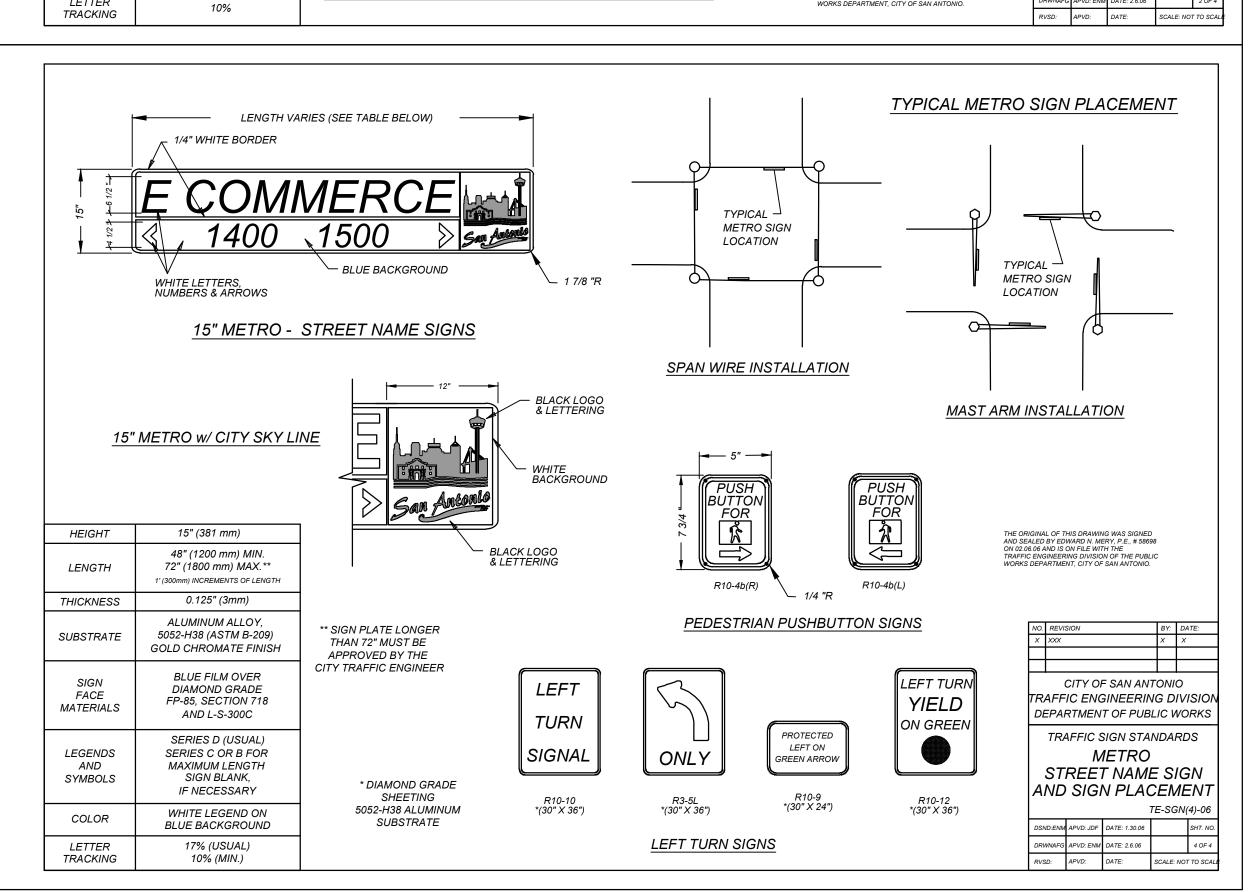




Engineering & Design


www.colliersengineering.com

pyright © 2025. Colliers Engineering & Design All Rights Reserved. This draw hom the services were contracted or to whom it is certified. This drawing ma pe copied, reused, disclosed, distributed or relied upon for any other purp without the express written consent of Colliers Engineering & Design.

Formerly Known as

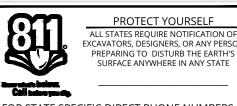

FOR STATE SPECIFIC DIRECT PHONE NUMBERS VISIT: WWW.CALL811.COM

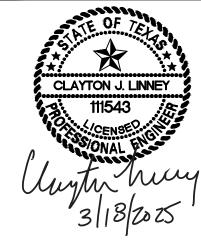

CLAYTON J. LINNEY TEXAS LICENSED PROFESSIONAL ENGINEER LICENSE NUMBER: 111543 COLLIERS ENGINEERING & DESIGN, INC. BPE Firm#: F-14909 - TBPLS Firm#: 10194550

TMM SOMERSET, UNIT 3A PLAT# 23-11800289

> FOR **KB HOME**

CITY OF SAN ANTONIO BEXAR COUNTY **TEXAS** 

Colliers Engineering

SAN ANTONIO (KFW) 3421 Paesanos Parkway San Antonio, TX 78231 Phone: 210.979.8444 COLLIERS ENGINEERING & DESIGN, INC & Design TBPE Firm#: F-14909 TBPLS Firm#: 10194550

AS SHOWN AWING NAME: ΓSDT4181407 418-14-07

TRAFFIC SIGN MOUNTING

DETAILS

#### SAWS STANDARD GENERAL CONSTRUCTION NOTES ASSOCIATED WITH 2022 SAWS STANDARD SPECS UPDATED JANUARY, 2022

#### **GENERAL SECTION**

- 1. ALL MATERIALS AND CONSTRUCTION PROCEDURES WITHIN THE SCOPE OF THIS CONTRACT SHALL BE APPROVED BY THE SAN ANTONIO WATER SYSTEM (SAWS) AND COMPLY WITH THE PLANS, SPECIFICATIONS, GENERAL CONDITIONS AND WITH THE FOLLOWING AS APPLICABLE:
- A. CURRENT TEXAS COMMISSION ON ENVIRONMENTAL QUALITY (TCEQ) "DESIGN CRITERIA FOR DOMESTIC WASTEWATER SYSTEM", TEXAS ADMINISTRATIVE CODE (TAC) TITLE 30 PART 1
- CHAPTER 217 AND "PUBLIC DRINKING WATER", TAC TITLE 30 PART 1 CHAPTER 290. B. CURRENT TXDOT "STANDARD SPECIFICATIONS FOR CONSTRUCTION OF HIGHWAYS, STREETS
- C. CURRENT "SAN ANTONIO WATER SYSTEM STANDARD SPECIFICATIONS FOR WATER AND SANITARY SEWER CONSTRUCTION".
- D. CURRENT CITY OF SAN ANTONIO "STANDARD SPECIFICATIONS FOR PUBLIC WORKS CONSTRUCTION".
- E. CURRENT CITY OF SAN ANTONIO "UTILITY EXCAVATION CRITERIA MANUAL" (UECM).
  - THE CONTRACTOR SHALL NOT PROCEED WITH ANY PIPE INSTALLATION WORK UNTIL THEY OBTAIN A COPY OF THE APPROVED COUNTER PERMIT OR GENERAL CONSTRUCTION PERMIT (GCP) FROM THE CONSULTANT AND HAS BEEN NOTIFIED BY SAWS CONSTRUCTION INSPECTION DIVISION TO PROCEED WITH THE WORK AND HAS ARRANGED A MEETING WITH THE INSPECTOR AND CONSULTANT FOR THE WORK REQUIREMENTS. WORK COMPLETED BY THE CONTRACTOR WITHOUT AN APPROVED COUNTER PERMIT AND/OR A GCP WILL BE SUBJECT TO REMOVAL AND REPLACEMENT AT THE EXPENSE OF THE CONTRACTORS AND/OR THE DEVELOPER.
- THE CONTRACTOR SHALL OBTAIN THE SAWS STANDARD DETAILS FROM THE SAWS WEBSITE, HTTP://WWW.SAWS.ORG/BUSINESS\_CENTER/SPECS. UNLESS OTHERWISE NOTED WITHIN THE DESIGN PLANS.
- 4. THE CONTRACTOR IS TO MAKE ARRANGEMENTS WITH THE SAWS CONSTRUCTION INSPECTION DIVISION AT (210) 233-2973, ON NOTIFICATION PROCEDURES THAT WILL BE USED TO NOTIFY AFFECTED HOME RESIDENTS AND/OR PROPERTY OWNERS 48 HOURS PRIOR TO BEGINNING ANY WORK.
- 5. LOCATION AND DEPTH OF EXISTING UTILITIES AND SERVICE LATERALS SHOWN ON THE PLANS ARE UNDERSTOOD TO BE APPROXIMATE. ACTUAL LOCATIONS AND DEPTHS MUST BE FIELD VERIFIED BY THE CONTRACTOR AT LEAST 1 WEEK PRIOR TO CONSTRUCTION. IT SHALL BE THE CONTRACTOR'S RESPONSIBILITY TO LOCATE UTILITY SERVICE LINES AS REQUIRED FOR CONSTRUCTION AND TO PROTECT THEM DURING CONSTRUCTION AT NO
- 6. THE CONTRACTOR SHALL VERIFY THE EXACT LOCATION OF UNDERGROUND UTILITIES AND DRAINAGE STRUCTURES AT LEAST 1-2 WEEKS PRIOR TO CONSTRUCTION WHETHER SHOWN ON PLANS OR NOT. PLEASE ALLOW UP TO 7 BUSINESS DAYS FOR LOCATES REQUESTING PIPE LOCATION MARKERS ON SAWS FACILITIES. THE FOLLOWING CONTACT INFORMATION ARE SUPPLIED FOR VERIFICATION PURPOSES.
- SAWS UTILITY LOCATES: <u>HTTP://WWW.SAWS.ORG/SERVICE/LOCATES</u>
- COSA DRAINAGE (210) 207-0724 OR (210) 207-6026 COSA TRAFFIC SIGNAL OPERATIONS (210) 206-8480
- COSA TRAFFIC SIGNAL DAMAGES (210) 207-3951 TEXAS STATE WIDE ONE CALL LOCATOR 1-800-545-6005 OR 811
- THE CONTRACTOR SHALL BE RESPONSIBLE FOR RESTORING EXISTING FENCES, CURBS, STREETS, DRIVEWAYS, SIDEWALKS, LANDSCAPING AND STRUCTURES TO ITS ORIGINAL OR BETTER CONDITION IF DAMAGES ARE MADE AS A RESULT OF THE PROJECT'S
- 8. ALL WORK IN TEXAS DEPARTMENT OF TRANSPORTATION (TXDOT) AND/OR BEXAR COUNTY RIGHT-OF-WAY SHALL BE DONE IN ACCORDANCE WITH RESPECTIVE
- CONSTRUCTION SPECIFICATIONS AND PERMIT REQUIREMENTS. 9. THE CONTRACTOR SHALL COMPLY WITH CITY OF SAN ANTONIO OR OTHER GOVERNING MUNICIPALITY'S TREE ORDINANCES WHEN EXCAVATING NEAR TREES.
- THE CONTRACTOR SHALL NOT PLACE ANY WASTE MATERIALS IN THE 100-YEAR FLOOD PLAIN WITHOUT FIRST OBTAINING AN APPROVED FLOOD PLAIN PERMIT. 11. HOLIDAY WORK: CONTRACTORS WILL NOT BE ALLOWED TO PERFORM SAWS WORK ON
- SAWS RECOGNIZED HOLIDAYS. REQUEST SHOULD BE SENT TO CONSTWORKREQ@SAWS.ORG. WEEKEND WORK: CONTRACTORS ARE REQUIRED TO NOTIFY THE SAWS INSPECTION CONSTRUCTION DEPARTMENT 48 HOURS IN ADVANCE TO REQUEST WEEKEND WORK. REQUEST SHOULD BE SENT TO CONSTWORKREO@SAWS.ORG. ANY AND ALL SAWS UTILITY WORK INSTALLED WITHOUT HOLIDAY/WEEKEND APPROVAL WILL BE SUBJECT TO BE UNCOVERED FOR PROPER
- THE COMPACTION REQUIREMENTS ON ALL TRENCH BACKFILL AND FOR PAYING FOR THE TESTS PERFORMED BY A THIRD PARTY. COMPACTION TESTS WILL BE DONE AT ONE LOCATION POINT RANDOMLY SELECTED, OR AS INDICATED BY THE SAWS INSPECTOR AND/OR THE TEST ADMINISTRATOR, PER EACH 12-INCH LOOSE LIFT PER 400 LINEAR FEET AT A MINIMUM. THIS PROJECT WILL NOT BE ACCEPTED AND FINALIZED BY SAWS WITHOUT THIS REQUIREMENT BEING MET AND VERIFIED BY PROVIDING ALL NECESSARY DOCUMENTED TEST RESULTS.
- . A COPY OF ALL TESTING REPORTS SHALL BE FORWARDED TO SAWS CONSTRUCTION INSPECTION DIVISION.

#### SEWER NOTES

- 1. THE CONTRACTOR IS RESPONSIBLE FOR ENSURING THAT NO SANITARY SEWER OVERFLOW (SSO) OCCURS AS A RESULT OF THEIR WORK, ALL CONTRACTOR PERSONNEL RESPONSIBLE FOR SSO PREVENTION AND CONTROL SHALL BE TRAINED ON PROPER RESPONSE. SHOULD AN SSO OCCUR. THE CONTRACTOR SHALL
- A. IDENTIFY THE SOURCE OF THE SSO AND NOTIFY SAWS EMERGENCY OPERATIONS CENTER (EOC) IMMEDIATELY AT (210) 233-2014. PROVIDE THE ADDRESS OF THE SPILL AND AN ESTIMATED VOLUME OR FLOW.
- B. ATTEMPT TO ELIMINATE THE SOURCE OF THE SSO. CONTAIN SEWAGE FROM THE SSO TO THE EXTENT OF PREVENTING A POSSIBLE
- D. CLEAN UP SPILL SITE (RETURN CONTAINED SEWAGE TO THE COLLECTION SYSTEM IF
- POSSIBLE) AND PROPERLY DISPOSE OF CONTAMINATED SOIL/MATERIALS.
- E. CLEAN THE AFFECTED SEWER MAINS AND REMOVE ANY DEBRIS. MEET ALL POST-SSO REQUIREMENTS AS PER THE EPA CONSENT DECREE, INCLUDING LINE CLEANING AND TELEVISING THE AFFECTED SEWER MAINS (AT SAWS DIRECTION) WITHIN 24
- SHOULD THE CONTRACTOR FAIL TO ADDRESS AN SSO IMMEDIATELY AND TO SAWS SATISFACTION. THEY WILL BE RESPONSIBLE FOR ALL COSTS INCURRED BY SAWS, INCLUDING ANY FINES FROM EPA, TCEQ AND/OR ANY OTHER FEDERAL, STATE OR LOCAL AGENCIES

NO SEPARATE MEASUREMENT OR PAYMENT SHALL BE MADE FOR THIS WORK. ALL WORK SHALL BE DONE ACCORDING TO GUIDELINES SET BY THE TCEQ AND SAWS.

- 2. IF BYPASS PUMPING IS REQUIRED, THE CONTRACTOR SHALL PERFORM SUCH WORK IN ACCORDANCE WITH SAWS STANDARD SPECIFICATION FOR WATER AND SANITARY
- SEWER CONSTRUCTION, ITEM NO. 864, "BYPASS PUMPING" PRIOR TO TIE-INS. ANY SHUTDOWNS OF EXISTING FORCE MAINS OF ANY SIZE MUST BE COORDINATED WITH THE SAWS CONSTRUCTION INSPECTION DIVISION AT (210) 233-2973 AT LEAST ONE WEEK IN ADVANCE OF THE SHUTDOWN. THE CONTRACTOR MUST ALSO PROVIDE A SEQUENCE OF WORK AS RELATED TO THE TIE-INS; THIS IS AT NO ADDITIONAL COST TO SAWS OR THE PROJECT AND IT IS THE RESPONSIBILITY OF THE CONTRACTOR
- TO SEQUENCE THE WORK ACCORDINGLY. 4. SEWER PIPE WHERE WATER LINE CROSSES SHALL BE 160 PSI AND MEET THE REQUIREMENTS OF ASTM D2241, TAC 217.53 AND TCEQ 290.44(E)(4)(B). CONTRACTOR SHALL CENTER A 20' JOINT OF 160 PSI PRESSURE RATED PVC AT THE PROPOSED WATER
- 5. ELEVATIONS POSTED FOR TOP OF MANHOLES ARE FOR REFERENCE ONLY: IT SHALL BE THE RESPONSIBILITY OF THE CONTRACTOR TO MAKE ALLOWANCES AND ADJUSTMENTS FOR TOP OF MANHOLES TO MATCH THE FINISHED GRADE OF THE PROJECT'S 6. SPILLS, OVERFLOWS, OR DISCHARGES OF WASTEWATER: ALL SPILLS, OVERFLOWS, OR
- DISCHARGES OF WASTEWATER, RECYCLED WATER, PETROLEUM PRODUCTS, OR CHEMICALS MUST BE REPORTED IMMEDIATELY TO THE SAWS INSPECTOR ASSIGNED TO THE COUNTER PERMIT OR GENERAL CONSTRUCTION PERMIT (GCP). THIS REQUIREMENT APPLIES TO EVERY SPILL, OVERFLOW, OR DISCHARGE REGARDLESS OF SIZE. MANHOLE AND ALL PIPE TESTING (INCLUDING THE TV INSPECTION) MUST BE PERFORMED
- AND PASSED PRIOR TO FINAL FIELD ACCEPTANCE BY SAWS CONSTRUCTION INSPECTION DIVISION, AS PER THE SAWS SPECIFICATIONS FOR WATER AND SANITARY SEWER
- 8. ALL PVC PIPE OVER 14 FEET OF COVER SHALL BE EXTRA STRENGTH WITH MINIMUM PIPE STIFFNESS OF 115 PSI.

# TMM SOMERSET, UNIT 3A

# SAN ANTONIO, TX SANITARY SEWER IMPROVEMENTS



LOCATION MAP NOT-TO-SCALE

OWNER INFORMATION: KB HOMES 4800 FREDERICKSBURG RD. SAN ANTONIO, TX 78229 PHONE: (210) 301 - 5485

## Sheet List Table

SHEET NUMBER
6.0
6.1
6.2
6.3
6.4
6.5
6.6

DEVELOPER'S NAME: KB HOME LONESTAR INC.

CITY: SAN ANTONIO

PHONE#: (210) 301-5485

NUMBER OF LOTS: 78

DEVELOPER'S ADDRESS: 2800 FREDERICKSBURG ROAD

SAWS BLOCK MAP#: 126530, 126532, 128530, 128532

TOTAL LINEAR FOOTAGE OF PIPE: 2,651 L.F. ~ 8" SDR 26

STATE: TEXAS

SAWS JOB#: 23-1605

Engineering & Design

www.colliersengineering.com


pyright © 2025. Colliers Engineering & Design All Rights Reserved. This drav hom the services were contracted or to whom it is certified. This drawing ma

e copied, reused, disclosed, distributed or relied upon for any other pur without the express written consent of Colliers Engineering & Design



ALL STATES REQUIRE NOTIFICATION C EXCAVATORS, DESIGNERS, OR ANY PERS PREPARING TO DISTURB THE EARTH'S SURFACE ANYWHERE IN ANY STATE

FOR STATE SPECIFIC DIRECT PHONE NUMBERS VISIT: WWW.CALL811.COM

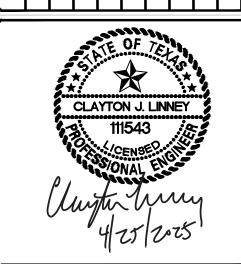

LICENSE NUMBER: 111543 COLLIERS ENGINEERING & DESIGN, INC. BPE Firm#: F-14909 - TBPLS Firm#: 1019455

TMM SOMERSET, UNIT 3A PLAT# 23-11800289

**KB HOME** 

CITY OF SAN ANTONIO BEXAR COUNTY

TEXAS

Engineering & Design

AS SHOWN

ZIP: 78229

PLAT NO.: 23-11800289


TOTAL ACREAGE: 11.68 AC.

TOTAL EDU'S: 78

SAN ANTONIO (KFW) 3421 Paesanos San Antonio, TX 78231 Phone: 210.979.8444 TBPLS Firm#: 10194550

VSS4181407 418-14-07

SANITARY SEWER COVER SHEET

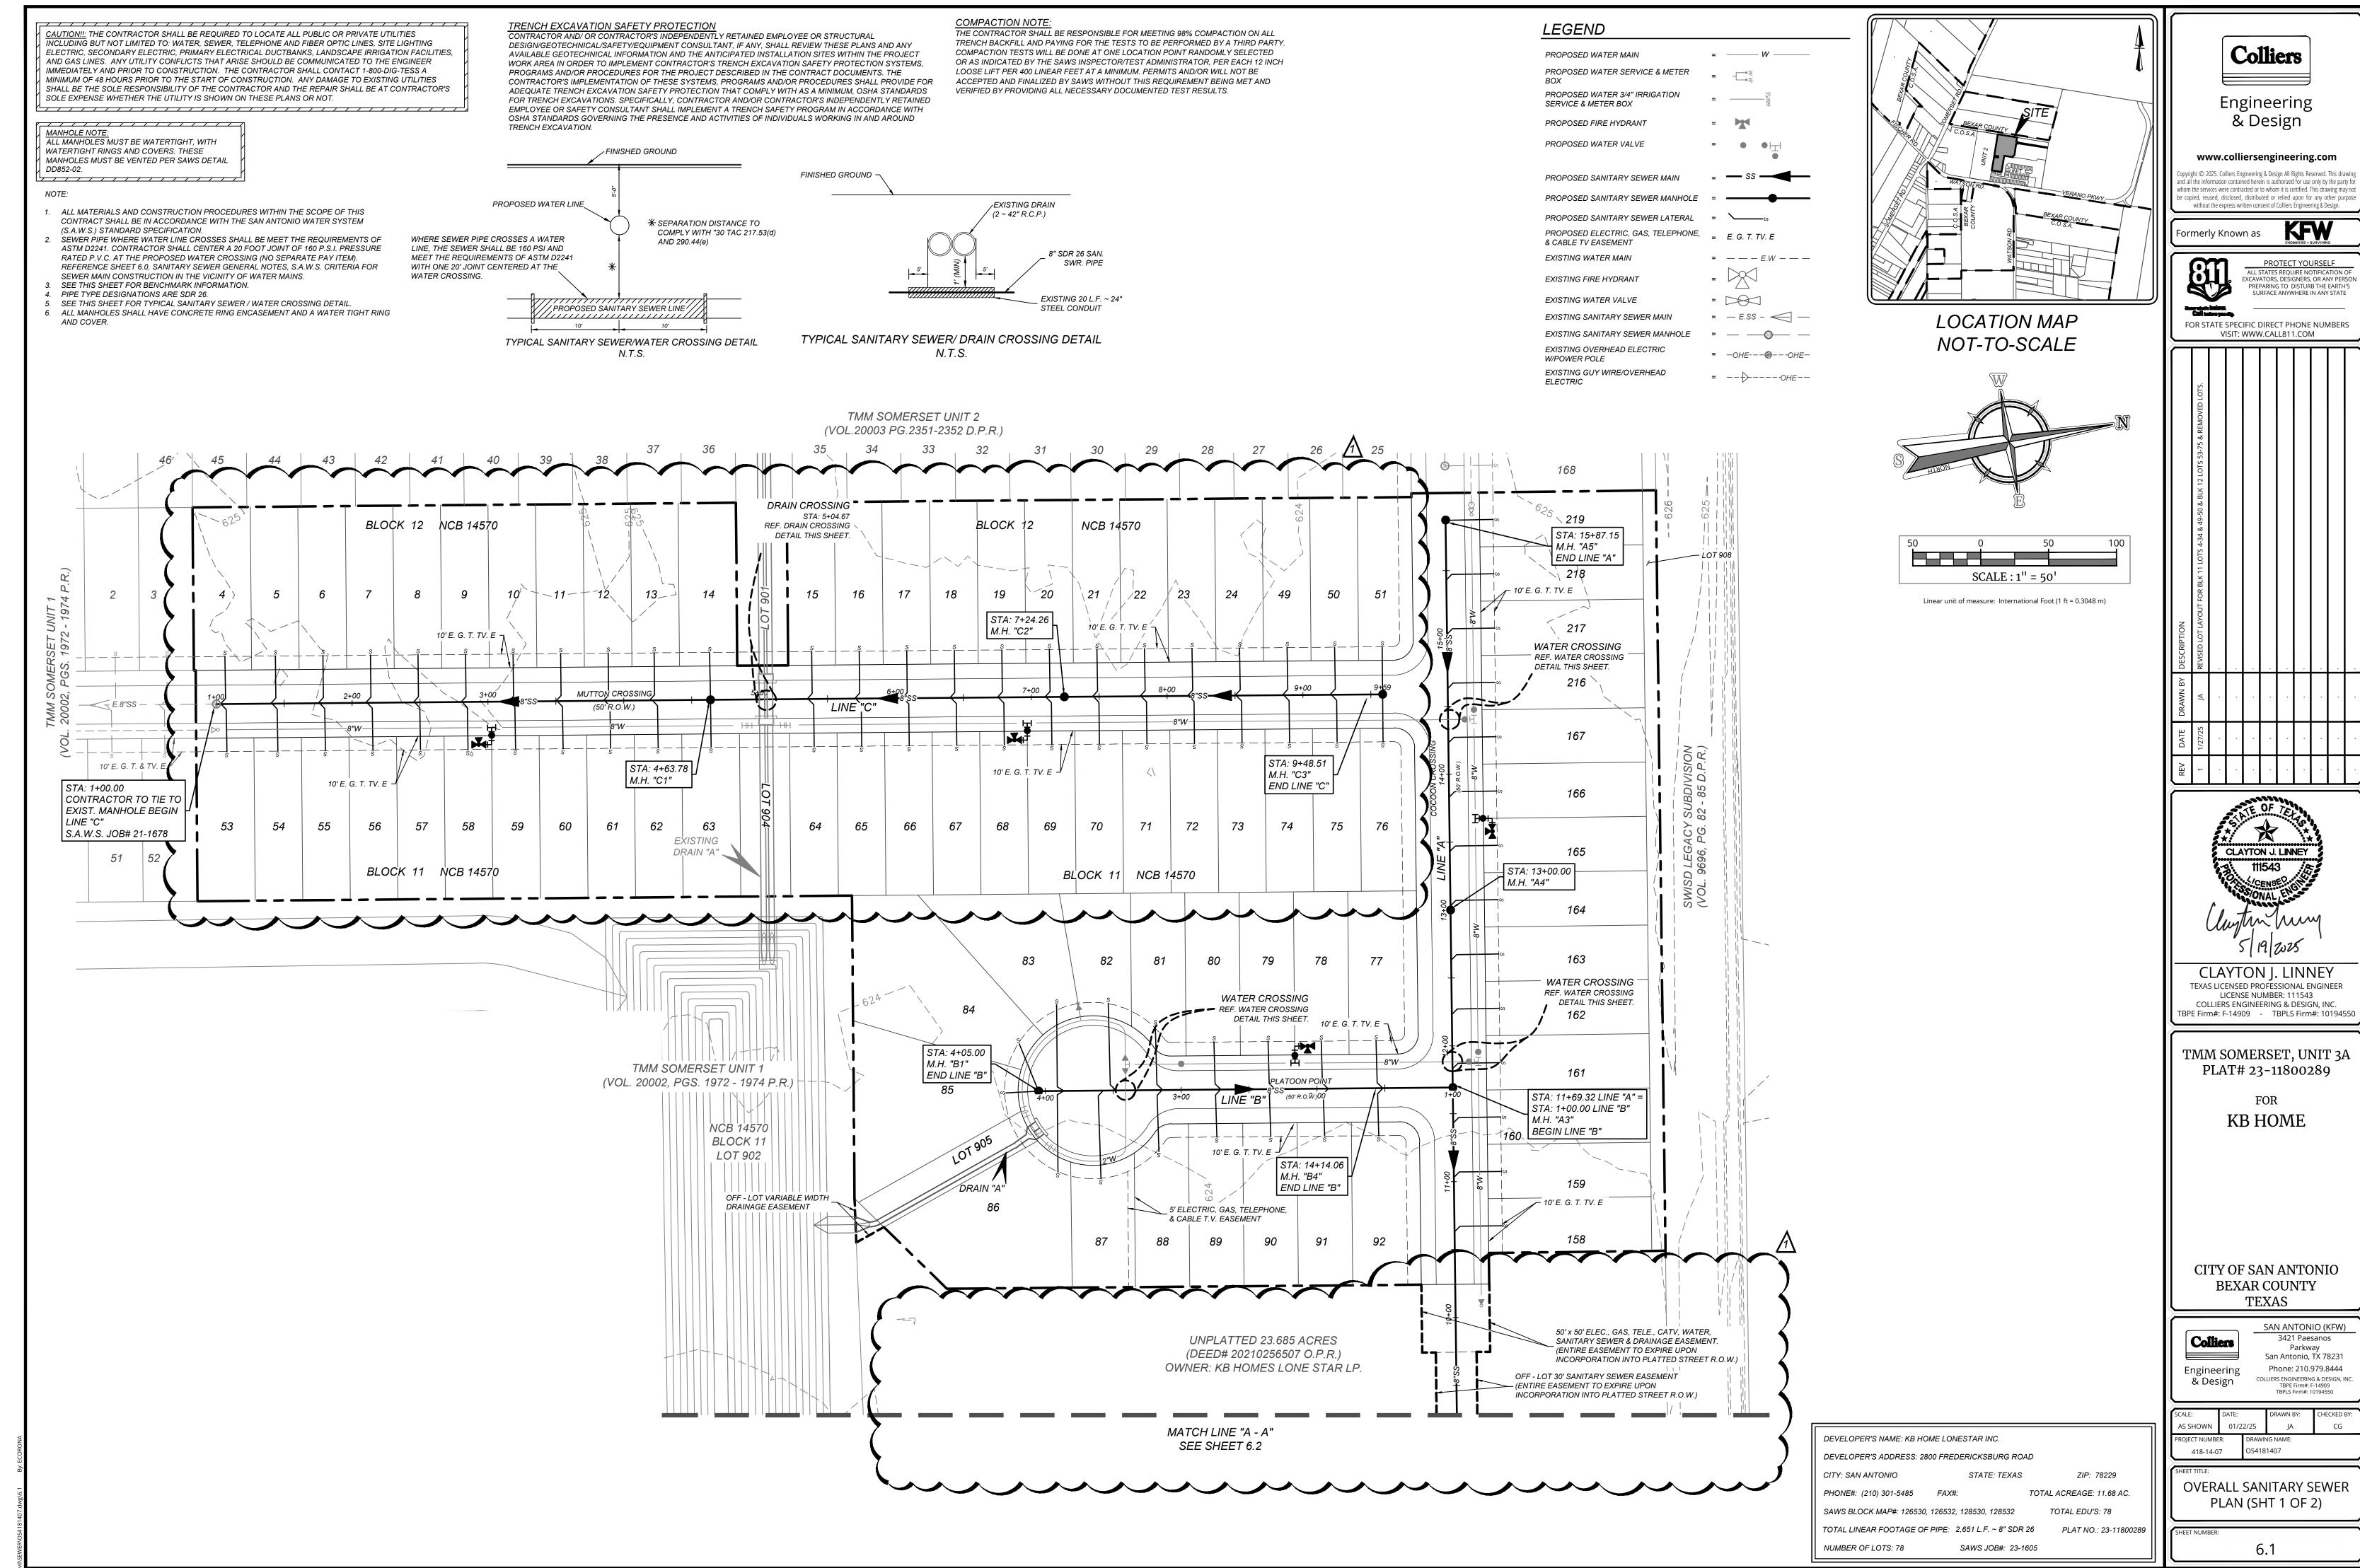


CAUTION!!: THE CONTRACTOR SHALL BE REQUIRED TO LOCATE ALL PUBLIC OR PRIVATE UTILITIES INCLUDING BUT NOT LIMITED TO: WATER. SEWER. TELEPHONE AND FIBER OPTIC LINES. SITE LIGHTING ELECTRIC, SECONDARY ELECTRIC, PRIMARY ELECTRICAL DUCTBANKS, LANDSCAPE IRRIGATION FACILITIES, AND GAS LINES. ANY UTILITY CONFLICTS THAT ARISE SHOULD BE COMMUNICATED TO THE ENGINEER IMMEDIATELY AND PRIOR TO CONSTRUCTION. THE CONTRACTOR SHALL CONTACT 1-800-DIG-TESS A MINIMUM OF 48 HOURS PRIOR TO THE START OF CONSTRUCTION. ANY DAMAGE TO EXISTING UTILITIES SHALL BE THE SOLE RESPONSIBILITY OF THE CONTRACTOR AND THE REPAIR SHALL BE AT CONTRACTOR'S SOLE EXPENSE WHETHER THE UTILITY IS SHOWN ON THESE PLANS OR NOT.

MANHOLE NOTE:
ALL MANHOLES MUST BE WATERTIGHT, WITH WATERTIGHT RINGS AND COVERS. THESE MANHOLES MUST BE VENTED PER SAWS DETAIL

- 1. ALL MATERIALS AND CONSTRUCTION PROCEDURES WITHIN THE SCOPE OF THIS CONTRACT SHALL BE IN ACCORDANCE WITH THE SAN ANTONIO WATER SYSTEM (S.A.W.S.) STANDARD SPECIFICATION.
- SEWER PIPE WHERE WATER LINE CROSSES SHALL BE MEET THE REQUIREMENTS OF ASTM D2241. CONTRACTOR SHALL CENTER A 20 FOOT JOINT OF 160 P.S.I. PRESSURE RATED P.V.C. AT THE PROPOSED WATER CROSSING (NO SEPARATE PAY ITEM). REFERENCE SHEET 6.0, SANITARY SEWER GENERAL NOTES, S.A.W.S. CRITERIA FOR SEWER MAIN CONSTRUCTION IN THE VICINITY OF WATER MAINS.
- SEE THIS SHEET FOR BENCHMARK INFORMATION.
- 4. PIPE TYPE DESIGNATIONS ARE SDR 26. 5. SEE THIS SHEET FOR TYPICAL SANITARY SEWER / WATER CROSSING DETAIL.
- 6. ALL MANHOLES SHALL HAVE CONCRETE RING ENCASEMENT AND A WATER TIGHT RING

#### TRENCH EXCAVATION SAFETY PROTECTION

CONTRACTOR AND/ OR CONTRACTOR'S INDEPENDENTLY RETAINED EMPLOYEE OR STRUCTURAL DESIGN/GEOTECHNICAL/SAFETY/EQUIPMENT CONSULTANT, IF ANY, SHALL REVIEW THESE PLANS AND ANY AVAILABLE GEOTECHNICAL INFORMATION AND THE ANTICIPATED INSTALLATION SITES WITHIN THE PROJECT WORK AREA IN ORDER TO IMPLEMENT CONTRACTOR'S TRENCH EXCAVATION SAFETY PROTECTION SYSTEMS, PROGRAMS AND/OR PROCEDURES FOR THE PROJECT DESCRIBED IN THE CONTRACT DOCUMENTS. THE CONTRACTOR'S IMPLEMENTATION OF THESE SYSTEMS, PROGRAMS AND/OR PROCEDURES SHALL PROVIDE FOR ADEQUATE TRENCH EXCAVATION SAFETY PROTECTION THAT COMPLY WITH AS A MINIMUM, OSHA STANDARDS FOR TRENCH EXCAVATIONS. SPECIFICALLY, CONTRACTOR AND/OR CONTRACTOR'S INDEPENDENTLY RETAINED EMPLOYEE OR SAFETY CONSULTANT SHALL IMPLEMENT A TRENCH SAFETY PROGRAM IN ACCORDANCE WITH OSHA STANDARDS GOVERNING THE PRESENCE AND ACTIVITIES OF INDIVIDUALS WORKING IN AND AROUND TRENCH EXCAVATION.

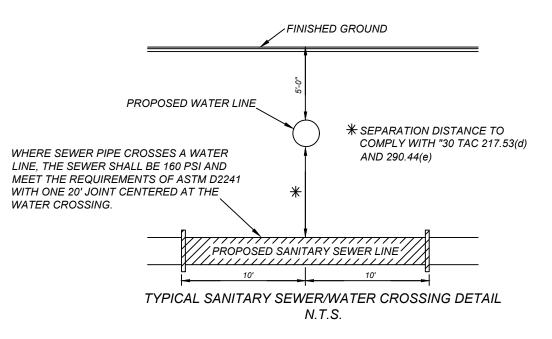

THE CONTRACTOR SHALL BE RESPONSIBLE FOR MEETING 98% COMPACTION ON ALL TRENCH BACKFILL AND PAYING FOR THE TESTS TO BE PERFORMED BY A THIRD PARTY. COMPACTION TESTS WILL BE DONE AT ONE LOCATION POINT RANDOMLY SELECTED OR AS INDICATED BY THE SAWS INSPECTOR/TEST ADMINISTRATOR, PER EACH 12 INCH LOOSE LIFT PER 400 LINEAR FEET AT A MINIMUM. PERMITS AND/OR WILL NOT BE ACCEPTED AND FINALIZED BY SAWS WITHOUT THIS REQUIREMENT BEING MET AND VERIFIED BY PROVIDING ALL NECESSARY DOCUMENTED TEST RESULTS.

#### LEGEND

PROPOSED WATER MAIN = ----- W ------PROPOSED WATER SERVICE & METER PROPOSED WATER 3/4" IRRIGATION SERVICE & METER BOX PROPOSED FIRE HYDRANT PROPOSED WATER VALVE **=** ● ● | | PROPOSED SANITARY SEWER MAIN PROPOSED SANITARY SEWER MANHOLE PROPOSED ELECTRIC, GAS, TELEPHONE, = E. G. T. TV. E & CABLE TV EASEMENT = ----E.W ----

EXISTING WATER MAIN EXISTING FIRE HYDRANT = 🖂 EXISTING WATER VALVE =  $-E.SS - \bigcirc$  -EXISTING SANITARY SEWER MAIN

= -OHE---⊗---OHE-


= — — — — EXISTING OVERHEAD ELECTRIC W/POWER POLE EXISTING GUY WIRE/OVERHEAD

EXISTING SANITARY SEWER MANHOLE




LOCATION MAP NOT-TO-SCALE

Linear unit of measure: International Foot (1 ft = 0.3048 m)

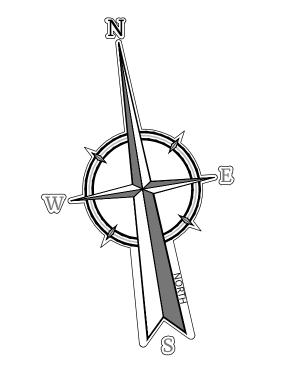

SCALE: 1" = 50'

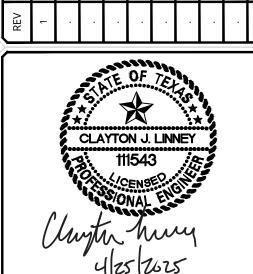

**Colliers** 

Engineering

& Design

www.colliersengineering.com

pyright © 2025. Colliers Engineering & Design All Rights Reserved. This drawin whom the services were contracted or to whom it is certified. This drawing may

be copied, reused, disclosed, distributed or relied upon for any other purp

without the express written consent of Colliers Engineering & Design.

FOR STATE SPECIFIC DIRECT PHONE NUMBERS

VISIT: WWW.CALL811.COM

ALL STATES REQUIRE NOTIFICATION OF EXCAVATORS, DESIGNERS, OR ANY PERSON

PREPARING TO DISTURB THE EARTH'S SURFACE ANYWHERE IN ANY STATE

Formerly Known as

CLAYTON J. LINNEY TEXAS LICENSED PROFESSIONAL ENGINEER LICENSE NUMBER: 111543 COLLIERS ENGINEERING & DESIGN, INC. BPE Firm#: F-14909 - TBPLS Firm#: 1019455

TMM SOMERSET, UNIT 3A PLAT# 23-11800289

> FOR **KB HOME**


CITY OF SAN ANTONIO BEXAR COUNTY **TEXAS** 

Colliers Engineering & Design

SAN ANTONIO (KFW) 3421 Paesanos Parkway San Antonio, TX 78231 Phone: 210.979.8444 COLLIERS ENGINEERING & DESIGN, INC TBPLS Firm#: 10194550

OS4181407

**OVERALL SANITARY SEWER** PLAN (SHT 2 OF 2)

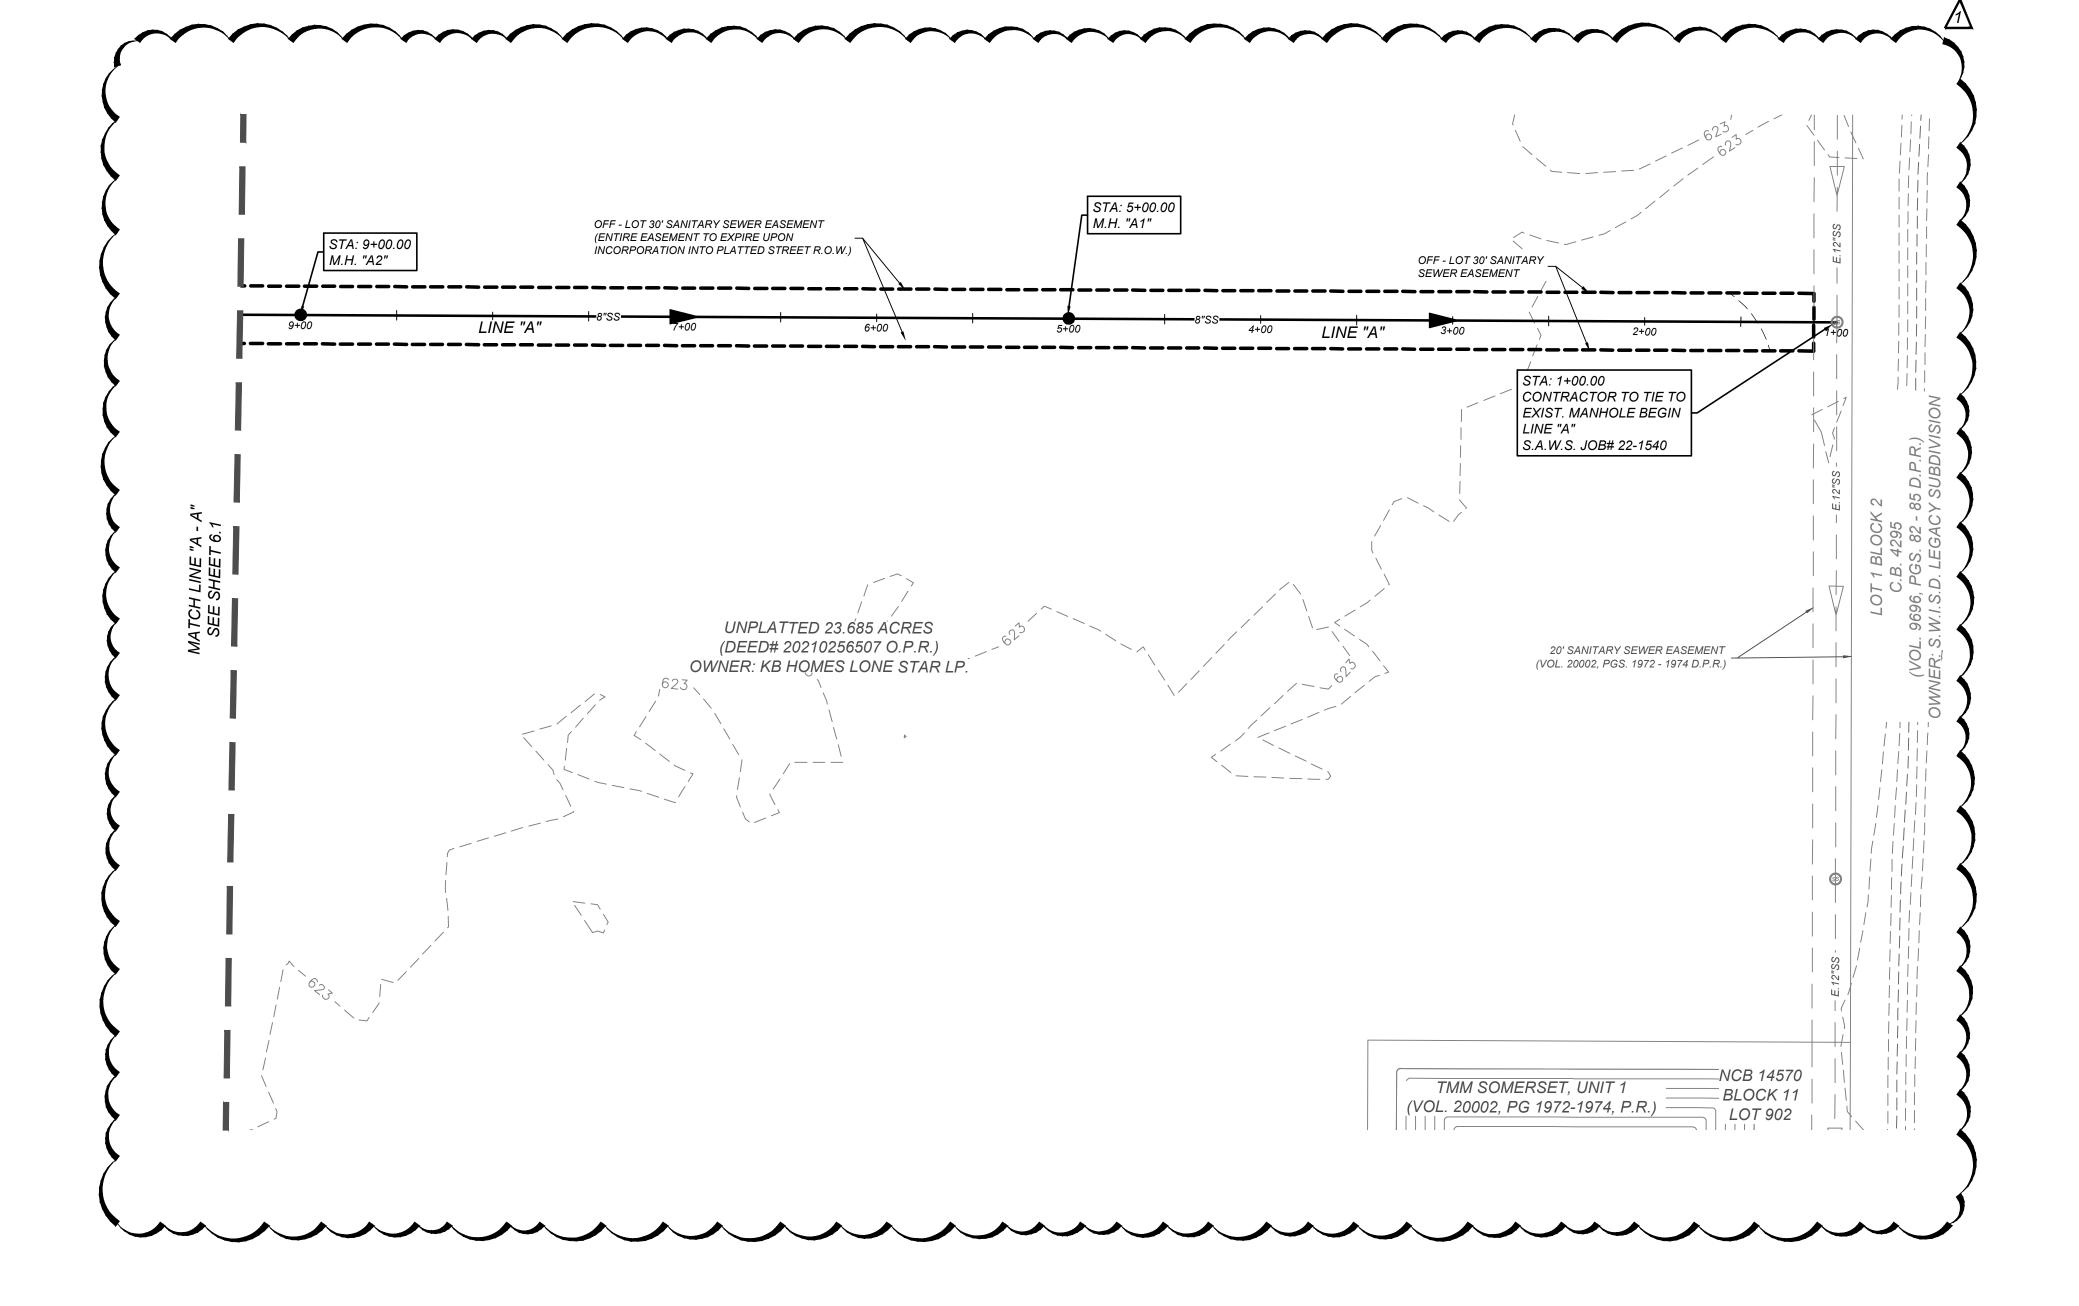



DEVELOPER'S NAME: KB HOME LONESTAR INC. DEVELOPER'S ADDRESS: 2800 FREDERICKSBURG ROAD

NUMBER OF LOTS: 78

CITY: SAN ANTONIO STATE: TEXAS ZIP: 78229 PHONE#: (210) 301-5485 FAX#: TOTAL ACREAGE: 11.68 AC. SAWS BLOCK MAP#: 126530, 126532, 128530, 128532 TOTAL EDU'S: 78 TOTAL LINEAR FOOTAGE OF PIPE: 2,651 L.F. ~ 8" SDR 26 PLAT NO.: 23-11800289

SAWS JOB#: 23-1605

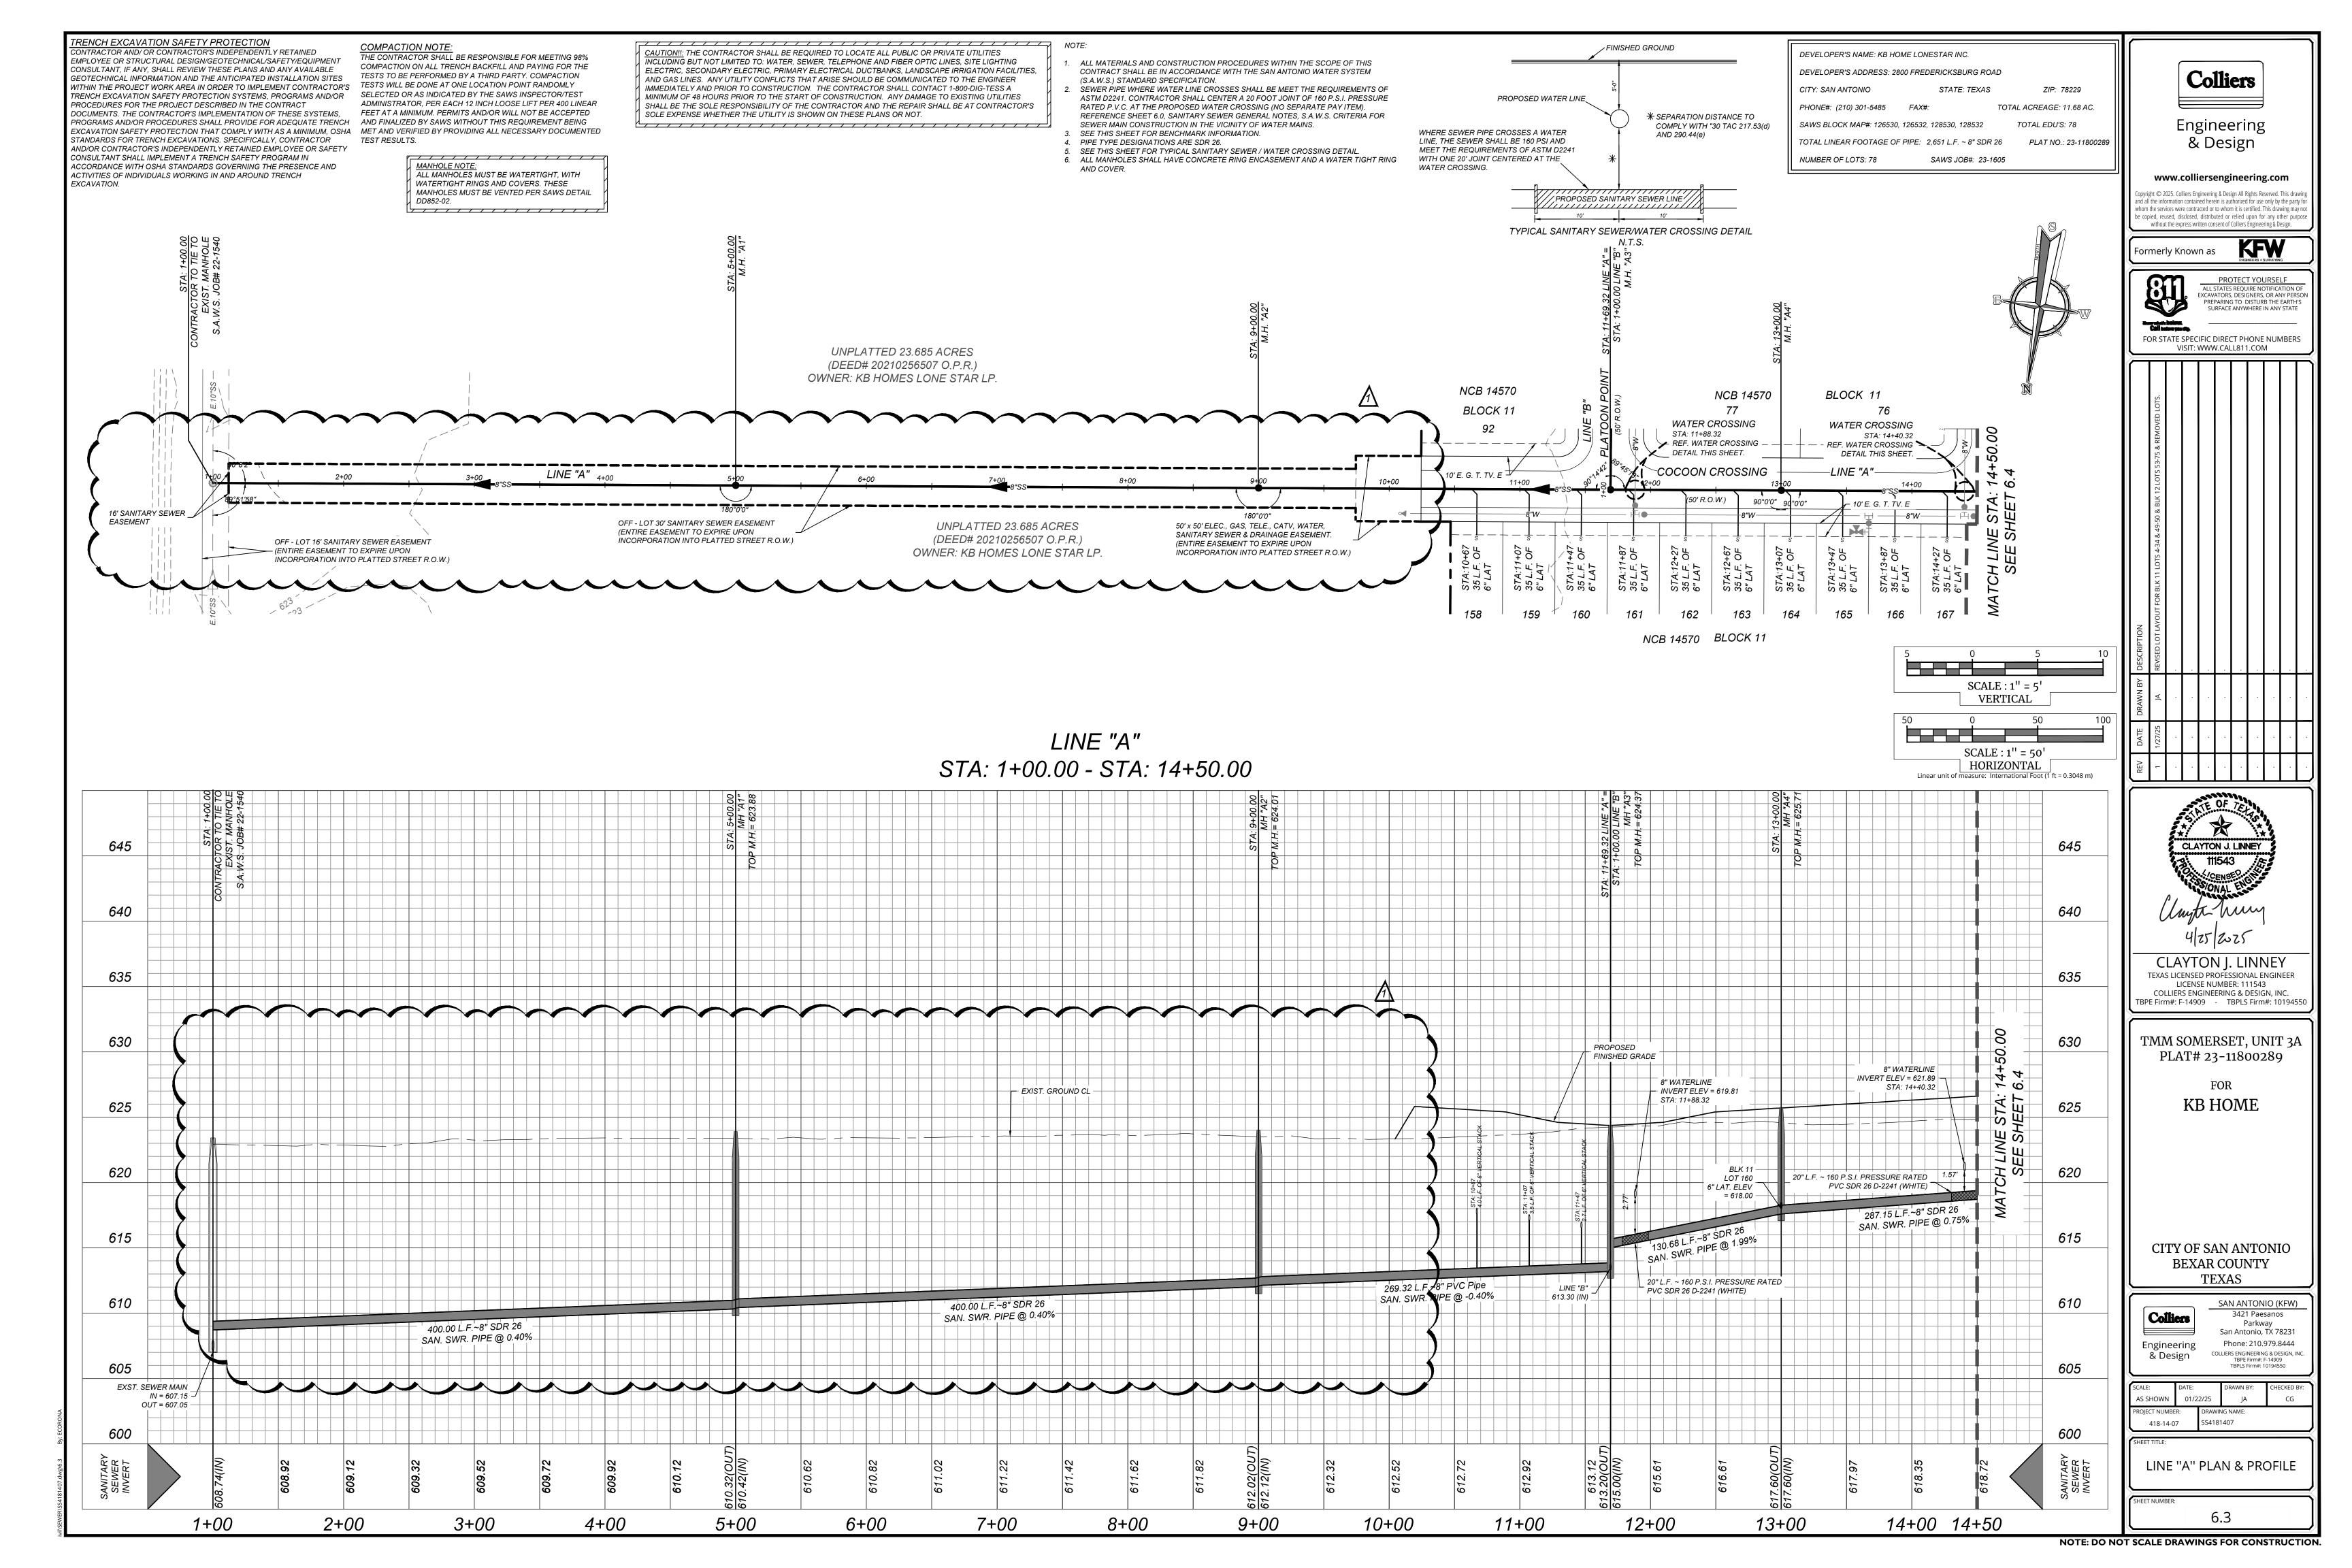

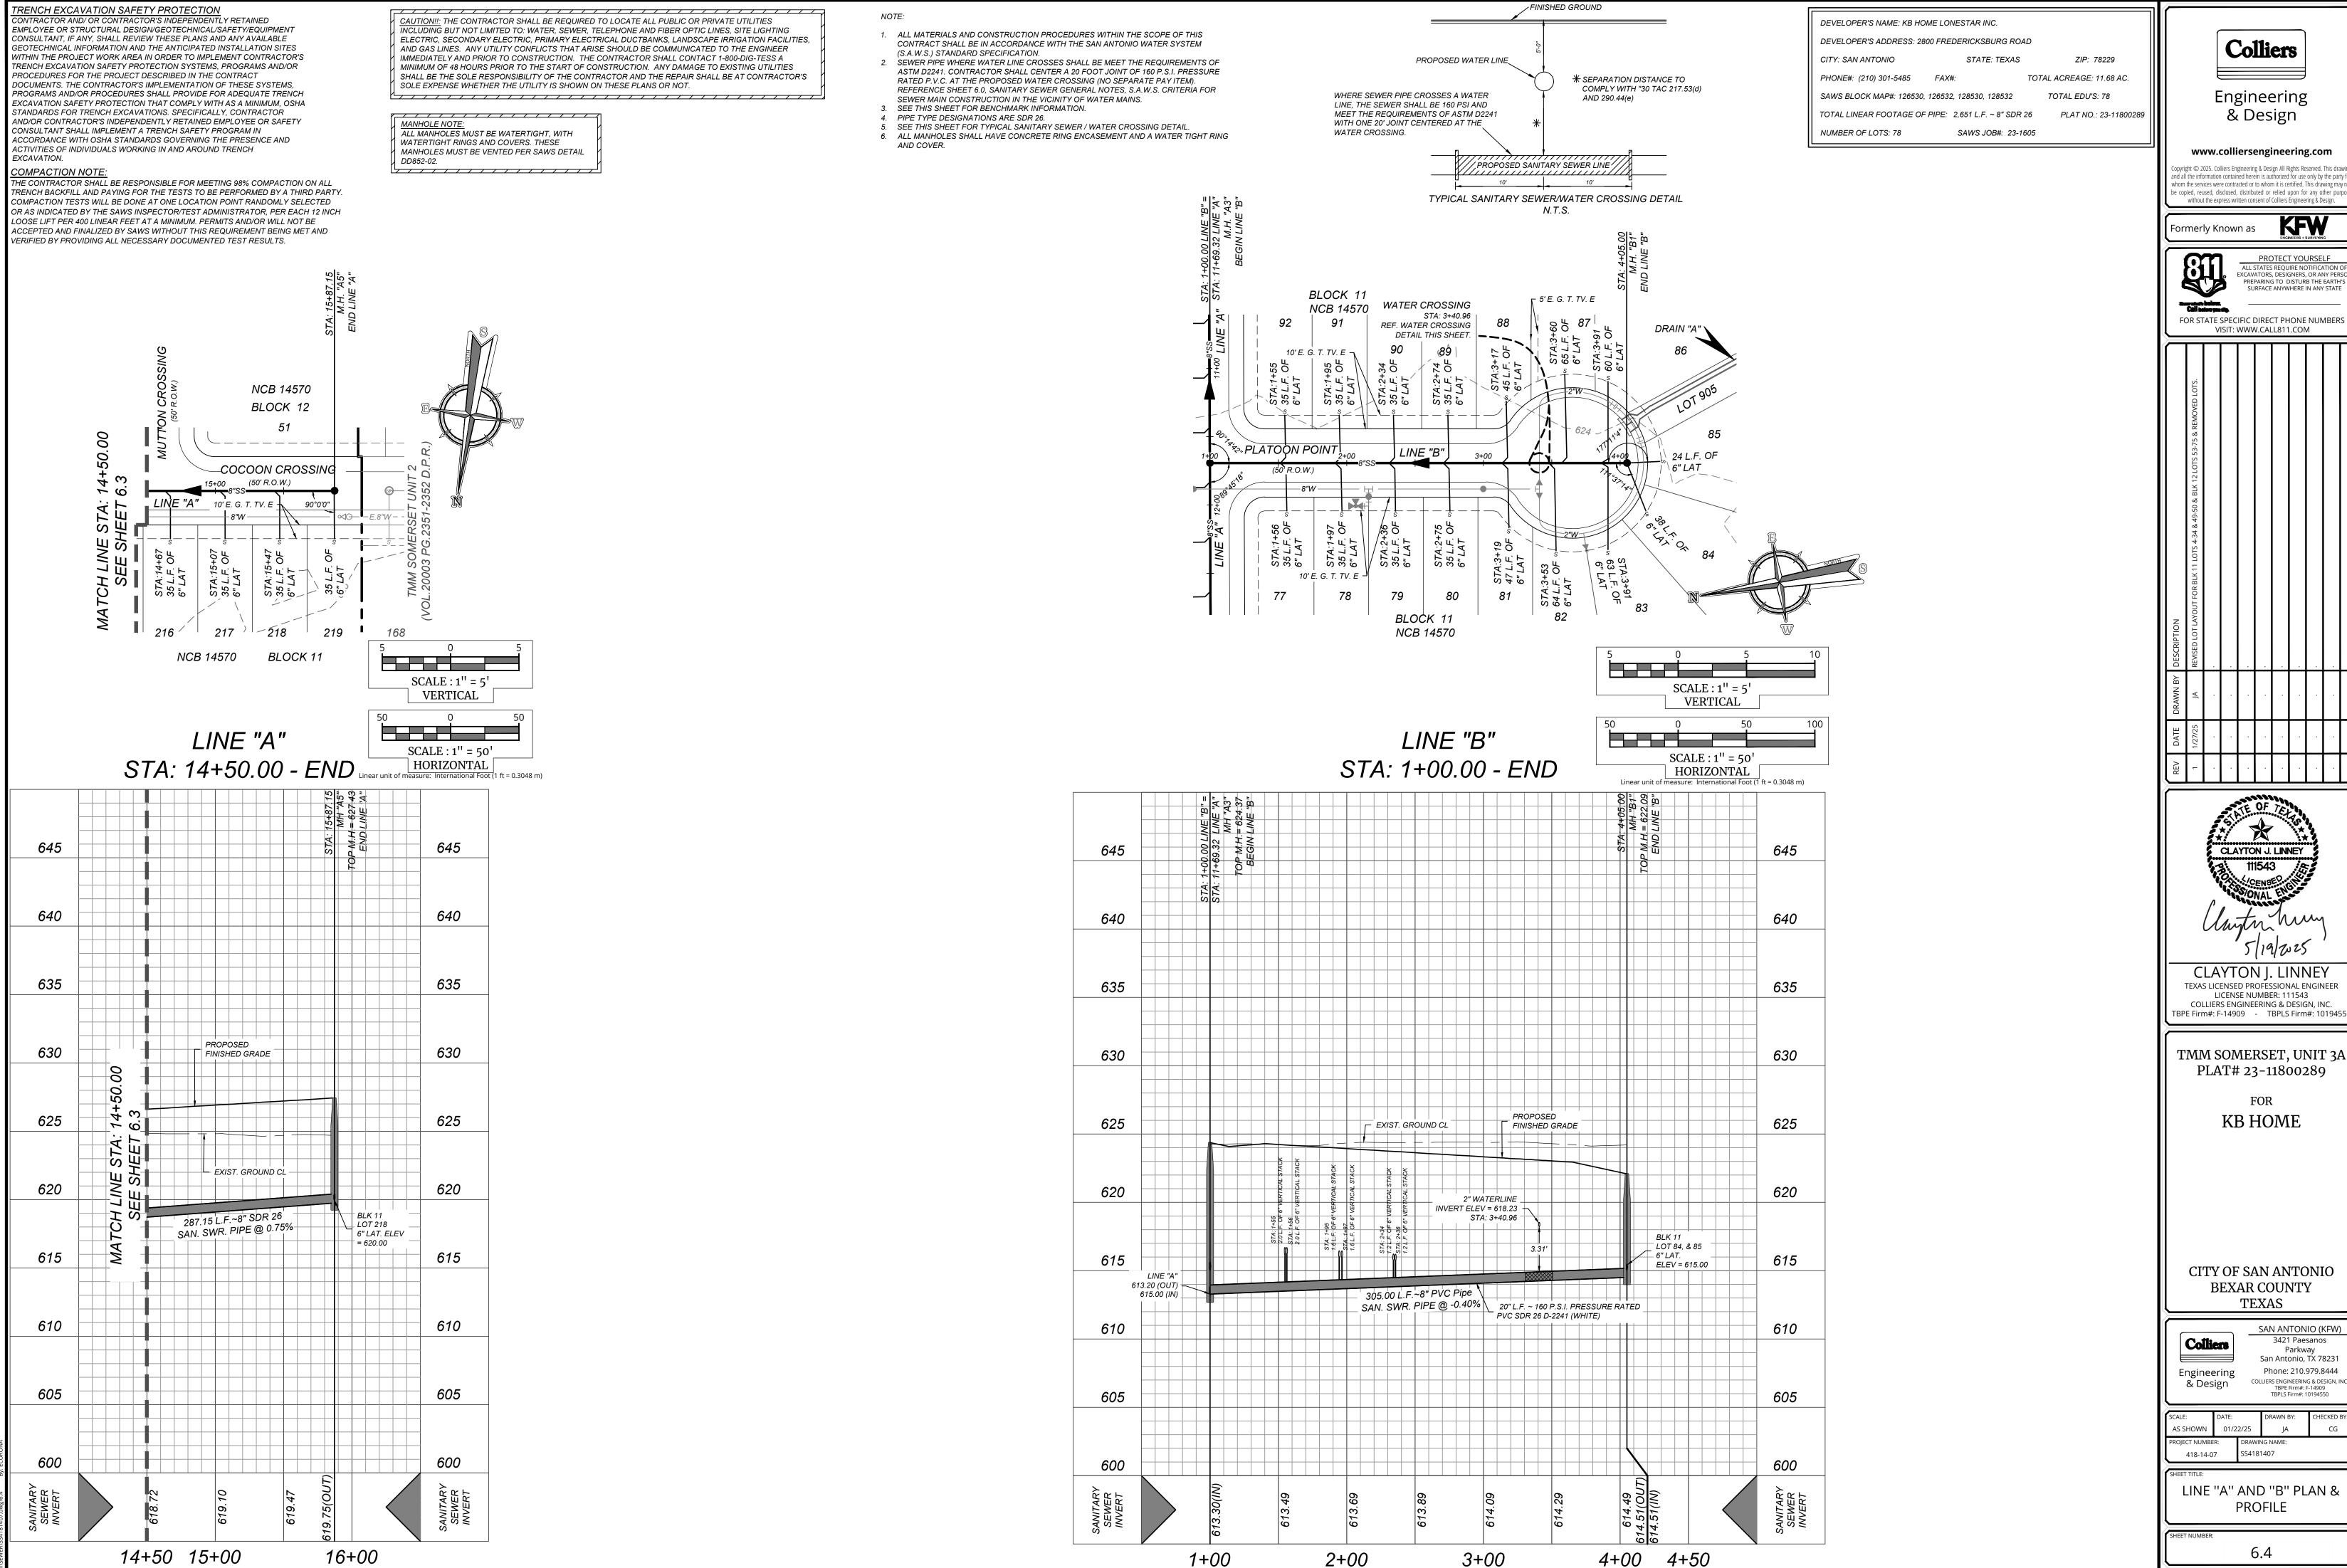

RENCH EXCAVATION SAFETY PROTECTION CONTRACTOR AND/ OR CONTRACTOR'S INDEPENDENTLY RETAINED EMPLOYEE OR STRUCTURAL DESIGN/GEOTECHNICAL/SAFETY/EQUIPMENT CONSULTANT, IF ANY, SHALL REVIEW THESE PLANS AND ANY AVAILABLE GEOTECHNICAL INFORMATION AND THE ANTICIPATED INSTALLATION SITES VITHIN THE PROJECT WORK AREA IN ORDER TO IMPLEMENT CONTRACTOR'S TRENCH EXCAVATION SAFETY PROTECTION SYSTEMS, PROGRAMS AND/OR PROCEDURES FOR THE PROJECT DESCRIBED IN THE CONTRACT DOCUMENTS. THE CONTRACTOR'S IMPLEMENTATION OF THESE SYSTEMS PROGRAMS AND/OR PROCEDURES SHALL PROVIDE FOR ADEQUATE TRENCH EXCAVATION SAFETY PROTECTION THAT COMPLY WITH AS A MINIMUM, OSHA STANDARDS FOR TRENCH EXCAVATIONS, SPECIFICALLY, CONTRACTOR AND/OR CONTRACTOR'S INDEPENDENTLY RETAINED EMPLOYEE OR SAFETY CONSULTANT SHALL IMPLEMENT A TRENCH SAFETY PROGRAM IN ACCORDANCE WITH OSHA STANDARDS GOVERNING THE PRESENCE AND ACTIVITIES OF INDIVIDUALS WORKING IN AND AROUND TRENCH EXCAVATION. HE CONTRACTOR SHALL BE RESPONSIBLE FOR MEETING 98% COMPACTION ON ALL TRENCH BACKFILL AND PAYING FOR THE TESTS TO BE PERFORMED BY A THIRD PARTY. COMPACTION TESTS WILL BE DONE AT ONE LOCATION POINT RANDOMLY SELECTED OR AS INDICATED BY THE SAWS INSPECTOR/TEST ADMINISTRATOR, PER EACH 12 INCH LOOSE LIFT PER 400 LINEAR FEET AT A MINIMUM. PERMITS AND/OR WILL NOT BE ACCEPTED AND FINALIZED BY SAWS WITHOUT THIS REQUIREMENT BEING MET AND VERIFIED BY PROVIDING ALL NECESSARY DOCUMENTED TEST RESULTS. FINISHED GROUND -

ALL MANHOLES MUST BE WATERTIGHT, WITH WATERTIGHT RINGS AND COVERS. THESE MANHOLES MUST BE VENTED PER SAWS DETAIL 

CAUTION!!: THE CONTRACTOR SHALL BE REQUIRED TO LOCATE ALL PUBLIC OR PRIVATE UTILITIES

INCLUDING BUT NOT LIMITED TO: WATER, SEWER, TELEPHONE AND FIBER OPTIC LINES, SITE LIGHTING

AND GAS LINES. ANY UTILITY CONFLICTS THAT ARISE SHOULD BE COMMUNICATED TO THE ENGINEER

IMMEDIATELY AND PRIOR TO CONSTRUCTION. THE CONTRACTOR SHALL CONTACT 1-800-DIG-TESS A

SOLE EXPENSE WHETHER THE UTILITY IS SHOWN ON THESE PLANS OR NOT.

MINIMUM OF 48 HOURS PRIOR TO THE START OF CONSTRUCTION. ANY DAMAGE TO EXISTING UTILITIES

SHALL BE THE SOLE RESPONSIBILITY OF THE CONTRACTOR AND THE REPAIR SHALL BE AT CONTRACTOR'S

ELECTRIC, SECONDARY ELECTRIC, PRIMARY ELECTRICAL DUCTBANKS, LANDSCAPE IRRIGATION FACILITIES,

1. ALL MATERIALS AND CONSTRUCTION PROCEDURES WITHIN THE SCOPE OF THIS CONTRACT SHALL BE IN ACCORDANCE WITH THE SAN ANTONIO WATER SYSTEM (S.A.W.S.) STANDARD SPECIFICATION.

2. SEWER PIPE WHERE WATER LINE CROSSES SHALL BE MEET THE REQUIREMENTS OF ASTM D2241. CONTRACTOR SHALL CENTER A 20 FOOT JOINT OF 160 P.S.I. PRESSURE RATED P.V.C. AT THE PROPOSED WATER CROSSING (NO SEPARATE PAY ITEM). REFERENCE SHEET 6.0, SANITARY SEWER GENERAL NOTES, S.A.W.S. CRITERIA FOR SEWER MAIN CONSTRUCTION IN THE VICINITY OF WATER MAINS.

3. SEE THIS SHEET FOR BENCHMARK INFORMATION. 4. PIPE TYPE DESIGNATIONS ARE SDR 26. 5. SEE THIS SHEET FOR TYPICAL SANITARY SEWER / WATER CROSSING DETAIL.


6. ALL MANHOLES SHALL HAVE CONCRETE RING ENCASEMENT AND A WATER TIGHT RING


FINISHED GROUND DEVELOPER'S NAME: KB HOME LONESTAR INC. DEVELOPER'S ADDRESS: 2800 FREDERICKSBURG ROAD CITY: SAN ANTONIO STATE: TEXAS PROPOSED WATER LINE TOTAL ACREAGE: 11.68 AC. PHONE#: (210) 301-5485 FAX#: \* SEPARATION DISTANCE TO COMPLY WITH "30 TAC 217.53(d) SAWS BLOCK MAP#: 126530, 126532, 128530, 128532 WHERE SEWER PIPE CROSSES A WATER AND 290.44(e) LINE, THE SEWER SHALL BE 160 PSI AND TOTAL LINEAR FOOTAGE OF PIPE: 2,651 L.F. ~ 8" SDR 26 PLAT NO.: 23-11800289 MEET THE REQUIREMENTS OF ASTM D2241 WITH ONE 20' JOINT CENTERED AT THE NUMBER OF LOTS: 78 SAWS JOB#: 23-1605 WATER CROSSING.

//PROPOSED SANITARY SEWER LINE // TYPICAL SANITARY SEWER/WATER CROSSING DETAIL N.T.S.

EXISTING DRAIN (2 ~ 42" R.C.P.) 8" SDR 26 SAN. SWR. PIPE EXISTING 20 L.F. ~ 24" STEEL CONDUIT

TYPICAL SANITARY SEWER/ DRAIN CROSSING DETAIL N.T.S.

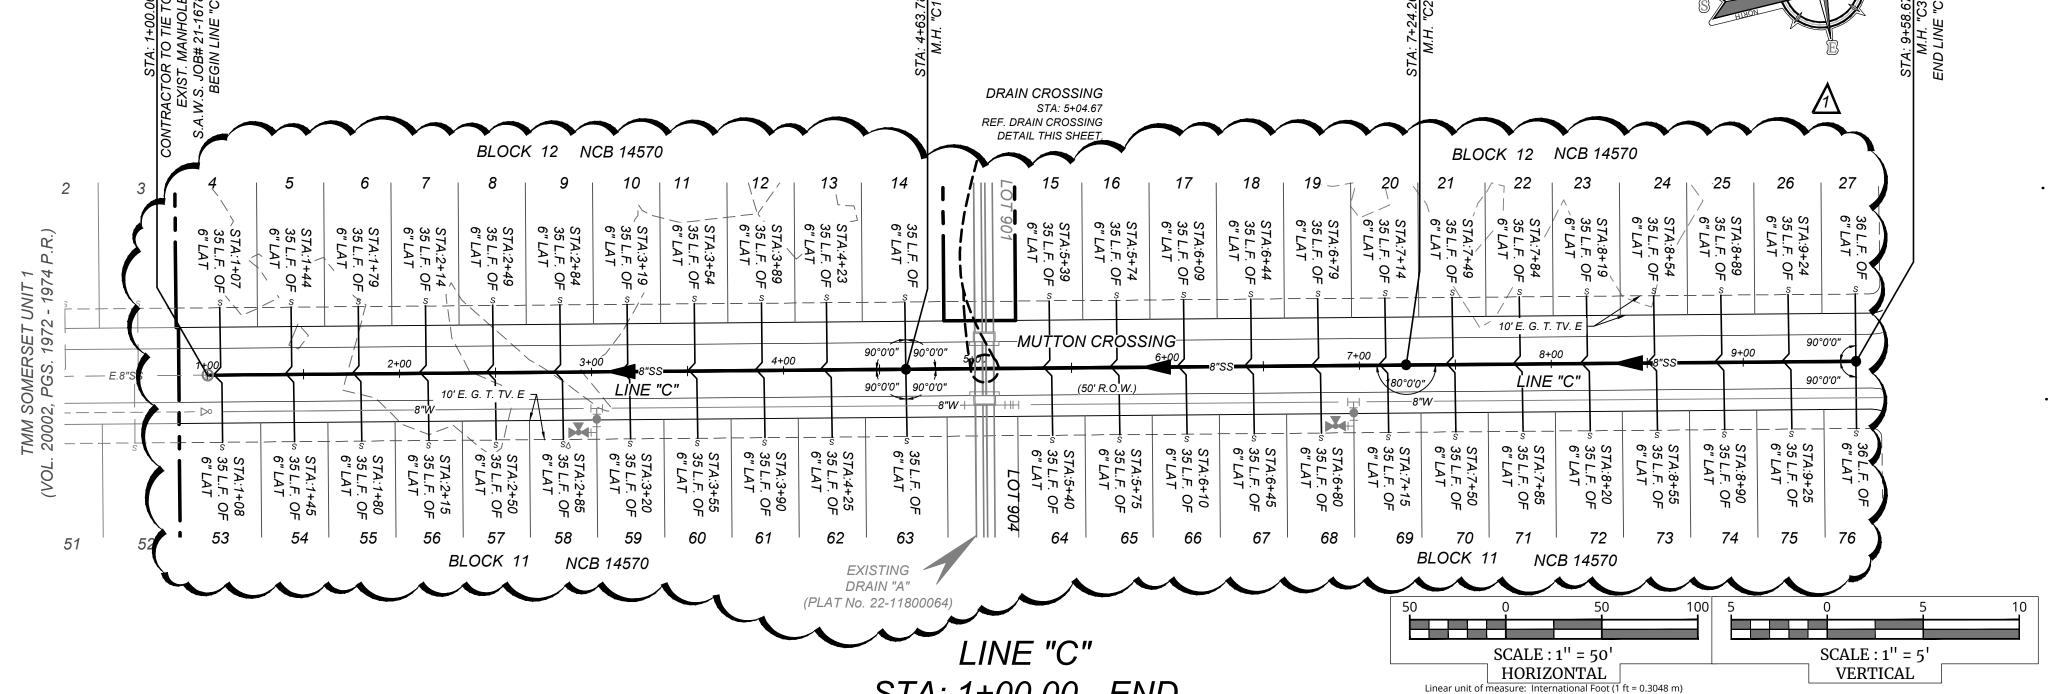

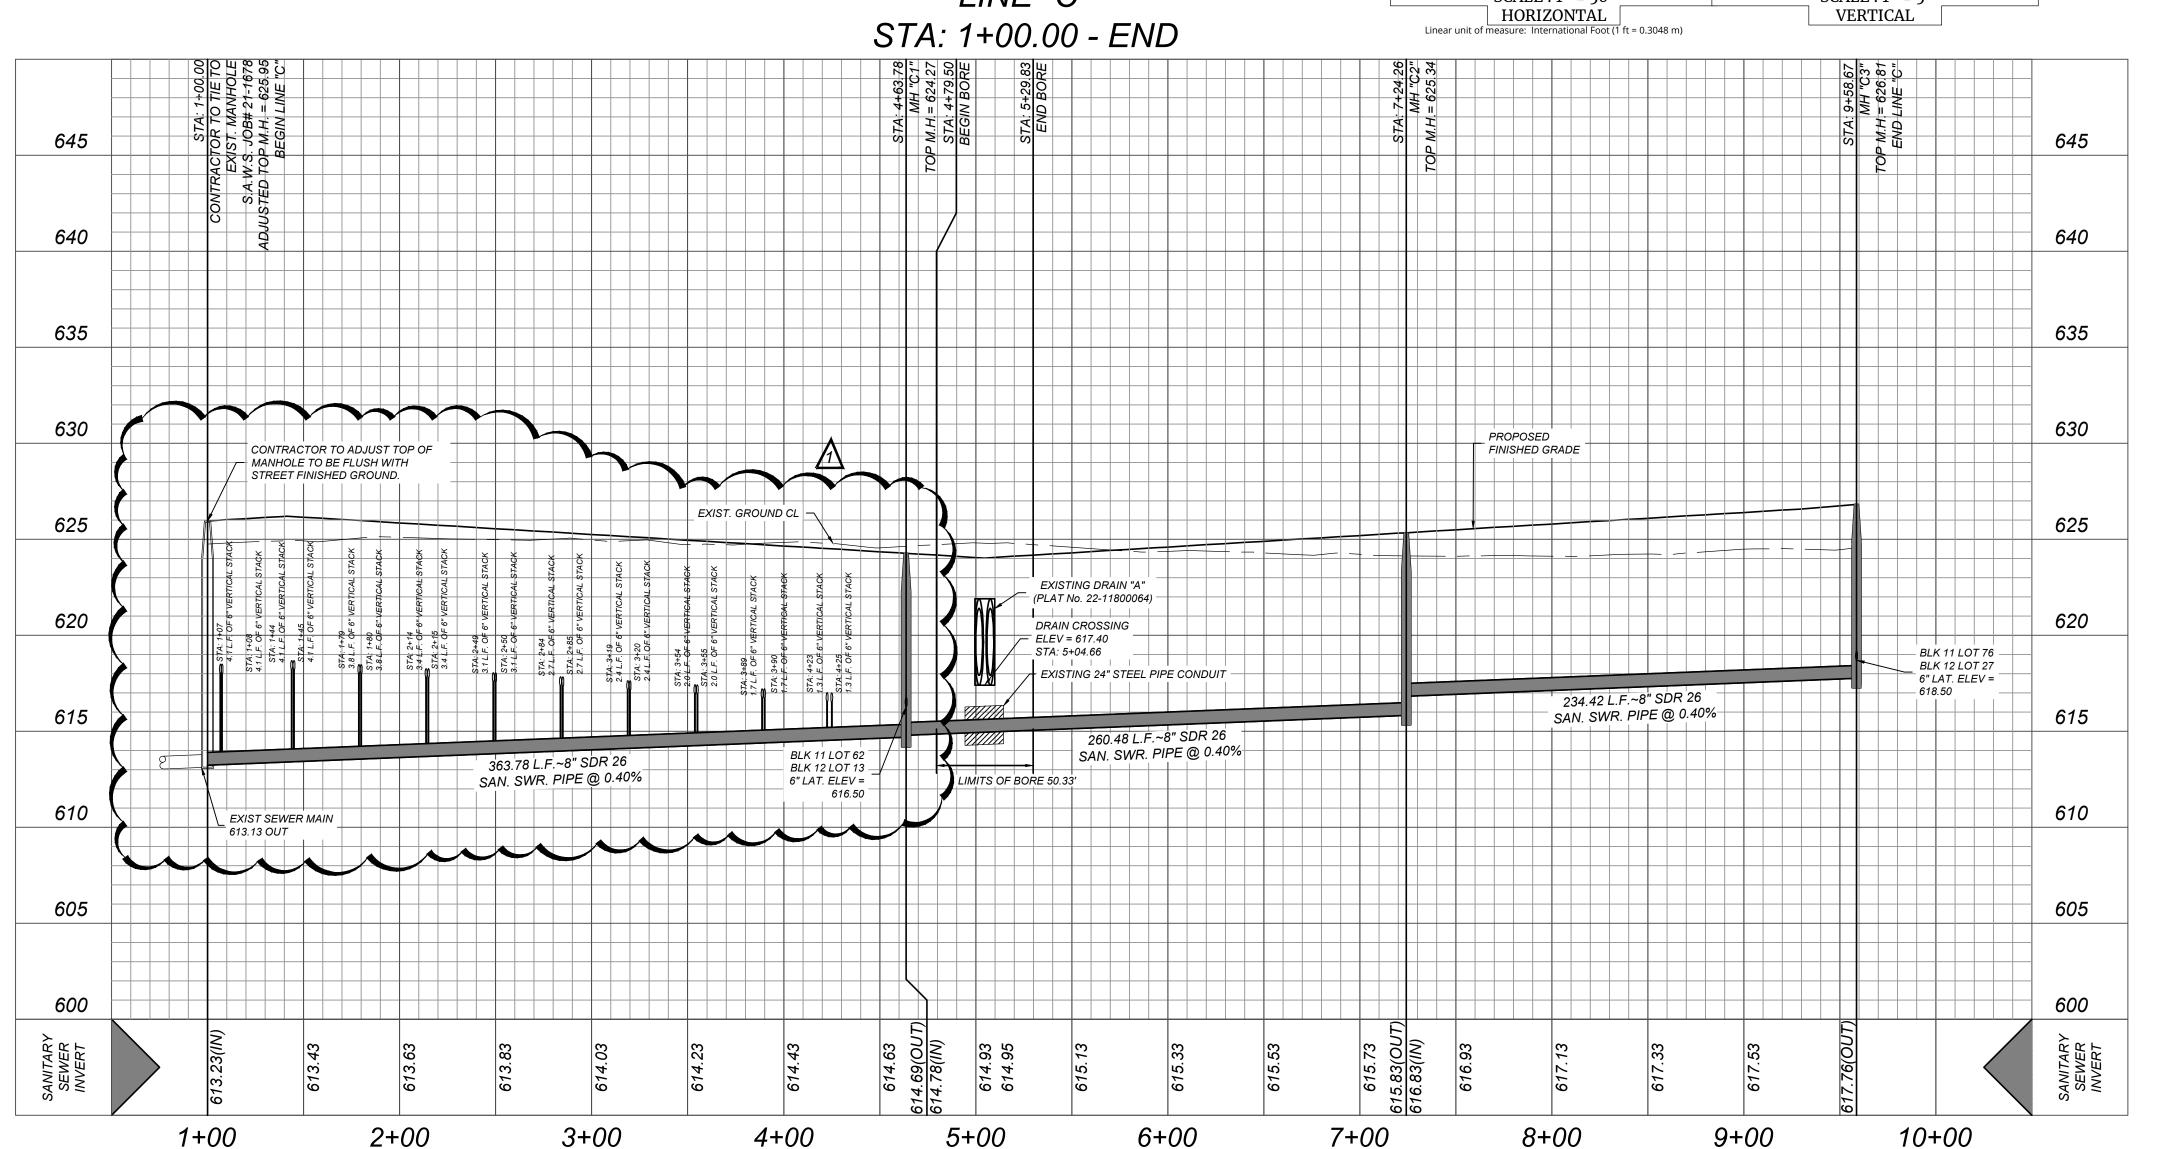



ZIP: 78229

TOTAL EDU'S: 78

Engineering & Design

www.colliersengineering.com


opyright © 2025. Colliers Engineering & Design All Rights Reserved. This draw whom the services were contracted or to whom it is certified. This drawing may be copied, reused, disclosed, distributed or relied upon for any other purp without the express written consent of Colliers Engineering & Design.

Formerly Known as



FOR STATE SPECIFIC DIRECT PHONE NUMBERS VISIT: WWW.CALL811.COM

DRAWN BY DESCRIPTION	REVISED LOT LAYOUT FOR BLK 11 LOTS 4-34 & 49-50 & BLK 12 LOTS 53-75 & REMOVED LOTS.					
DRAWN BY	Αĺ					
DATE	1/27/25					
REV	1					

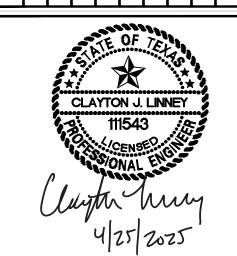

CLAYTON J. LINNEY TEXAS LICENSED PROFESSIONAL ENGINEER LICENSE NUMBER: 111543 COLLIERS ENGINEERING & DESIGN, INC. BPE Firm#: F-14909 - TBPLS Firm#: 1019455

TMM SOMERSET, UNIT 3A PLAT# 23-11800289

**KB HOME** 

CITY OF SAN ANTONIO **BEXAR COUNTY TEXAS** 

1	Colliers
ı	Engineering & Design

SAN ANTONIO (KFW) 3421 Paesanos Parkway San Antonio, TX 78231 Phone: 210.979.8444 COLLIERS ENGINEERING & DESIGN, INC TBPE Firm#: F-14909 TBPLS Firm#: 10194550

AS SHOWN SS4181407 418-14-07

LINE "C" PLAN & PROFILE

#### GENERAL WATER NOTES

1. All materials and construction procedures within the scope of this contract shall be approved by the San Antonio Water System (SAWS) and comply with the Plans, Specifications, General Conditions and with the following as applicable:

- A. Current Texas Commission on Environmental Quality (TCEQ) "Design Criteria for Domestic Waste water System", Texas Administrative Code (TAC) Title 30 Part 1 Chapter 217 and "Public Drinking Water", TAC Title 30 Part 1 Chapter 290.
- B. Current TXDOT "Standard Specifications for Construction of Highways, Streets and Drainage".
  C. Current "San Antonio Water System Standard Specifications for Water and Sanitary Sewer Construction".
  D. Current City of San Antonio "Standard Specifications for Public Works Construction".

2. The contractor shall not proceed with any pipe installation work until they obtain a copy of the approved Counter Permit or General Construction Permit (GCP) from the consultant and has been notified by SAWS Construction I nspection Division to proceed with the work and has arranged a meeting with the inspector and consultant for the work requirements. Work completed by the contractor without an approved Counter Permit and/or a GCP will be

subject to removal and replacement at the expense of the contractors and/or the developer.

3. The Contractor shall obtain the SAWS Standard Details from the SAWS website,

http://www.saws.org/business\_center/specs. Unless otherwise noted within the design plans.

E. Current City of San Antonio "Utility Excavation Criteria Manual" (UECM).

4. The Contractor is to make arrangements with the SAWS Construction Inspection Division at (210) 233-2973, on notification procedures that will be used to notify affected home residents and/or property owners 48 hours prior to beginning any work.

5. Location and depth of existing utilities and service laterals shown on the plans are understood to be approximate.

Actual locations and depths must be field verified by the Contractor at least 1 week prior to construction. It shall be the Contractor's responsibility to locate utility service lines as required for construction and to protect them during construction at no cost to SAWS.

6. The Contractor shall verify the exact location of underground utilities and drainage structures at least 1-2 weeks prior to construction whether shown on plans or not. Please allow up to 7 business days for locates requesting pipe location markers on SAWS facilities. The following contact information are supplied for verification purposes:

SAWS Utility Locates: http://www.saws.org/Service/Locates COSA Drainage (210) 207-0724 or (210) 207-6026 COSA Traffic Signal Operations (210) 206-8480 COSA Traffic Signal Damages (210) 207-3951 Texas State Wide One Call Locator 1-800-545-6005 or 811

7. The Contractor shall be responsible for restoring existing fences, curbs, streets, driveways, sidewalks, landscaping and structures to its original or better condition if damages are made as a result of the project's construction.

8. All work in Texas Department of Transportation (TxDOT) and/or Bexar County right-of-way shall be done in accordance with respective construction specifications and permit requirements.

9. The Contractor shall comply with City of San Antonio or other governing municipality's tree ordinances when excavating

10. The Contractor shall not place any waste materials in the 100-year Flood Plain without first obtaining an approved Flood Plain Permit.

11. Holiday Work: Contractors will not be allowed to perform SAWS work on SAWS recognized holidays. Request should be sent to constworkreq@saws.org.

Weekend Work: Contractors are required to notify the SAWS Inspection Construction

Department 48 hours in advance to request weekend work. Request should be sent to constworkreq@saws.org.

Any and all SAWS utility work installed without holiday/weekend approval will be subject to be uncovered for proper inspection.

12. Compaction note (Item 804): The contractor shall be responsible for meeting the compaction requirements on all trench backfill and for paying for the tests performed by a third party. Compaction tests will be done at one location point randomly selected, or as indicated by the SAWS Inspector and/or the test administrator, per each 12-inch loose lift per 400 linear feet at a minimum. This project will not be accepted and finalized by SAWS without this requirement being met and verified by providing all necessary documented test results.

13. A copy of all testing reports shall be forwarded to SAWS Construction Inspection Division.

#### Water Section

1. Prior to tie-ins, any shutdowns of existing mains of any size must be coordinated with the SAWS Construction Inspection Division at least one week in advance of the shutdown. The Contractor must also provide a sequence of work as related to the tie-ins; this is at no additional cost to SAWS or the project and it is the responsibility of the Contractor to sequence the work accordingly.

■ For water mains 12" or higher: SAWS Emergency Operations Center (210) 233-2014

2. Asbestos Cement (AC) pipe, also known as transite pipe which is known to contain asbestos containing material (ACM), may be located within the project limits. Special waste management procedures and health and safety requirements will be applicable when removal and/or disturbance of this pipe occurs. Such work is to be made under Special Specification Item No. 3000, "Special Specification for Handling Asbestos Cement Pipe".

3. Valve removal: Where the contractor is to abandon a water main, the control valve located on the abandoning branch will be removed and replaced with a cap/plug. (NSPI)

4. Suitable anchorage/thrust blocking or joint restraint shall be provided at all of the following main locations: dead ends, plugs, caps, tees, crosses, valves, and bends, in accordance with the Standard Drawings DD-839 Series and Item No. 839, in the SAWS Standard Specifications for Construction.

5. All valves shall read "open right".

6. PRVs Required: Contractor to verify that no portion of the tract is below ground elevation of 605 feet where the static pressure will normally exceed 80 PSI. At all such locations where the ground level is below 605 feet, the Developer or Builder shall install at each lot, on the customer's side of the meter, an approved type pressure regulator in conformance with the Plumbing Code of the City of San Antonio. No dual services allowed for any lot(s) if \*PRV is/are required for such lot(s), only single service connections shall be allowed. \*Note: A pressure regulator is also known as a pressure reducing valve (PRV).

7. Pipe Disinfection with Dry HTH for Projects less than 800 linear feet. (Item No. 847.3): Mains shall be disinfected with dry HTH where shown in the contract documents or as directed by the Inspector, and shall not exceed a total length of 800 feet. This method of disinfection will also be followed for main repairs. The Contractor shall utilize all appropriate safety measure to protect his personnel during disinfection operations.

#### 8. Backflow Prevention Devices:

DISTRIBUTION AND COLLECTION STAFF.

All irrigation services within residential areas are required to have backflow prevention devices.
 All commercial backflow prevention devices must be approved by SAWS prior to installation.

 Final connection to the existing water main shall not be made until the water main has been pressure tested, chlorinated, and SAWS has released the main for tie-in and use.

10. DIVISION VALVES: DIVISION VALVES SHOWN ON PLANS OR NOT SHOWN ON PLANS BUT FOUND IN THE FIELD SHALL ONLY BE OPERATED BY SAWS DISTRIBUTION AND COLLECTION STAFF AND ONLY WITH PRIOR WRITTEN APPROVAL OF THE SAWS DIRECTOR OF PRODUCTION AND OPERATIONS AND PROPER COORDINATION WITH ALL SAWS DEPARTMENTS. CONTRACTOR SHALL PROVIDE WRITTEN NOTIFICATION TO THE INSPECTOR A MINIMUM OF TWO WEEKS IN ADVANCE TO START THE COORDINATION PROCESS AND WILL BE INFORMED BY THE INSPECTOR WHEN THE DIVISION VALVE WILL BE OPERATED BY THE SAWS DISTRIBUTION AND COLLECTION STAFF. THE DIVISION VALVE CAN ONLY BE OPERATED BY SAWS DISTRIBUTION AND COLLECTION STAFF MEMBER NOT THE INSPECTOR OR THE CONTRACTOR. OPERATION OF A DIVISION VALVE WITHOUT THE EXPRESS PRIOR WRITTEN APPROVAL OF THE SAWS DISTRIBUTION AND COLLECTION STAFF WILL CONSTITUTE A MATERIAL BREACH OF ANY WRITTEN SAWS CONTRACT OR PERMIT IN ADDITION TO SUBJECTING THE CONTRACTOR TO LIABILITY FOR ANY AND ALL FINES, FEES, OR OTHER DAMAGES, DIRECT OR CONSEQUENTIAL, THAT MAY ARISE FROM OR BE CAUSED BY THE OPERATION OF THE VALVE WITHOUT PRIOR WRITTEN PERMISSION. PLEASE BE INFORMED THAT THE APPROVAL OF THE OPERATION OR OPENING OR CLOSING OF A DIVISION VALVE CAN TAKE SEVERAL WEEKS FOR APPROVAL. DIVISION VALVES WILL ALSO HAVE A VALVE LID LABELED DIVISION VALVE AND A LOCKING MECHANISM INSTALLED WITH A KEY. THE LOCK AND KEY MECHANISM WILL BE PAID FOR BY THE CONTRACTOR BUT WILL BE INSTALLED BY SAWS

# TMM SOMERSET, UNIT 3A

# SAN ANTONIO, TX WATER IMPROVEMENTS



LOCATION MAP NOT-TO-SCALE

OWNER INFORMATION:
KB HOMES
4800 FREDERICKSBURG RD.
SAN ANTONIO, TX 78229
PHONE: (210) 301 - 5485

# Sheet List Table

SHEET TITLE SHEET NUMBER
WATER DISTRIBUTION COVER SHEET 7.0
WATER DISTRIBUTION PLAN 7.1

whom the services were contracted or to whom it is certified. This drawing may r e copied, reused, disclosed, distributed or relied upon for any other purpo Formerly Known as FOR STATE SPECIFIC DIRECT PHONE NUMBERS VISIT: WWW.CALL811.COM X CLAYTON J. LINNEY TEXAS LICENSED PROFESSIONAL ENGINEER LICENSE NUMBER: 111543 COLLIERS ENGINEERING & DESIGN, INC. TBPE Firm#: F-14909 - TBPLS Firm#: 10194550 TMM SOMERSET, UNIT 3A PLAT# 23-11800289 **KB HOME** CITY OF SAN ANTONIO **BEXAR COUNTY** TEXAS SAN ANTONIO (KFW) 3421 Paesanos San Antonio, TX 78231 Phone: 210.979.8444 & Design TBPE Firm#: F-14909 TBPLS Firm#: 10194550

**Colliers** 

Engineering

& Design

www.colliersengineering.com

opyright © 2025. Colliers Engineering & Design All Rights Reserved. This draw

SERVICE AREA: 790

 DEVELOPER'S NAME: KB HOME LONESTAR INC.

 DEVELOPER'S ADDRESS: 4800 FREDERICKSBURG RD.

 CITY: SAN ANTONIO
 STATE: TEXAS
 ZIP: 78229

 PHONE#: (210) 301-5485
 FAX#:
 TOTAL ACREAGE: 11.68 AC

 SAWS BLOCK MAP#: 126530, 126532, 128530, 128532
 TOTAL EDU'S: 78

 TOTAL LINEAR FOOTAGE OF PIPE: 1,780 L.F. ~ 8" DR-11 H.D.P.E.
 PLAT NO.: 23-11800289

 NUMBER OF LOTS: 78
 SAWS JOB#: 23-1132

NOTE: DO NOT SCALE DRAWINGS FOR CONSTRUCTION


418-14-07

CVOW4181407

WATER DISTRIBUTION

**COVER SHEET** 

7.0

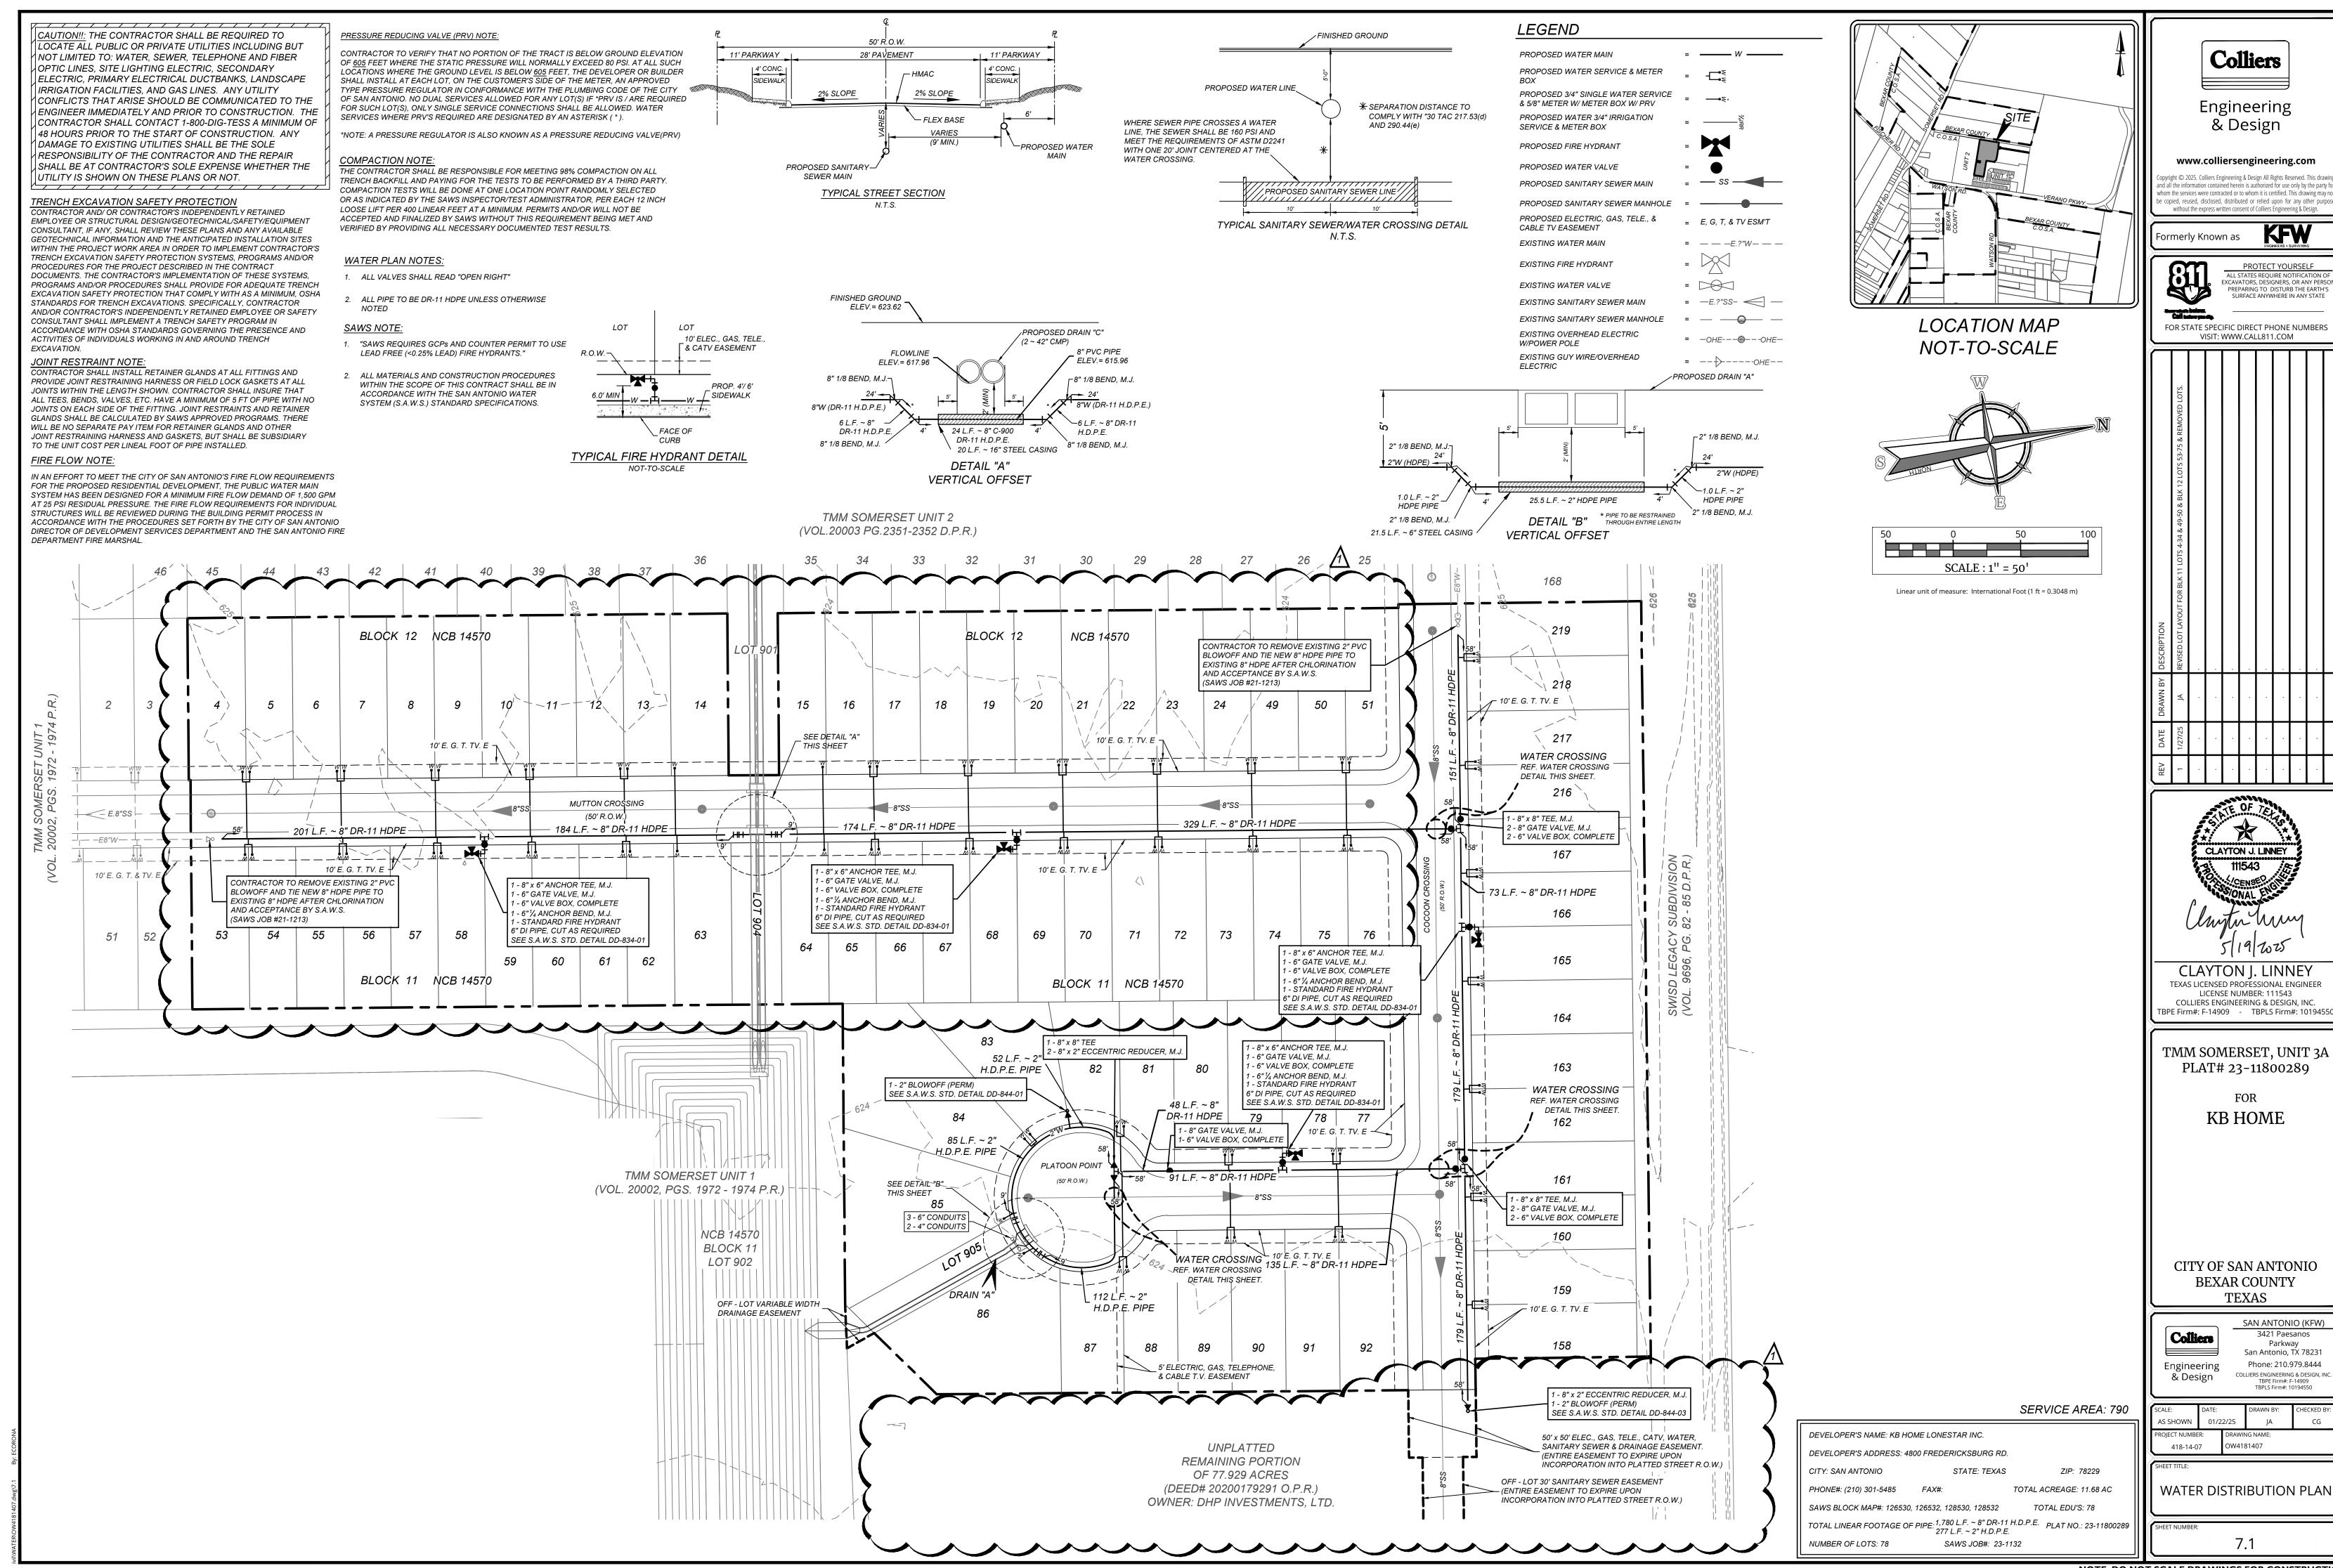

#### **INSTALLATION:**

- 1. ALL OPERATORS SHALL SUBMIT A NOTICE OF INTENT (NOI) AT LEAST 48 HOURS IN ADVANCE AND ALL BEST MANAGEMENT PRACTICES (BMP'S) SHALL BE IN PLACE PRIOR TO STARTING CONSTRUCTION ACTIVITIES.
- 2. CONTRACTOR TO ENSURE THAT STRUCTURAL BMP'S ARE INSTALLED WITHIN THE LIMITS OF THE SITE BOUNDARY.
- 3. CONTRACTOR MAY INSTALL THE BEST MANAGEMENT PRACTICES IN PHASES THAT COINCIDE WITH THE DISTURBANCE OF UP GRADIENT AREAS. THIS PHASING SHOULD BE NOTED WITHIN THE MODIFICATIONS SECTION WITH THE SIGNATURE AND DATE OF THE
- 4. CONTRACTOR TO VERIFY SUFFICIENT VEGETATION IN AREAS DENOTED AS VEGETATED FILTER STRIP. IF INSUFFICIENT VEGETATION EXISTS, CONTRACTOR SHALL IMPLEMENT A DIFFERENT BEST MANAGEMENT PRACTICE AND WILL SHOW IT ON THIS PLAN WITH NOTATION IN THE MODIFICATIONS SECTION WITH THE SIGNATURE AND DATE OF THE RESPONSIBLE PARTY.

#### MAINTENANCE AND INSPECTION:

SIGNATURE AND DATE OF THE RESPONSIBLE PARTY.

RESPONSIBLE PARTY.

- 1. CONTRACTOR SHOULD LIMIT CONSTRUCTION ACTIVITIES TO ONLY THOSE AREAS SHOWN TO BE DISTURBED ON THIS PLAN. IF ADDITIONAL VEGETATED AREAS ARE DISTURBED, THEY SHOULD BE PROTECTED WITH APPROPRIATE BEST MANAGEMENT PRACTICES UNTIL THE AREAS HAVE BEEN STABILIZED AS PER THE SPECIFICATIONS OF THE SWPPP. THE AREAS OF THIS ADDITIONAL SOIL DISTURBANCE AND THE MEASURES USED SHOULD BE SHOWN ON THE SITE PLAN AND NOTED WITHIN THE MODIFICATIONS SECTION WITH THE
- 2. CONTRACTOR IS RESPONSIBLE FOR MAINTENANCE AND INSPECTION OF BMP'S AS PER THE SPECIFICATIONS OF THE SWPPP. THE CONTRACTOR MAY MODIFY THE CONTROLS AS NECESSARY TO PREVENT SEDIMENT RUNOFF. THESE MODIFICATIONS SHOULD BE SHOWN AND THE SITE PLAN AND NOTED WITHIN THE MODIFICATIONS SECTION WITH THE SIGNATURE AND DATE OF THE RESPONSIBLE PARTY.
- 3. LOCATION OF CONSTRUCTION ENTRANCE/EXIT, CONCRETE WASHOUT PIT, AND

#### PROJECT COMPLETION:

- 1. ALL DISTURBED AREAS ARES NOT COVERED BY IMPERVIOUS COVER ARE TO BE STABILIZED PER THE SWPPP AND PROJECT SPECIFICATIONS PRIOR TO REMOVAL OF ANY BMP'S AND/OR PRIOR TO FILING A NOTICE OF TERMINATION (NOT).
- 2. BEST MANAGEMENT PRACTICES MAY BE REMOVED IN PHASES IF ALL UPGRADIENT AREAS HAVE BEEN STABILIZED PER SWPPP AND PROJECT SPECIFICATIONS. THIS PHASING SHOULD BE NOTED WITHIN THE MODIFICATIONS SECTION WITH THE SIGNATURE AND DATE OF THE RESPONSIBLE PARTY.
- 3. CONTRACTOR TO ENSURE THEY HAVE MET ALL REQUIREMENTS OF THE SWPPP BEFORE FILING A NOTICE OF TERMINATION (NOT).

- 1. THIS EXHIBIT IS TO BE USED FOR THE PURPOSES OF STORMWATER POLLUTION PREVENTION ONLY. ALL OTHER CIVIL ENGINEERING INFORMATION SHOULD BE OBTAINED FROM THE APPROPRIATE CONSTRUCTION DOCUMENTS.
- 2. THE PURPOSE OF THE SIGNATURE AND SEAL OF THE ENGINEER ON THIS DOCUMENT IS TO DEMONSTRATE COMPLIANCE WITH THE TPDES STORMWATER POLLUTION PREVENTION PLAN REGULATIONS ONLY.
- 3. ALL OWNERS/OPERATORS ARE RESPONSIBLE FOR FAMILIARIZING THEMSELVES WITH THE STORMWATER POLLUTION PREVENTION PLAN AND COMPLYING WITH THE REGULATIONS CONTAINED WITHIN IT.


#### **COORDINATION NOTE:**


- 1. CONTACT TIME WARNER TO COORDINATE CABLE TV SERVICE. (210) 244-0500
- 2. CONDUIT FOR ELECTRICAL SERVICE. CONFIRM REQUIREMENTS AND COORDINATE WITH CPS FOR INSPECTION. (210) 353-2246.
- 3. CONTACT AT&T TO COORDINATE TELEPHONE SERVICE. 1-800-449-7928.
- 4. CONTRACTOR TO COORDINATE WITH CPS PRIOR TO CONSTRUCTION TO PLAN ELECTRIC SERVICE.
- 5. CONTRACTOR TO COORDINATE WITH SAWS TO PLAN WATER AND SANITARY SEWER SERVICES (210) 704-7297
- 6. CONTRACTOR SHALL CONTACT 1-800-DIG-TESS A MINIMUM OF 48 HOURS PRIOR TO THE START OF CONSTRUCTION.


DATE	SIGNATURE	DESCRIPTION

SW3P MODIFICATIONS



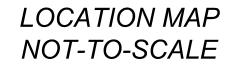

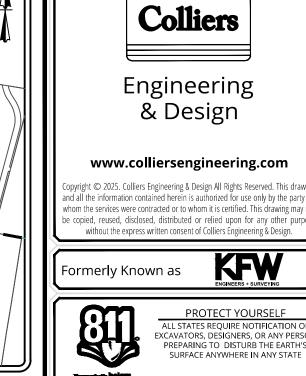

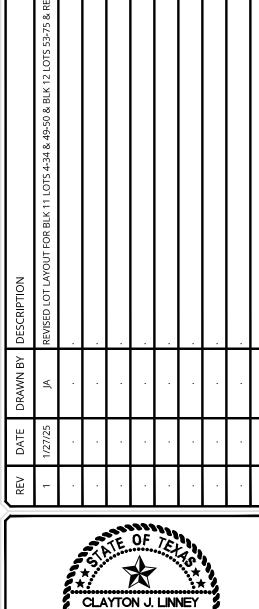

FOR STATE SPECIFIC DIRECT PHONE NUMBERS

VISIT: WWW.CALL811.COM

CLAYTON J. LINNEY TEXAS LICENSED PROFESSIONAL ENGINEER LICENSE NUMBER: 111543 COLLIERS ENGINEERING & DESIGN, INC. BPE Firm#: F-14909 - TBPLS Firm#: 1019455

TMM SOMERSET, UNIT 3A PLAT# 23-11800289

FOR **KB HOME** 

CITY OF SAN ANTONIO **BEXAR COUNTY** TEXAS

Colliers Engineering & Design


3421 Paesanos Parkway San Antonio, TX 78231 Phone: 210.979.8444 COLLIERS ENGINEERING & DESIGN, INC TBPE Firm#: F-14909 TBPLS Firm#: 10194550

SAN ANTONIO (KFW)

AS SHOWN SW3P4181407 418-14-07

STORM WATER POLLUTION PREVENTION

PLAN (SHT 1 OF 2)

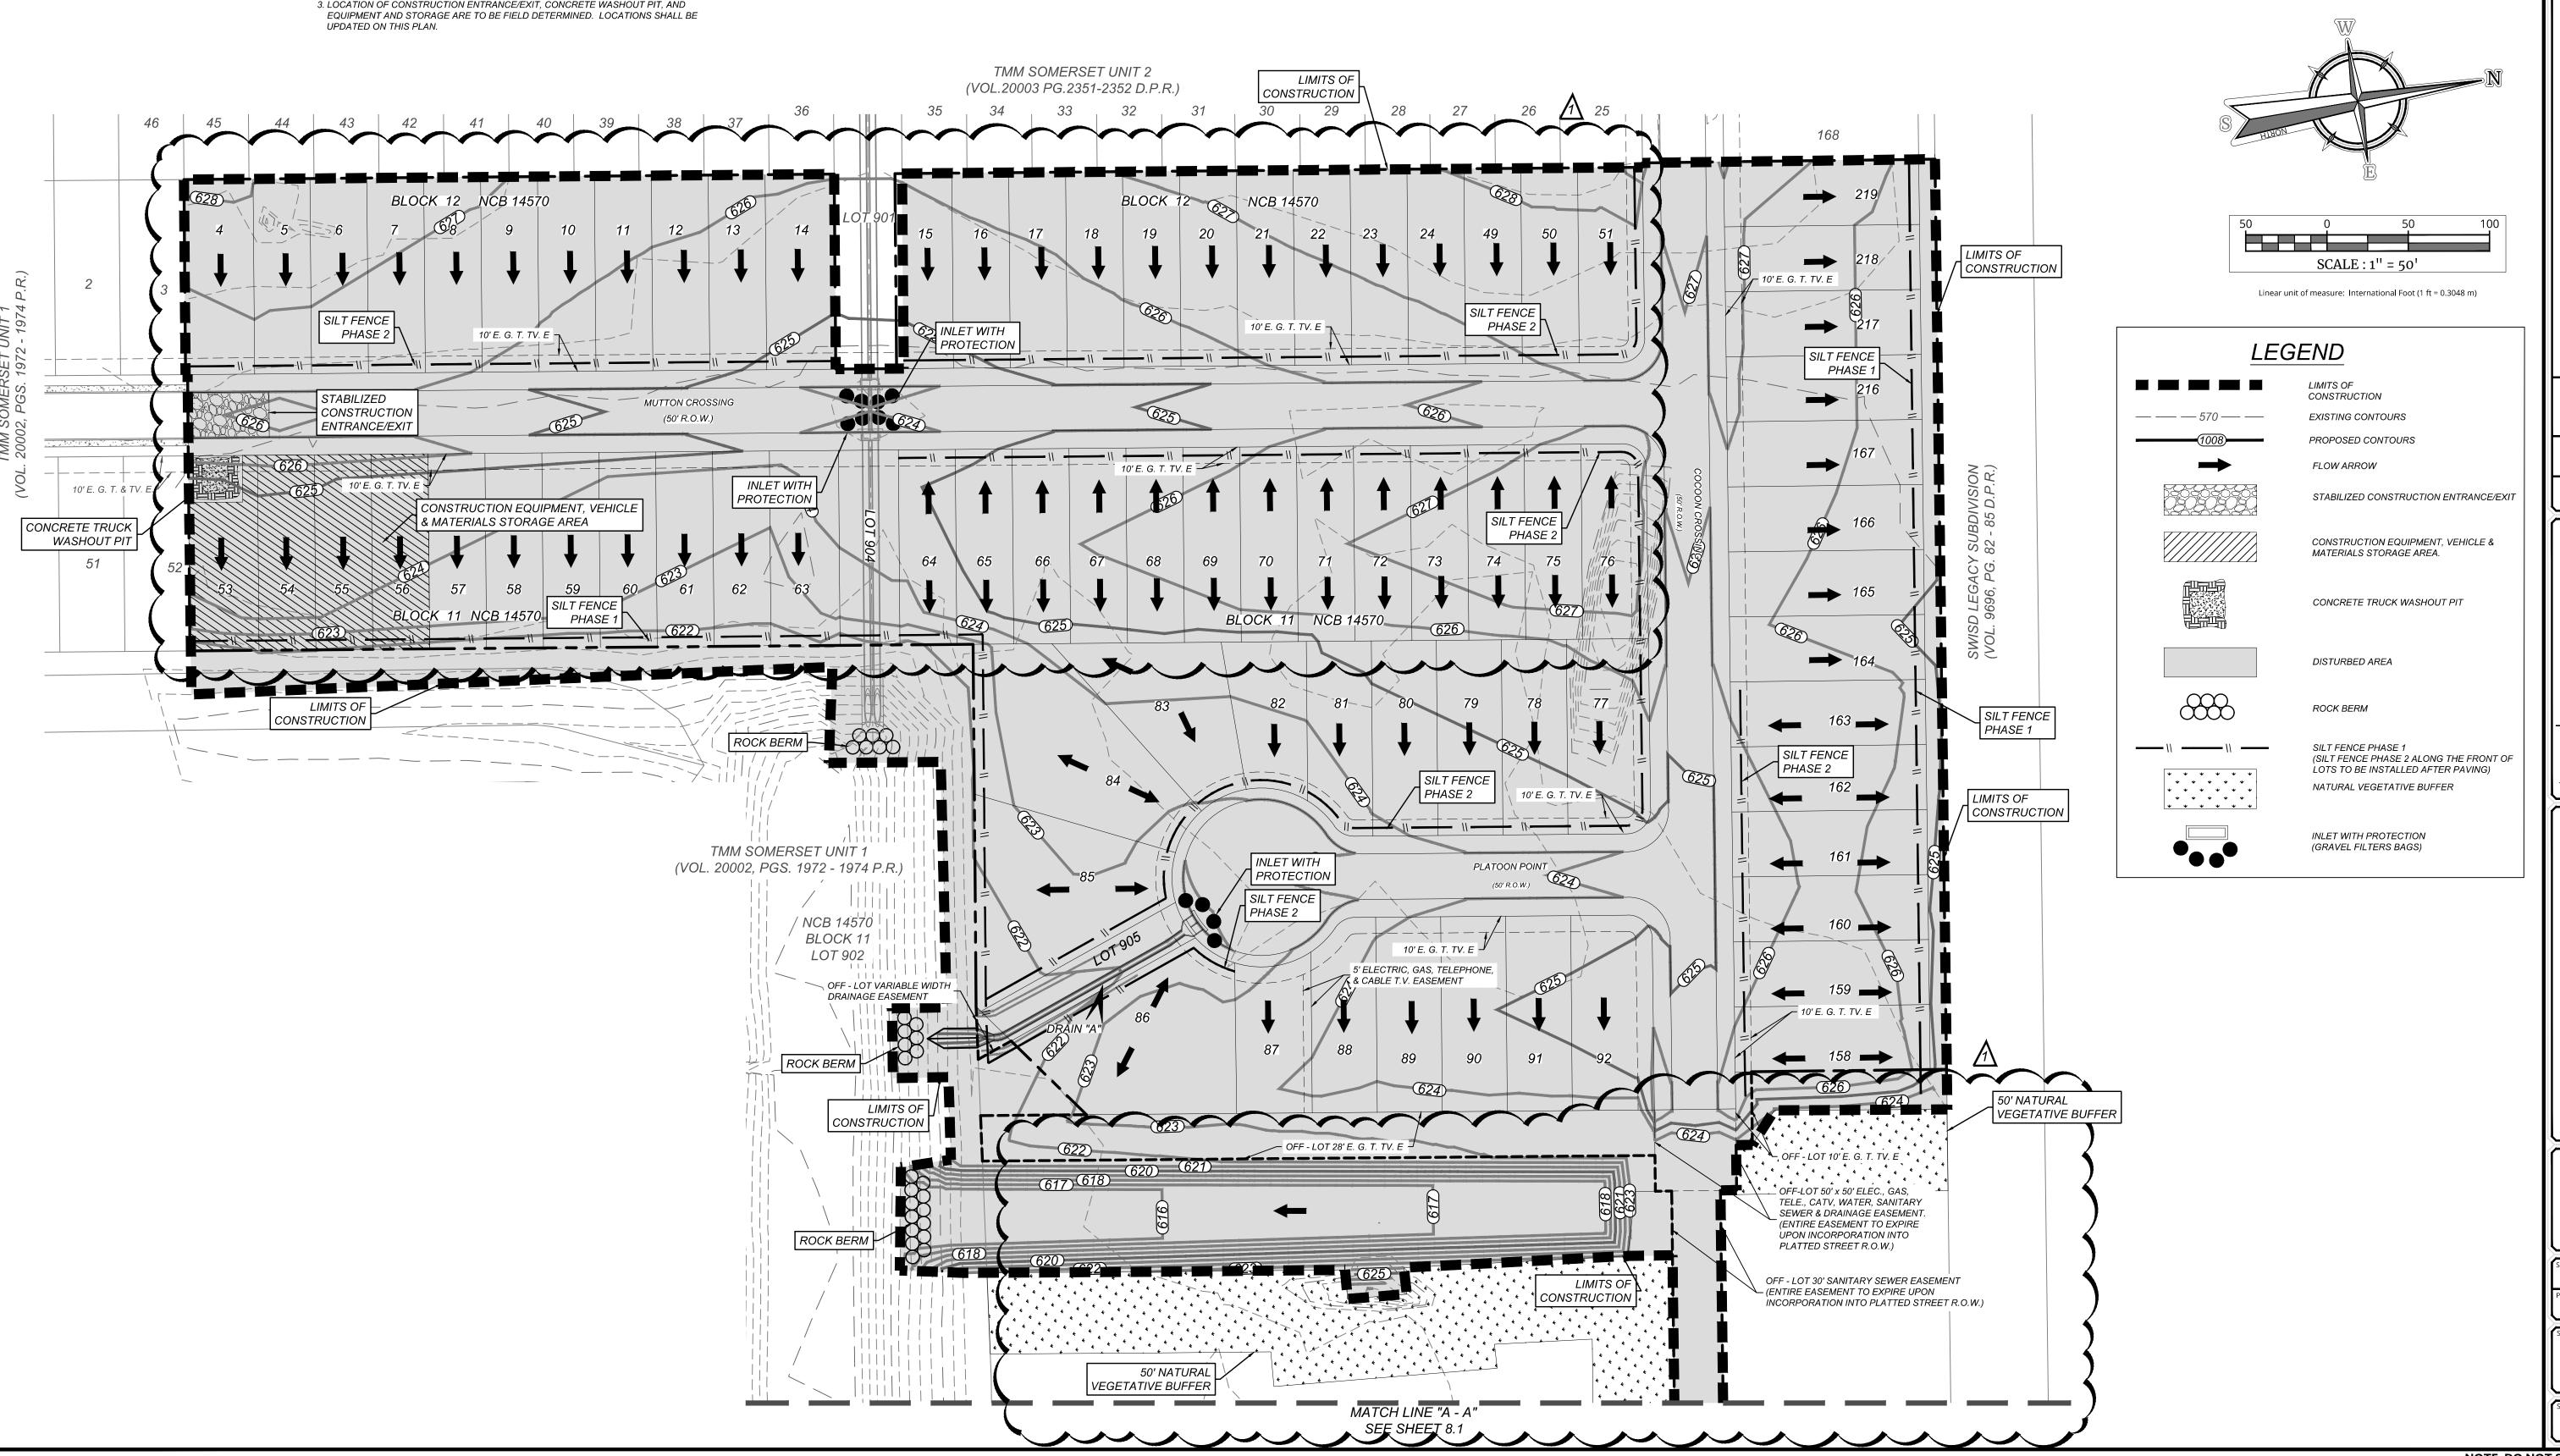

#### **INSTALLATION:**

- 1. ALL OPERATORS SHALL SUBMIT A NOTICE OF INTENT (NOI) AT LEAST 48 HOURS IN ADVANCE AND ALL BEST MANAGEMENT PRACTICES (BMP'S) SHALL BE IN PLACE PRIOR TO STARTING CONSTRUCTION ACTIVITIES.
- 2. CONTRACTOR TO ENSURE THAT STRUCTURAL BMP'S ARE INSTALLED WITHIN THE LIMITS OF THE SITE BOUNDARY.
- 3. CONTRACTOR MAY INSTALL THE BEST MANAGEMENT PRACTICES IN PHASES THAT COINCIDE WITH THE DISTURBANCE OF UP GRADIENT AREAS. THIS PHASING SHOULD BE NOTED WITHIN THE MODIFICATIONS SECTION WITH THE SIGNATURE AND DATE OF THE RESPONSIBLE PARTY.
- 4. CONTRACTOR TO VERIFY SUFFICIENT VEGETATION IN AREAS DENOTED AS VEGETATED FILTER STRIP. IF INSUFFICIENT VEGETATION EXISTS, CONTRACTOR SHALL IMPLEMENT A DIFFERENT BEST MANAGEMENT PRACTICE AND WILL SHOW IT ON THIS PLAN WITH NOTATION IN THE MODIFICATIONS SECTION WITH THE SIGNATURE AND DATE OF THE RESPONSIBLE PARTY.

#### MAINTENANCE AND INSPECTION:

- 1. CONTRACTOR SHOULD LIMIT CONSTRUCTION ACTIVITIES TO ONLY THOSE AREAS SHOWN TO BE DISTURBED ON THIS PLAN. IF ADDITIONAL VEGETATED AREAS ARE DISTURBED, THEY SHOULD BE PROTECTED WITH APPROPRIATE BEST MANAGEMENT PRACTICES UNTIL THE AREAS HAVE BEEN STABILIZED AS PER THE SPECIFICATIONS OF THE SWPPP. THE AREAS OF THIS ADDITIONAL SOIL DISTURBANCE AND THE MEASURES USED SHOULD BE SHOWN ON THE SITE PLAN AND NOTED WITHIN THE MODIFICATIONS SECTION WITH THE SIGNATURE AND DATE OF THE RESPONSIBLE PARTY.
- 2. CONTRACTOR IS RESPONSIBLE FOR MAINTENANCE AND INSPECTION OF BMP'S AS PER THE SPECIFICATIONS OF THE SWPPP. THE CONTRACTOR MAY MODIFY THE CONTROLS AS NECESSARY TO PREVENT SEDIMENT RUNOFF. THESE MODIFICATIONS SHOULD BE SHOWN AND THE SITE PLAN AND NOTED WITHIN THE MODIFICATIONS SECTION WITH THE SIGNATURE AND DATE OF THE RESPONSIBLE PARTY.
- 3. LOCATION OF CONSTRUCTION ENTRANCE/EXIT, CONCRETE WASHOUT PIT, AND EQUIPMENT AND STORAGE ARE TO BE FIELD DETERMINED. LOCATIONS SHALL BE UPDATED ON THIS PLAN.

OFF - LOT 30' SANITARY SEWER EASEMENT

INCORPORATION INTO PLATTED STREET R.O.W.)

---~---------

\_\_\_\_\_\_ (VOL. 20002, PG 1972-1974, P.R.) -

(ENTIRE EASEMENT TO EXPIRE UPON

VEGETATIVE BUFFER

#### PROJECT COMPLETION:

- 1. ALL DISTURBED AREAS ARES NOT COVERED BY IMPERVIOUS COVER ARE TO BE STABILIZED PER THE SWPPP AND PROJECT SPECIFICATIONS PRIOR TO REMOVAL OF ANY BMP'S AND/OR PRIOR TO FILING A NOTICE OF TERMINATION (NOT).
- 2. BEST MANAGEMENT PRACTICES MAY BE REMOVED IN PHASES IF ALL UPGRADIENT AREAS HAVE BEEN STABILIZED PER SWPPP AND PROJECT SPECIFICATIONS. THIS PHASING SHOULD BE NOTED WITHIN THE MODIFICATIONS SECTION WITH THE SIGNATURE AND DATE OF THE RESPONSIBLE PARTY.
- 3. CONTRACTOR TO ENSURE THEY HAVE MET ALL REQUIREMENTS OF THE SWPPP BEFORE FILING A NOTICE OF TERMINATION (NOT).

LIMITS OF

LIMITS OF CONSTRUCTION

**UNPLATTED 23.685 ACRES** 

(DEED# 20210256507 O.P.R.)

OWNER: KB HOMES LONE STAR LP.

CONSTRUCTION

- 1. THIS EXHIBIT IS TO BE USED FOR THE PURPOSES OF STORMWATER POLLUTION PREVENTION ONLY. ALL OTHER CIVIL ENGINEERING INFORMATION SHOULD BE OBTAINED FROM THE APPROPRIATE CONSTRUCTION DOCUMENTS.
- 2. THE PURPOSE OF THE SIGNATURE AND SEAL OF THE ENGINEER ON THIS DOCUMENT IS TO DEMONSTRATE COMPLIANCE WITH THE TPDES STORMWATER POLLUTION PREVENTION PLAN REGULATIONS ONLY.
- 3. ALL OWNERS/OPERATORS ARE RESPONSIBLE FOR FAMILIARIZING THEMSELVES WITH THE STORMWATER POLLUTION PREVENTION PLAN AND COMPLYING WITH THE REGULATIONS


20' SANITARY SEWER EASEMENT (VOL. 20002, PGS. 1972 - 1974 D.P.R.)

#### **COORDINATION NOTE:**

- 1. CONTACT TIME WARNER TO COORDINATE CABLE TV SERVICE. (210) 244-0500
- 2. CONDUIT FOR ELECTRICAL SERVICE. CONFIRM REQUIREMENTS AND COORDINATE WITH CPS FOR INSPECTION. (210) 353-2246.
- 3. CONTACT AT&T TO COORDINATE TELEPHONE SERVICE. 1-800-449-7928.
- 4. CONTRACTOR TO COORDINATE WITH CPS PRIOR TO CONSTRUCTION TO PLAN ELECTRIC SERVICE.
- 5. CONTRACTOR TO COORDINATE WITH SAWS TO PLAN WATER AND SANITARY SEWER SERVICES (210) 704-7297
- 6. CONTRACTOR SHALL CONTACT 1-800-DIG-TESS A MINIMUM OF 48 HOURS PRIOR TO THE START OF CONSTRUCTION.



NOT-TO-SCALE

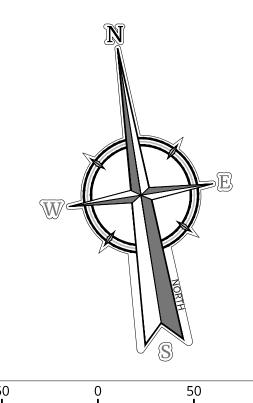

Linear unit of measure: International Foot (1 ft = 0.3048 m)

SCALE : 1" = 50'

#### LEGEND

CONSTRUCTION EXISTING CONTOURS PROPOSED CONTOURS

MATERIALS STORAGE AREA.

SILT FENCE PHASE 1


PLAT# 23-11800289 (SILT FENCE PHASE 2 ALONG THE FRONT OF LOTS TO BE INSTALLED AFTER PAVING) NATURAL VEGETATIVE BUFFER

INLET WITH PROTECTION (GRAVEL FILTERS BAGS)

### SW3P MODIFICATIONS

DATE	SIGNATURE	DESCRIPTION

**LOCATION MAP** 

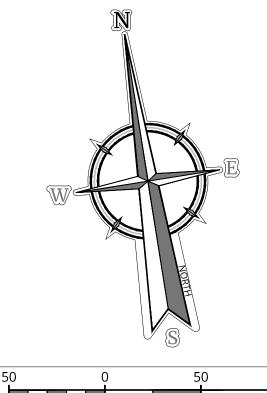

FLOW ARROW

LIMITS OF

STABILIZED CONSTRUCTION ENTRANCE/EXIT

CONSTRUCTION EQUIPMENT, VEHICLE &

CONCRETE TRUCK WASHOUT PIT

DISTURBED AREA

ROCK BERM

CITY OF SAN ANTONIO **BEXAR COUNTY** TEXAS

CLAYTON J. LINNEY

CLAYTON J. LINNEY TEXAS LICENSED PROFESSIONAL ENGINEER LICENSE NUMBER: 111543

COLLIERS ENGINEERING & DESIGN, INC. BPE Firm#: F-14909 - TBPLS Firm#: 1019455

TMM SOMERSET, UNIT 3A

FOR

**KB HOME** 

Engineering

& Design

www.colliersengineering.com

oyright © 2025. Colliers Engineering & Design All Rights Reserved. This draw

rhom the services were contracted or to whom it is certified. This drawing may

e conied, reused, disclosed, distributed or relied upon for any other purp

without the express written consent of Colliers Engineering & Design.

FOR STATE SPECIFIC DIRECT PHONE NUMBERS

VISIT: WWW.CALL811.COM

ALL STATES REQUIRE NOTIFICATION OF EXCAVATORS, DESIGNERS, OR ANY PERSON

PREPARING TO DISTURB THE EARTH'S SURFACE ANYWHERE IN ANY STATE


ormerly Known as

Engineering & Design

SAN ANTONIO (KFW) 3421 Paesanos Colliers Parkway San Antonio, TX 78231 Phone: 210.979.8444 COLLIERS ENGINEERING & DESIGN, INC TBPE Firm#: F-14909 TBPLS Firm#: 10194550

AS SHOWN

418-14-07 SW3P4181407 STORM WATER POLLUTION PREVENTION PLAN (SHT 2 OF 2)

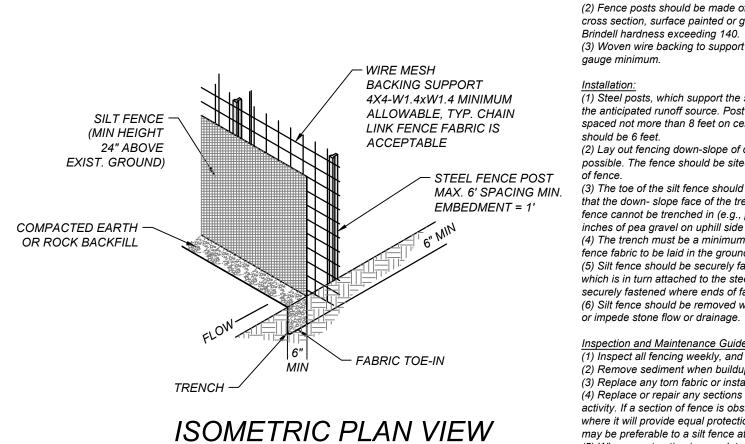

SILT FENCE

SECTION A-A

SECTION B-B

Materials:
(1) Silt fence material should be polypropylene, polyethylene or polyamide woven or nonwoven fabric. The fabric width should be 36 inches, with a minimum unit weight of 4.5 oz/yd, mullen burst strength exceeding 190 lb/in2, ultraviolet stability exceeding 70%, and minimum apparent opening size of U.S. Sieve No. (2) Fence posts should be made of hot rolled steel, at least 4 feet long with Tee or Ybar

cross section, surface painted or galvanized, minimum nominal weight 1.25 lb/fl2, and Brindell hardness exceeding 140. (3) Woven wire backing to support the fabric should be galvanized 2" x 4" welded wire, 12 gauge minimum.

(1) Steel posts, which support the silt fence, should be installed on a slight angle toward the anticipated runoff source. Post must be embedded a minimum of 1- foot deep and spaced not more than 8 feet on center. Where water concentrates, the maximum spacing should be 6 feet.

(2) Lay out fencing down-slope of disturbed area, following the contour as closely as possible. The fence should be sited so that the maximum drainage area is 1/4 acre/i 00 feet

(3) The toe of the silt fence should be trenched in with a spade or mechanical trencher, so that the down- slope face of the trench is flat and perpendicular to the line of flow. Where fence cannot be trenched in (e.g., pavement or rock outcrop), weight fabric flap with 3 inches of pea gravel on uphill side to prevent flow from seeping under fence. (4) The trench must be a minimum of 6 inches deep and 6 inches wide to allow for the silt fence fabric to be laid in the ground and backfilled with compacted material. (5) Silt fence should be securely fastened to each steel support post or to woven wire. which is in turn attached to the steel fence post. There should be a 3-foot overlap, securely fastened where ends of fabric meet. (6) Silt fence should be removed when the site is completely stabilized so as not to block

Inspection and Maintenance Guidelines:

(1) Inspect all fencing weekly, and after any rainfall. (2) Remove sediment when buildup reaches 6 inches. (3) Replace any torn fabric or install a second line of fencing parallel to the torn section. (4) Replace or repair any sections crushed or collapsed in the course of construction activity. If a section of fence is obstructing vehicular access, consider relocating it to a spot where it will provide equal protection, but will not obstruct vehicles. A triangular filter dike may be preferable to a silt fence at common vehicle access points.

SUBGRADE

GENERAL NOTES.

(5) When construction is complete, the sediment should be disposed of in a manner that will not cause additional siltation and the prior location of the silt fence should be revegetated. The fence itself should be disposed of in an approved landfill.

THE MATERIAL, INSTALLATION, INSPECTION, AND MAINTENANCE OF FIBER ROLLS WILL BE PER THE MANUFACTURE'S SPECIFICATIONS AND SHALL ALSO COMPLY WITH THE TEXAS COMMISSION OF ENVIRONMENTAL QUALITY CURRENT "TECHNICAL GUIDANCE ON BEST MANAGEMENT PRACTICES" AS NOTED BELOW. Install fiber roll along a level contour. may be compost, mulch, aspen wood fibers, chipped site vegetation.

Install a fiber roll near

into a steeper slope

FIBER ROLL

slope where it transitions

(1) Core material: Core material should be biodegradable or recyclable. Material agricultural rice or wheat straw, coconut fiber, 100% recyclable fibers, or similar materials.

(2) Containment Mesh: Containment mesh should be 100% biodegradable, photodegradable or recyclable such as burlap, twine, UV photodegradable plastic, polyester, or similar material. When the fiber role will remain in place as part of a vegetative system use biodegradable or photodegradable mesh. For temporary installation recyclable mesh is recommended.

Implementation: (1) Locate fiber rolls on level contours spaced as follows: Slope inclination of 4:1 (H:V) or flatter: Fiber rolls should be placed at a maximum interval of 20 ft.

Slope inclination between 4:1 and 2:1 (H:V): Fiber Rolls should be placed at a maximum interval of 15 ft. (a closer spacing is more effective). Slope inclination 2:1 (H:V) or greater: Fiber Rolls should be placed at a maximum interval of 10 ft. (a closer spacing is more effective). (2) Turn the ends of the fiber roll up slope to prevent runoff from going around the

(3) Stake fiber rolls into a 2 to 4 in. deep trench with a width equal to the diameter of the fiber roll. (4) Drive stakes at the end of each fiber roll and spaced 4 ft maximum on center. (5) Use wood stakes with a nominal classification of 0.75 by 0.75 in. and minimum

length of 24 in. (6) If more than one fiber roll is placed in a row, the rolls should be overlapped, not

Inspection and Maintenance Guidelines: (1) Inspect prior to forecast rain, daily during extended rain events, after rain events,

(2) Repair or replace split, torn, unraveling, or slumping fiber rolls. (3) If the fiber roll is used as a sediment capture device, or as an erosion control device to maintain sheet flows, sediment that accumulates behind the role must be periodically removed in order to maintain its effectiveness. Sediment should be removed when the accumulation reaches one-half the designated sediment storage depth, usually one-half the distance between the top of the fiber roll and the adjacent ground surface. Sediment removed during maintenance may be incorporated into earthwork on the site or disposed of at an appropriate location.

CONSTRUCTION

**EQUIPMENT** & VEHICLE STORAGE AND MAINTENANCE AREA


CONSTRUCTION

AND WASTE

MATERIAL

STORAGE

AREA

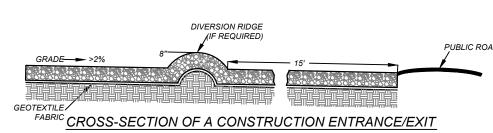


#### Materials:

(1) The aggregate should consist of 4 to 8 inch washed stone over a stable foundation as specified in the plan. (2) The aggregate should be placed with a minimum thickness of 8 inches. (3) The geotextile fabric should be designed specifically for use as a soil

rating of 140 lb/in2, and an equivalent opening size greater than a number (4) If a washing facility is required, a level area with a minimum of 4 inch diameter washed stone or commercial rack should be included in the plans. Divert wastewater to a sediment trap or basin.

filtration media with an approximate weight of 6 oz/yd2, a mullen burst

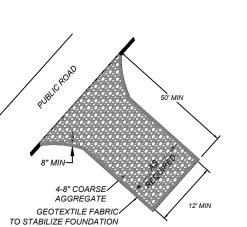

CONSTRUCTION ENTRANCE/EXIT

Installation: (North Carolina, 1993)

(1) Avoid curves on public roads and steep slopes. Remove vegetation and other objectionable material from the foundation area. Grade crown foundation for positive drainage. (2) The minimum width of the entrance/exit should be 12 feet or the full width of exit roadway, whichever is greater.

(3) The construction entrance should be at least 50 feet long. (4) If the slope toward the road exceeds 2%, construct a ridge, 6 to 8 inches high with 3:1 (H:V) side slopes, across the foundation approximately 15 feet from the entrance to divert runoff away from the public road. (5) Place geotextile fabric and grade foundation to improve stability, especially where wet conditions are anticipated. (6) Place stone to dimensions and grade shown on plans. Leave surface smooth and slope for drainage. (7) Divert all surface runoff and drainage from the stone pad to a sediment trap or basin.


Inspection and Maintenance Guidelines:

1) The entrance should be maintained in a condition, which will prevent tracking or flowing of sediment onto public rights-of-way. This may require periodic top dressing with additional stone as conditions demand and repair andlor cleanout of any measures used to trap sediment. (2) All sediment spilled, dropped, washed or tracked onto public rights-of-way should be removed immediately by contractor. (3) When necessary, wheels should be cleaned to remove sediment prior to entrance onto public right-of-way.

(4) When washing is required, it should be done on an area stabilized with crushed stone that drains into an approved sedime. trap or sediment basin. (5) All sediment should be prevented from entering any storm drain, ditch or water course by using approved methods.

STABILIZED CONSTRUCTION ENTRANCE / EXIT

(8) Install pipe under pad as needed to maintain proper public road drainage.

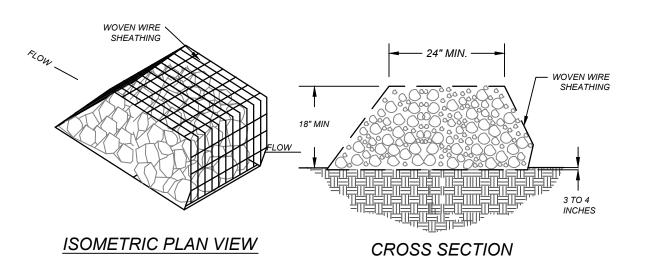

(1) The berm structure should be. secured with a woven wire sheathing having maximum opening of 1 inch and a minimum wire diameter of 20 gauge galvanized and should be secured with shoat rings. (2) Clean, open graded 3- to 5-inch diameter rock should be used, except in areas where high velocities or large volumes of flow are expected, where 5- to 8-inch diameter rocks may be used.

(1) Lay out the woven wire sheathing perpendicular to the flow line. The sheathing should be 20 gauge woven wire mesh with 1 inch openings.

(2) Berm should have a top width of 2 feet minimum with side slopes being 2:1 (H:V) or flatter. (3) Place the rock along the sheathing as shown in the diagram Figure 1-28), to a height not less than (4) Wrap the wire sheathing around the rock and secure with tie wire so that the ends of the sheathing

overlap at least 2 inches, airl the berm retains its shape when walked upon. (5) Berm should be built along the contour at zero percent grade or as near as possible. (6) The ends of the berm should be tied into existing upslope grade and the berm should be buried in a trench approximately 3 to 4 inches deep to prevent failure of the control.

Inspection and Maintenance Guidelines:


(1) Inspection should be made weekly and after each rainfall by the responsible party. For installations in streambeds, additional daily inspections should be made. (2) Remove sediment and other debris when buildup reaches 6 inches and dispose of the accumulated silt in an approved manner that will not cause any additional siltation.


(3) Repair any loose wire sheathing.


(4) The berm should be reshaped as needed during inspection. (5) The berm should be replaced when the structure ceases to function as intended due to silt

accumulation among the rocks, washout, construction traffic damage, etc. (6) The rock berm should be left in place until all upstream areas are stabilized and accumulated silt

#### ROCK BERM

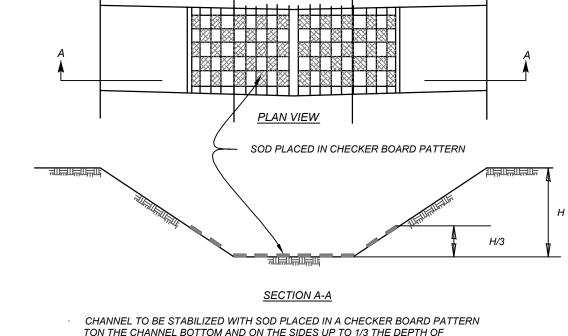

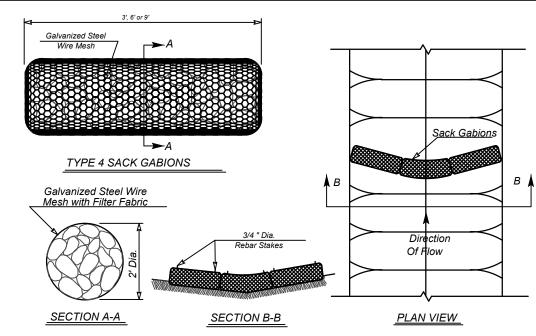

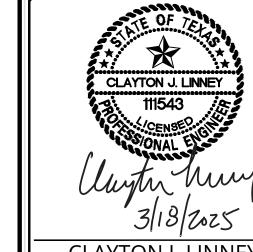

Engineering & Design

www.colliersengineering.com

pyright © 2025. Colliers Engineering & Design All Rights Reserved. This draw

nom the services were contracted or to whom it is certified. This drawing may

e copied, reused, disclosed, distributed or relied upon for any other purp

without the express written consent of Colliers Engineering & Design.

FOR STATE SPECIFIC DIRECT PHONE NUMBERS

VISIT: WWW.CALL811.COM

ALL STATES REQUIRE NOTIFICATION OF EXCAVATORS, DESIGNERS, OR ANY PERSON

PREPARING TO DISTURB THE EARTH'S SURFACE ANYWHERE IN ANY STATE

ormerly Known as

Theoreticals bolders.

CLAYTON J. LINNEY TEXAS LICENSED PROFESSIONAL ENGINEER LICENSE NUMBER: 111543 COLLIERS ENGINEERING & DESIGN, INC. BPE Firm#: F-14909 - TBPLS Firm#: 1019455

TMM SOMERSET, UNIT 3A PLAT# 23-11800289

**KB HOME** 

CITY OF SAN ANTONIO **BEXAR COUNTY TEXAS** 

Engineering


3421 Paesanos Parkway San Antonio, TX 78231 Phone: 210.979.8444 COLLIERS ENGINEERING & DESIGN, INC TBPE Firm#: F-14909 TBPLS Firm#: 10194550

SAN ANTONIO (KFW)

AS SHOWN SW3PDT4181407 418-14-07

STORM WATER POLLUTION PREVENTION PLAN DETAILS

NOTE: DO NOT SCALE DRAWINGS FOR CONSTRUCTION.

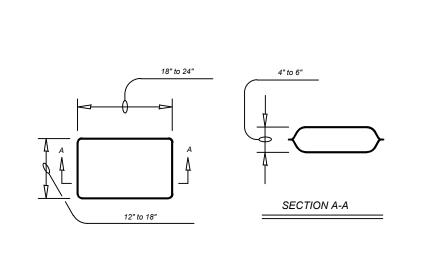

DETAIL ABOVE ILLUSTRATES MINIMUM DIMENSIONS. PIT CAN BE INCREASED IN

WASHOUT PIT SHALL BE LOCATED IN AN AREA EASILY ACCESSIBLE TO CONSTRUCTION TRAFFIC.

WASHOUT PIT SHALL NOT BE LOCATED IN AREAS SUBJECT TO INUNDATION

FROM STORM WATER RUNOFF AND AT LEAST 50 FEET FROM SENSITIVE

FEATURES, STORM DRAINS, OPEN DITCHES, STREETS, OR STREAMS.

CONCRETE TRUCK WASHOUT PIT

SIZE DEPENDING ON EXPECTED FREQUENCY OF USE.


#### GENERAL NOTES:

**GENERAL NOTES:** 

THE FILTER BAG MATERIAL SHALL BE MADE OF POLYPROPYLENE, POLYETHYLENE OR POLYAMIDE WOVEN FABRIC, MIN UNIT WEIGHT OF 4 OUNCES/SY, MULLEN BURST STRENGTH EXCEEDING 300 PSI AND ULTRAVIOLET

THE FILTER BAG SHALL BE FILLED WITH CLEAN, MEDIUM TO COARSE GRAVEL (0.31 TO 0.75 INCH DIAMETER).

GRAVEL FILTER BAG DETAIL

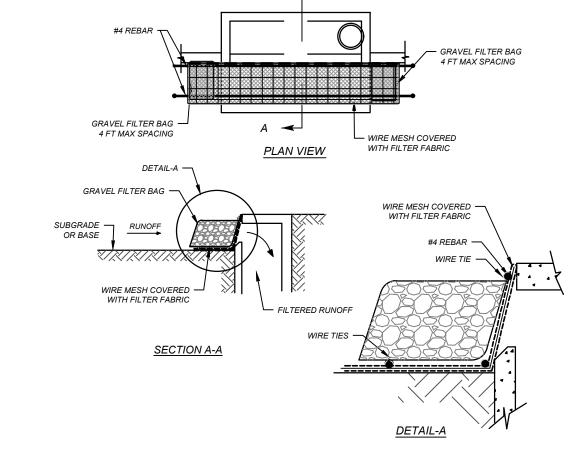

- FILTERED RUNOFF

SECTION A-A

ALL STORM DRAINAGE SYSTEMS INLETS SHOULD FILTER RUNOFF BEFORE

UNLESS TREATMENT IS PROVIDED ELSEWHERE.

THE WATER IS DISCHARGED INTO STREAMS OR ONTO ADJACENT PROPERTIES.

IF NO ADDITIONAL DOWNSTREAM TREATMENT EXISTS, THE MAXIMUM DRAINAGE AREA TRIBUTARY TO AN AREA DRAIN INSTALLED WITH A GRAVEL FILTER SHOULD BE ONE ACRE.

MATERIAL IS WITHIN THREE INCHES OF THE TOP OF THE CONCRETE BLOCKS.

PERIODICALLY, THE GRAVEL SHOULD BE RAKED TO INCREASE INFILTRATION AND

CURB INLET PROTECTION GRAVEL FILTER BAGS

ALL CURB INLET GRAVEL FILTERS SHOULD BE INSPECTED AND REPAIRED

AFTER FACH RUNOFF EVENT, SEDIMENT SHOULD BE REMOVED WHEN

Vertical spacing

face of the slope

varies between

10' and 20'

measured along the

TYPICAL FIBER ROLL INSTALLATION

ENTRENCHMENT DETAIL

**CURB INLET PROTECTION (ALTERNATE)** 

TON THE CHANNEL BOTTOM AND ON THE SIDES UP TO 1/3 THE DEPTH OF CHANNEL.

/EXIT

TYPICAL CONSTRUCTION STAGING AREA

FLOW ARROWS

OFFICE

CHANNEL LINING

TYPE 4 SACK GABIONS

FILTER FABRIC MATERIAL SHOULD MEET THE FOLLOWING

SPECIFICATIONS: RESISTANT TO ULTRAVIOLET LIGHT. FABRIC SHOULD BE NON-WOVEN GEOTEXTILE WITH MINIMUM WEIGHT OF 3.5 OUNCES PER SQUARE YARD, MINIMUM MULLEN BURST STRENGTH O 200 POUNDS PER SQUARE INCH AND A FLOW THRU RATE OF 120 GALLONS PER MINUTE PER SQUARE FOOT OF FRONTAL AREA. STONE SIZE: ±4"-8" OPEN GRADED CRUSHED LIMESTONE. INSPECT WEEKLY OR AFTER EACH RAINFALL EVENT AND REPAIR OR REPLACE AS NEEDED.

THE TOP OF THE SACK GABIONS SHOULD BE LEVEL AND ORIENTED PERPENDICULAR TO THE DIRECTION OF FLOW.

FILTER FABRIC MATERIAL SHALL BE FASTENED TO WOVEN WIRE

NATURAL GROUND. SILT SHALL BE REMOVED AND DISPOSED IN AN APPROVED MANNER THAT WILL NOT CONTRIBUTE TO RESILTATION CONTAMINATED SEDIMENT MUST BE REMOVED AND DISPOSED OF OFF-SITE IN ACCORDANCE WITH APPLICABLE REGULATIONS.

& Design