

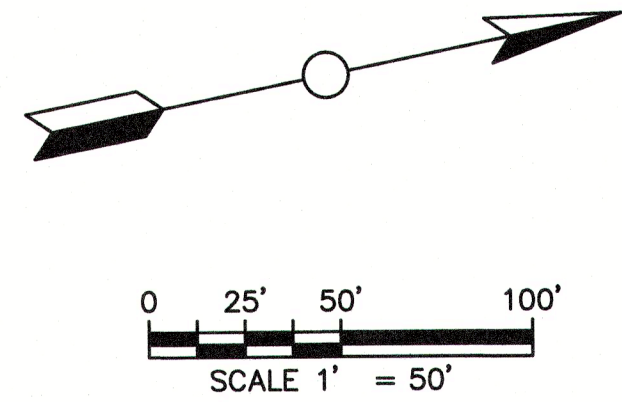


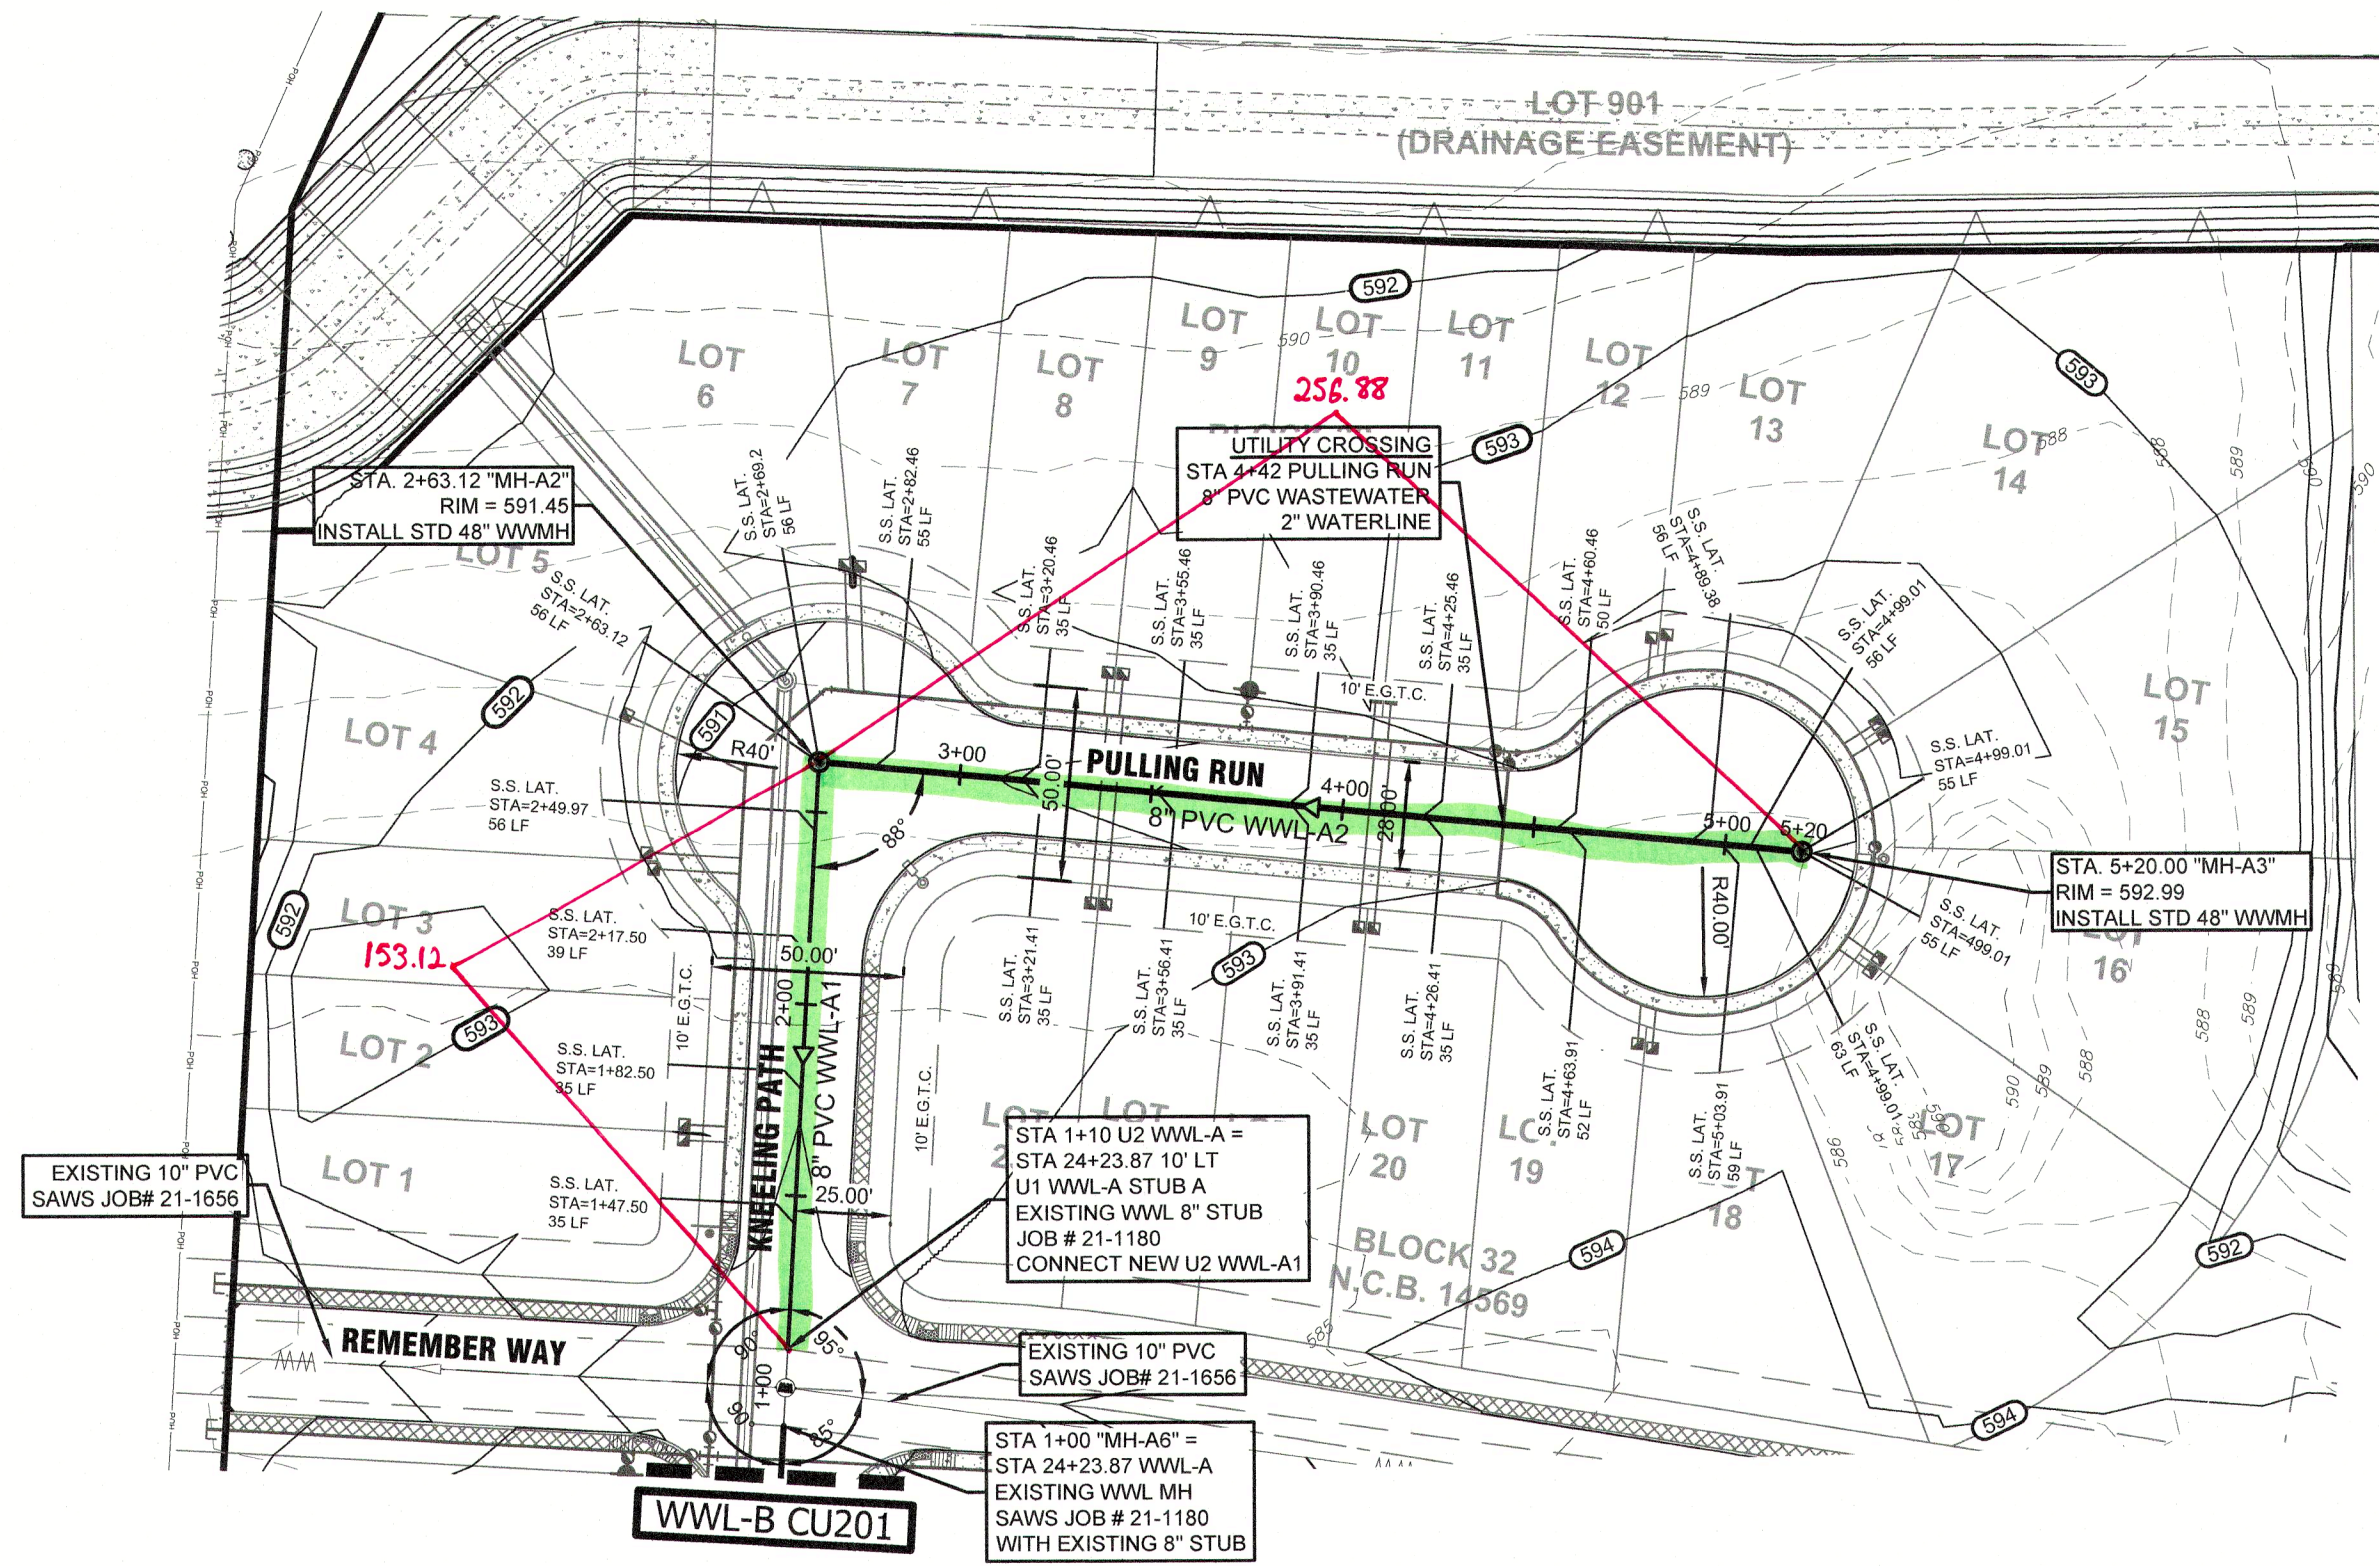

| LEGEND |                                          |
|--------|------------------------------------------|
|        | BOUNDARY / RIGHT OF WAY                  |
|        | EASEMENT / SETBACK                       |
|        | CURB / EDGE OF PAVEMENT                  |
|        | SIDEWALK (HOME BUILDER'S RESPONSIBILITY) |
|        | SIDEWALK (DEVELOPER'S RESPONSIBILITY)    |
|        | EXIST. GRADE ELEVATIONS                  |
|        | PROP. GRADE ELEVATIONS                   |
|        | EXISTING WATER LINE                      |
|        | PROPOSED WATER LINE                      |
|        | EXISTING OVERHEAD UTILITIES              |
|        | EXISTING UNDERGROUND ELECTRIC            |
|        | EXISTING GAS LINE                        |
|        | PROPOSED DRAINAGE                        |
|        | PROPOSED WASTEWATER LINE                 |
|        | EXISTING WASTEWATER LINE                 |
|        | TOP OF STACK                             |
|        | EXISTING UTILITY POLE                    |
|        | EXISTING WASTEWATER MANHOLE              |
|        | PROPOSED DRAINAGE JUNCTION BOX           |
|        | EXISTING FIRE HYDRANT                    |
|        | PROPOSED FIRE HYDRANT                    |
|        | PROPOSED WATER VALVE                     |
|        | PROPOSED CAP/PLUG                        |
|        | EXISTING WATER METER                     |
|        | PROPOSED WATER METER                     |
|        | EXISTING GUY WIRE                        |
|        | PROPOSED WASTEWATER MANHOLE              |
|        | PROPOSED CURB INLET                      |
|        | PROPOSED 60" DRAINAGE MANHOLE            |
|        | PROPOSED STREET LIGHT                    |
|        | PROPOSED WASTEWATER LATERAL              |

WASTEWATER SHEET NOTES

- EXISTING CONDITIONS SURVEY WAS PREPARED BY WESTWOOD PROFESSIONAL SERVICES, INC. IN MAY, OF 2020.
- REFERENCE COVER SHEET FOR ADDITIONAL SITE INFORMATION.
- REFERENCE SHEET C012, GENERAL NOTES FOR ADDITIONAL SITE NOTES.
- LIMITS OF CONSTRUCTION ARE SHOWN ON THE EROSION & SEDIMENTATION CONTROL PLAN, REFERENCE SHEET ###.
- REFERENCE SHEET CU100 FOR OVERALL UTILITY LAYOUT.
- LOCATION OF EXISTING UTILITIES, SOME OF WHICH MAY NOT BE SHOWN, COULD IMPACT CONSTRUCTION MEANS AND METHODS. CONTRACTOR TO VERIFY ALL EXISTING UTILITIES VERTICALLY AND HORIZONTALLY PRIOR TO BID AND CONSTRUCTION, AND SHALL NOTIFY THE ENGINEER IMMEDIATELY OF ANY DISCREPANCIES. THE CONTRACTOR TO CONTACT THE AREA "ONE CALL" SYSTEM @ 811, OR THE OWNER OF EACH INDIVIDUAL UTILITY FOR ASSISTANCE IN DETERMINING EXISTING UTILITY LOCATIONS.
- CONTRACTOR TO SHALL EXPOSE ALL EXISTING UTILITIES CROSSING PROPOSED GRAVITY LINES AND INSURE THERE WILL BE NO CONFLICT PRIOR TO BEGINNING CONSTRUCTION. ADDITIONALLY, CONTRACTOR TO PLAN UTILITY INSTALLATIONS IN A MANNER TO AVOID CONFLICTS WITH PROPOSED GRAVITY LINES.
- THE SIZE AND LOCATION OF UTILITY STRUCTURES (IF SHOWN) MAY BE EXAGGERATED FOR GRAPHICAL CLARITY. THE SURVEY SHOWS FIELD MEASURED SIZES AND DEPTHS AS OBSERVED FROM GROUND LEVEL OPENINGS.
- ON ALL GRAVITY LINES, CONTRACTOR MUST START AT DOWNSTREAM END AND PROCEED UPSTREAM TAKING CARE TO EXPOSE ALL EXISTING UTILITIES AND STRUCTURES WHICH MAY CONFLICT WITH THE PROPOSED LINE. ANY OTHER SEQUENCE OF CONSTRUCTION WILL BE AT THE CONTRACTOR'S RISK.
- THERE ARE NO EXISTING HERITAGE TREES ON THE SITE.
- ALL ITEMS ARE TO BE FURNISHED & INSTALLED BY CONTRACTOR. REFERENCE CONSTRUCTION DETAILS SHEETS FOR ADDITIONAL INFORMATION.
- AFTER ALL WASTE WATER CONSTRUCTION HAS BEEN COMPLETED, FINAL STABILIZATION OF THE CONSTRUCTION AREA ON ALL UNPAVED AREAS AND AREAS NOT COVERED BY PERMANENT STRUCTURES SHALL BE COMPLETED BY EVENLY DISTRIBUTING SEEDING AND WATERING TO A MIN. 70% OF THE NATIVE BACKGROUND VEGETATIVE COVER.
- ALL WASTE WATER MANHOLES SHALL BE CONSTRUCTION IN ACCORDANCE WITH THE SAWS SPECIFICATIONS FOR WATER AND SANITARY SEWER CONSTRUCTION (LATEST EDITION).
- ALL WASTE WATER PRECAST MANHOLES SHALL BE SUPPLIED BY A SAWS APPROVED MANUFACTURER.
- CONTRACTOR SHALL PROVIDE MANUFACTURED STUB OUT CAP & PLUG TO MEET 30 TAC 213.5(3)(G) STANDARDS AND TO MEET ASTM D3034 SPECIFICATIONS UNLESS OTHERWISE NOTED.
- ALL RESIDENTIAL WASTE WATER SERVICE LATERALS ARE 6" DIA. AND 35 FEET IN LENGTH UNLESS OTHERWISE NOTED. PIPE JOINTS TO BE SDR 26 PER ASTM D3139 SPECIFICATIONS.
- ALL WASTE WATER LATERALS WHICH CROSS WATER LINES ARE TO HAVE A MINIMUM OF A SINGLE LENGTH OF SDR 26/AST D2241-09, PRESSURE RATED 150 PSI) PIPE, CENTERED ON THE WATERLINE SUCH THAT EACH WASTE WATER JOINT IS A MINIMUM OF NINE FEET FROM THE WATERLINE.
- ALL WASTE WATER PIPE TO BE SDR 26 PER ASTM D3034 SPECIFICATIONS UNLESS OTHERWISE NOTED. PIPE JOINTS TO BE SDR 26 PER ASTM D3139 SPECIFICATIONS.
- ALL WASTE WATER LATERALS SHALL BE EXTENDED TO THE BACK OF THE 10' E.G.T.C. AND CAPPED AND SEALED.
- WASTE WATER LATERALS TO LOTS THAT SLOPE AWAY FROM THE STREET SHALL BE SLOPED FROM THE TEE OR STACK AT 2% TO THE PROPERTY LINE.
- ALL SITE DIMENSIONS ARE TO FACE OF CURB, CENTER OF PIPE, CENTER OF STRIPING, AND PROPERTY LINE UNLESS OTHERWISE NOTED.
- CONTRACTOR AND/OR CONTRACTOR'S INDEPENDENTLY RETAINED EMPLOYEE OR STRUCTURAL DESIGN / GEOTECHNICAL / SAFETY / EQUIPMENT CONSULTANT, IF ANY, SHALL REVIEW THESE PLANS AND AVAILABLE GEOTECHNICAL INFORMATION AND THE ANTICIPATED INSTALLATION SITE(S) WITHIN THE PROJECT WORK AREA IN ORDER TO IMPLEMENT CONTRACTOR'S TRENCH EXCAVATION SAFETY PROTECTION SYSTEMS, PROGRAMS AND/OR PROCEDURES FOR THE PROJECT DESCRIBED IN THE CONTRACT DOCUMENTS. THE CONTRACTOR'S IMPLEMENTATION OF THESE SYSTEMS, PROGRAMS AND/OR PROCEDURES SHALL PROVIDE FOR ADEQUATE TRENCH EXCAVATION SAFETY PROTECTION THAT COMPLY WITH AS A MINIMUM, OSHA STANDARDS FOR TRENCH EXCAVATIONS, SPECIFICALLY CONTRACTOR AND/OR CONTRACTOR'S INDEPENDENTLY RETAINED EMPLOYEE OR SAFETY CONSULTANT SHALL IMPLEMENT A TRENCH SAFETY PROGRAM IN ACCORDANCE WITH OSHA STANDARDS GOVERNING THE PRESENCE AND ACTIVITIES OF INDIVIDUALS WORKING IN AND AROUND TRENCH EXCAVATION.
- THE UNDERGROUND UTILITIES SHOWN HAVE BEEN LOCATED FROM FIELD SURVEY INFORMATION AND EXISTING DRAWINGS. THE ENGINEER MAKES NO GUARANTEE THAT THE UNDERGROUND UTILITIES COMPRISE ALL SUCH UTILITIES IN THE AREA, EITHER IN SERVICE OR ABANDON. THE ENGINEER FURTHER DOES NOT WARRANT THAT THE UNDERGROUND UTILITIES SHOWN ARE IN THE EXACT LOCATION INDICATED. THE ENGINEER HAS NOT PHYSICALLY LOCATED THE UNDERGROUND UTILITIES.
- REFERENCE CONSTRUCTION DETAILS FOR ADDITIONAL INFORMATION ON DRAINAGE STRUCTURES & APPURTENANCES. CONTRACTOR TO REFER TO SAWS STANDARD DETAILS FOR ALL SAWS APPURTENANCES AND STRUCTURES.
- CONTRACTOR TO REPAIR AND/OR REPLACE ALL DAMAGED SIDEWALKS AND CURBS AROUND SITE IN ACCORDANCE WITH THE [CITY OF SAN ANTONIO] STANDARD DETAILS AND SPECIFICATIONS.

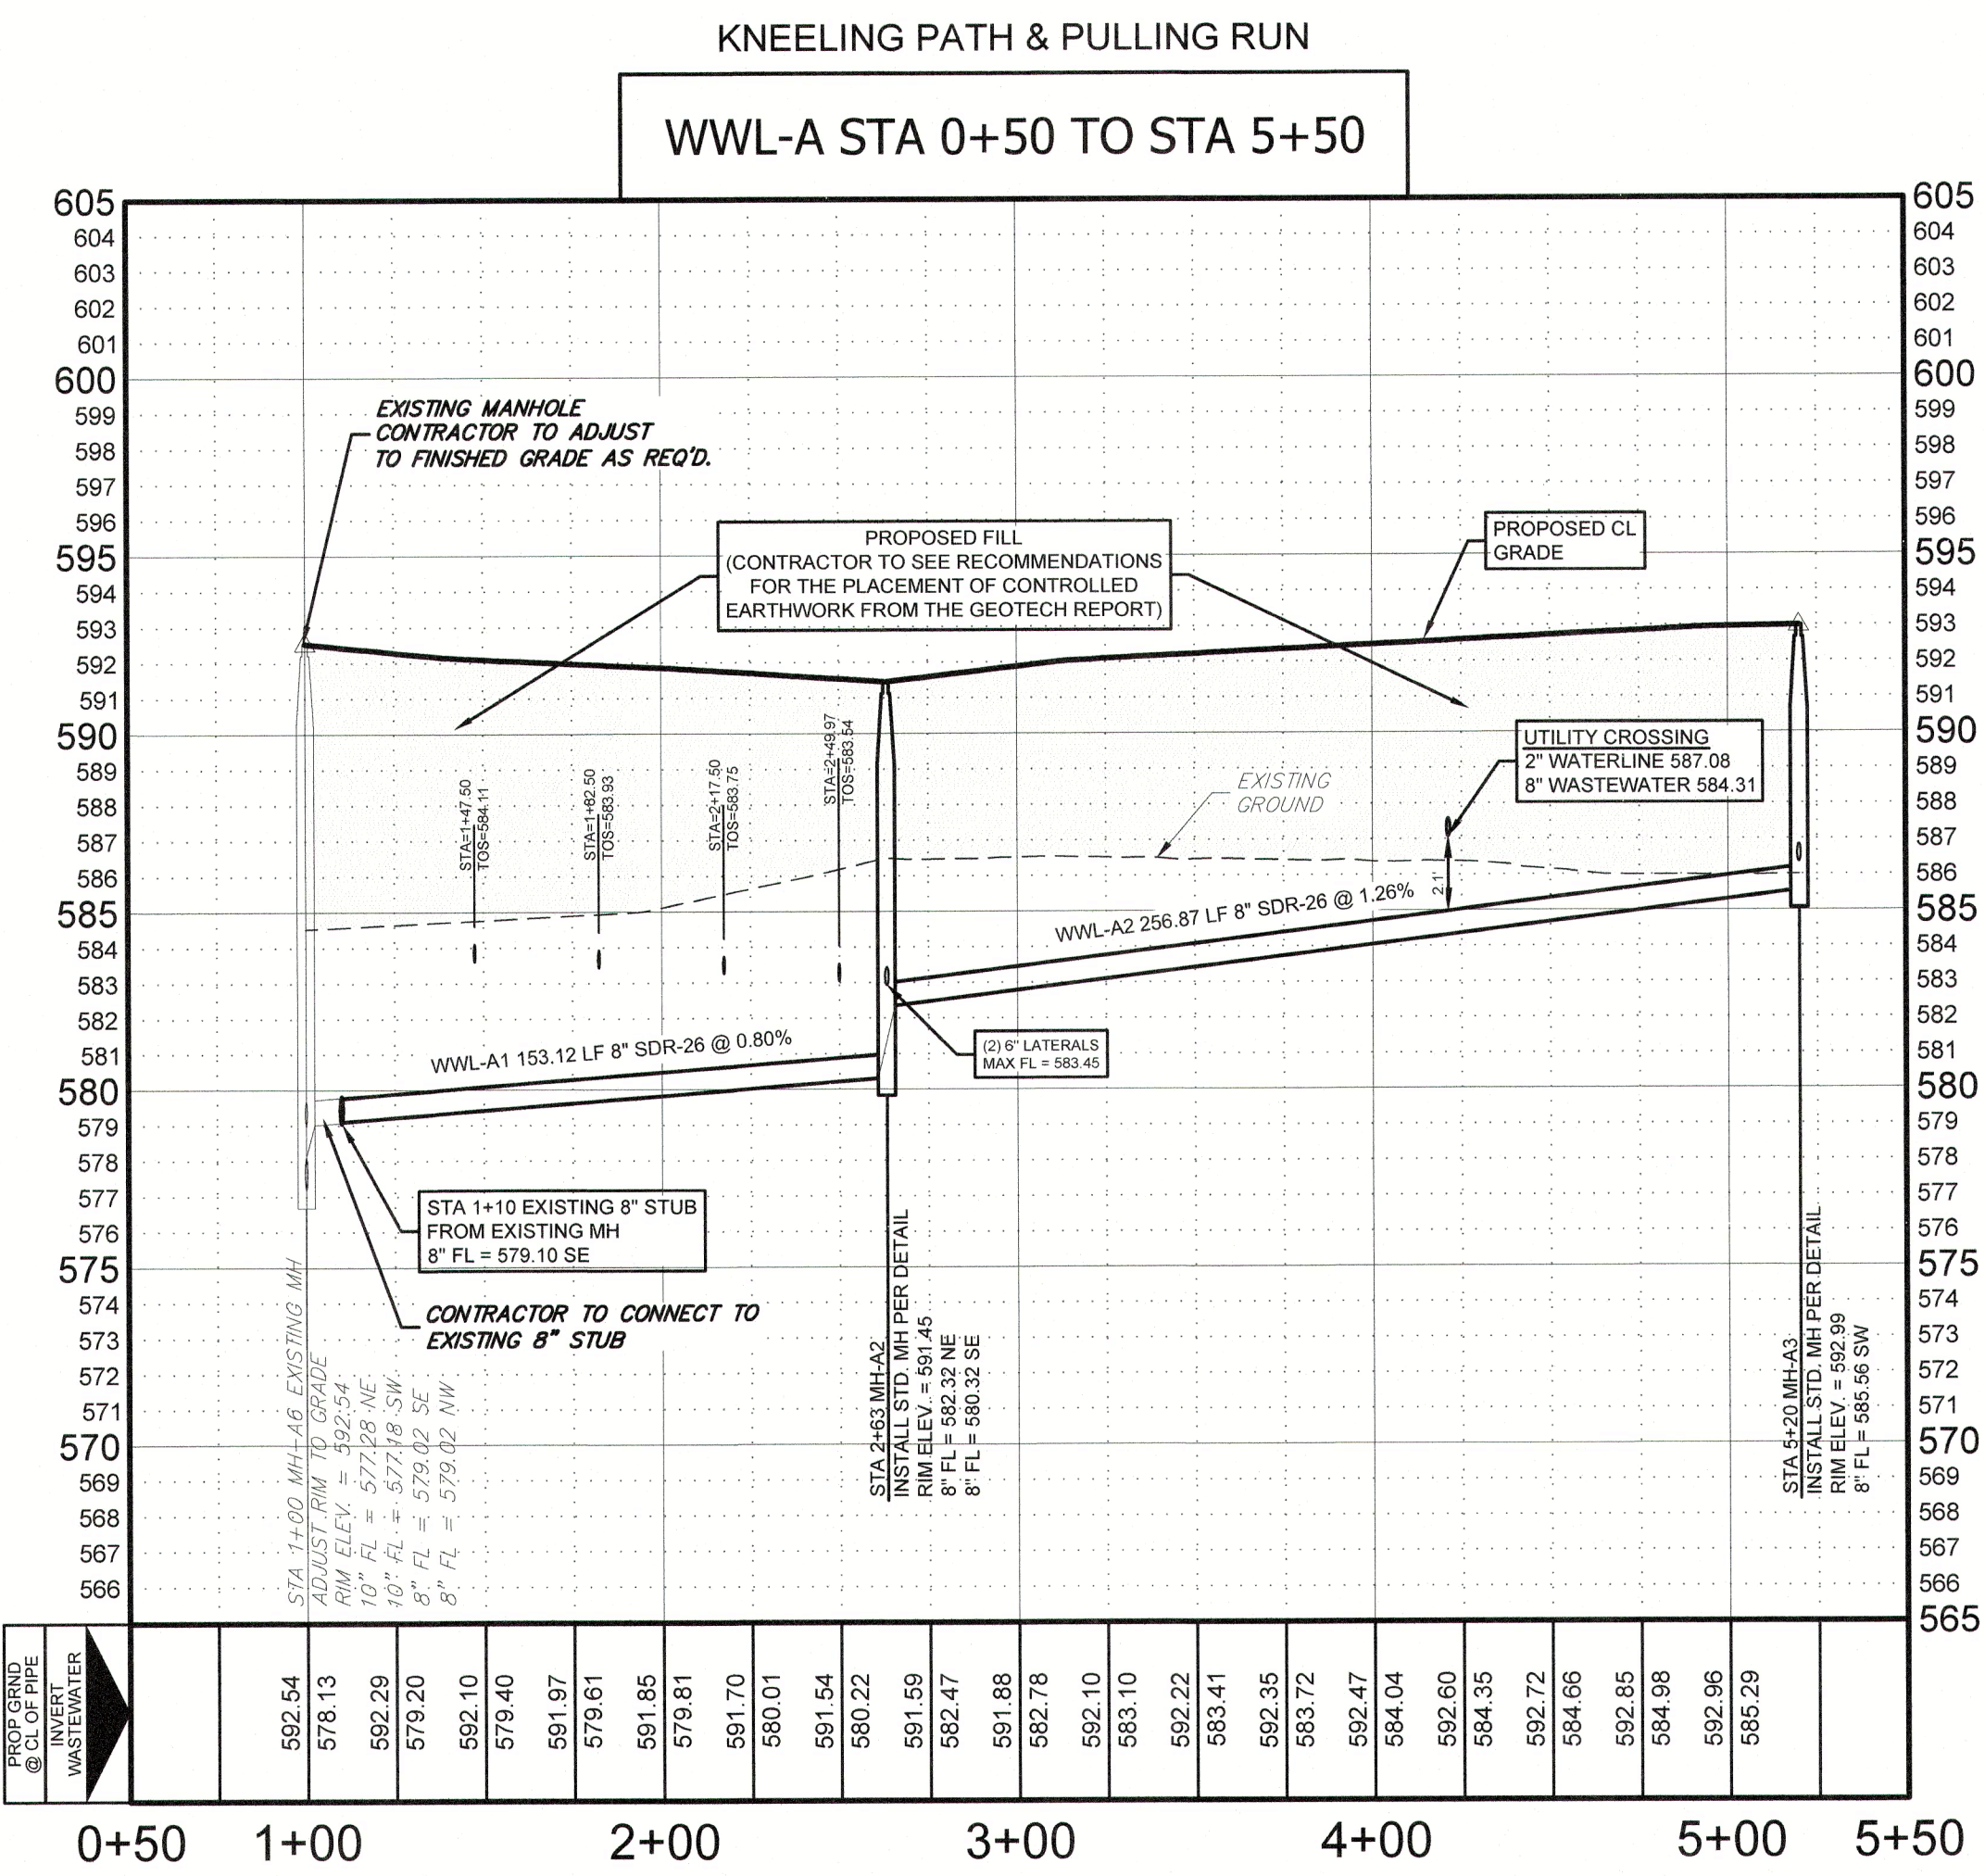

5'  
2.5'  
0'  
VERT. SCALE  
SCALE:  
1"=5' VERT.  
1"=50' HORIZ.

1 REVISED SHEET

|                                                            |              |
|------------------------------------------------------------|--------------|
| UPPER MEDINA RIVER WATERSHED - DOS RIOS W.R.C.             |              |
| Developer: LENNAR HOMES OF TEXAS LAND & CONSTRUCTION, LTD. |              |
| Address: 100 NE LOOP 410, SUITE 1155                       |              |
| City: SAN ANTONIO                                          | State: TEXAS |
| Phone: _____                                               | Fax: _____   |
| SAWS Block Map: 122-536                                    |              |
| Total EDUs: 195                                            |              |
| Total Acreage: 33.62                                       |              |
| Total Linear Footage of Pipe: 4,734 L.F. 8" PVC            |              |
| 4,494 L.F. 6" PVC                                          |              |
| Plat No.: 22-11800251                                      |              |
| Number of Lots: 4 N.S.F.                                   |              |
| SAWS Job No.: 22-1656                                      |              |

CAUTION!!!  
CONTRACTOR TO VERIFY ALL EXISTING UTILITIES VERTICALLY AND HORIZONTALLY PRIOR TO CONSTRUCTION. CONTRACTOR TO NOTIFY THE ENGINEER IMMEDIATELY OF ANY DISCREPANCIES. THE ENGINEER ASSUMES NO RESPONSIBILITY FOR THE ACCURACY OF THE LOCATION OF UNDERGROUND UTILITIES. THE CONTRACTOR SHALL BE RESPONSIBLE FOR AVOIDING ALL EXISTING UTILITIES BY CALLING DISTRESS @ 1-800-DIG-TESS FOR LOCATION OF ALL UTILITIES, AT LEAST 2 WORKING DAYS PRIOR TO BEGINNING CONSTRUCTION.

LENNAR HOMES OF TEXAS  
LAND & CONSTRUCTION, LTD.  
100 NE LOOP 410, SUITE 1155  
SAN ANTONIO, TEXAS 78216

VALLE SOL UNIT 2 SUBDIVISION  
PLAT NO. 22-11800251  
WASTEWATER LINE A

| REV | DATE    | DESCRIPTION                           |
|-----|---------|---------------------------------------|
| 1   | 11/7/24 | GRADING REVISIONS & VALUE ENGINEERING |

DESIGNED BY: JOS/TS  
DRAFTED BY: JOS  
CHECKED BY: NFU/RRP

SHEET  
CU200  
61 OF 75



UP  
ENGINEERING  
+ SURVEYING  
11903 JONES MALBERGER, SUITE 102  
SAN ANTONIO, TEXAS 78220  
WWW.JPEENGINEERING.COM  
TEL 771-771-1792  
FAX 771-771-1792

FILE NAME: U:\PROJECTS\196 - VALLE SOL UNIT 2\DESIGN\DWG\SHEET\196-2 - CU200 WASTEWATER LINE A.DWG  
LAST MODIFIED BY: J. P. JONES  
LAST PLOTTED BY: J. P. JONES  
PLOT DATE: 11/19/24  
PLOT TITLE: 196-2 - CU200 WASTEWATER LINE A.DWG




# UPPER MEDINA RIVER WATERSHED - DOS RIOS W.R.C.

Developer: LENNAR HOMES OF TEXAS LAND & CONSTRUCTION, LTD.  
 Address: 100 NE LOOP 410, SUITE 1155  
 City: SAN ANTONIO State: TEXAS Zip: 78216  
 Phone: Fax:  
 SAWS Block Map: 122-536 Total EDUs: 195 Total Acreage: 33.62  
 Total Linear Footage of Pipe: 4,734 L.F. 8" PVC 6,494 L.F. 8" PVC  
 Number of Lots: 195 S.F. 4 N.S.F. SAWS Job No.: 22-11800251  
 22-1656

1 REVISED SHEET

0 25' 50' 100'  
 SCALE 1" = 50'

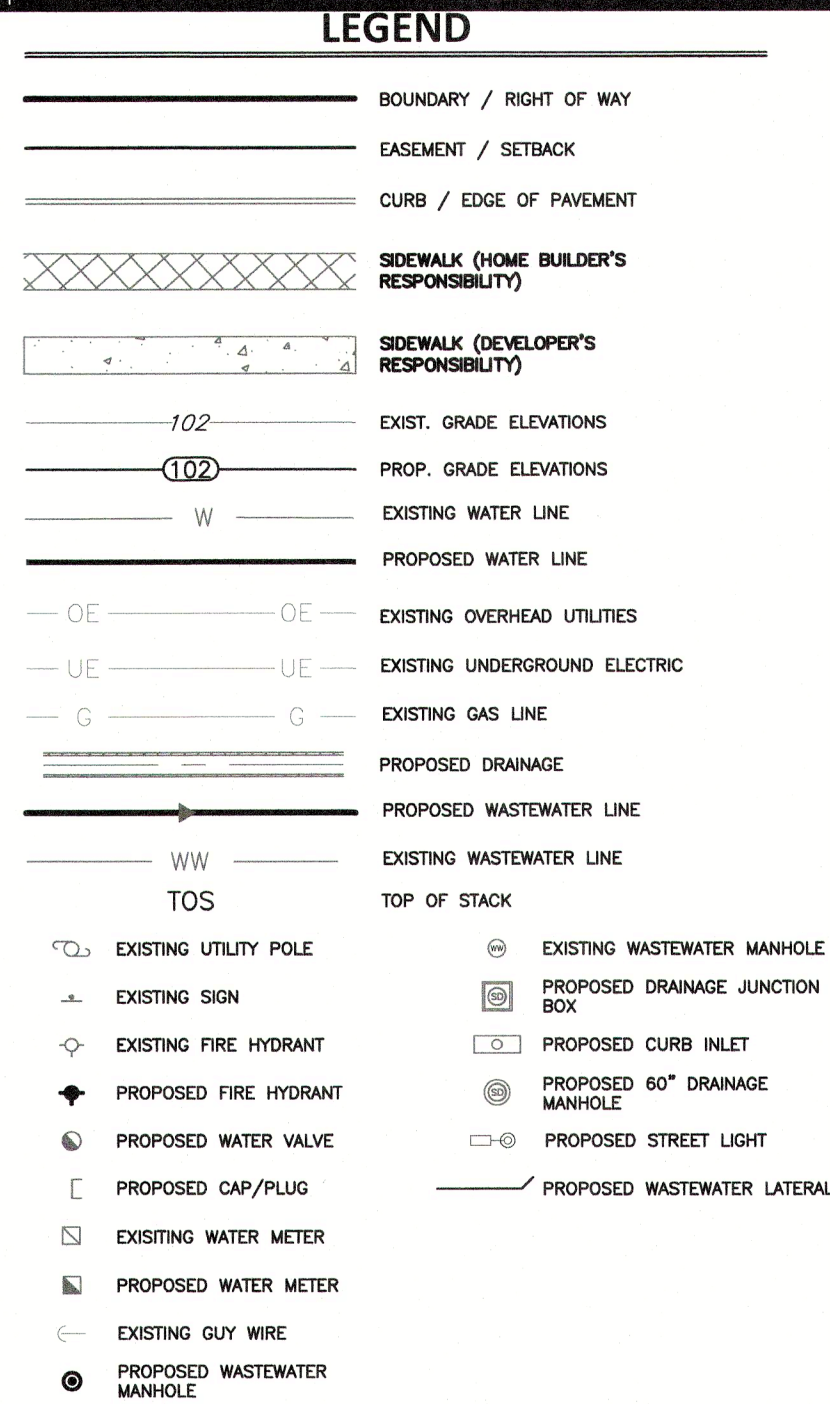

LENNAR HOMES OF TEXAS  
 LAND & CONSTRUCTION, LTD.  
 100 NE LOOP 410, SUITE 1155  
 SAN ANTONIO, TEXAS 78216

## WASTEWATER SHEET NOTES

- EXISTING CONDITIONS SURVEY WAS PREPARED BY WESTWOOD PROFESSIONAL SERVICES, INC. IN MAY, OF 2020.
- REFERENCE COVER SHEET FOR ADDITIONAL SITE INFORMATION.
- REFERENCE SHEET C012, GENERAL NOTES FOR ADDITIONAL SITE NOTES.
- LIMITS OF CONSTRUCTION ARE SHOWN ON THE EROSION & SEDIMENTATION CONTROL PLAN, REFERENCE SHEET ###.
- REFERENCE SHEET CU000 FOR OVERALL UTILITY LAYOUT.
- LOCATION OF EXISTING UTILITIES, SOME OF WHICH MAY NOT BE SHOWN, COULD IMPACT CONSTRUCTION MEANS AND METHODS. CONTRACTOR TO VERIFY ALL EXISTING UTILITIES VERTICALLY AND HORIZONTALLY PRIOR TO BID AND CONSTRUCTION, AND SHALL NOTIFY THE ENGINEER IMMEDIATELY OF ANY DISCREPANCIES. THE CONTRACTOR TO CONTACT THE AREA "ONE CALL" SYSTEM @ 811, OR THE OWNER OF EACH INDIVIDUAL UTILITY FOR ASSISTANCE IN DETERMINING EXISTING UTILITY LOCATIONS.
- CONTRACTOR SHALL EXPOSE ALL EXISTING UTILITIES CROSSING PROPOSED GRAVITY LINES AND INSURE THERE WILL BE NO CONFLICT PRIOR TO BEGINNING CONSTRUCTION. ADDITIONALLY, CONTRACTOR TO PLAN UTILITY INSTALLATIONS IN A MANNER TO AVOID CONFLICTS WITH PROPOSED GRAVITY LINES.
- THE SIZE AND LOCATION OF UTILITY STRUCTURES (IF SHOWN) MAY BE EXAGGERATED FOR GRAPHICAL CLARITY. THE SURVEY SHOWS FIELD MEASURED SIZES AND DEPTHS AS OBSERVED FROM GROUND LEVEL OPENINGS.
- ON ALL GRAVITY LINES, CONTRACTOR MUST START AT DOWNSTREAM END AND PROCEED UPSTREAM TAKING CARE TO EXPOSE ALL EXISTING UTILITIES AND STRUCTURES WHICH MAY CONFLICT WITH THE PROPOSED LINE. ANY OTHER SEQUENCE OF CONSTRUCTION WILL BE AT THE CONTRACTOR'S RISK.
- THERE ARE NO EXISTING HERITAGE TREES ON THE SITE.
- ALL ITEMS ARE TO BE FURNISHED & INSTALLED BY CONTRACTOR. REFERENCE CONSTRUCTION DETAILS SHEETS FOR ADDITIONAL INFORMATION.
- AFTER ALL WASTE WATER CONSTRUCTION HAS BEEN COMPLETED, FINAL STABILIZATION OF THE CONSTRUCTION AREA ON ALL UNPAVED AREAS AND AREAS NOT COVERED BY PERMANENT STRUCTURES SHALL BE COMPLETED BY EVENLY DISTRIBUTING SEEDING AND WATERING TO A MIN. 70% OF THE NATIVE BACKGROUND VEGETATIVE COVER.
- ALL WASTE WATER MANHOLES SHALL BE CONSTRUCTION IN ACCORDANCE WITH THE SAWS SPECIFICATIONS FOR WATER AND SANITARY SEWER CONSTRUCTION (LATEST EDITION).
- ALL WASTE WATER PRECAST MANHOLES SHALL BE SUPPLIED BY A SAWS APPROVED MANUFACTURER.
- CONTRACTOR SHALL PROVIDE MANUFACTURED STUB OUT CAP & PLUG TO MEET 30 TAC 213.5(3)(G) STANDARDS AND TO MEET ASTM D3034 SPECIFICATIONS UNLESS OTHERWISE NOTED.
- ALL RESIDENTIAL WASTE WATER SERVICE LATERALS SHALL BE EXTENDED TO THE BACK OF THE 10' E.G.T.C. AND CAPPED AND SEALED.
- WASTE WATER LATERALS TO LOTS THAT SLOPE AWAY FROM THE STREET SHALL BE SLOPED FROM THE TEE OR STACK AT 2% TO THE PROPERTY LINE.
- ALL WASTE WATER PIPE TO BE SDR 26 PER ASTM D3034 SPECIFICATIONS UNLESS OTHERWISE NOTED. PIPE JOINTS TO BE SDR 26 PER ASTM D3138 SPECIFICATIONS.
- ALL WASTE WATER LINES WHICH CROSS WATER LINES ARE TO HAVE A MINIMUM OF A SINGLE LENGTH OF SDR 26 (AST D2241-09), PRESSURE RATED (150 PSI) PIPE, CENTERED ON THE WATERLINE SUCH THAT EACH WASTE WATER JOINT IS A MINIMUM OF NINE FEET FROM THE WATERLINE.
- ALL SITE DIMENSIONS ARE TO FACE OF CURB, CENTER OF PIPE, CENTER OF STRIPING, AND PROPERTY LINE UNLESS OTHERWISE NOTED.
- CONTRACTOR AND/OR CONTRACTORS INDEPENDENTLY RETAINED EMPLOYEE OR STRUCTURAL DESIGN / GEOTECHNICAL / SAFETY EQUIPMENT CONSULTANT, IF ANY, SHALL REVIEW THESE PLANS AND AVAILABLE GEOTECHNICAL INFORMATION AND THE ANTICIPATED INSTALLATION SITES) WITHIN THE PROJECT WORK AREA IN ORDER TO IMPLEMENT CONTRACTOR'S TRENCH EXCAVATION SAFETY PROTECTION SYSTEMS, PROGRAMS AND/OR PROCEDURES FOR THE PROJECT DESCRIBED IN THE CONTRACT DOCUMENTS. THE CONTRACTOR'S IMPLEMENTATION OF THESE SYSTEMS, PROGRAMS AND/OR PROCEDURES SHALL PROVIDE FOR ADEQUATE TRENCH EXCAVATION SAFETY PROTECTION THAT COMPLY WITH AS A MINIMUM, OSHA STANDARDS FOR TRENCH EXCAVATIONS, SPECIFICALLY CONTRACTOR AND/OR CONTRACTOR'S INDEPENDENTLY RETAINED EMPLOYEE OR SAFETY CONSULTANT SHALL IMPLEMENT A TRENCH SAFETY PROGRAM IN ACCORDANCE WITH OSHA STANDARDS GOVERNING THE PRESENCE AND ACTIVITIES OF INDIVIDUALS WORKING IN AND AROUND TRENCH EXCAVATION.
- THE UNDERGROUND UTILITIES SHOWN HAVE BEEN LOCATED FROM FIELD SURVEY INFORMATION AND EXISTING DRAWINGS. THE ENGINEER MAKES NO GUARANTEE THAT THE UNDERGROUND UTILITIES COMPRISE ALL SUCH UTILITIES IN THE AREA, EITHER IN SERVICE OR ABANDON. THE ENGINEER FURTHER DOES NOT GUARANTEE THE PRESENCE AND ACTIVITIES OF INDIVIDUALS WORKING IN AND AROUND TRENCH EXCAVATION.
- REFERENCE CONSTRUCTION DETAILS FOR ADDITIONAL INFORMATION ON DRAINAGE STRUCTURES & APPURTENANCES. CONTRACTOR TO REFER TO SAWS STANDARD DETAILS FOR ALL SAWS APPURTENANCES AND STRUCTURES.
- CONTRACTOR TO REPAIR AND/OR REPLACE ALL DAMAGED SIDEWALKS AND CURBS AROUND SITE IN ACCORDANCE WITH THE (CITY OF SAN ANTONIO) STANDARD DETAILS AND SPECIFICATIONS.

**CAUTION!!!**  
 CONTRACTOR TO VERIFY ALL EXISTING UTILITIES VERTICALLY AND HORIZONTALLY PRIOR TO CONSTRUCTION. CONTRACTOR TO NOTIFY THE ENGINEER IMMEDIATELY OF ANY DISCREPANCIES.  
 THE ENGINEER ASSUMES NO RESPONSIBILITY FOR THE ACCURACY OF THE LOCATION OF UNDERGROUND UTILITIES. THE CONTRACTOR SHALL BE RESPONSIBLE FOR AVOIDING ALL EXISTING UTILITIES BY CALLING DIGITSS 811-800-DIG-TESS FOR LOCATION OF ALL UTILITIES. AT LEAST 2 WORKING DAYS PRIOR TO BEGINNING CONSTRUCTION.


VALLE SOL UNIT 2 SUBDIVISION  
 PLAT NO. 22-11800251

WASTEWATER LINE B


|              |  |                                       |         |
|--------------|--|---------------------------------------|---------|
| DESIGNED BY: |  | JOS/TS                                |         |
|              |  | 1                                     | 1/17/24 |
|              |  | GRADING REVISIONS & VALUE ENGINEERING |         |
|              |  |                                       |         |
|              |  |                                       |         |
SHEET  
 CU201



62 OF 75

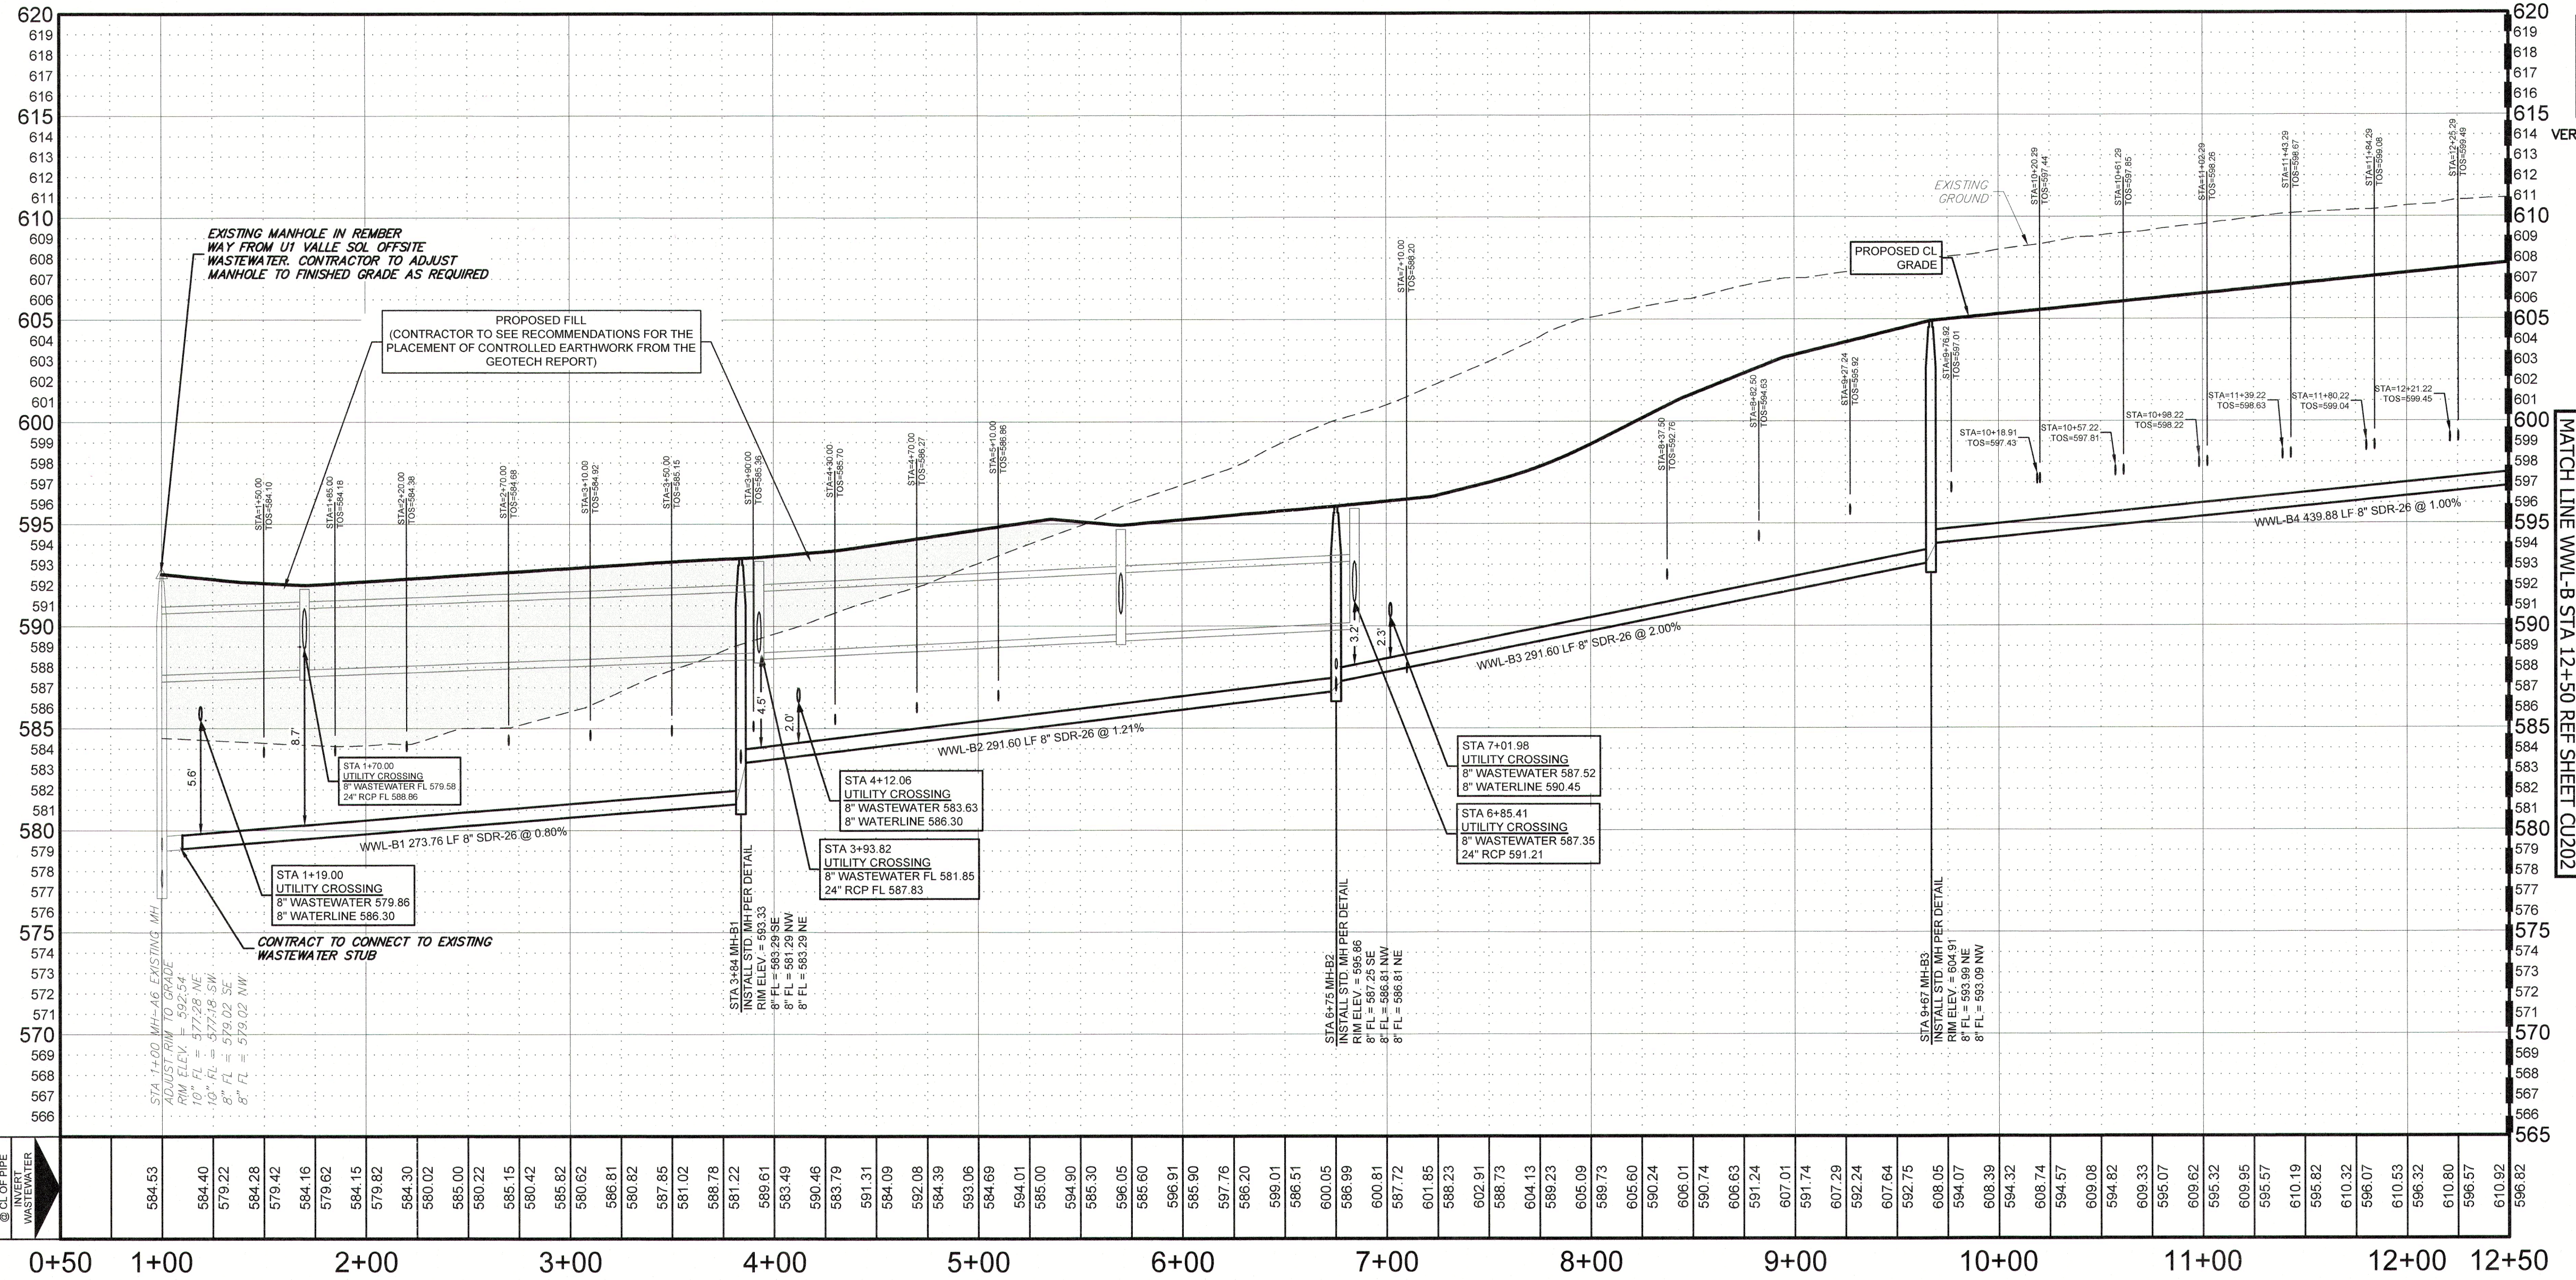



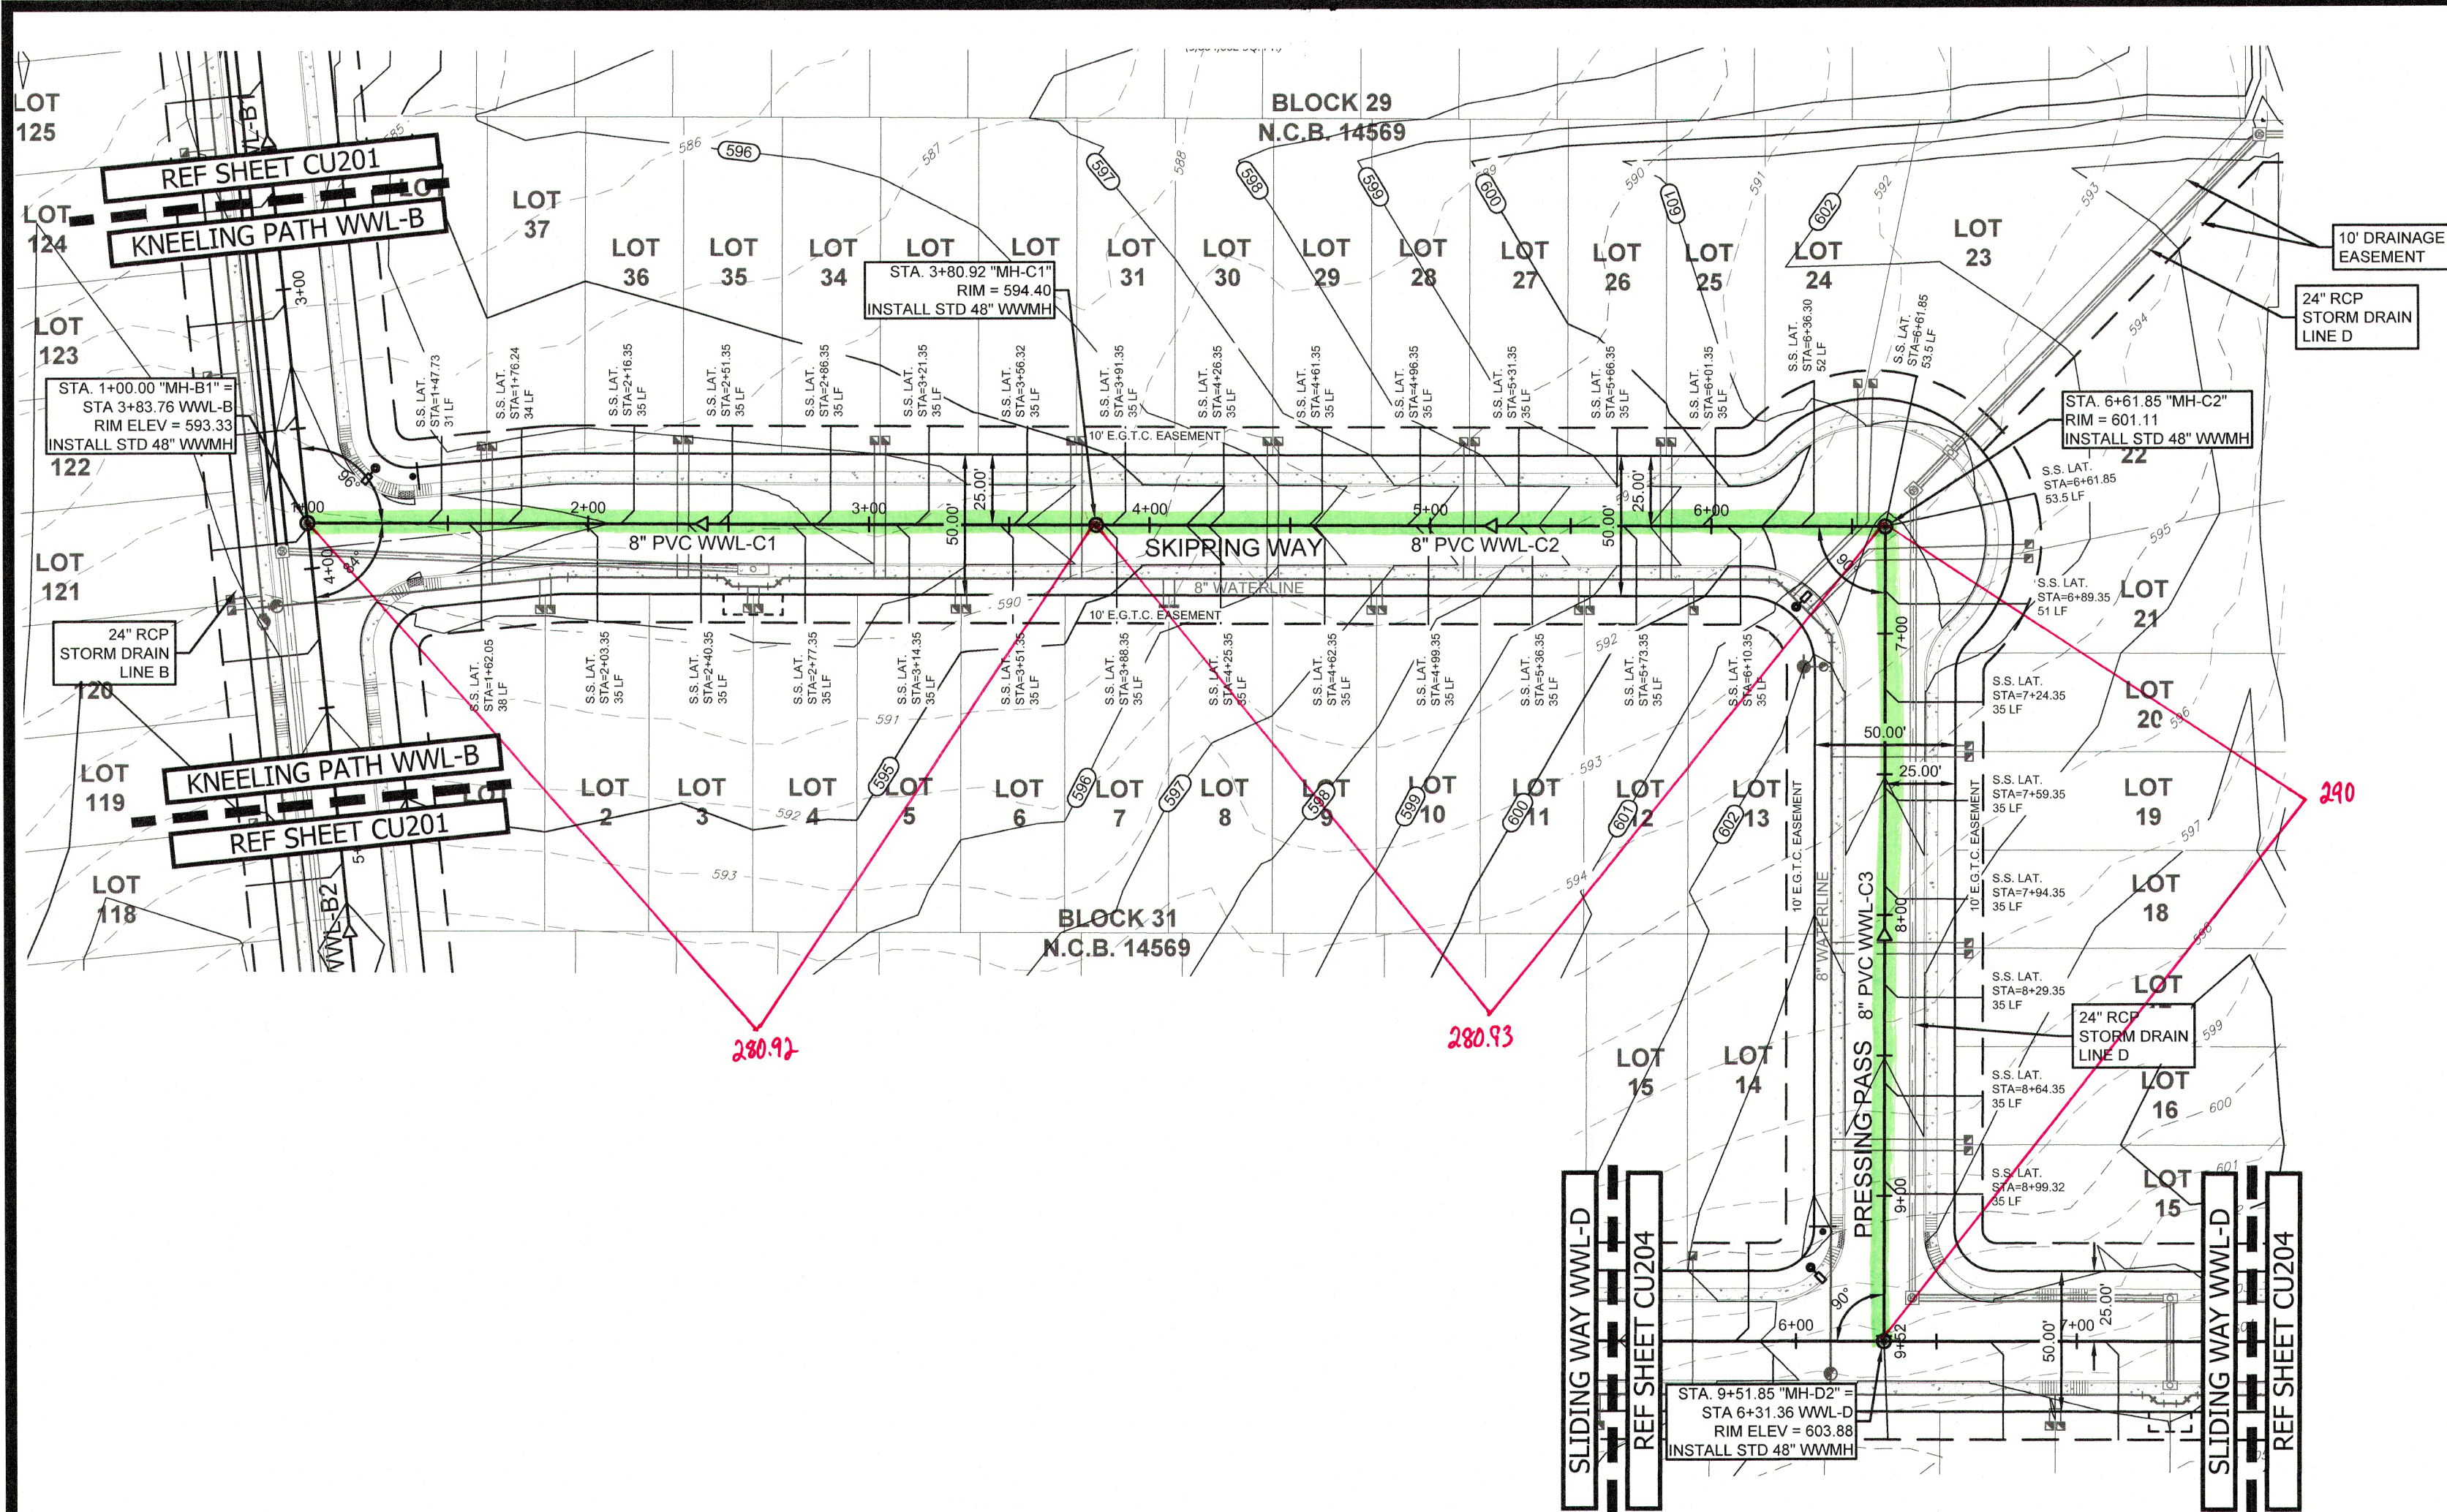

SKIPPING WAY & PRESSING PASS

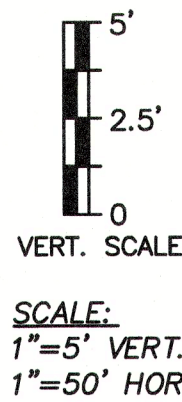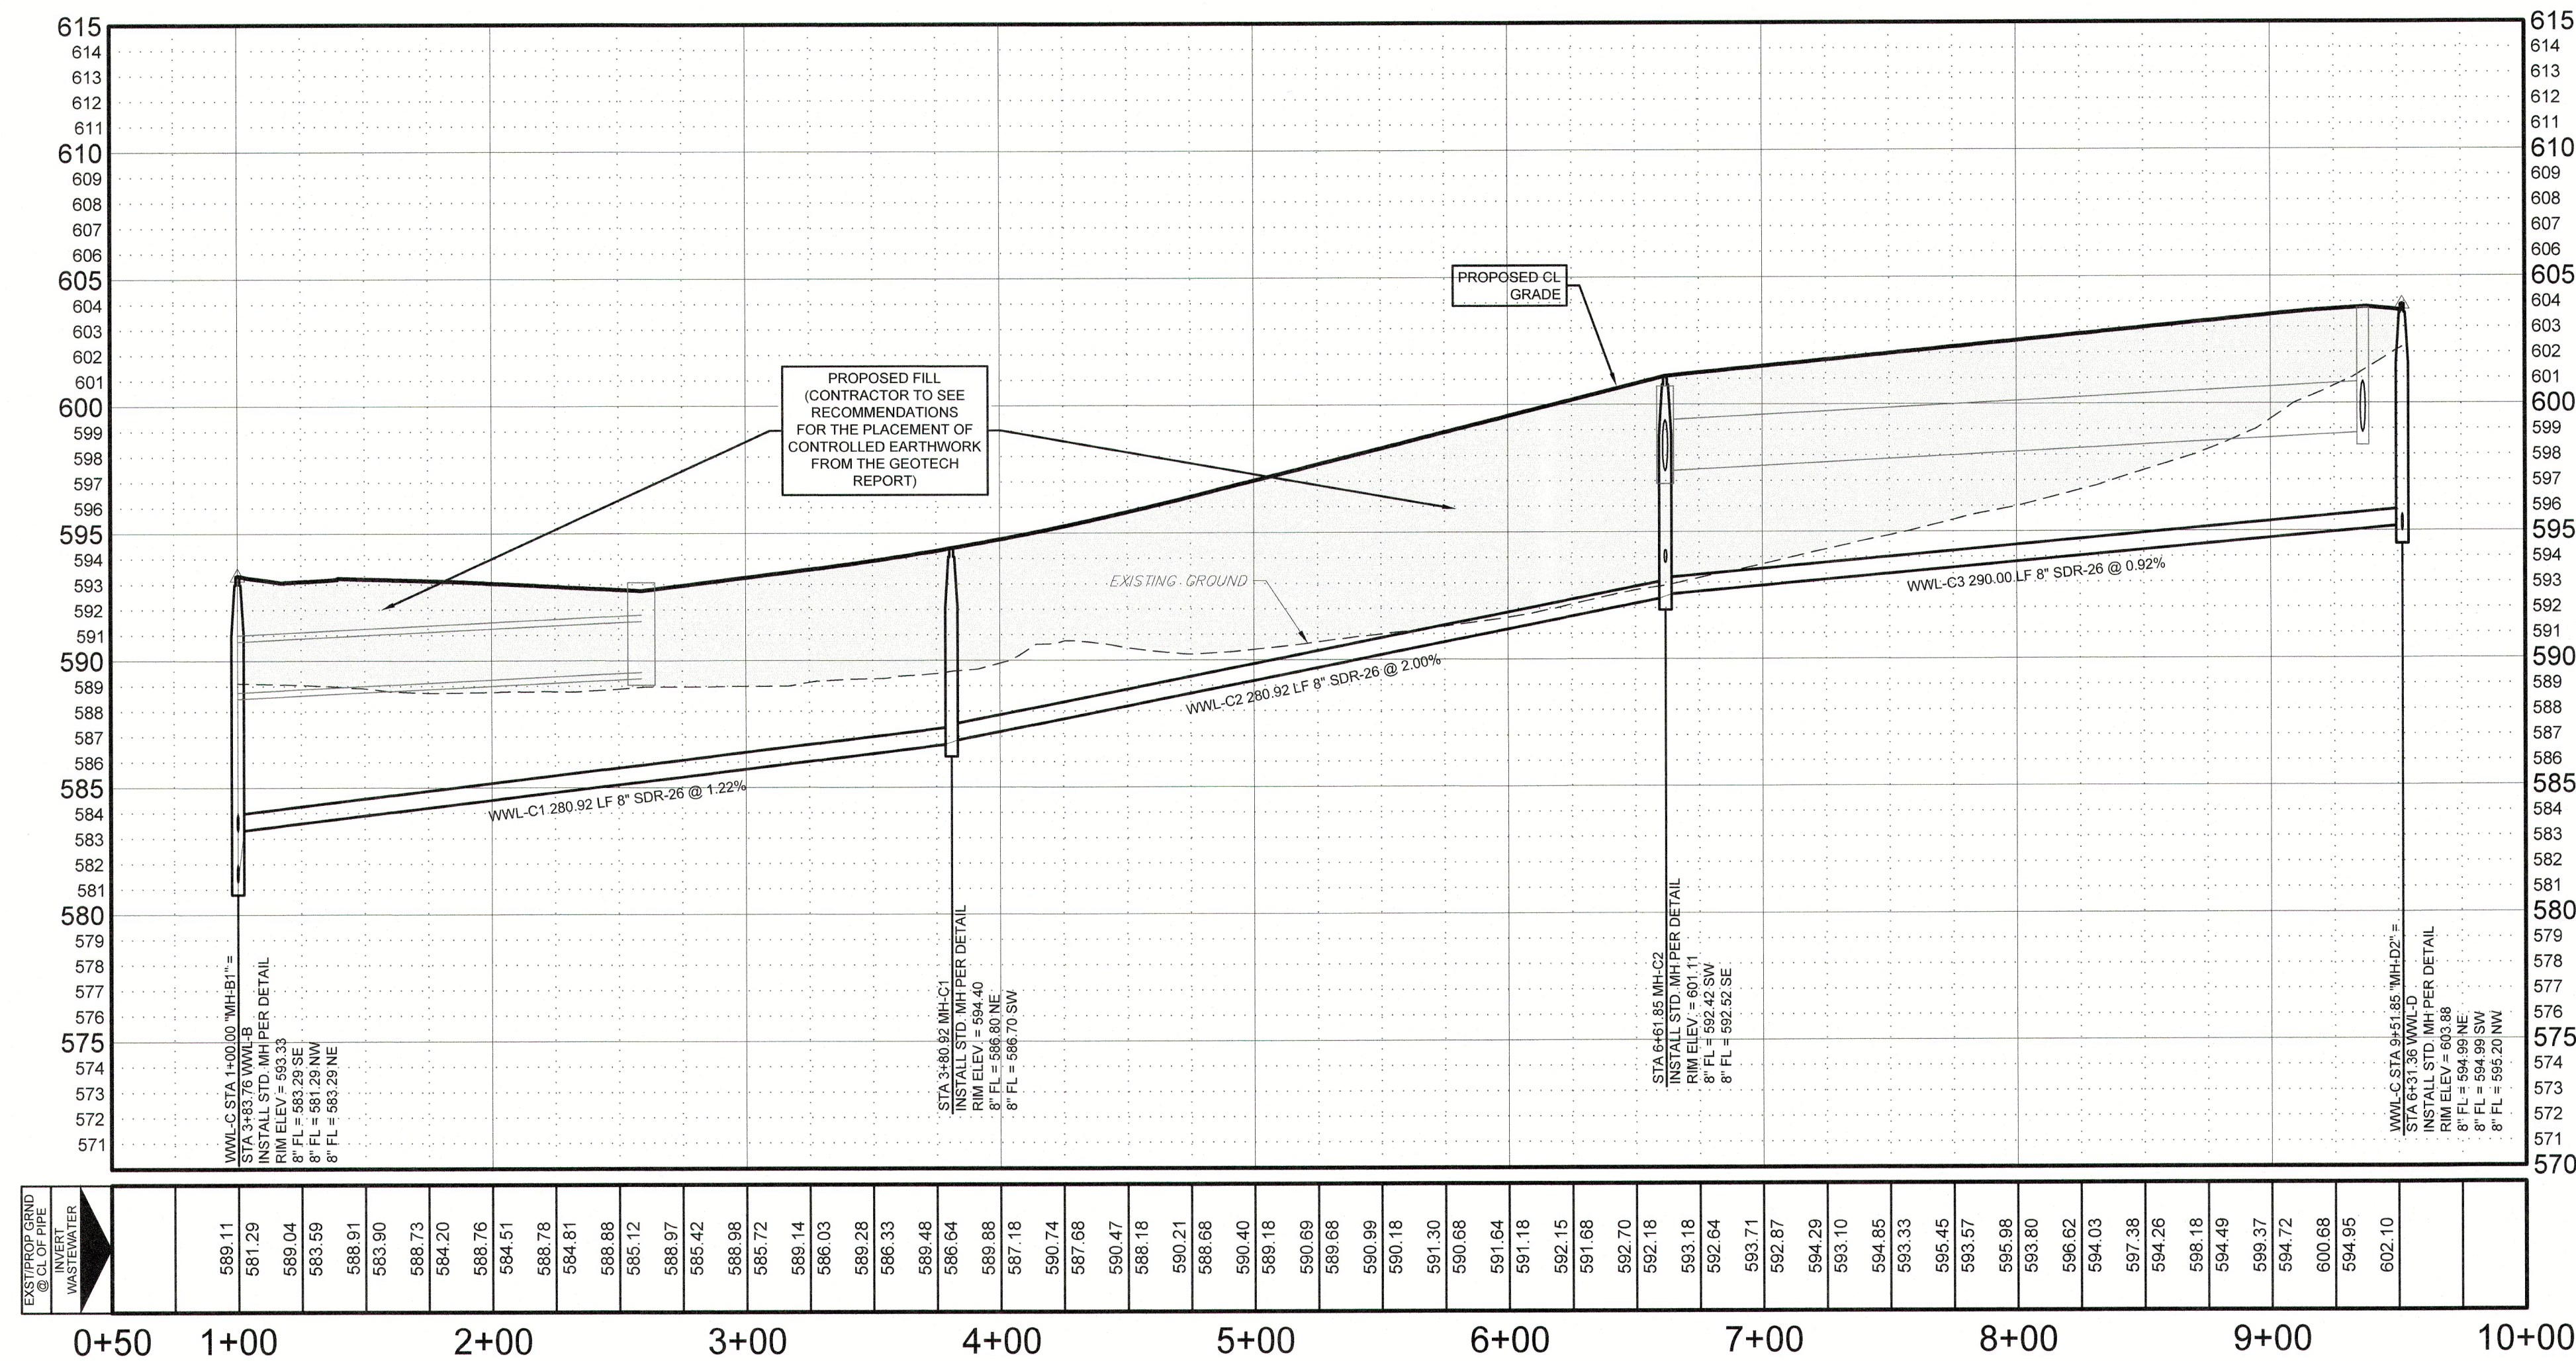

1 REVISED SHEET

UPPER MEDINA RIVER WATERSHED - DOS RIOS W.R.C.

Developer: LENNAR HOMES OF TEXAS LAND & CONSTRUCTION, LTD.

Address: 100 NE LOOP 410, SUITE 1155

City: SAN ANTONIO State: TEXAS Zip: 78216

Phone: Fax:

SAWS Block Map: 122-536 Total EDUs: 195 Total Acreage: 33.62

Total Linear Footage of Pipe: 4,734 L.F. 8" PVC 6,494 L.F. 6" PVC Plat No.: 22-11800251

Number of Lots: 195 S.F. 4 N.S.F. SAWS Job No.: 22-1656

**LEGEND**

- BOUNDARY / RIGHT OF WAY
- EASEMENT / SETBACK
- CURB / EDGE OF PAVEMENT
- SIDEWALK (HOME BUILDER'S RESPONSIBILITY)
- SIDEWALK (DEVELOPER'S RESPONSIBILITY)
- EXIST. GRADE ELEVATIONS
- PROP. GRADE ELEVATIONS
- EXISTING WATER LINE
- PROPOSED WATER LINE
- EXISTING OVERHEAD UTILITIES
- EXISTING UNDERGROUND ELECTRIC
- EXISTING GAS LINE
- PROPOSED DRAINAGE
- PROPOSED WASTEWATER LINE
- EXISTING WASTEWATER LINE
- TOP OF STACK
- EXISTING UTILITY POLE
- EXISTING SIGN
- EXISTING FIRE HYDRANT
- PROPOSED FIRE HYDRANT
- PROPOSED WATER VALVE
- PROPOSED CAP/PLUG
- EXISTING WATER METER
- PROPOSED WATER METER
- EXISTING GUY WIRE
- PROPOSED WASTEWATER MANHOLE
- EXISTING WASTEWATER MANHOLE
- PROPOSED DRAINAGE JUNCTION BOX
- PROPOSED CURB INLET
- PROPOSED 60" DRAINAGE MANHOLE
- PROPOSED STREET LIGHT
- PROPOSED WASTEWATER LATERAL

WASTEWATER SHEET NOTES

- EXISTING CONDITIONS SURVEY WAS PREPARED BY WESTWOOD PROFESSIONAL SERVICES, INC. IN MAY, OF 2020.
- REFERENCE COVER SHEET FOR ADDITIONAL SITE INFORMATION.
- REFERENCE SHEET C012, GENERAL NOTES FOR ADDITIONAL SITE NOTES.
- LIMITS OF CONSTRUCTION ARE SHOWN ON THE EROSION & SEDIMENTATION CONTROL PLAN, REFERENCE SHEET ###.
- REFERENCE SHEET CU100 FOR OVERALL UTILITY LAYOUT.
- LOCATION OF EXISTING UTILITIES, SOME OF WHICH MAY NOT BE SHOWN, COULD IMPACT CONSTRUCTION MEANS AND METHODS. CONTRACTOR TO VERIFY ALL EXISTING UTILITIES VERTICALLY AND HORIZONTALLY PRIOR TO BID AND CONSTRUCTION, AND SHALL NOTIFY THE ENGINEER IMMEDIATELY OF ANY DISCREPANCIES. THE CONTRACTOR TO CONTACT THE AREA "ONE CALL" SYSTEM @ 811, OR THE OWNER OF EACH INDIVIDUAL UTILITY FOR ASSISTANCE IN DETERMINING EXISTING UTILITY LOCATIONS.
- CONTRACTOR TO SHALL EXPOSE ALL EXISTING UTILITIES CROSSING PROPOSED GRAVITY LINES AND INSURE THERE WILL BE NO CONFLICT PRIOR TO BEGINNING CONSTRUCTION. ADDITIONALLY, CONTRACTOR TO PLAN UTILITY INSTALLATIONS IN A MANNER TO AVOID CONFLICTS WITH PROPOSED GRAVITY LINES.
- THE SIZE AND LOCATION OF UTILITY STRUCTURES (IF SHOWN) MAY BE EXAGGERATED FOR GRAPHICAL CLARITY. THE SURVEY SHOWS FIELD MEASURED SIZES AND DEPTHS AS OBSERVED FROM GROUND LEVEL OPENINGS.
- ON ALL GRAVITY LINES, CONTRACTOR MUST START AT DOWNSTREAM END AND PROCEED UPSTREAM TAKING CARE TO EXPOSE ALL EXISTING UTILITIES AND STRUCTURES WHICH MAY CONFLICT WITH THE PROPOSED LINE. ANY OTHER SEQUENCE OF CONSTRUCTION WILL BE THE CONTRACTOR'S RISK.
- THERE ARE NO EXISTING HERITAGE TREES ON THE SITE.
- ALL ITEMS ARE TO BE FURNISHED & INSTALLED BY CONTRACTOR. REFERENCE CONSTRUCTION DETAILS SHEETS FOR ADDITIONAL INFORMATION.
- AFTER ALL WASTE WATER CONSTRUCTION HAS BEEN COMPLETED, FINAL STABILIZATION OF THE CONSTRUCTION AREA ON ALL UNPAVED AREAS AND AREAS NOT COVERED BY PERMANENT STRUCTURES SHALL BE COMPLETED BY EVENLY DISTRIBUTING SEEDING AND WATERING TO A MIN. 75% OF THE NATIVE BACKGROUND VEGETATIVE COVER.
- ALL WASTE WATER MANHOLES SHALL BE CONSTRUCTION IN ACCORDANCE WITH THE SAWS SPECIFICATIONS FOR WATER AND SANITARY SEWER CONSTRUCTION (LATEST EDITION).
- ALL WASTE WATER PRECAST MANHOLES SHALL BE SUPPLIED BY A SAWS APPROVED MANUFACTURER.
- CONTRACTOR SHALL PROVIDE MANUFACTURED STUB OUT CAP & PLUG TO MEET 30 TAC 213.53(3) STANDARDS AND TO MEET ASTM D3034 SPECIFICATIONS UNLESS OTHERWISE NOTED.
- ALL RESIDENTIAL WASTE WATER SERVICE LATERALS ARE 6" DIA. AND 35 FEET IN LENGTH UNLESS OTHERWISE NOTED.
- ALL RESIDENTIAL WASTE WATER SERVICE LATERALS SHALL BE EXTENDED TO THE BACK OF THE 10' E.G.T.C. AND CAPPED AND SEALED.
- WASTE WATER LATERALS TO LOTS THAT SLOPE AWAY FROM THE STREET SHALL BE SLOPED FROM THE TEE OR STACK AT 2% TO THE PROPERTY LINE.
- ALL WASTE WATER PIPE TO BE SDR 26 PER ASTM D3034 SPECIFICATIONS UNLESS OTHERWISE NOTED. PIPE JOINTS TO BE SDR 26 PER ASTM D3034 SPECIFICATIONS.
- ALL WASTE WATER LINES WHICH CROSS WATER LINES ARE TO HAVE A MINIMUM OF A SINGLE LENGTH OF SDR 26/AST D2241-09, PRESSURE RATED 150 PSI PIPE, CENTERED ON THE WATERLINE SUCH THAT EACH WASTE WATER JOINT IS A MINIMUM OF NINE FEET FROM THE WATERLINE.
- ALL SITE DIMENSIONS ARE TO FACE OF CURB, CENTER OF PIPE, CENTER OF STRIPING, AND PROPERTY LINE UNLESS OTHERWISE NOTED.
- CONTRACTOR AND/OR CONTRACTOR'S INDEPENDENTLY RETAINED EMPLOYEE OR STRUCTURAL DESIGN / GEOTECHNICAL / SAFETY EQUIPMENT CONSULTANT, IF ANY, SHALL REVIEW THESE PLANS AND AVAILABLE GEOTECHNICAL INFORMATION AND THE ANTICIPATED INSTALLATION SITE(S) WITHIN THE PROJECT WORK AREA IN ORDER TO IMPLEMENT CONTRACTOR'S TRENCH EXCAVATION SAFETY PROTECTION SYSTEMS, PROGRAMS AND/OR PROCEDURES FOR THE PROJECT DESCRIBED IN THE CONTRACT DOCUMENTS. THE CONTRACTOR'S IMPLEMENTATION OF THESE SYSTEMS, PROGRAMS AND/OR PROCEDURES SHALL PROVIDE FOR ADEQUATE TRENCH EXCAVATION SAFETY PROTECTION THAT COMPLY WITH AS A MINIMUM, OSHA STANDARDS FOR TRENCH EXCAVATIONS, SPECIFICALLY, CONTRACTOR AND/OR CONTRACTOR'S INDEPENDENTLY RETAINED EMPLOYEE OR SAFETY CONSULTANT SHALL IMPLEMENT A TRENCH SAFETY PROGRAM IN ACCORDANCE WITH OSHA STANDARDS GOVERNING THE PRESENCE AND ACTIVITIES OF INDIVIDUALS WORKING IN AND AROUND TRENCH EXCAVATION.
- THE UNDERGROUND UTILITIES SHOWN HAVE BEEN LOCATED FROM FIELD SURVEY INFORMATION AND EXISTING DRAWINGS. THE ENGINEER MAKES NO GUARANTEE THAT THE UNDERGROUND UTILITIES COMPRISE ALL SUCH UTILITIES IN THE AREA, EITHER IN SERVICE OR ABANDON. THE ENGINEER FURTHER DOES NOT WARRANT THAT THE UNDERGROUND UTILITIES SHOWN ARE IN THE EXACT LOCATION INDICATED. THE ENGINEER HAS NOT PHYSICALLY LOCATED THE UNDERGROUND UTILITIES.
- REFERENCE CONSTRUCTION DETAILS FOR ADDITIONAL INFORMATION ON DRAINAGE STRUCTURES & APPURTENANCES. CONTRACTOR TO REFER TO SAWS STANDARD DETAILS FOR ALL SAWS APPURTENANCES AND STRUCTURES.
- CONTRACTOR TO REPAIR AND/OR REPLACE ALL DAMAGED SIDEWALKS AND CURBS AROUND SITE IN ACCORDANCE WITH THE CITY OF SAN ANTONIO STANDARD DETAILS AND SPECIFICATIONS.

**CAUTION!!!**  
CONTRACTOR TO VERIFY ALL EXISTING UTILITIES VERTICALLY AND HORIZONTALLY PRIOR TO CONSTRUCTION. CONTRACTOR TO NOTIFY THE ENGINEER IMMEDIATELY OF ANY DISCREPANCIES. THE ENGINEER ASSUMES NO RESPONSIBILITY FOR THE ACCURACY OF THE LOCATION OF UNDERGROUND UTILITIES. THE CONTRACTOR SHALL BE RESPONSIBLE FOR AVOIDING ALL EXISTING UTILITIES BY CALLING DIGGERS & 1-800-DIG-TESS FOR LOCATION OF ALL UTILITIES, AT LEAST 2 WORKING DAYS PRIOR TO BEGINNING CONSTRUCTION.

**UP ENGINEERING + SURVEYING**  
11903 JONES WALTERS, SUITE 102  
SAN ANTONIO, TEXAS 78216  
WWW.UPENGINEERING.COM TEL: 214-714-7894  
TBRELS F-10194606

**STATE OF TEXAS**  
NATASHA F. UHLRICH  
89502  
LICENSED PROFESSIONAL ENGINEER  
1/1/24

LENNAR HOMES OF TEXAS  
LAND & CONSTRUCTION, LTD.  
100 NE LOOP 410, SUITE 1155  
SAN ANTONIO, TEXAS 78216

VALLE SOL UNIT 2 SUBDIVISION  
PLAT NO. 22-11800251  
WASTEWATER LINE C

| DESIGNED BY: | JOS/TS |                                       |             |
|--------------|--------|---------------------------------------|-------------|
| DRAFTED BY:  | JOS    |                                       |             |
| CHECKED BY:  | NFURRP |                                       |             |
| 1            | 1/1/24 | GRADING REVISIONS & VALUE ENGINEERING | DESCRIPTION |
| REV          | DATE   |                                       |             |

SHEET  
**CU203**  
64 OF 75





**LEGEND**

- BOUNDARY / RIGHT OF WAY
- EASEMENT / SETBACK
- CURB / EDGE OF PAVEMENT
- SIDEWALK (HOME BUILDER'S RESPONSIBILITY)
- SIDEWALK (DEVELOPER'S RESPONSIBILITY)
- EXIST. GRADE ELEVATIONS
- PROP. GRADE ELEVATIONS
- EXISTING WATER LINE
- PROPOSED WATER LINE
- EXISTING OVERHEAD UTILITIES
- EXISTING UNDERGROUND ELECTRIC
- EXISTING GAS LINE
- PROPOSED DRAINAGE
- PROPOSED WASTEWATER LINE
- EXISTING WASTEWATER LINE
- TOS
- EXISTING UTILITY POLE
- EXISTING SIGN
- EXISTING FIRE HYDRANT
- PROPOSED FIRE HYDRANT
- PROPOSED WATER VALVE
- PROPOSED CAP/PLUG
- EXISTING WATER METER
- PROPOSED WATER METER
- EXISTING GUY WIRE
- PROPOSED WASTEWATER MANHOLE
- EXISTING WASTEWATER MANHOLE
- PROPOSED DRAINAGE JUNCTION BOX
- PROPOSED CURB INLET
- PROPOSED 60" DRAINAGE MANHOLE
- PROPOSED STREET LIGHT
- PROPOSED WASTEWATER LATERAL

**WASTE WATER SHEET NOTES**

- EXISTING CONDITIONS SURVEY WAS PREPARED BY WESTWOOD PROFESSIONAL SERVICES, INC. IN MAY OF 2020.
- REFERENCE COVER SHEET FOR ADDITIONAL SITE INFORMATION.
- REFERENCE SHEET C012, GENERAL NOTES FOR ADDITIONAL SITE NOTES.
- LIMITS OF CONSTRUCTION ARE SHOWN ON THE EROSION & SEDIMENTATION CONTROL PLAN, REFERENCE SHEET ###.
- REFERENCE SHEET CU100 FOR OVERALL UTILITY LAYOUT.
- LOCATION OF EXISTING UTILITIES, SOME OF WHICH MAY NOT BE SHOWN, COULD IMPACT CONSTRUCTION MEANS AND METHODS. CONTRACTOR TO VERIFY ALL EXISTING UTILITIES VERTICALLY AND HORIZONTALLY PRIOR TO BID AND CONSTRUCTION, AND SHALL NOTIFY THE ENGINEER IMMEDIATELY OF ANY DISCREPANCIES. THE CONTRACTOR TO CONTACT THE AREA "ONE CALL" SYSTEM @ 811, OR THE OWNER OF EACH INDIVIDUAL UTILITY FOR ASSISTANCE IN DETERMINING EXISTING UTILITY LOCATIONS.
- CONTRACTOR TO SHALL EXPOSE ALL EXISTING UTILITIES CROSSING PROPOSED GRAVITY LINES AND INSURE THERE WILL BE NO CONFLICT PRIOR TO BEGINNING CONSTRUCTION. ADDITIONALLY, CONTRACTOR TO PLAN UTILITY INSTALLATIONS IN A MANNER TO AVOID CONFLICTS WITH PROPOSED GRAVITY LINES.
- THE SIZE AND LOCATION OF UTILITY STRUCTURES (IF SHOWN) MAY BE EXAGGERATED FOR GRAPHICAL CLARITY. THE SURVEY SHOWS FIELD MEASURED SIZES AND DEPTHS AS OBSERVED FROM GROUND LEVEL OPENINGS.
- ON ALL GRAVITY LINES, CONTRACTOR MUST START AT DOWNSTREAM END AND PROCEED UPSTREAM TAKING CARE TO EXPOSE ALL EXISTING UTILITIES AND STRUCTURES WHICH MAY CONFLICT WITH THE PROPOSED LINE. ANY OTHER SEQUENCE OF CONSTRUCTION WILL BE AT THE CONTRACTOR'S RISK.
- THERE ARE NO EXISTING HERITAGE TREES ON THE SITE.
- ALL ITEMS ARE TO BE FURNISHED & INSTALLED BY CONTRACTOR. REFERENCE CONSTRUCTION DETAILS SHEETS FOR ADDITIONAL INFORMATION.
- AFTER ALL WASTE WATER CONSTRUCTION HAS BEEN COMPLETED, FINAL STABILIZATION OF THE CONSTRUCTION AREA ON ALL UNPAVED AREAS AND AREAS NOT COVERED BY PERMANENT STRUCTURES SHALL BE COMPLETED BY EVENLY DISTRIBUTING SEEDING AND WATERING TO A MIN. 70% OF THE NATIVE BACKGROUND VEGETATIVE COVER.
- ALL WASTE WATER MANHOLES SHALL BE CONSTRUCTION IN ACCORDANCE WITH THE SAWS SPECIFICATIONS FOR WATER AND SANITARY SEWER CONSTRUCTION (LATEST EDITION).
- ALL WASTE WATER PRECAST MANHOLES SHALL BE SUPPLIED BY A SAWS APPROVED MANUFACTURER.
- CONTRACTOR SHALL PROVIDE MANUFACTURED STUB OUT CAP & PLUG TO MEET 30 TAC 213.5(3)(G) STANDARDS AND TO MEET ASTM D3034 SPECIFICATIONS UNLESS OTHERWISE NOTED.
- ALL RESIDENTIAL WASTE WATER SERVICE LATERALS ARE 6" DIA. AND 35 FEET IN LENGTH UNLESS OTHERWISE NOTED.
- ALL RESIDENTIAL WASTE WATER SERVICE LATERALS SHALL BE EXTENDED TO THE BACK OF THE 10' E.G.T.C. AND CAPPED AND SEALED.
- WASTE WATER LATERALS TO LOTS THAT SLOPE AWAY FROM THE STREET SHALL BE SLOPED FROM THE TEE OR STACK AT 2% TO THE PROPERTY LINE.
- ALL WASTE WATER PIPE TO BE SDR 26 PER ASTM D3034 SPECIFICATIONS UNLESS OTHERWISE NOTED. PIPE JOINTS TO BE SDR 26 PER ASTM D3034 SPECIFICATIONS.
- ALL WASTE WATER LINES WHICH CROSS WATER LINES ARE TO HAVE A MINIMUM OF A SINGLE LENGTH OF SDR 26 (AST D2241-09), PRESSURE RATED 150 PSI PIPE, CENTERED ON THE WATERLINE SUCH THAT EACH WASTE WATER JOINT IS A MINIMUM OF NINE FEET FROM THE WATERLINE.
- ALL SITE DIMENSIONS ARE TO FACE OF CURB, CENTER OF PIPE, CENTER OF STRIPING, AND PROPERTY LINE UNLESS OTHERWISE NOTED.
- CONTRACTOR AND/OR CONTRACTOR'S INDEPENDENTLY RETAINED EMPLOYEE OR STRUCTURAL DESIGN / GEOTECHNICAL / SAFETY / EQUIPMENT CONSULTANT, IF ANY, SHALL REVIEW THESE PLANS AND AVAILABLE GEOTECHNICAL INFORMATION AND THE ANTICIPATED INSTALLATION SITE(S) WITHIN THE PROJECT WORK AREA IN ORDER TO IMPLEMENT CONTRACTOR'S TRENCH EXCAVATION SAFETY PROTECTION SYSTEMS, PROGRAMS AND/OR PROCEDURES FOR THE PROJECT DESCRIBED IN THE CONTRACT DOCUMENTS. THE CONTRACTOR'S IMPLEMENTATION OF THESE SYSTEMS, PROGRAMS AND/OR PROCEDURES SHALL PROVIDE FOR ADEQUATE TRENCH EXCAVATION SAFETY PROTECTION THAT COMPLY WITH AS A MINIMUM, OSHA STANDARDS FOR TRENCH EXCAVATIONS, SPECIFICALLY, CONTRACTOR AND/OR CONTRACTOR'S INDEPENDENTLY RETAINED EMPLOYEE OR SAFETY CONSULTANT SHALL IMPLEMENT A TRENCH SAFETY PROGRAM IN ACCORDANCE WITH OSHA STANDARDS GOVERNING THE PRESENCE AND ACTIVITIES OF INDIVIDUALS WORKING IN AND AROUND TRENCH EXCAVATION.
- THE UNDERGROUND UTILITIES SHOWN HAVE BEEN LOCATED FROM FIELD SURVEY INFORMATION AND EXISTING DRAWINGS. THE ENGINEER MAKES NO GUARANTEE THAT THE UNDERGROUND UTILITIES COMPRISE ALL SUCH UTILITIES IN THE AREA, EITHER IN SERVICE OR ABANDON. THE ENGINEER FURTHER DOES NOT WARRANT THAT THE UNDERGROUND UTILITIES SHOWN ARE IN THE EXACT LOCATION INDICATED. THE ENGINEER HAS NOT PHYSICALLY LOCATED THE UNDERGROUND UTILITIES.
- REFERENCE CONSTRUCTION DETAILS FOR ADDITIONAL INFORMATION ON DRAINAGE STRUCTURES & APPURTENANCES. CONTRACTOR TO REFER TO SAWS STANDARD DETAILS FOR ALL SAWS APPURTENANCES AND STRUCTURES.
- CONTRACTOR TO REPAIR AND/OR REPLACE ALL DAMAGED SIDEWALKS AND CURBS AROUND SITE IN ACCORDANCE WITH THE (CITY OF SAN ANTONIO) STANDARD DETAILS AND SPECIFICATIONS.

**UPPER MEDINA RIVER WATERSHED - DOS RIOS W.R.C.**

Developer: LENNAR HOMES OF TEXAS LAND & CONSTRUCTION, LTD.

Address: 100 NE LOOP 410, SUITE 1155

City: SAN ANTONIO State: TEXAS Zip: 78216

Phone: Fax:

SAWS Block Map: 122-536 Total EDUs: 195 Total Acreage: 33.82

Total Linear Footage of Pipe: 4,734 L.F. 8" PVC 6,494 L.F. 6" PVC Plat No.: 22-11800251

Number of Lots: 4 N.S.F. SAWS Job No.: 22-1656

**CAUTION!!!**

CONTRACTOR TO VERIFY ALL EXISTING UTILITIES VERTICALLY AND HORIZONTALLY PRIOR TO CONSTRUCTION. CONTRACTOR TO NOTIFY THE ENGINEER IMMEDIATELY OF ANY DISCREPANCIES.

THE ENGINEER ASSUMES NO RESPONSIBILITY FOR THE ACCURACY OF THE LOCATION OF UNDERGROUND UTILITIES. THE CONTRACTOR SHALL BE RESPONSIBLE FOR AVOIDING ALL EXISTING UTILITIES BY CALLING DIGITEST @ 1-800-DIG-TESS FOR LOCATION OF ALL UTILITIES, AT LEAST 2 WORKING DAYS PRIOR TO BEGINNING CONSTRUCTION.

**ENGINEERING + SURVEYING**

11803 JONES WATSON BLVD, SUITE 102  
SAN ANTONIO, TEXAS 78244  
WWW.UPEENGINEERING.COM  
TELEPHONE: 719-17992  
FAX: 719-17992

STATE OF TEXAS  
NATASHA F. UHLRICH  
89502  
LICENSED PROFESSIONAL ENGINEER  
1/19/24

LENNAR HOMES OF TEXAS  
LAND & CONSTRUCTION, LTD.  
100 NE LOOP 410, SUITE 1155  
SAN ANTONIO, TEXAS 78216

VALLE SOL UNIT 2 SUBDIVISION  
PLAT NO. 22-11800251

WASTE WATER LINE B

| REV | DATE    | DESCRIPTION                           | BY  |
|-----|---------|---------------------------------------|-----|
| 1   | 1/17/24 | GRADING REVISIONS & VALUE ENGINEERING | JOS |

DESIGNED BY: JOS/TS

DRAFTED BY: JOS

CHECKED BY: NFU/RRP


SHEET

**CU202**

63 OF 75



FILE NAME: U:\PROJECTS\196 - VALE SOL UNIT 2 - UNIT 2 - REDONCAGUAS\196-2 - CU20 WASTEWATER LINE D.DWG  
LAST MODIFIED ON: 01/18/2024  
LAST PRINTED ON: 01/18/2024  
PLOT STYLE: W:\UP\PRODUCTION\STANDARD.CTB

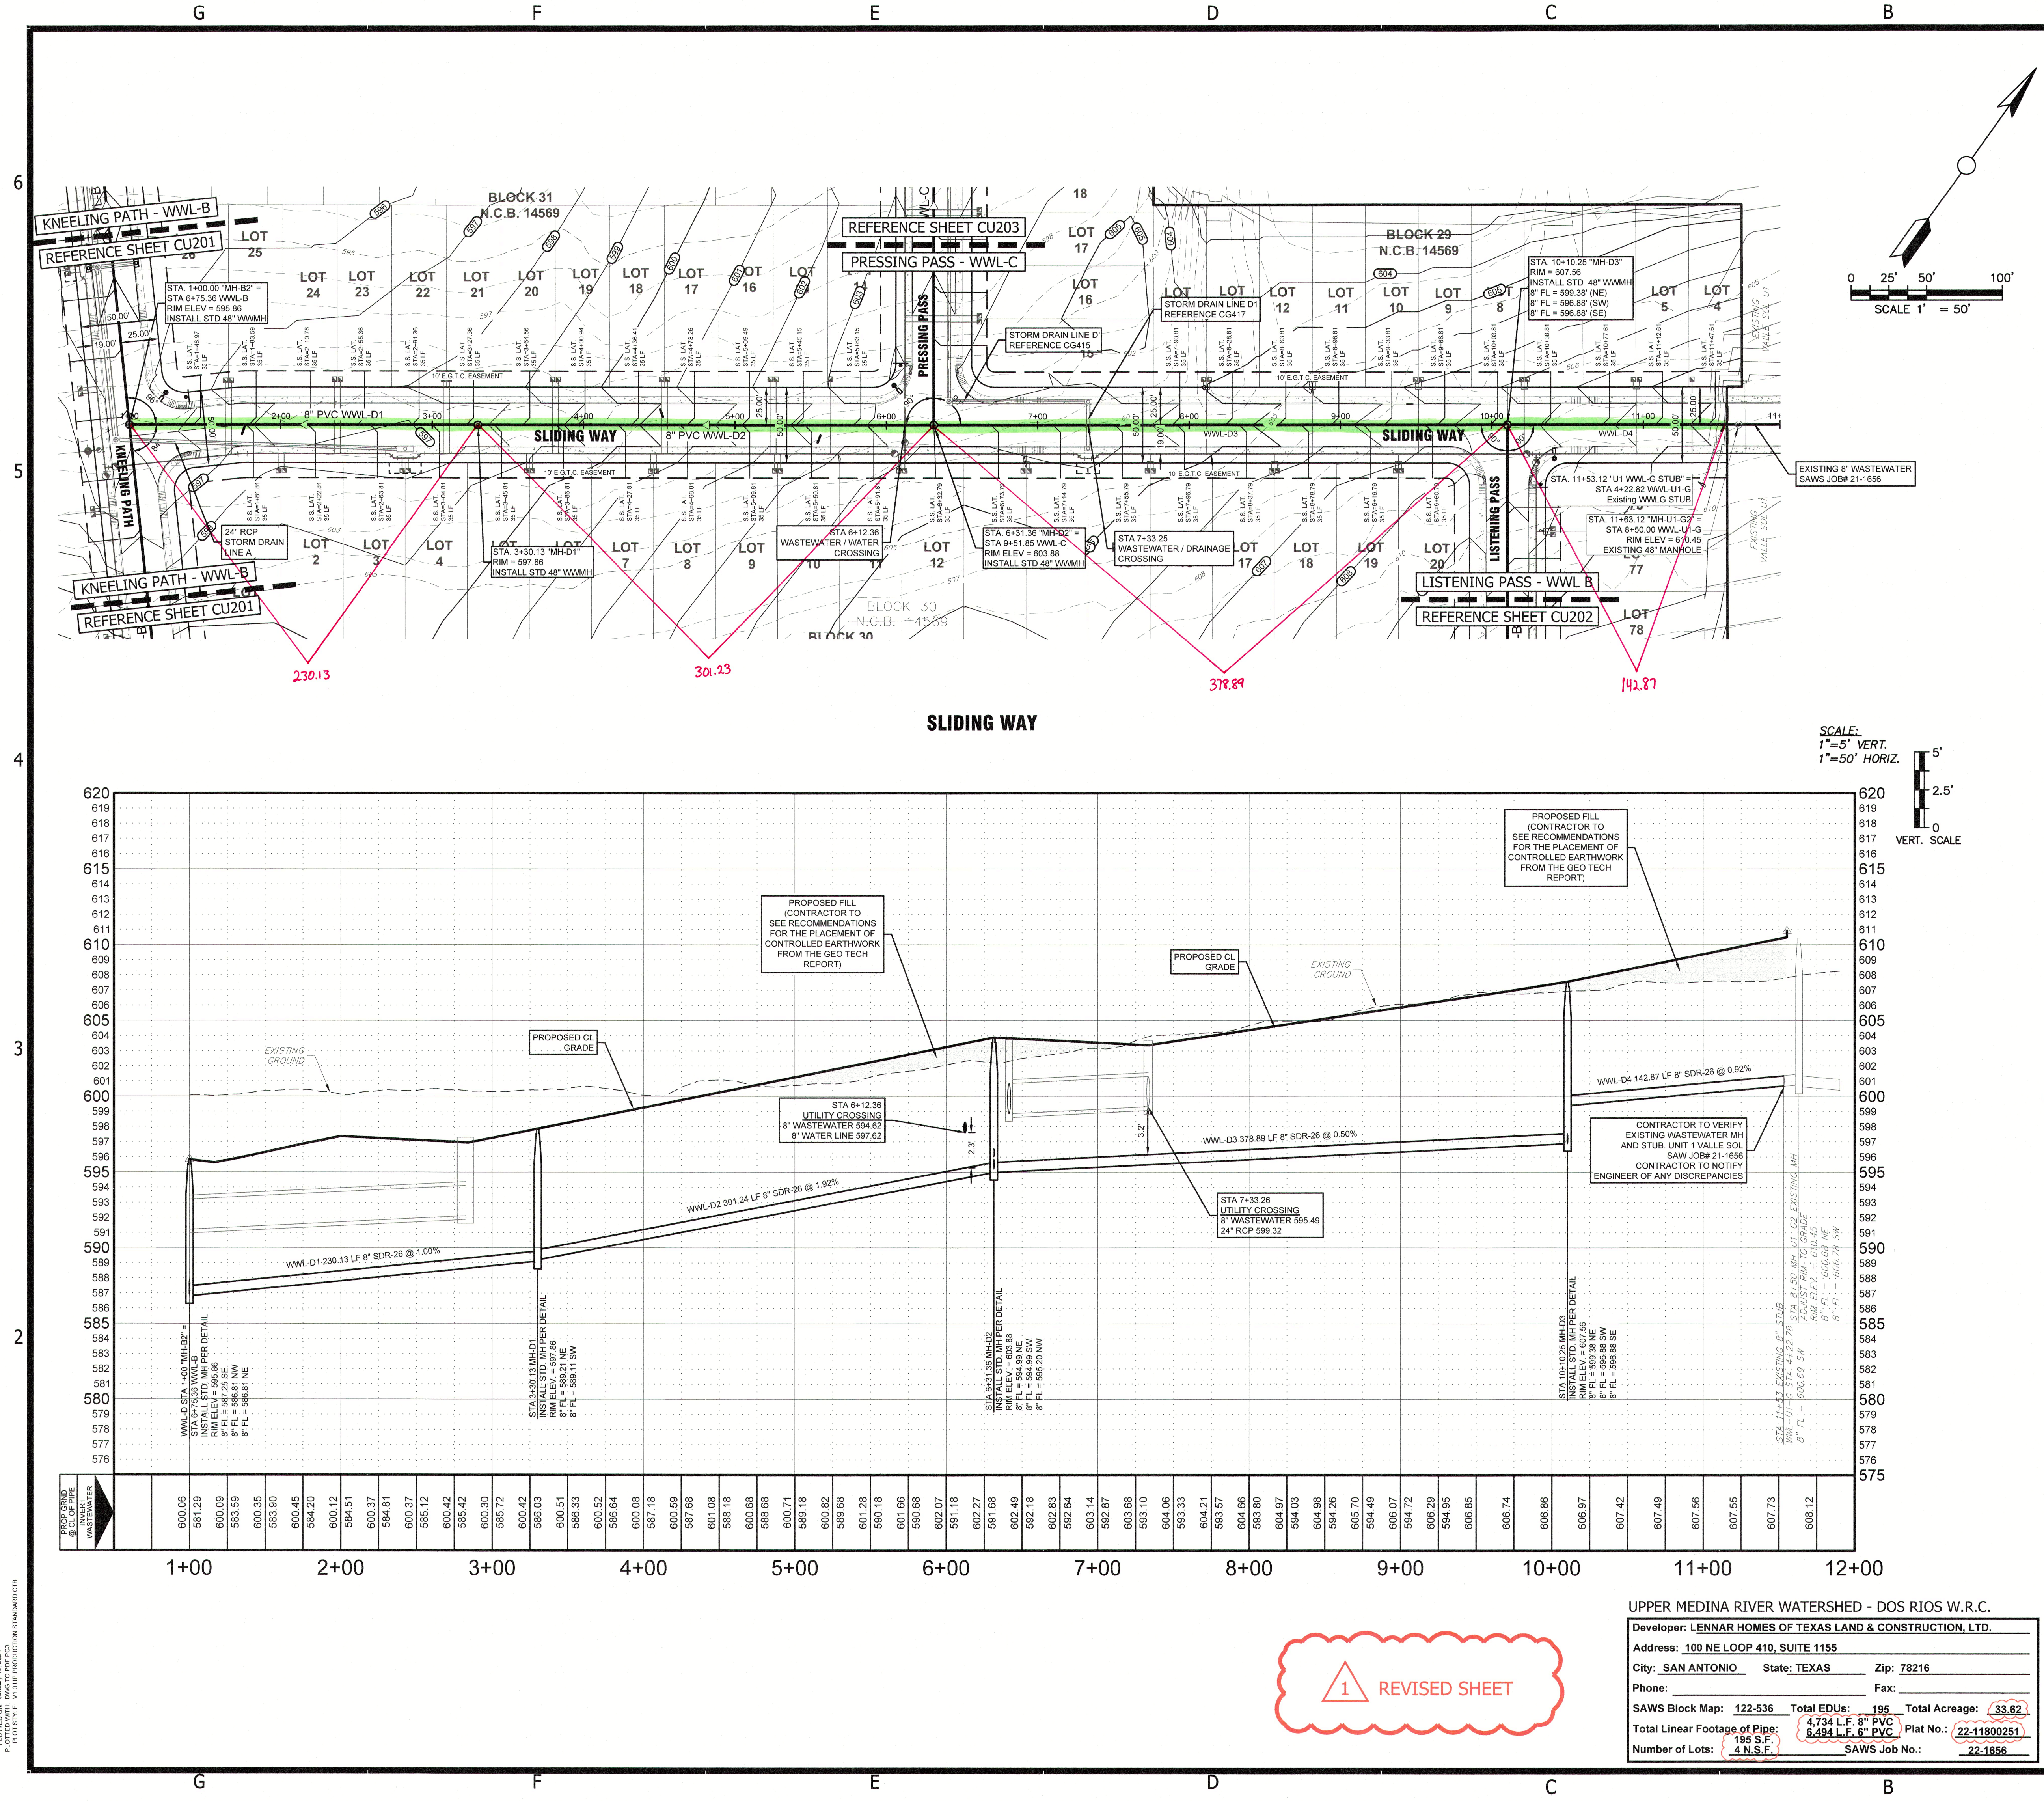

**LEGEND**

- BOUNDARY / RIGHT OF WAY
- EASEMENT / SETBACK
- CURB / EDGE OF PAVEMENT
- SIDEWALK (HOME BUILDER'S RESPONSIBILITY)
- SIDEWALK (DEVELOPER'S RESPONSIBILITY)
- EXIST. GRADE ELEVATIONS
- PROP. GRADE ELEVATIONS
- EXISTING WATER LINE
- PROPOSED WATER LINE
- EXISTING OVERHEAD UTILITIES
- EXISTING UNDERGROUND ELECTRIC
- EXISTING GAS LINE
- PROPOSED DRAINAGE
- PROPOSED WASTEWATER LINE
- EXISTING WASTEWATER LINE
- WW TOP OF STACK
- EXISTING UTILITY POLE
- EXISTING SIGN
- EXISTING FIRE HYDRANT
- PROPOSED FIRE HYDRANT
- PROPOSED WATER VALVE
- PROPOSED CAP/PLUG
- EXISTING WATER METER
- PROPOSED WATER METER
- EXISTING GUY WIRE
- PROPOSED WASTEWATER MANHOLE
- EXISTING WASTEWATER JUNCTION BOX
- PROPOSED CURB INLET
- PROPOSED 60" DRAINAGE MANHOLE
- PROPOSED STREET LIGHT
- PROPOSED WASTEWATER LATERAL

**WASTEWATER SHEET NOTES**

- EXISTING CONDITIONS SURVEY WAS PREPARED BY WESTWOOD PROFESSIONAL SERVICES, INC. IN MAY, OF 2020.
- REFERENCE COVER SHEET FOR ADDITIONAL SITE INFORMATION.
- REFERENCE SHEET CU212, GENERAL NOTES FOR ADDITIONAL SITE NOTES.
- LIMITS OF CONSTRUCTION ARE SHOWN ON THE EROSION & SEDIMENTATION CONTROL PLAN, REFERENCE SHEET ###.
- REFERENCE SHEET CU100 FOR OVERALL UTILITY LAYOUT.
- LOCATION OF EXISTING UTILITIES, SOME OF WHICH MAY NOT BE SHOWN, COULD IMPACT CONSTRUCTION MEANS AND METHODS. CONTRACTOR TO VERIFY ALL EXISTING UTILITIES VERTICALLY AND HORIZONTALLY PRIOR TO BID AND CONSTRUCTION, AND SHALL NOTIFY THE ENGINEER IMMEDIATELY OF ANY DISCREPANCIES. THE CONTRACTOR TO CONTACT THE AREA "ONE CALL" SYSTEM @ 811, OR THE OWNER OF EACH INDIVIDUAL UTILITY FOR ASSISTANCE IN DETERMINING EXISTING UTILITY LOCATIONS.
- CONTRACTOR TO SHALL EXPOSE ALL EXISTING UTILITIES CROSSING PROPOSED GRAVITY LINES AND INSURE THERE WILL BE NO CONFLICT PRIOR TO BEGINNING CONSTRUCTION. ADDITIONALLY, CONTRACTOR TO PLAN UTILITY INSTALLATIONS IN A MANNER TO AVOID CONFLICTS WITH PROPOSED GRAVITY LINES.
- THE SIZE AND LOCATION OF UTILITY STRUCTURES (IF SHOWN) MAY BE EXAGGERATED FOR GRAPHICAL CLARITY. THE SURVEY SHOWS FIELD MEASURED SIZES AND DEPTHS AS OBSERVED FROM GROUND LEVEL OPENINGS.
- ON ALL GRAVITY LINES, CONTRACTOR MUST START AT DOWNSTREAM END AND PROCEED UPSTREAM TAKING CARE TO EXPOSE ALL EXISTING UTILITIES AND STRUCTURES WHICH MAY CONFLICT WITH THE PROPOSED LINE. ANY OTHER SEQUENCE OF CONSTRUCTION WILL BE AT THE CONTRACTOR'S RISK.
- THERE ARE NO EXISTING HERITAGE TREES ON THE SITE.
- ALL ITEMS ARE TO BE FURNISHED & INSTALLED BY CONTRACTOR. REFERENCE CONSTRUCTION DETAILS SHEETS FOR ADDITIONAL INFORMATION.
- AFTER ALL WASTE WATER CONSTRUCTION HAS BEEN COMPLETED, FINAL STABILIZATION OF THE CONSTRUCTION AREA ON ALL UNPAVED AREAS AND AREAS NOT COVERED BY PERMANENT STRUCTURES SHALL BE COMPLETED BY EVENLY DISTRIBUTING SEEDING AND WATERING TO A MIN. 70% OF THE NATIVE BACKGROUND VEGETATIVE COVER.
- ALL WASTE WATER MANHOLES SHALL BE CONSTRUCTION IN ACCORDANCE WITH THE SAWS SPECIFICATIONS FOR WATER AND SANITARY SEWER CONSTRUCTION (LATEST EDITION).
- ALL WASTE WATER PRECAST MANHOLES SHALL BE SUPPLIED BY A SAWS APPROVED MANUFACTURER.
- CONTRACTOR SHALL PROVIDE MANUFACTURED STUB OUT CAP & PLUG TO MEET 30 TAG 213.53(5) STANDARDS AND TO MEET ASTM D3034 SPECIFICATIONS UNLESS OTHERWISE NOTED.
- ALL RESIDENTIAL WASTE WATER SERVICE LATERALS ARE 6" DIA. AND 35 FEET IN LENGTH UNLESS OTHERWISE NOTED.
- ALL RESIDENTIAL WASTE WATER SERVICE LATERALS SHALL BE EXTENDED TO THE BACK OF THE 10' E.G.T.C. AND CAPPED AND SEALED.
- WASTE WATER LATERALS TO LOTS THAT SLOPE AWAY FROM THE STREET SHALL BE SLOPED FROM THE TEE OR STACK AT 2% TO THE PROPERTY LINE.
- ALL WASTE WATER PIPE TO BE SDR 26 PER ASTM D3034 SPECIFICATIONS UNLESS OTHERWISE NOTED. PIPE JOINTS TO BE SDR 26 PER ASTM D3135 SPECIFICATIONS.
- ALL WASTE WATER LINES WHICH CROSS WATER LINES ARE TO HAVE A MINIMUM OF A SINGLE LENGTH OF SDR 26 (ASTM D2241-09), PRESSURE RATED (150 PSI) PIPE, CENTERED ON THE WATERLINE SUCH THAT EACH WASTE WATER JOINT IS A MINIMUM OF NINE FEET FROM THE WATERLINE.
- ALL SITE DIMENSIONS ARE TO FACE OF CURB, CENTER OF PIPE, CENTER OF STRIPING, AND PROPERTY LINE UNLESS OTHERWISE NOTED.
- CONTRACTOR AND/OR CONTRACTOR'S INDEPENDENTLY RETAINED EMPLOYEE OR STRUCTURAL DESIGN / GEOTECHNICAL / SAFETY / EQUIPMENT CONSULTANT, IF ANY, SHALL REVIEW THESE PLANS AND AVAILABLE GEOTECHNICAL INFORMATION AND THE ANTICIPATED INSTALLATION SITE(S) WITHIN THE PROJECT WORK AREA IN ORDER TO IMPLEMENT CONTRACTOR'S TRENCH EXCAVATION SAFETY PROTECTION SYSTEMS, PROGRAMS AND PROCEDURES FOR THE PROJECT DESCRIBED IN THE CONTRACT DOCUMENTS. THE CONTRACTOR'S IMPLEMENTATION OF THESE SYSTEMS, PROGRAMS AND/OR PROCEDURES SHALL PROVIDE FOR ADEQUATE TRENCH EXCAVATION SAFETY PROTECTION THAT COMPLY WITH AS A MINIMUM, OSHA STANDARDS FOR TRENCH EXCAVATIONS, SPECIFICALLY, CONTRACTOR AND/OR CONTRACTOR'S INDEPENDENTLY RETAINED EMPLOYEE OR SAFETY CONSULTANT SHALL IMPLEMENT A TRENCH SAFETY PROGRAM IN ACCORDANCE WITH OSHA STANDARDS GOVERNING THE PRESENCE AND ACTIVITIES OF INDIVIDUALS WORKING IN AND AROUND TRENCH EXCAVATION.
- THE UNDERGROUND UTILITIES SHOWN HAVE BEEN LOCATED FROM FIELD SURVEY INFORMATION AND EXISTING DRAWINGS. THE ENGINEER MAKES NO GUARANTEE THAT THE UNDERGROUND UTILITIES COMPRISE ALL SUCH UTILITIES IN THE AREA. IF OTHER IN SERVICE OR ABANDONED, THE ENGINEER FURTHER DOES NOT WARRANT THAT THE UNDERGROUND UTILITIES SHOWN ARE IN THE EXACT LOCATION INDICATED. THE ENGINEER HAS NOT PHYSICALLY LOCATED THE UNDERGROUND UTILITIES.
- REFERENCE CONSTRUCTION DETAILS FOR ADDITIONAL INFORMATION ON DRAINAGE STRUCTURES & APPURTENANCES. CONTRACTOR TO REFER TO SAWS STANDARD DETAILS FOR ALL SAWS APPURTENANCES AND STRUCTURES.
- CONTRACTOR TO REPAIR AND/OR REPLACE ALL DAMAGED SIDEWALKS AND CURBS AROUND SITE IN ACCORDANCE WITH THE [CITY OF SAN ANTONIO] STANDARD DETAILS AND SPECIFICATIONS.

**CAUTION!!**

CONTRACTOR TO VERIFY ALL EXISTING UTILITIES VERTICALLY AND HORIZONTALLY PRIOR TO CONSTRUCTION. CONTRACTOR TO NOTIFY THE ENGINEER IMMEDIATELY OF ANY DISCREPANCIES.

THE ENGINEER ASSUMES NO RESPONSIBILITY FOR THE ACCURACY OF THE LOCATION OF UNDERGROUND UTILITIES. THE CONTRACTOR SHALL BE RESPONSIBLE FOR AVOIDING ALL EXISTING UTILITIES BY CALLING DIGITEST @ 1-800-DIG-TEST FOR LOCATION OF ALL UTILITIES, AT LEAST 2 WORKING DAYS PRIOR TO BEGINNING CONSTRUCTION.

UPPER MEDINA RIVER WATERSHED - DOS RIOS W.R.C.

Developer: LENNAR HOMES OF TEXAS LAND & CONSTRUCTION, LTD.

Address: 100 NE LOOP 410, SUITE 1155

City: SAN ANTONIO State: TEXAS Zip: 78216

Phone: \_\_\_\_\_ Fax: \_\_\_\_\_

SAWS Block Map: 122-536 Total EDUs: 195 Total Acreage: 33.82

Total Linear Footage of Pipe: 4,734 L.F. 8" PVC 6,494 L.F. 6" PVC Plat No.: 22-11800251

Number of Lots: 18 N.S.F. SAWS Job No.: 22-1656

1 REVISED SHEET

**UP ENGINEERING + SURVEYING**

11903 JONES WATTSBERGER, SUITE 102  
SAN ANTONIO, TX 78216 TEL. 210-774-5504  
WWW.UPENGINEERING.COM FAX F-17992

STATE OF TEXAS  
NATASHA F. UHLRICH  
89502  
LICENSED PROFESSIONAL ENGINEER  
1/1/24

LENNAR HOMES OF TEXAS  
LAND & CONSTRUCTION, LTD.  
100 NE LOOP 410, SUITE 1155  
SAN ANTONIO, TEXAS 78216

VALE SOL UNIT 2 SUBDIVISION  
PLAT NO. 22-11800251

WASTEWATER LINE D

| REV | DATE    | DESCRIPTION                           |
|-----|---------|---------------------------------------|
| 1   | 1/17/24 | GRADING REVISIONS & VALUE ENGINEERING |

DESIGNED BY: JOS/TS  
DRAFTED BY: JOS  
CHECKED BY: NFUR/RRP

SHEET  
**CU204**  
65 OF 75