

CONSTRUCTION NOTES:


- ALL WORK SHALL BE IN ACCORDANCE WITH GBRA STANDARDS AS PUBLISHED AT THE FOLLOWING WEBSITE: [HTTP://WWW.GBRA.ORG/PUBLIC/WATERWASTEWATERSERVICES.ASPX](http://www.gbra.org/public/waterwastewaterservices.aspx)
- COPIES OF EACH CONSTRUCTION SUBMITTAL (SHOP DRAWINGS, PRODUCT DATA, ETC.) SHALL BE PROVIDED FOR GBRA REVIEW AND APPROVAL PRIOR TO FABRICATION. USE CLOUDS, BOXES, ARROWS, ETC., TO CLEARLY MARK ALL PROPOSED OPTIONS AND PART NUMBERS. LIST ANY PROPOSED DEVIATIONS ON THE SUBMITTAL COVER SHEET. ALLOW 21 CALENDAR DAYS FOR REVIEW.
- ALL WATER AND WASTEWATER INSTALLATIONS MUST BE INSPECTED AND APPROVED BY GBRA PRIOR TO BACKFILLING OR OTHERWISE COVERING THE WORK. THIS INCLUDES CROSSINGS OF WATER AND WASTEWATER BY OTHER UTILITIES. GBRA WILL PERFORM A MAXIMUM OF ONE (1) INSPECTION DAILY FOR ONE (1) HOUR DURATION BETWEEN 8:00 AM AND 5:00 PM EXCLUDING WEEKENDS AND HOLIDAYS. CALL 800-379-5822 TO SCHEDULE INSPECTIONS 48 HOURS ADVANCE NOTICE IS REQUIRED FOR ALL INSPECTIONS.
- TRENCH EXCAVATION AND PIPE INSTALLATION WILL NOT BE PERMITTED UNTIL SUBGRADE HAS BEEN ESTABLISHED. SURVEY STAKING MUST BE INSTALLED PRIOR TO AND MAINTAINED DURING TRENCH EXCAVATION AND PIPE INSTALLATION. SURVEY STAKING SHALL INCLUDE HORIZONTAL AND VERTICAL CONTROL AT A MINIMUM OF 50 FOOT STATION INTERVALS. HORIZONTAL OFFSETS SHALL BE 15 FEET MAXIMUM. INSTALL PROPERTY PINS AND STAKES. MARK FINISH GRADE LINES WITH CUT/FILL ON OFFSET STAKES AND PROPERTY STAKES. ALL MARKS SHALL FACE THE PIPELINE. SURVEY STAKING SHALL BE PERFORMED BY THE CONTRACTOR.
- PVC MALE ADAPTERS ARE NOT ALLOWED.
- SANITARY TAPPING SADDLES ARE NOT ALLOWED.
- MANHOLE INTERNAL DROPS ARE NOT ALLOWED.
- PIPE BELLS SHALL BE INSTALLED IN UPSTREAM DIRECTION.
- ALL PIPING SHALL BE DESIGNED IN A STRAIGHT ALIGNMENT VERTICALLY AND HORIZONTALLY. PIPE CURVATURE AND/OR DEFLECTION ARE NOT ALLOWED.
- MAINTAIN A MINIMUM OF 10 FEET HORIZONTAL AND 12 INCHES VERTICAL CLEARANCE BETWEEN WATER AND WASTEWATER AND OTHER UTILITIES. SHARED TRENCHES ARE NOT ALLOWED.
- WATER AND WASTEWATER PIPE LENGTHS SHALL BE CENTERED AT CROSSINGS WITH OTHER UTILITIES, INCLUDING DRY UTILITY SERVICES. BOTH PIPES SHALL BE CENTERED AT WATER AND WASTEWATER CROSSINGS, INCLUDING WASTEWATER SERVICE LATERALS AND FIRE HYDRANT LEADS.
- WATER AND WASTEWATER PIPING (INCLUDING MAINS, SERVICES, AND LATERALS) SHALL BE SLEAVED IF LOCATED UNDER CONCRETE CHANNELS, BOX CULVERTS, OR MULTIPLE BARREL STORM SEWER CROSSINGS REGARDLESS OF SIZE AND SINGLE BARRELS 30" OR LARGER.
- VALVE BOXES, EXPOSED PIPING AND VALVES AND APPURTENANCES SHALL BE PAINTED. PROVIDE PAINTED CURB CUT MARKINGS AT VALVES AND SERVICES.
- ALL EXPOSED VERTICAL AND HORIZONTAL CONCRETE EDGES SHALL BE FORMED WITH 3/4" CHAMFER STRIPS.
- EXISTING FACILITIES THAT ARE DISTRIBUTED SHALL BE RESTORED AND TESTED TO BE IN FULL COMPLIANCE WITH CURRENT GBRA STANDARDS. THE CONTRACTOR SHALL ADJUST EXISTING WATER AND WASTEWATER FACILITIES TO PROPOSED FINISHED GRADES INCLUDING BUT NOT LIMITED TO MANHOLES, CLEANOUTS, VALVES, HYDRANTS, APPURTENANCES, ETC.
- EXISTING MANHOLES THAT ARE DISTURBED SHALL BE RESTORED TO BE IN FULL COMPLIANCE WITH CURRENT GBRA STANDARDS INCLUDING TESTING, CORROSION RESISTANT LINING, RINGS AND COVERS, ETC.
- THE CONTRACTOR SHALL MAINTAIN SERVICES TO EXISTING WATER AND WASTEWATER SYSTEMS AT ALL TIMES DURING CONSTRUCTION. ANY WORK INVOLVING POWER OUTAGES, BYPASS PUMPING, PUMP AND HAULS, OR ANY OTHER INTERRUPTION OF FLOW MUST BE PERFORMED BETWEEN 8:00 AM AND 5:00 PM EXCLUDING WEEKENDS AND HOLIDAYS. ALL NECESSARY TEMPORARY POWER, BYPASS PUMPING, PUMP AND HAUL, TEMPORARY PLUGS, ETC., SHALL BE FURNISHED AND PERFORMED BY THE CONTRACTOR. COORDINATE AND SCHEDULE ANY SUCH ACTIVITIES WITH GBRA AT LEAST TWO (2) WEEKS IN ADVANCE.
- EXPLOSIVES AND BLASTINGS ARE NOT ALLOWED.
- ALL UTILITIES TO BE CONSTRUCTED PRIOR TO THE STREETS.
- NO VALVES, HYDRANTS, CLEANOUTS, ETC. SHALL BE CONSTRUCTED WITHIN CURBS, SIDEWALKS OR DRIVEWAYS.
- THIS PROJECT INCLUDES UTILITY INSTALLATIONS GREATER THAN 5- FEET IN DEPTH LOCATED IN PUBLIC RIGHT-OF-WAY OR EASEMENTS. DEEP TRENCHES POSE COMPACTION TESTING AND CONSTRUCTION CHALLENGES AND CITY METHODS FOR TESTING AND COMPACTION MAY NOT BE ACHIEVABLE. A UTILITY COMPACTION PLAN WILL BE REQUIRED AND MUST BE SUBMITTED FOR APPROVAL TO CITY PRIOR TO UTILITY INSTALLATION.

UTILITY TRENCH COMPACTION

ALL UTILITY TRENCH COMPACTION TESTS WITHIN THE STREET PAVEMENT/SIDEWALK SECTION SHALL BE THE RESPONSIBILITY OF THE DEVELOPER'S GEOTECHNICAL ENGINEER. FILL MATERIAL SHALL BE PLACED IN UNIFORM LAYERS NOT TO EXCEED TWELVE INCHES (12") LOOSE. DETERMINE THE MAXIMUM LIFT THICKNESS BASED ON THE ABILITY OF THE COMPACTING OPERATION AND EQUIPMENT USED TO MEET THE REQUIRED DENSITY. EACH LAYER OF MATERIAL SHALL BE COMPACTED TO A MINIMUM 95% DENSITY AND TESTED FOR DENSITY AND MOISTURE IN ACCORDANCE WITH TEST METHODS TEX-113-E, TEX-114-E, TEX-115-E. THE NUMBER AND LOCATION OF REQUIRED TESTS SHALL BE DETERMINED BY THE GEOTECHNICAL ENGINEER AND APPROVED BY THE CITY OF NEW BRAUNFELS STREET INSPECTOR. AT A MINIMUM, TESTS SHALL BE TAKEN EVERY 200 LF FOR EACH LIFT AND EVERY OTHER SERVICE LINE. UPON COMPLETION OF TESTING THE GEOTECHNICAL ENGINEER SHALL PROVIDE THE CITY OF NEW BRAUNFELS STREET INSPECTOR WITH ALL TESTING DOCUMENTATION AND A CERTIFICATION STATING THAT THE PLACEMENT OF FILL MATERIAL HAS BEEN COMPLETED IN ACCORDANCE WITH THE PLANS. ADDITIONAL DENSITY TESTS MAY BE REQUESTED BY THE CITY OF NEW BRAUNFELS INSPECTOR.

TRENCHING NOTE


THIS PROJECT INCLUDES UTILITY INSTALLATIONS GREATER THAN 5 FEET IN DEPTH LOCATED IN PUBLIC RIGHT-OF-WAY OR EASEMENTS. DEEP TRENCHES POSE COMPACTION TESTING AND CONSTRUCTION CHALLENGES, AND CITY METHODS FOR TESTING AND COMPACTION MAY NOT BE ACHIEVABLE. A UTILITY COMPACTION PLAN WILL BE REQUIRED AND MUST BE SUBMITTED TO CITY PRIOR TO UTILITY INSTALLATION.

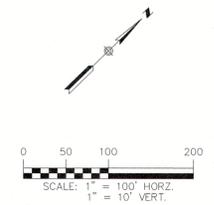

LEGEND

| | |
|-----------|-----------------------------|
| ---700--- | EXISTING CONTOURS |
| [700] | PROPOSED CONTOURS |
| B.L. | BUILDING SETBACK LINE |
| U.E. | UTILITY EASEMENT |
| D.E. | DRAINAGE EASEMENT |
| --- | EXISTING WASTEWATER LINE |
| --- | PROPOSED WASTEWATER LINE |
| --- | PROPOSED WASTEWATER SERVICE |
| --- | UTILITY CROSSING |

UTILITY NOTES:
1. ALL UTILITIES TO BE CONSTRUCTED PRIOR TO THE STREETS.

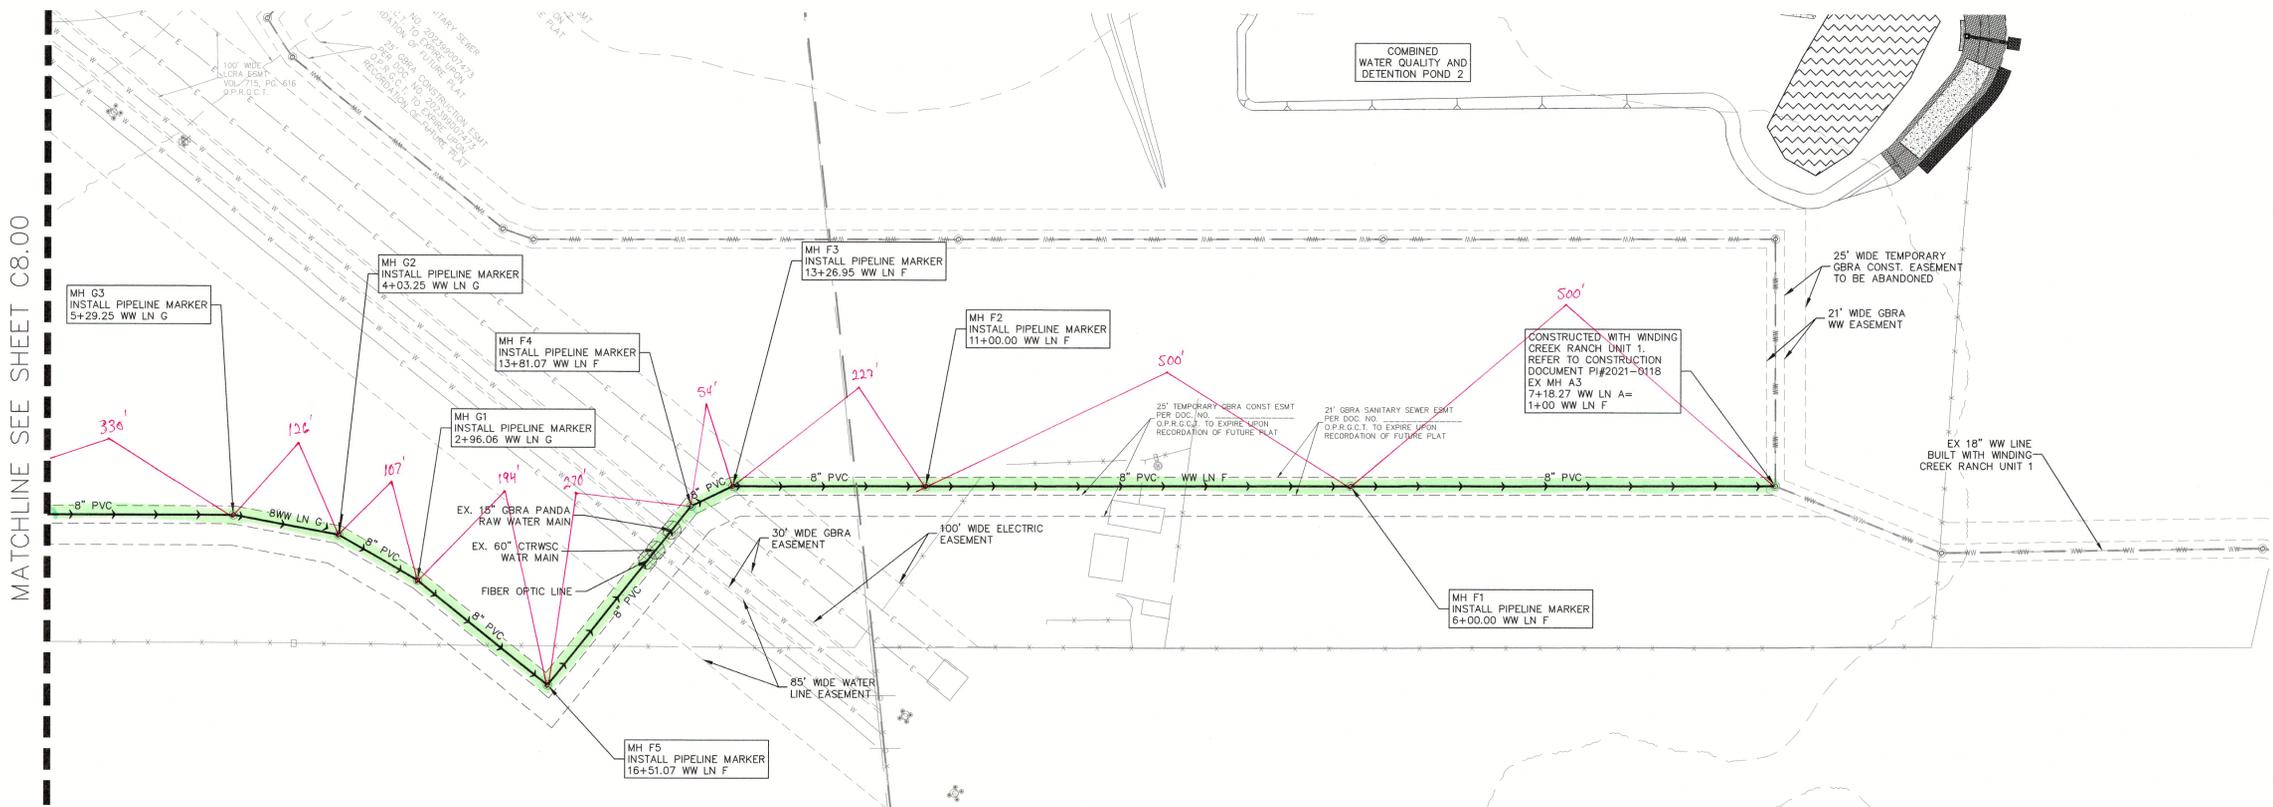

FOR CONSTRUCTION

REFER TO THE COVER SHEET FOR BENCHMARK INFORMATION.

THE LOCATION OF ALL EXISTING UNDERGROUND UTILITIES ARE SHOWN IN APPROXIMATE LOCATIONS ONLY. THE CONTRACTOR SHALL DETERMINE THE EXACT LOCATION OF ALL EXISTING UTILITIES BEFORE COMMENCING WORK. THE CONTRACTOR WILL AGREE TO BE FULLY RESPONSIBLE FOR ANY AND ALL DAMAGES WHICH MIGHT BE INCURRED BY THEIR FAILURE TO EXACTLY LOCATE AND PRESERVE ANY AND ALL UNDERGROUND UTILITIES OR FACILITIES. CONTRACTOR SHALL NOTIFY ENGINEER OF ANY DISCREPANCIES 24-HOURS PRIOR TO COMMENCING CONSTRUCTION.

Drawing Name: N:\Projects\031 - DR Horton\031.097 - Winding Creek Ranch Unit 3\CD\031.097_WWTR.dwg User: jrm Sep 25, 2023 - 2:38pm

290 S. CASTELL AVE., STE. 100
NEW BRAUNFELS, TX 78130
TBPE FIRM F-10961
TBPLS FIRM 1053600



06/19/2023

**OVERALL WASTEWATER
(2 OF 2)**
WINDING CREEK RANCH UNIT 3
NEW BRAUNFELS, TEXAS

| NO. | REVISION DESCRIPTION | REVISION DATE |
|-----|----------------------|---------------|
| | | |
| | | |
DATE: APRIL 2023
DRAWN BY: JAD
DESIGNED BY: CAT
REVIEWED BY: CVH
HMT PROJECT NO.: 031.097

**SHEET
C8.01**