


Date: Feb. 02, 2024, 9:35am User ID: tcomacho
File: E:\2023\12\22\23\122223\122223.dwg



THIS DOCUMENT HAS BEEN PRODUCED FROM MATERIAL THAT WAS STORED AND/OR TRANSMITTED ELECTRONICALLY AND MAY HAVE BEEN INADVERTENTLY ALTERED. RELY ONLY ON FINAL HARD COPY MATERIALS BEARING THE CONSULTANT'S ORIGINAL SIGNATURE AND SEAL. AERIAL IMAGERY PROVIDED BY GOOGLE UNLESS OTHERWISE NOTED. Imagery © 2014 CAPOCO Digital Data, Texas Orthographic Program, USDA Farm Service Agency.

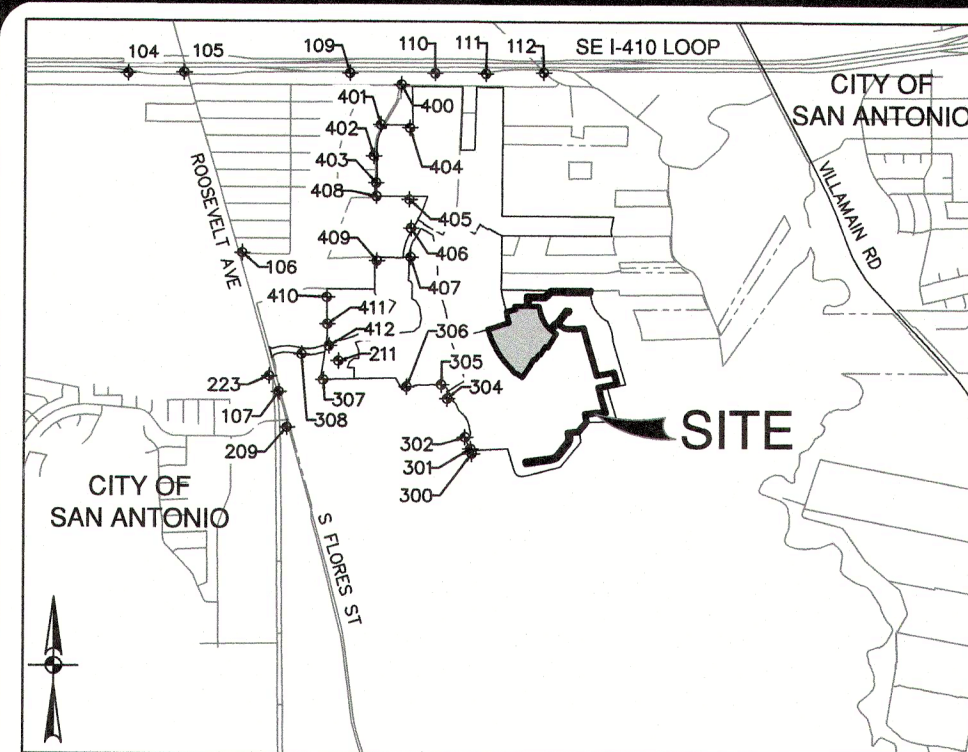

BENCHMARK LOCATION MAP
NOT TO SCALE



BENCHMARKS

NUMBER	NORTHING/EASTING	ELEVATION	DESCRIPTION
104	2134235.64	1367131.27	SIGTV
105	2135225.14	1367152.88	SIGTV
106	2136253.51	1367399.19	SIGTV
107	2136910.77	1367155.14	SIGTV
109	2138141.40	1367147.99	SIGTV
110	2139641.31	1367151.22	SIGTV
111	2140529.66	1367147.55	SIGTV
112	2141547.03	1367170.87	SIGTV
209	2137056.40	1366093.88	SIRCTV
211	2137959.03	1366210.28	SIRCTV
223	2136739.20	1366183.78	SIRCTV
300	2140313.48	1366047.95	SIRCTV
301	2140289.02	1366058.62	SIRCTV
302	2140195.36	1366076.07	SIRCTV
304	2139877.28	1366144.05	SIRCTV
305	2139775.87	1366169.85	SIRCTV
306	2139161.43	1366165.29	SIRCTV
307	2137696.58	13661770.81	SIRCTV
308	2137306.70	1366221.96	SIRCTV
401	2139049.73	1366694.91	SIRCTV
402	2138689.77	1366650.38	SIRCTV
403	2138565.79	1366596.4	SIRCTV
404	2138610.70	1366522.03	SIRCTV
405	2139202.41	13666191.18	SIRCTV
406	2139197.12	1366492.25	SIRCTV
407	2139228.36	1366442.15	SIRCTV
408	2139224.11	1366392.62	SIRCTV
409	2138815.57	1366498.71	SIRCTV
410	2138628.71	1366386.0	SIRCTV
411	2137752.56	1366321.55	SIRCTV
412	2137759.32	1366245.14	SIRCTV
413	2137791.62	1366233.23	SIRCTV

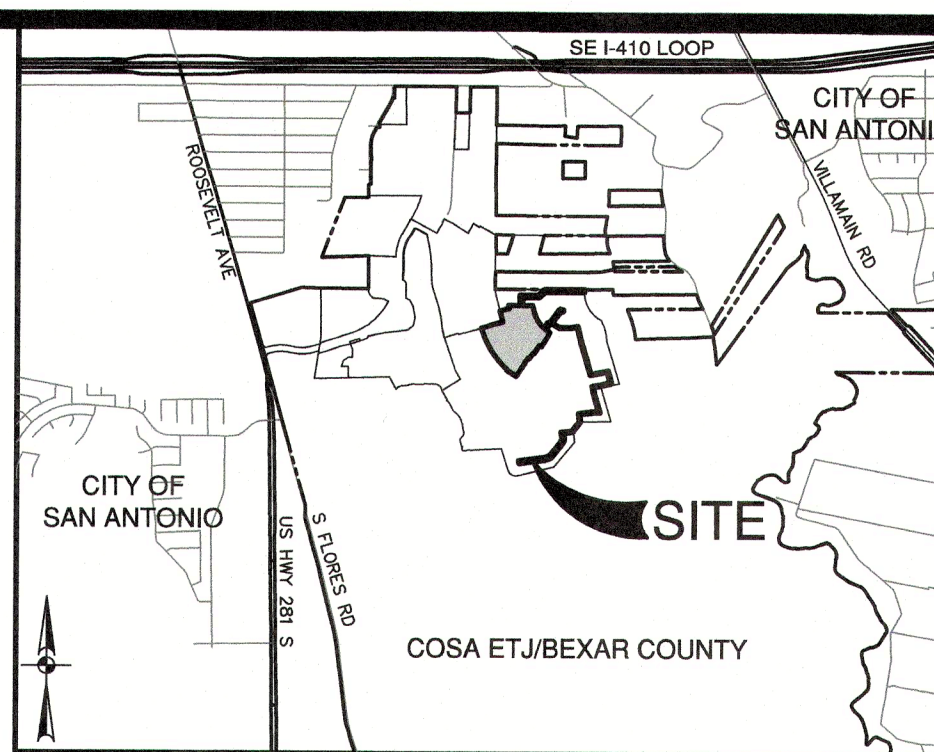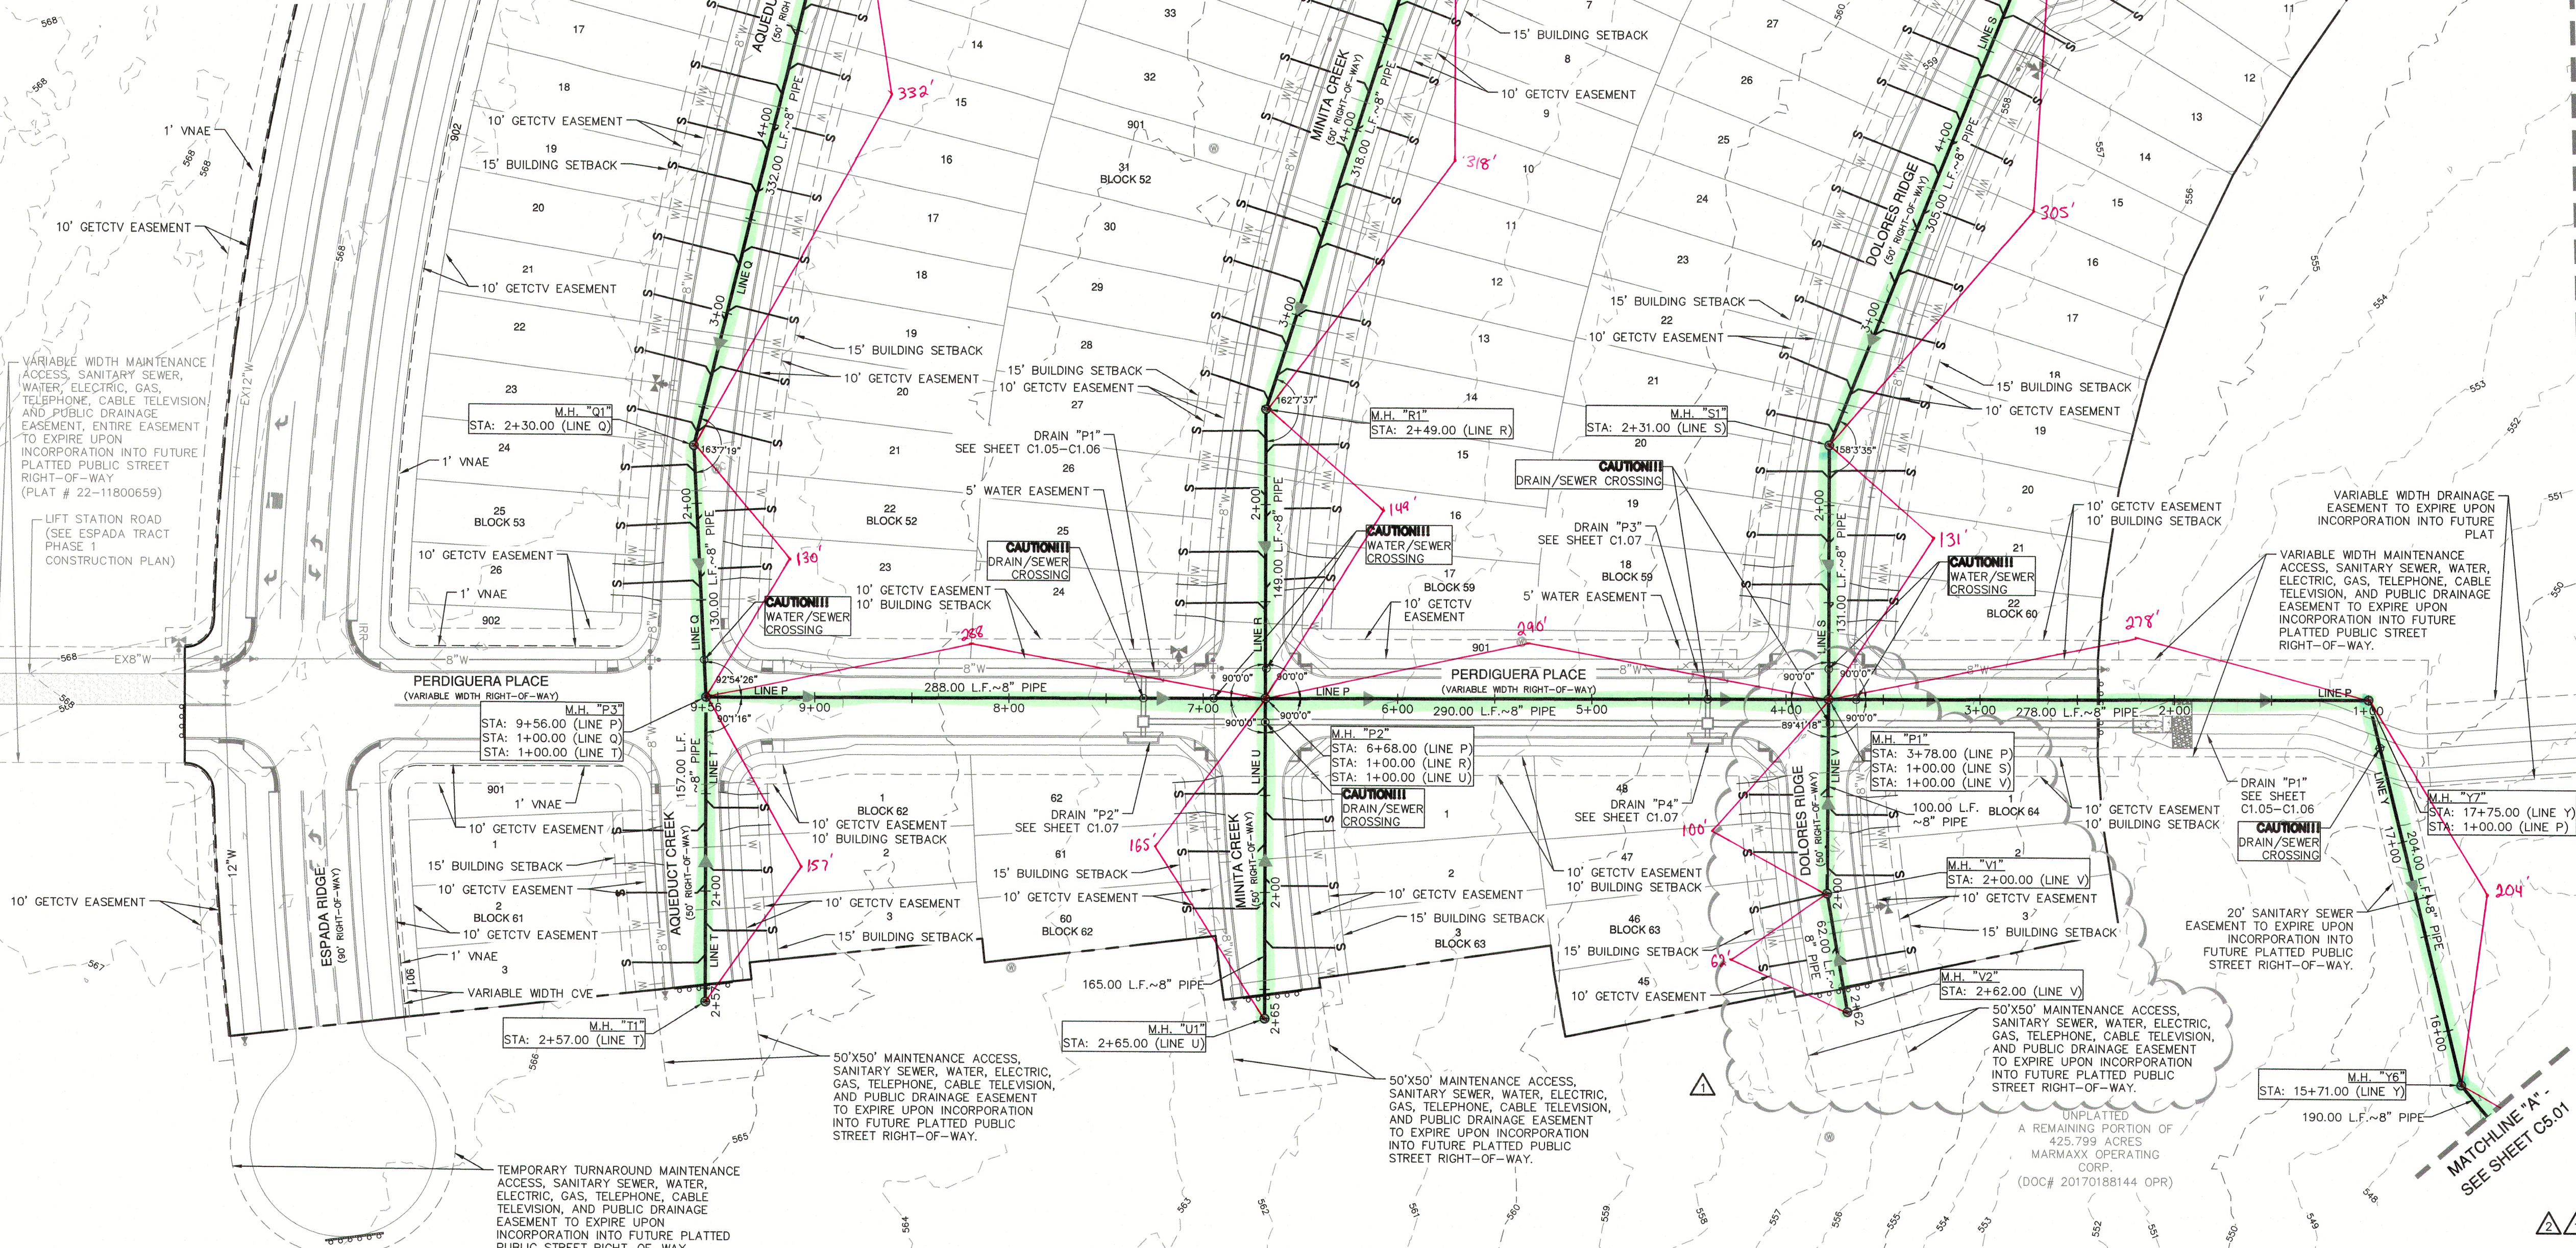

LOCATION MAP
NOT TO SCALE

SEWER LEGEND

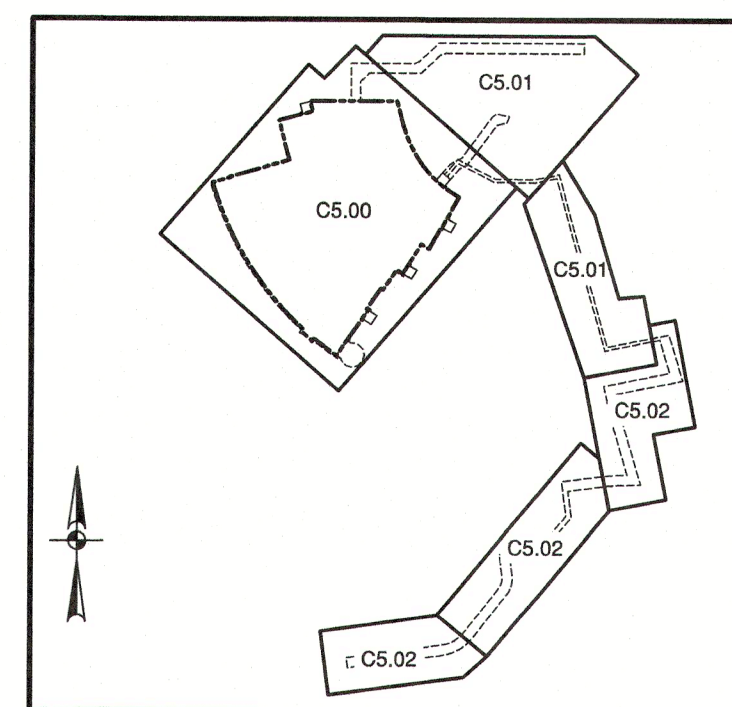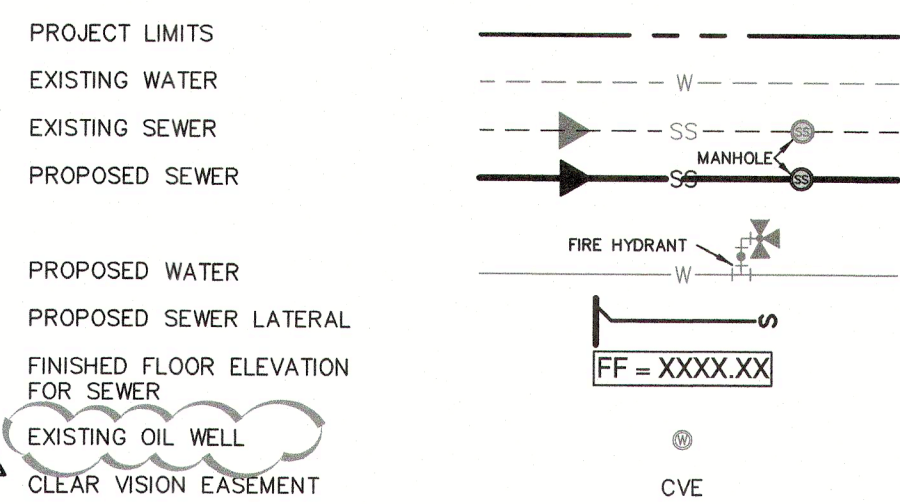

MAP INDEX
NOT TO SCALE

CAUTION!!

CONTRACTOR SHALL BE REQUIRED TO LOCATE ALL PUBLIC OR PRIVATE UTILITIES INCLUDING BUT NOT LIMITING TO: WATER, SEWER, TELEPHONE AND FIBER OPTIC LINES, SITE LIGHTING, SECONDARY ELECTRIC, PRIMARY ELECTRICAL, DUCTBANKS, LANDSCAPE IRRIGATION FACILITIES, AND GAS LINES. ANY UTILITY CONFLICTS THAT ARISE SHOULD BE COMMUNICATED TO THE ENGINEER IMMEDIATELY AND PRIOR TO CONSTRUCTION. THE CONTRACTOR SHALL CONTACT 1-800-DIG-TESS A MINIMUM OF 48 HOURS PRIOR TO THE START OF CONSTRUCTION. ANY DAMAGE TO EXISTING UTILITIES SHALL BE THE SOLE RESPONSIBILITY OF THE CONTRACTOR AND THE REPAIR SHALL BE AT CONTRACTOR'S SOLE EXPENSE WHETHER THE UTILITY IS SHOWN ON THESE PLANS OR NOT.

FINISHED FLOOR NOTES:

1. THE FINISHED FLOOR ELEVATIONS (FF) REPRESENT THE MINIMUM POSSIBLE FLOOR ELEVATION TO PROVIDE SANITARY SEWER SERVICE TO EACH LOT. ACTUAL FINISHED FLOOR ELEVATIONS FOR EACH LOT ARE TO BE DETERMINED BY THE BUILDER AND SHALL TAKE INTO CONSIDERATION AS-BUILT CONDITIONS FOR FOUND SEWER SERVICES AND ACTUAL LATERAL PLACEMENT. IT IS THE BUILDER'S SOLE RESPONSIBILITY TO DETERMINE ACTUAL FINISHED FLOOR ELEVATIONS FOR EACH LOT PRIOR TO THE START OF HOME FOUNDATION CONSTRUCTION TAKING INTO CONSIDERATION SITE DRAINAGE, STREET ACCESS AND SANITARY SEWER SERVICE ELEVATIONS.

2. THE MINIMUM SANITARY SEWER LATERAL GRADES WERE BASED UPON THE MINIMUM FINISHED FLOOR ELEVATIONS FOR THE LOTS LOCATED ON THE DOWNHILL SIDES OF THE PROPOSED ROADWAYS.

ROW PERMIT NOTE:

A BEXAR COUNTY PERMIT MUST BE OBTAINED BEFORE WORKING IN BEXAR COUNTY RIGHTS-OF-WAY.

TRENCH EXCAVATION SAFETY PROTECTION:

CONTRACTOR AND/OR CONTRACTOR'S INDEPENDENTLY RETAINED EMPLOYEE OR STRUCTURAL DESIGN/ GEOTECHNICAL/ SAFETY/EQUIPMENT CONSULTANT, IF ANY, SHALL REVIEW THESE PLANS AND ANY AVAILABLE GEOTECHNICAL INFORMATION AND THE ANTICIPATED INSTALLATION SITES WITHIN THE PROJECT WORK AREA IN ORDER TO IMPLEMENT CONTRACTOR'S TRENCH EXCAVATION SAFETY PROTECTION SYSTEMS, PROGRAMS AND/OR PROCEDURES FOR THE PROJECT DESCRIBED IN THE CONTRACT DOCUMENTS. THE CONTRACTOR'S IMPLEMENTATION OF THESE SYSTEMS, PROGRAMS AND/OR PROCEDURES SHALL PROVIDE FOR ADEQUATE TRENCH EXCAVATION SAFETY PROTECTION THAT COMPLY WITH AS A MINIMUM, OSHA STANDARDS FOR TRENCH EXCAVATIONS. SPECIFICALLY, CONTRACTOR AND/OR CONTRACTOR'S INDEPENDENTLY RETAINED EMPLOYEE OR SAFETY CONSULTANT SHALL IMPLEMENT A TRENCH SAFETY PROGRAM IN ACCORDANCE WITH OSHA STANDARDS GOVERNING THE PRESENCE AND ACTIVITIES OF INDIVIDUALS WORKING IN AND AROUND TRENCH EXCAVATION.

LOWER - EAST SEWERSHED - DOS RIOS/LEON CREEK

DEVELOPER'S NAME: LENNAR HOMES OF TEXAS
ADDRESS: 100 NE LOOP 410, STE. 1155
CITY: SAN ANTONIO STATE: TEXAS ZIP: 78216
PHONE# (210) 403-6200 FAX# N/A
SAWS BLOCK MAP# 170536 TOTAL EDU'S 138 TOTAL ACREAGE 19.33
TOTAL LINEAR FOOTAGE OF PIPE: 2899 LF ~ 1276' PLAT NO. 23-11800231
NUMBER OF LOTS 138 SAWS JOB NO. 23-1603

NO.	REVISION	DATE
1	REVISED EX SAWS JOB # SAWS	12/22/23
2	BLOCK, LEGEND AND SEWER	02/07/24
3	REVISED SAWS BLOCK	02/07/24




PAPE-DAWSON
ENGINEERS

SAN ANTONIO | AUSTIN | HOUSTON | FORT WORTH | DALLAS
2000 NW LOOP 410 | SAN ANTONIO, TX 78213 | 210.375.9000
TEXAS ENGINEERING FIRM #72 | TEXAS SURVEYING FIRM #1002800


ESPADA TRACT UNIT 15
SAN ANTONIO, TEXAS

OVERALL SANITARY SEWER PLAN

PLAT NO. 23-11800231
JOB NO. 12632-14
DATE JULY 2023
DESIGNER JG
CHECKED DW, DRAWN TC
SHEET C5.00

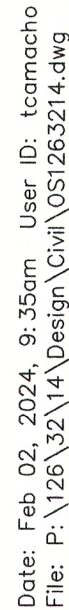

THIS DOCUMENT HAS BEEN PRODUCED FROM MATERIAL THAT WAS STORED AND/OR TRANSMITTED ELECTRONICALLY AND MAY HAVE BEEN INADVERTENTLY ALTERED. RELY ONLY ON FINAL HARDCOPY MATERIALS BEARING THE CONSULTANT'S ORIGINAL SIGNATURE AND SEAL. AERIAL IMAGERY PROVIDED BY GOOGLE© UNLESS OTHERWISE NOTED. Imagery © 2016, CAPCO3, Digital Globe, Texas Orthomosaic Program, USDA Farm Service Agency

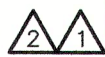

CONTRACTOR SHALL BE REQUIRED TO LOCATE ALL PUBLIC OR PRIVATE UTILITIES INCLUDING BUT NOT LIMITING TO: WATER, SEWER, TELEPHONE AND FIBER OPTIC LINES, SITE LIGHTING ELECTRIC, SECONDARY ELECTRIC, PRIMARY ELECTRICAL DUCTBANKS, LANDSCAPE IRRIGATION FACILITIES, AND GAS LINES. ANY UTILITY CONFLICTS THAT ARISE SHOULD BE COMMUNICATED TO THE ENGINEER IMMEDIATELY AND PRIOR TO CONSTRUCTION. THE CONTRACTOR SHALL NOT BE ALLOWED TO DIG-TEST A MINIMUM OF 48 HOURS PRIOR TO THE START OF CONSTRUCTION. ANY DAMAGE TO EXISTING UTILITIES SHALL BE THE SOLE RESPONSIBILITY OF THE CONTRACTOR AND THE REPAIR SHALL BE AT CONTRACTOR'S SOLE EXPENSE WHETHER THE UTILITY IS SHOWN ON THESE PLANS OR NOT.

FINISHED FLOOR NOTES:

1. THE FINISHED FLOOR ELEVATIONS (FF) REPRESENT THE MINIMUM POSSIBLE FLOOR ELEVATION TO PROVIDE SANITARY SEWER SERVICE TO EACH LOT. ACTUAL FINISHED FLOOR ELEVATIONS FOR EACH LOT ARE TO BE DETERMINED BY THE BUILDER AND SHALL TAKE INTO CONSIDERATION AS-BUILT CONDITIONS FOR FOUND SEWER SERVICES AND ACTUAL LATERAL PLACEMENT. IT IS THE BUILDER'S SOLE RESPONSIBILITY TO DETERMINE ACTUAL FINISHED FLOOR ELEVATIONS FOR EACH LOT PRIOR TO THE START OF HOME FOUNDATION CONSTRUCTION TAKING INTO CONSIDERATION SITE DRAINAGE, STREET ACCESS AND SANITARY SEWER SERVICE ELEVATIONS.

ROW PERMIT NOTE:


A BEXAR COUNTY PERMIT MUST BE OBTAINED BEFORE WORKING IN BEXAR COUNTY RIGHTS-OF-WAY.

TRENCH EXCAVATION SAFETY PROTECTION:

CONTRACTOR AND/OR CONTRACTOR'S INDEPENDENTLY RETAINED EMPLOYEE OR STRUCTURAL DESIGN/ GEOTECHNICAL/ SAFETY/EQUIPMENT CONSULTANT, IF ANY, SHALL REVIEW THESE PLANS AND ANY AVAILABLE GEOTECHNICAL INFORMATION AND THE PROPOSED INSTALLATION DETAILS WITHIN THE PROJECT WORK AREA IN ORDER TO IDENTIFY IMPORTANT GEOTECHNICAL EXCAVATION SAFETY PROTECTION SYSTEMS, PROGRAMS AND/OR PROCEDURES FOR THE PROJECT DESCRIBED IN THE CONTRACT DOCUMENTS. THE CONTRACTOR'S IMPLEMENTATION OF THESE SYSTEMS, PROGRAMS AND/OR PROCEDURES SHALL BE IN ACCORDANCE WITH THE PREVALENT AND BEST PRACTICE SAFETY PROTECTION THAT COMPLY WITH AS A MINIMUM, OSHA STANDARDS FOR TRENCH EXCAVATIONS. SPECIFICALLY, CONTRACTOR AND/OR CONTRACTOR'S INDEPENDENTLY RETAINED EMPLOYEE OR SAFETY ENGINEER SHALL BE RESPONSIBLE FOR TRENCH SAFETY PROTECTION IN ACCORDANCE WITH OSHA STANDARDS GOVERNING THE PREVALENT AND ACTIVITIES OF INDIVIDUALS WORKING IN AND AROUND TRENCH EXCAVATION.

LOWER - EAST SEWERSHED - DOS RIOS/LEON CREEK

DEVELOPER'S NAME: LENNAR HOMES OF TEXAS	
ADDRESS: 100 NE LOOP 410, STE. 1155	
CITY: SAN ANTONIO	STATE: TEXAS ZIP: 78216
PHONE# (210) 403-6200	FAX# N/A
SAWS BLOCK MAP# 170536 TOTAL EDU'S 138 TOTAL ACREAGE 19.33	
TOTAL LINEAR FOOT OF PIPE: 2899 LF - 2" PVC 5275 LF - 6" PVC	
PLAT NO 23-11800231	
NUMBER OF LOTS 138	SAWS JOB NO. 23-1603

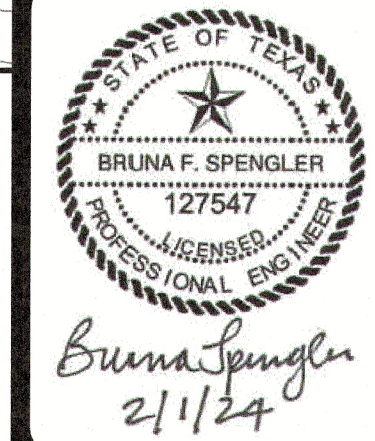[illegible]

**PAPE-DAWSON
ENGINEERS**





SAN ANTONIO | AUSTIN | HOUSTON | FORT WORTH | DALLAS
2000 NW LOOP 410 | SAN ANTONIO, TX 78213 | 210.375.9000
TEXAS ENGINEERING FIRM #470 | TEXAS SURVEYING FIRM #10028800

ESPADA TRACT UNIT 15


SAN ANTONIO, TEXAS

OVERALL SANITARY SEWER PLAN

PLAT NO. 23-11800231
JOB NO. 12632-14
DATE JULY 2023
DESIGNER JG
CHECKED DW DRAWN TC
SHEET C5.01

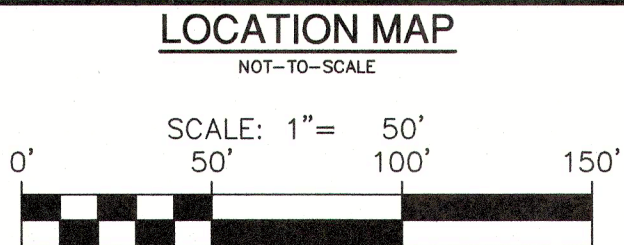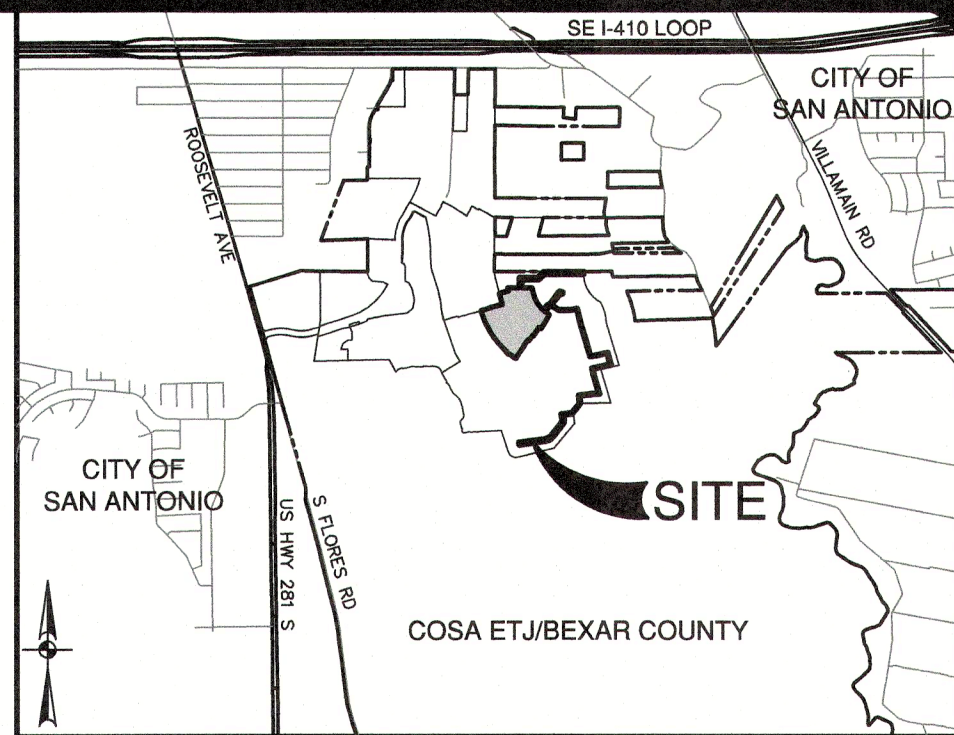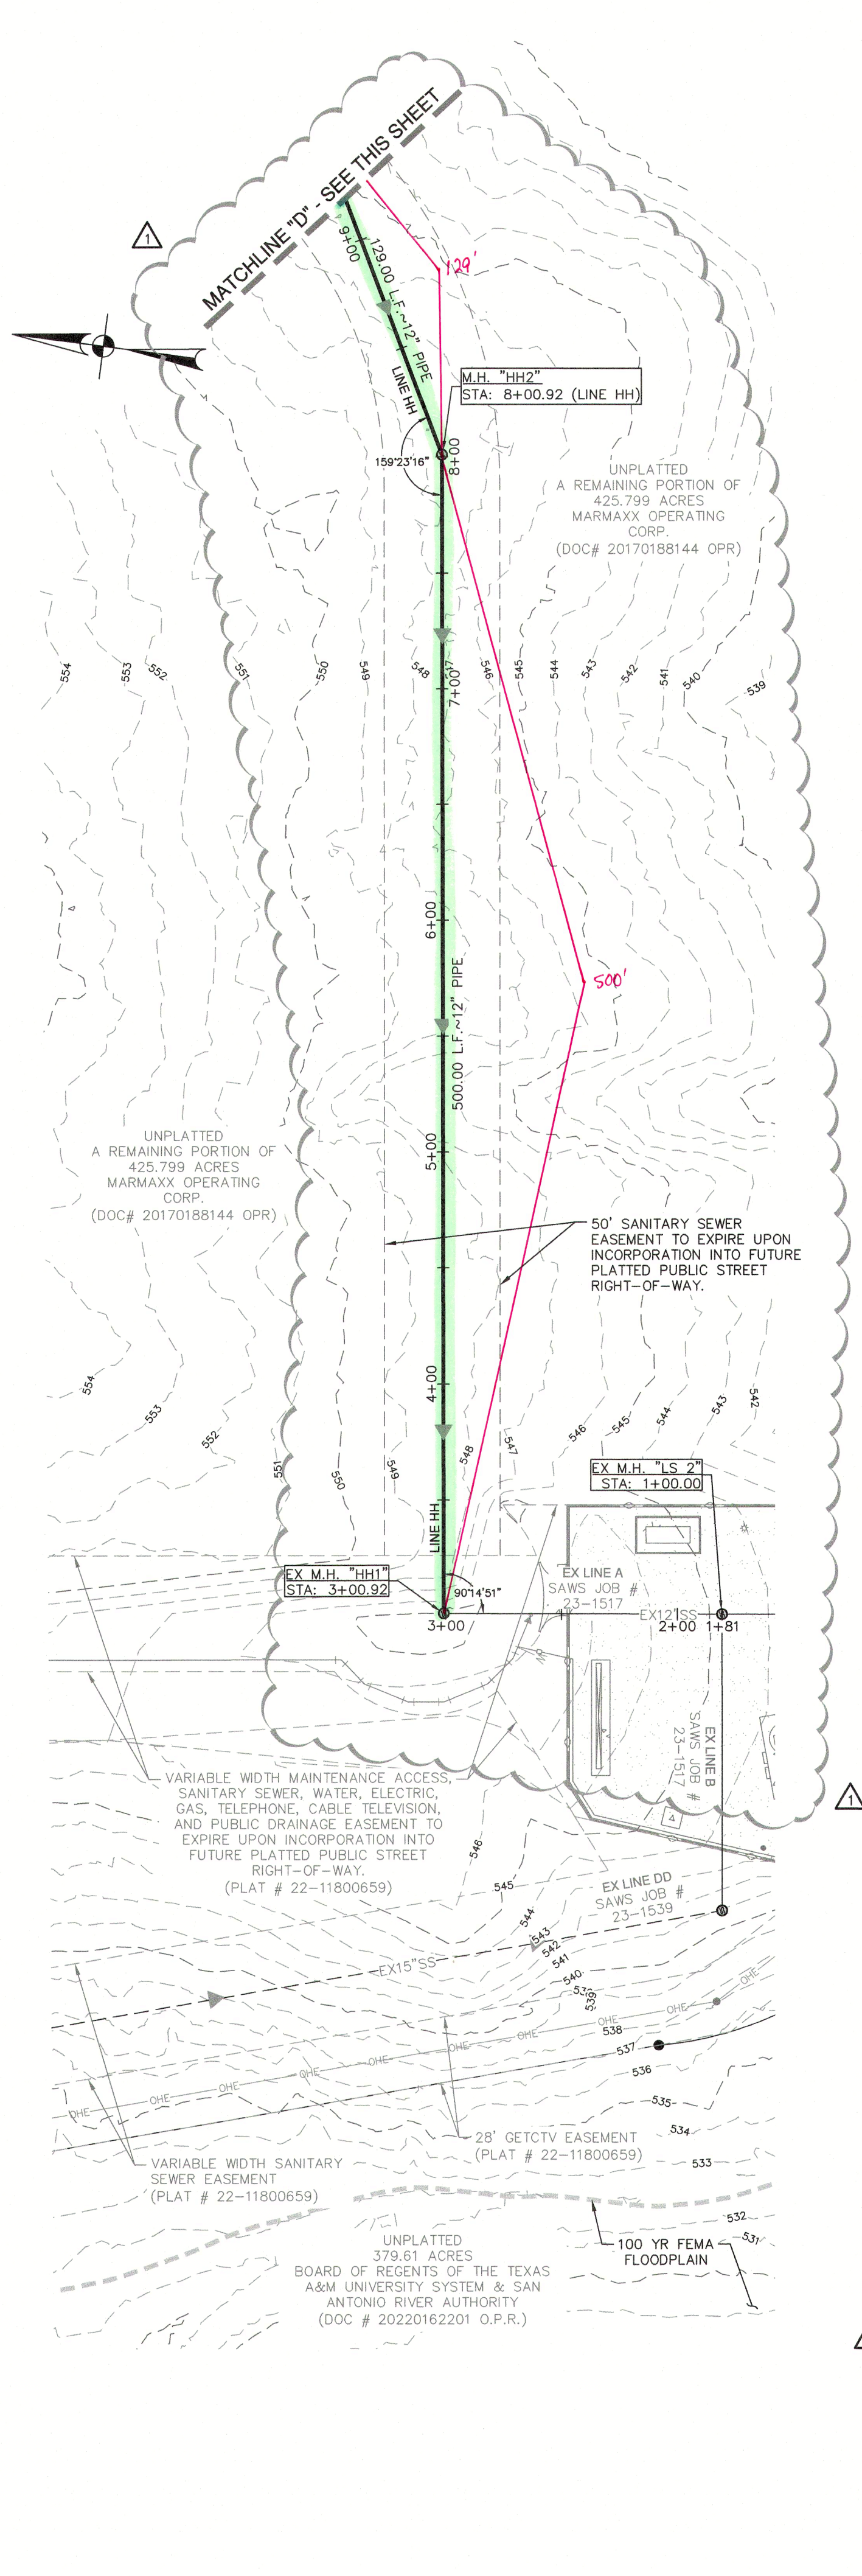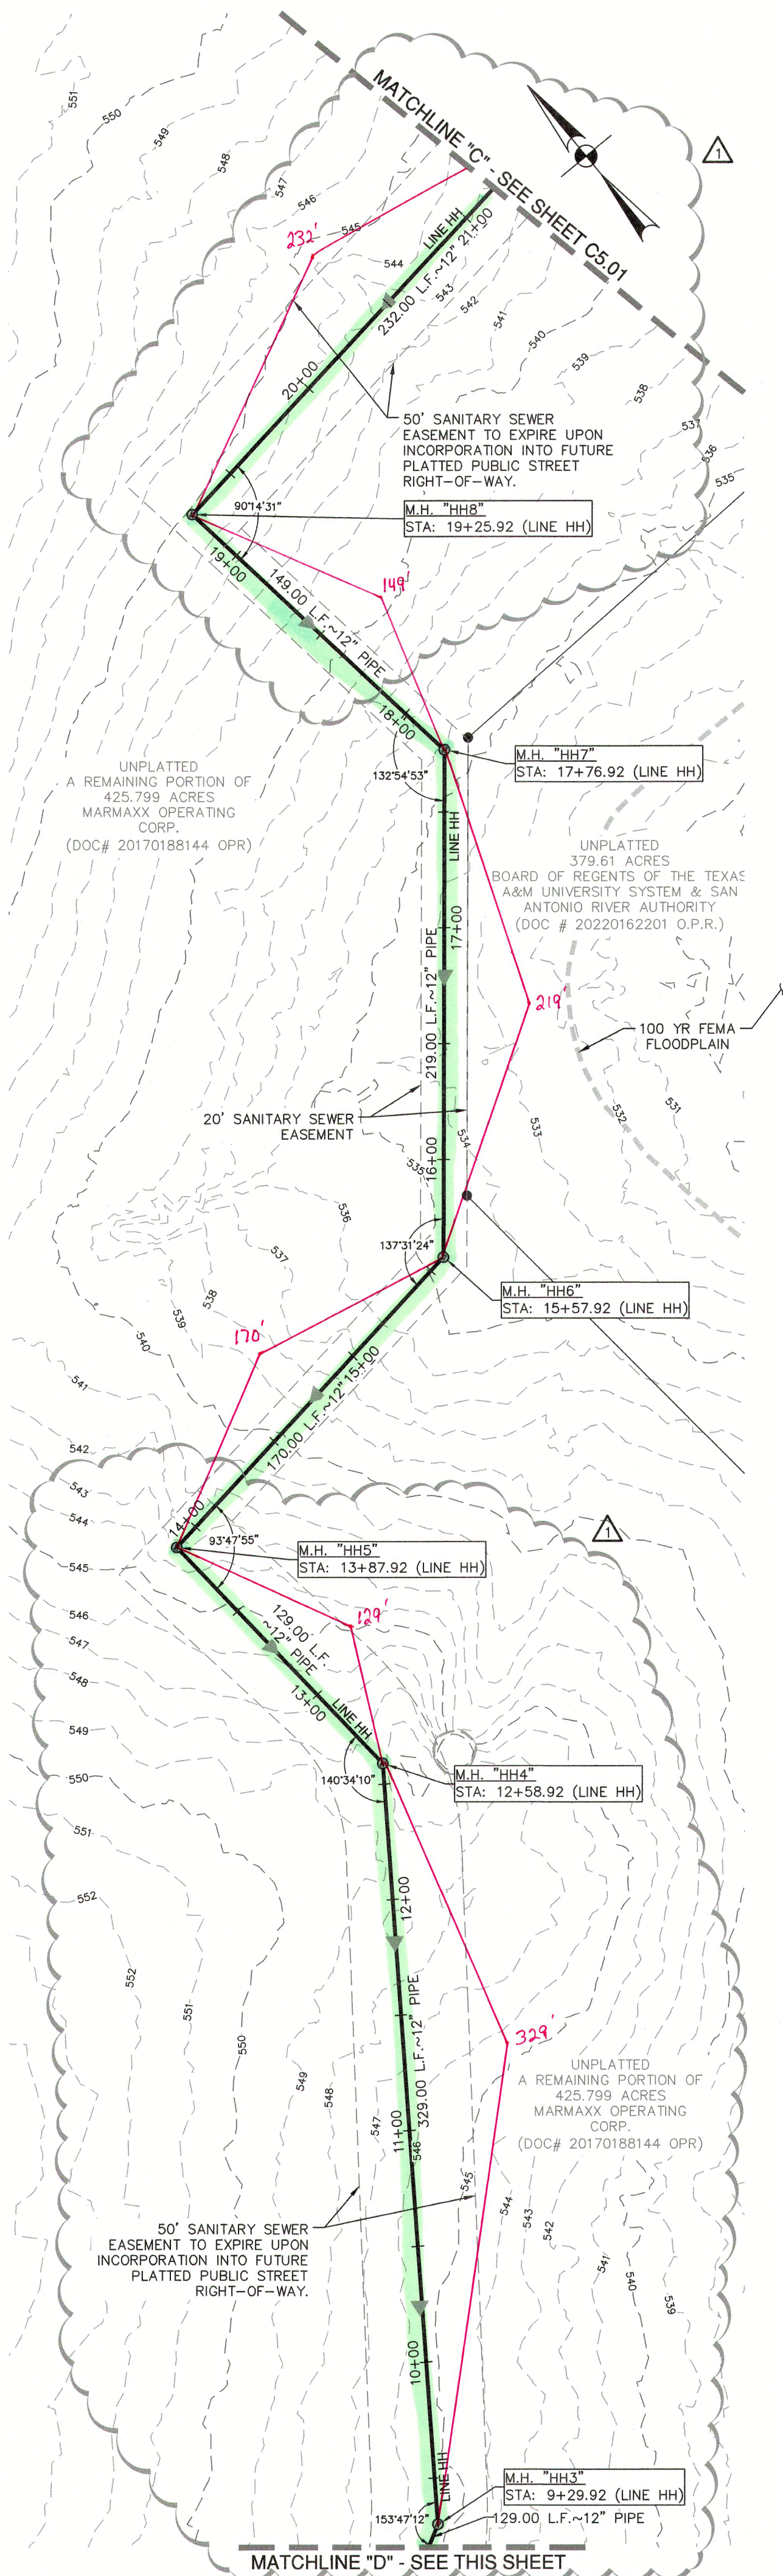

SEWER LEGEND

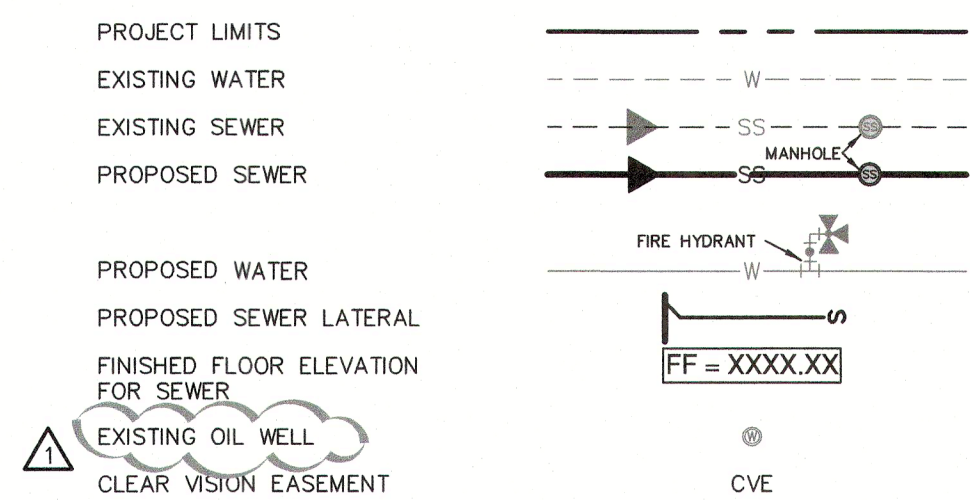

CAUTION!!

CONTRACTOR SHALL BE REQUIRED TO LOCATE ALL PUBLIC OR PRIVATE UTILITIES INCLUDING BUT NOT LIMITING TO: WATER, SEWER, TELEPHONE, AND FIBER OPTIC LINES, SITE LIGHTING, ELECTRIC, SECONDARY ELECTRIC, PRIMARY ELECTRICAL DUCTBANKS, LANDSCAPE IRRIGATION FACILITIES, AND GAS LINES. ANY UTILITY CONFLICTS THAT ARISE SHOULD BE COMMUNICATED TO THE ENGINEER IMMEDIATELY AND PRIOR TO CONSTRUCTION. THE CONTRACTOR SHALL CONTACT 1-800-DIG-TESS A MINIMUM OF 48 HOURS PRIOR TO THE START OF CONSTRUCTION. ANY DAMAGE TO EXISTING UTILITIES SHALL BE THE SOLE RESPONSIBILITY OF THE CONTRACTOR AND THE REPAIR SHALL BE AT CONTRACTOR'S SOLE EXPENSE WHETHER THE UTILITY IS SHOWN ON THESE PLANS OR NOT.

FINISHED FLOOR NOTES:

1. THE FINISHED FLOOR ELEVATIONS (FF) REPRESENT THE MINIMUM POSSIBLE FLOOR ELEVATION TO PROVIDE SANITARY SEWER SERVICE TO EACH LOT. ACTUAL FINISHED FLOOR ELEVATIONS FOR EACH LOT ARE TO BE DETERMINED BY THE BUILDER AND SHALL TAKE INTO CONSIDERATION AS-BUILT CONDITIONS FOR FOUND SEWER SERVICES AND ACTUAL LATERAL PLACEMENT. IT IS THE BUILDER'S SOLE RESPONSIBILITY TO DETERMINE ACTUAL FINISHED FLOOR ELEVATIONS FOR EACH LOT PRIOR TO THE START OF HOME FOUNDATION CONSTRUCTION TAKING INTO CONSIDERATION SITE DRAINAGE, STREET ACCESS AND SANITARY SEWER SERVICE ELEVATIONS.
2. THE MINIMUM SANITARY SEWER LATERAL GRADES WERE BASED UPON THE MINIMUM FINISHED FLOOR ELEVATIONS FOR THE LOTS LOCATED ON THE DOWNHILL SIDES OF THE PROPOSED ROADWAYS.

ROW PERMIT NOTE:

A BEXAR COUNTY PERMIT MUST BE OBTAINED BEFORE WORKING IN BEXAR COUNTY RIGHTS-OF-WAY.

TRENCH EXCAVATION SAFETY PROTECTION:

CONTRACTOR AND/OR CONTRACTOR'S INDEPENDENTLY RETAINED EMPLOYEE OR STRUCTURAL DESIGN/ GEOTECHNICAL/ SAFETY/EQUIPMENT CONSULTANT, IF ANY, SHALL REVIEW THESE PLANS AND ANY AVAILABLE GEOTECHNICAL INFORMATION AND THE ANTICIPATED INSTALLATION SITES WITHIN THE PROJECT WORK AREA IN ORDER TO IMPLEMENT CONTRACTOR'S TRENCH EXCAVATION SAFETY PROTECTION SYSTEMS, PROGRAMS AND/OR PROCEDURES FOR THE PROJECT DESCRIBED IN THE CONTRACT DOCUMENTS. THE CONTRACTOR'S IMPLEMENTATION OF THESE SYSTEMS, PROGRAMS AND/OR PROCEDURES SHALL PROVIDE FOR ADEQUATE TRENCH EXCAVATION SAFETY PROTECTION THAT COMPLY WITH AS A MINIMUM, OSHA STANDARDS FOR TRENCH EXCAVATIONS. SPECIFICALLY, CONTRACTOR AND/OR CONTRACTOR'S INDEPENDENTLY RETAINED EMPLOYEE OR SAFETY CONSULTANT SHALL IMPLEMENT A TRENCH SAFETY PROGRAM IN ACCORDANCE WITH OSHA STANDARDS GOVERNING THE PRESENCE AND ACTIVITIES OF INDIVIDUALS WORKING IN AND AROUND TRENCH EXCAVATION.

DEVELOPER'S NAME: LENNAR HOMES OF TEXAS	
ADDRESS: 100 NE LOOP 410, STE. 1155	
CITY: SAN ANTONIO	STATE: TEXAS ZIP: 78216
PHONE# (210) 403-6200	FAX# N/A
SAWS BLOCK MAP# 170536 TOTAL EDU'S 138 TOTAL ACREAGE 19.33	
TOTAL LINEAR FOOTAGE OF PIPE: 5217 LF-8" PVC PLAT NO 23-11800231	
NUMBER OF LOTS 138 SAWS JOB NO. 23-1603	

NO.	REVISION	DATE
1	REVISED SEWER ESMT, SAWS	12/22/23
2	BLOCK AND LEGEND	02/07/24
2	REVISED SAWS BLOCK	



PAPE-DAWSON
ENGINEERS

SAN ANTONIO | AUSTIN | HOUSTON | FORT WORTH | DALLAS
2000 NW LOOP 410 | SAN ANTONIO, TX 78213 | 210.375.9000
TEXAS ENGINEERING FIRM #470 | TEXAS SURVEYING FIRM #10028860

ESPADA TRACT UNIT 15

SAN ANTONIO, TEXAS

OVERALL SANITARY SEWER PLAN

PLAT NO. 23-11800231
JOB NO. 12632-14
DATE JULY 2023
DESIGNER JG
CHECKED DW DRAWN TC
SHEET C5.02