

PROJECT LOCATION MAP

SCALE: N.T.S.

PROJECT BENCHMARK

SITE TBM #1
SET TBM #50
N: 13826117.760
E: 22708943.061
ELEV: 647.78

SITE TBM #3
SET TBM #52
N: 13823280.018
E: 2269104.327
ELEV: 724.60

SITE TBM #2
SET TBM #51
N: 13824938.543
E: 2270011.970
ELEV: 718.08

LEGAL DESCRIPTION

BEING A 40.15 ACRE TRACT OF LAND, SITUATED IN THE NANCY KENNER SURVEY NO. 2, ABSTRACT NO. 306, COMAL COUNTY, TEXAS. BEING A PORTION OF A CALLED 150.643 ACRE TRACT RECORDED IN DOCUMENT NO. 202306036543 OF OFFICIAL PUBLIC RECORDS, COMAL COUNTY, TEXAS.

PROJECT DESCRIPTION

THIS PROJECT CONSISTS OF A 40.15 ACRE TRACT FOR SINGLE FAMILY, DETACHED RESIDENTIAL SUBDIVISION WITH 160 LOTS.

KYNDWOOD MUNICIPAL UTILITY DISTRICT (M.U.D.)

REVIEW OF THE PLANS BY THE DISTRICT IS LIMITED TO WATER, WASTEWATER AND DRAINAGE AND DOES NOT INDICATE A REVIEW OF THE ADEQUACY OF THE DESIGN FOR THE FACILITIES. IN APPROVING THESE PLANS THE DISTRICT MUST RELY ON THE ADEQUACY OF THE WORK OF THE DESIGN ENGINEER.

DISTRICT ENGINEER

GENERAL NOTES:

1. IF CONSTRUCTION HAS NOT COMMENCED WITHIN ONE-YEAR OF CITY APPROVAL FOR CONSTRUCTION INSPECTION, THAT APPROVAL IS NO LONGER VALID.
2. THE MOST CURRENT EDITIONS OF THE CITY OF SAN ANTONIO STANDARD SPECIFICATIONS AND THE TEXAS DEPARTMENT OF TRANSPORTATION STANDARD SPECIFICATIONS FOR CONSTRUCTION OF HIGHWAYS, STREETS AND BRIDGES SHALL BE FOLLOWED FOR ALL CONSTRUCTION EXCEPT AS AMENDED BY THE CITY OF NEW BRAUNFELS STANDARD DETAILS.
3. ALL RESPONSIBILITY FOR THE ADEQUACY OF THESE PLANS REMAINS WITH THE ENGINEER OF RECORD. IN ACCEPTING THESE PLANS, THE CITY OF NEW BRAUNFELS MUST RELY UPON THE ADEQUACY OF THE WORK OF THE ENGINEER OF RECORD.
4. PRIOR TO THE START OF CONSTRUCTION THE CONTRACTOR SHALL CONTACT THE CITY OF NEW BRAUNFELS TO SET A PRE-CONSTRUCTION MEETING. A 48-HOUR ADVANCED NOTIFICATION IS REQUIRED FOR ALL INSPECTION AND MEETING REQUESTS.

4.1 ALL INSPECTIONS ARE TO BE CALLED IN AT 830-372-1031 OR,
4.2 FAXED IN AT 830-372-0067 OR,
4.3 E-MAILED AT VEPOLL.COM.

5. IT IS THE CONTRACTOR'S RESPONSIBILITY TO SEE THAT ALL TEMPORARY AND PERMANENT TRAFFIC CONTROL DEVICES ARE PROPERLY INSTALLED AND MAINTAINED IN ACCORDANCE WITH THE PLANS AND LATEST EDITION OF THE TEXAS MANUAL ON UNIFORM TRAFFIC CONTROL DEVICES. IF THE NEED ARISES, ADDITIONAL TEMPORARY TRAFFIC CONTROL DEVICES MAY BE ORDERED BY THE ENGINEERING REPRESENTATIVE AT THE CONTRACTOR'S EXPENSE.

6. DRAINAGE IMPROVEMENTS SUFFICIENT TO MITIGATE OFFSITE IMPACT OF CONSTRUCTION MUST BE COMPLETED AND IN PLACE PRIOR TO ADDING IMPERVIOUS COVER TO THE SITE.

7. THIS DEVELOPMENT IS A TYPE 3 DEVELOPMENT.

8. A PORTION OF THE SUBDIVISION IS LOCATED WITHIN AN INDICATED SPECIAL FLOOD HAZARD ZONE ACCORDING TO THE ADOPTED FLOOD MAPS OF THE CITY OF NEW BRAUNFELS, AS DEFINED BY THE COMAL COUNTY, TEXAS FLOOD INSURANCE RATE MAP NUMBER 48091C0295F, EFFECTIVE DATE SEPTEMBER 2, 2009 AS PREPARED BY THE FEDERAL EMERGENCY MANAGEMENT AGENCY.

9. THIS PROJECT IS NOT LOCATED WITHIN THE EDWARDS AQUIFER RECHARGE, TRANSITION OR CONTRIBUTING ZONE.

10. GAS UTILITIES ARE NOT INCLUDED IN THE CIVIL CONSTRUCTION PLANS. FINAL GAS UTILITY DESIGN SHALL BE APPROVED BY THE CITY FOR ANY WORK WITHIN PUBLIC RIGHT-OF-WAY, IF APPLICABLE.

11. THE ENGINEER OF RECORD ACKNOWLEDGES THAT ALL PROPOSED WATER AND WASTEWATER IMPROVEMENTS MUST COMPLY WITH TCEQ, CITY OF NEW BRAUNFELS, CRYSTAL CLEAR SUD WATER CONNECTION POLICY, SOUND ENGINEERING JUDGEMENT AND ANY OTHER GOVERNING ENTITY ORDINANCES OR CODES.

KYNDWOOD MUNICIPAL UTILITY DISTRICT

KYNDWOOD SUBDIVISION UNIT 5

NEW BRAUNFELS, TEXAS


CIVIL SITE CONSTRUCTION PLANS

LENNAR HOMES OF TEXAS LAND & CONSTRUCTION, LTD

100 NE LOOP 410, SUITE 1155
SAN ANTONIO, TEXAS 78216

| REQUIRED PERMITS | NUMBER |
|--------------------------|--------------|
| 1. CRYSTAL CLEAR SUD | # |
| 2. CITY OF NEW BRAUNFELS | PI 2025-0023 |
| REVISIONS | |

JANUARY 2026

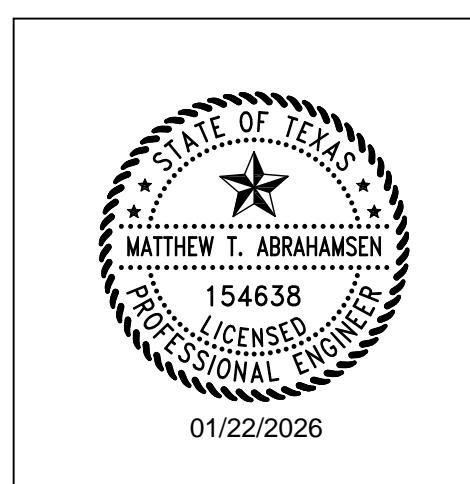

ALL RESPONSIBILITY FOR THE ADEQUACY OF THESE PLANS REMAINS WITH THE ENGINEER OF RECORD. IN ACCEPTING THESE PLANS, THE CITY OF NEW BRAUNFELS MUST RELY UPON THE ADEQUACY OF THE WORK OF THE ENGINEER OF RECORD.

Matthew T. Abrahamsen
Matthew T. Abrahamsen P.E.,
License No. 154638

PREPARED BY:



290 S. CASTELL AVE., STE. 100
NEW BRAUNFELS, TX 78130
HMTNB.COM
P(830)625-8555/F(830)625-8556
TBPELS FIRM F-10961
TBPELS FIRM 1053600

NOTE TO CONTRACTOR:

BY THE ACT OF SUBMITTING A BID FOR THIS PROPOSED CONTRACT, THE BIDDER WARRANTS THAT THE BIDDER, AND ALL SUBCONTRACTORS AND MATERIAL SUPPLIERS HE INTENDS TO USE HAVE CAREFULLY AND THOROUGHLY REVIEWED THE DRAWINGS, SPECIFICATIONS AND ALL OTHER CONTRACT DOCUMENTS AND HAVE FOUND THEM COMPLETE AND FREE FROM ANY AMBIGUITIES AND SUFFICIENT FOR THE PURPOSE INTENDED. THE BIDDER FURTHER WARRANTS THAT TO THE BEST OF HIS OR HIS SUBCONTRACTORS' AND MATERIAL SUPPLIERS' KNOWLEDGE, ALL MATERIALS AND PRODUCTS SPECIFIED OR INDICATED HEREIN ARE ACCEPTABLE FOR ALL APPLICABLE CODES AND AUTHORITIES.

THE LOCATION OF ALL EXISTING UTILITIES SHOWN ON THESE PLANS HAS BEEN BASED UPON RECORD INFORMATION ONLY AND MAY NOT MATCH LOCATIONS AND/OR DEPTHS AS CONSTRUCTED. THE CONTRACTOR SHALL CONTACT EACH OF THE INDIVIDUAL UTILITIES FOR ASSISTANCE IN DETERMINING EXISTING UTILITY LOCATIONS AND DEPTHS PRIOR TO BEGINNING ANY CONSTRUCTION. CONTRACTOR SHALL FIELD VERIFY LOCATIONS OF ALL UTILITY CROSSINGS PRIOR TO BEGINNING ANY CONSTRUCTION.


ANY QUANTITIES PROVIDED BY HMT OR OWNER ON THE PLANS, OPINION OF PROBABLE COST, BID SUMMARIES, ETC. ARE FOR CURSORY USE. ONLY CONTRACTOR IS RESPONSIBLE FOR BIDDING SIGNED AND SEALED CONSTRUCTION PLANS. IF A DISCREPANCY EXIST, CONTRACTOR SHALL CONTACT ENGINEER IMMEDIATELY.

CONTRACTOR IS RESPONSIBLE FOR CONFIRMING THE LOCATION AND ELEVATION OF ALL DOWNSTREAM CONNECTION POINTS PRIOR TO CONSTRUCTION. IF A DISCREPANCY EXIST, CONTRACTOR SHALL CONTACT ENGINEER IMMEDIATELY.

CONTRACTOR SHALL INSTALL ALL GRAVITY SEWER, GRAVITY STORM SEWER, CURBS AND PAVEMENT FROM THE MOST DOWNSTREAM POINT OF CONNECTION. IF IMPROVEMENTS ARE CONSTRUCTED FROM UPSTREAM TO DOWNSTREAM, THEN THE CONTRACTOR WILL TAKE FULL RISK AND LIABILITY OF ANY ISSUES THAT MIGHT ARISE FROM FLOWLINE ELEVATION DISCREPANCIES, UTILITY CONFLICTS, ETC.

CONTRACTOR IS RESPONSIBLE FOR THE STOCKPILING OF ANY EXCESS DIRT. ALL BIDS FROM CONTRACTOR SHOULD ACCOUNT FOR THE REMOVAL AND PLACEMENT OF ALL EARTHWORK TO INCLUDE STOCKPILING, EXPORT, IMPORT, ETC. IF A LOCATION OF PLACEMENT OF EXCESS DIRT IS NOT SHOWN ON THE PLANS, THEN CONTRACTOR SHALL CONTACT ENGINEER IMMEDIATELY TO DETERMINE THE MOST SUITABLE STOCKPILE LOCATION.


| Sheet List Table | |
|------------------|---|
| Sheet Number | Sheet Title |
| C0.01 | COVER SHEET |
| C0.02 | GENERAL NOTES |
| C0.03 | PLAT (1 OF 6) |
| C0.04 | PLAT (2 OF 6) |
| C0.05 | PLAT (3 OF 6) |
| C0.06 | PLAT (4 OF 6) |
| C0.07 | PLAT (5 OF 6) |
| C0.08 | PLAT (6 OF 6) |
| C1.01 | EXISTING DRAINAGE MAP |
| C1.02 | PROPOSED DRAINAGE MAP |
| C1.03 | ULTIMATE DRAINAGE MAP |
| C1.04 | PROPOSED SUB-DRAINAGE MAP |
| C2.01 | EROSION CONTROL PLAN |
| C2.02 | EROSION CONTROL DETAILS |
| C3.01 | GRADING PLAN (1 OF 2) |
| C3.02 | GRADING PLAN (2 OF 2) |
| C3.03 | GRADING DETAILS |
| C4.01 | KYNDWOOD TRAIL PLAN & PROFILE (1 OF 2) |
| C4.02 | KYNDWOOD TRAIL PLAN & PROFILE (2 OF 2) |
| C4.03 | SABINE ST PLAN & PROFILE |
| C4.04 | PIKE PT PLAN & PROFILE |
| C4.05 | SASSAFRAS WAY PLAN & PROFILE |
| C4.06 | OCALA ST PLAN & PROFILE |
| C4.07 | REDCEDAR LN PLAN & PROFILE |
| C4.08 | STREET SIGNAGE PLAN |
| C4.09 | PAVEMENT STRIPING PLAN |
| C4.10 | STREET DETAILS (1 OF 5) |
| C4.11 | STREET DETAILS (2 OF 5) |
| C4.12 | STREET DETAILS (3 OF 5) |
| C4.13 | STREET DETAILS (4 OF 5) |
| C4.14 | STREET DETAILS (5 OF 5) |
| C5.01 | OVERALL STORM PLAN |
| C5.02 | INTERCEPTOR CHANNEL A PLAN & PROFILE (1 OF 2) |
| C5.03 | INTERCEPTOR CHANNEL A PLAN & PROFILE (2 OF 2) |
| C5.04 | INTERCEPTOR CHANNEL B PLAN & PROFILE (1 OF 3) |
| C5.05 | INTERCEPTOR CHANNEL B PLAN & PROFILE (2 OF 3) |
| C5.06 | INTERCEPTOR CHANNEL B PLAN & PROFILE (3 OF 3) |
| C5.07 | CHANNEL A PLAN & PROFILE |
| C5.08 | CHANNEL B PLAN & PROFILE |
| C5.09 | CHANNEL C PLAN & PROFILE |
| C5.10 | STORM LINE A PLAN & PROFILE |
| C5.11 | UNIT 1 STORM LINE EXTENSION PLAN & PROFILE |
| C5.12 | KYNDWOOD TRAIL CULVERT B |
| C5.13 | STORM DETAILS (1 OF 5) |
| C5.14 | STORM DETAILS (2 OF 5) |
| C5.15 | STORM DETAILS (3 OF 5) |
| C5.16 | STORM DETAILS (4 OF 5) |
| C5.17 | STORM DETAILS (5 OF 5) |
| C6.01 | OVERALL WATER PLAN (1 OF 2) |
| C6.02 | OVERALL WATER PLAN (2 OF 2) |
| C6.03 | WATER DETAILS (1 OF 2) |
| C6.04 | WATER DETAILS (2 OF 2) |
| C7.01 | OVERALL WASTEWATER PLAN |
| C7.02 | WASTEWATER LINE A PLAN AND PROFILE (1 OF 2) |
| C7.03 | WASTEWATER LINE A PLAN AND PROFILE (2 OF 2) |
| C7.04 | WASTEWATER LINE B PLAN AND PROFILE |
| C7.05 | WASTEWATER LINE C PLAN AND PROFILE |
| C7.06 | WASTEWATER LINE E PLAN AND PROFILE |
| C7.07 | WASTEWATER LINE F PLAN AND PROFILE |
| C7.08 | WASTEWATER LINE G & I PLAN AND PROFILE |
| C7.09 | WASTEWATER LINE H PLAN AND PROFILE |
| C7.10 | WASTEWATER DETAILS |

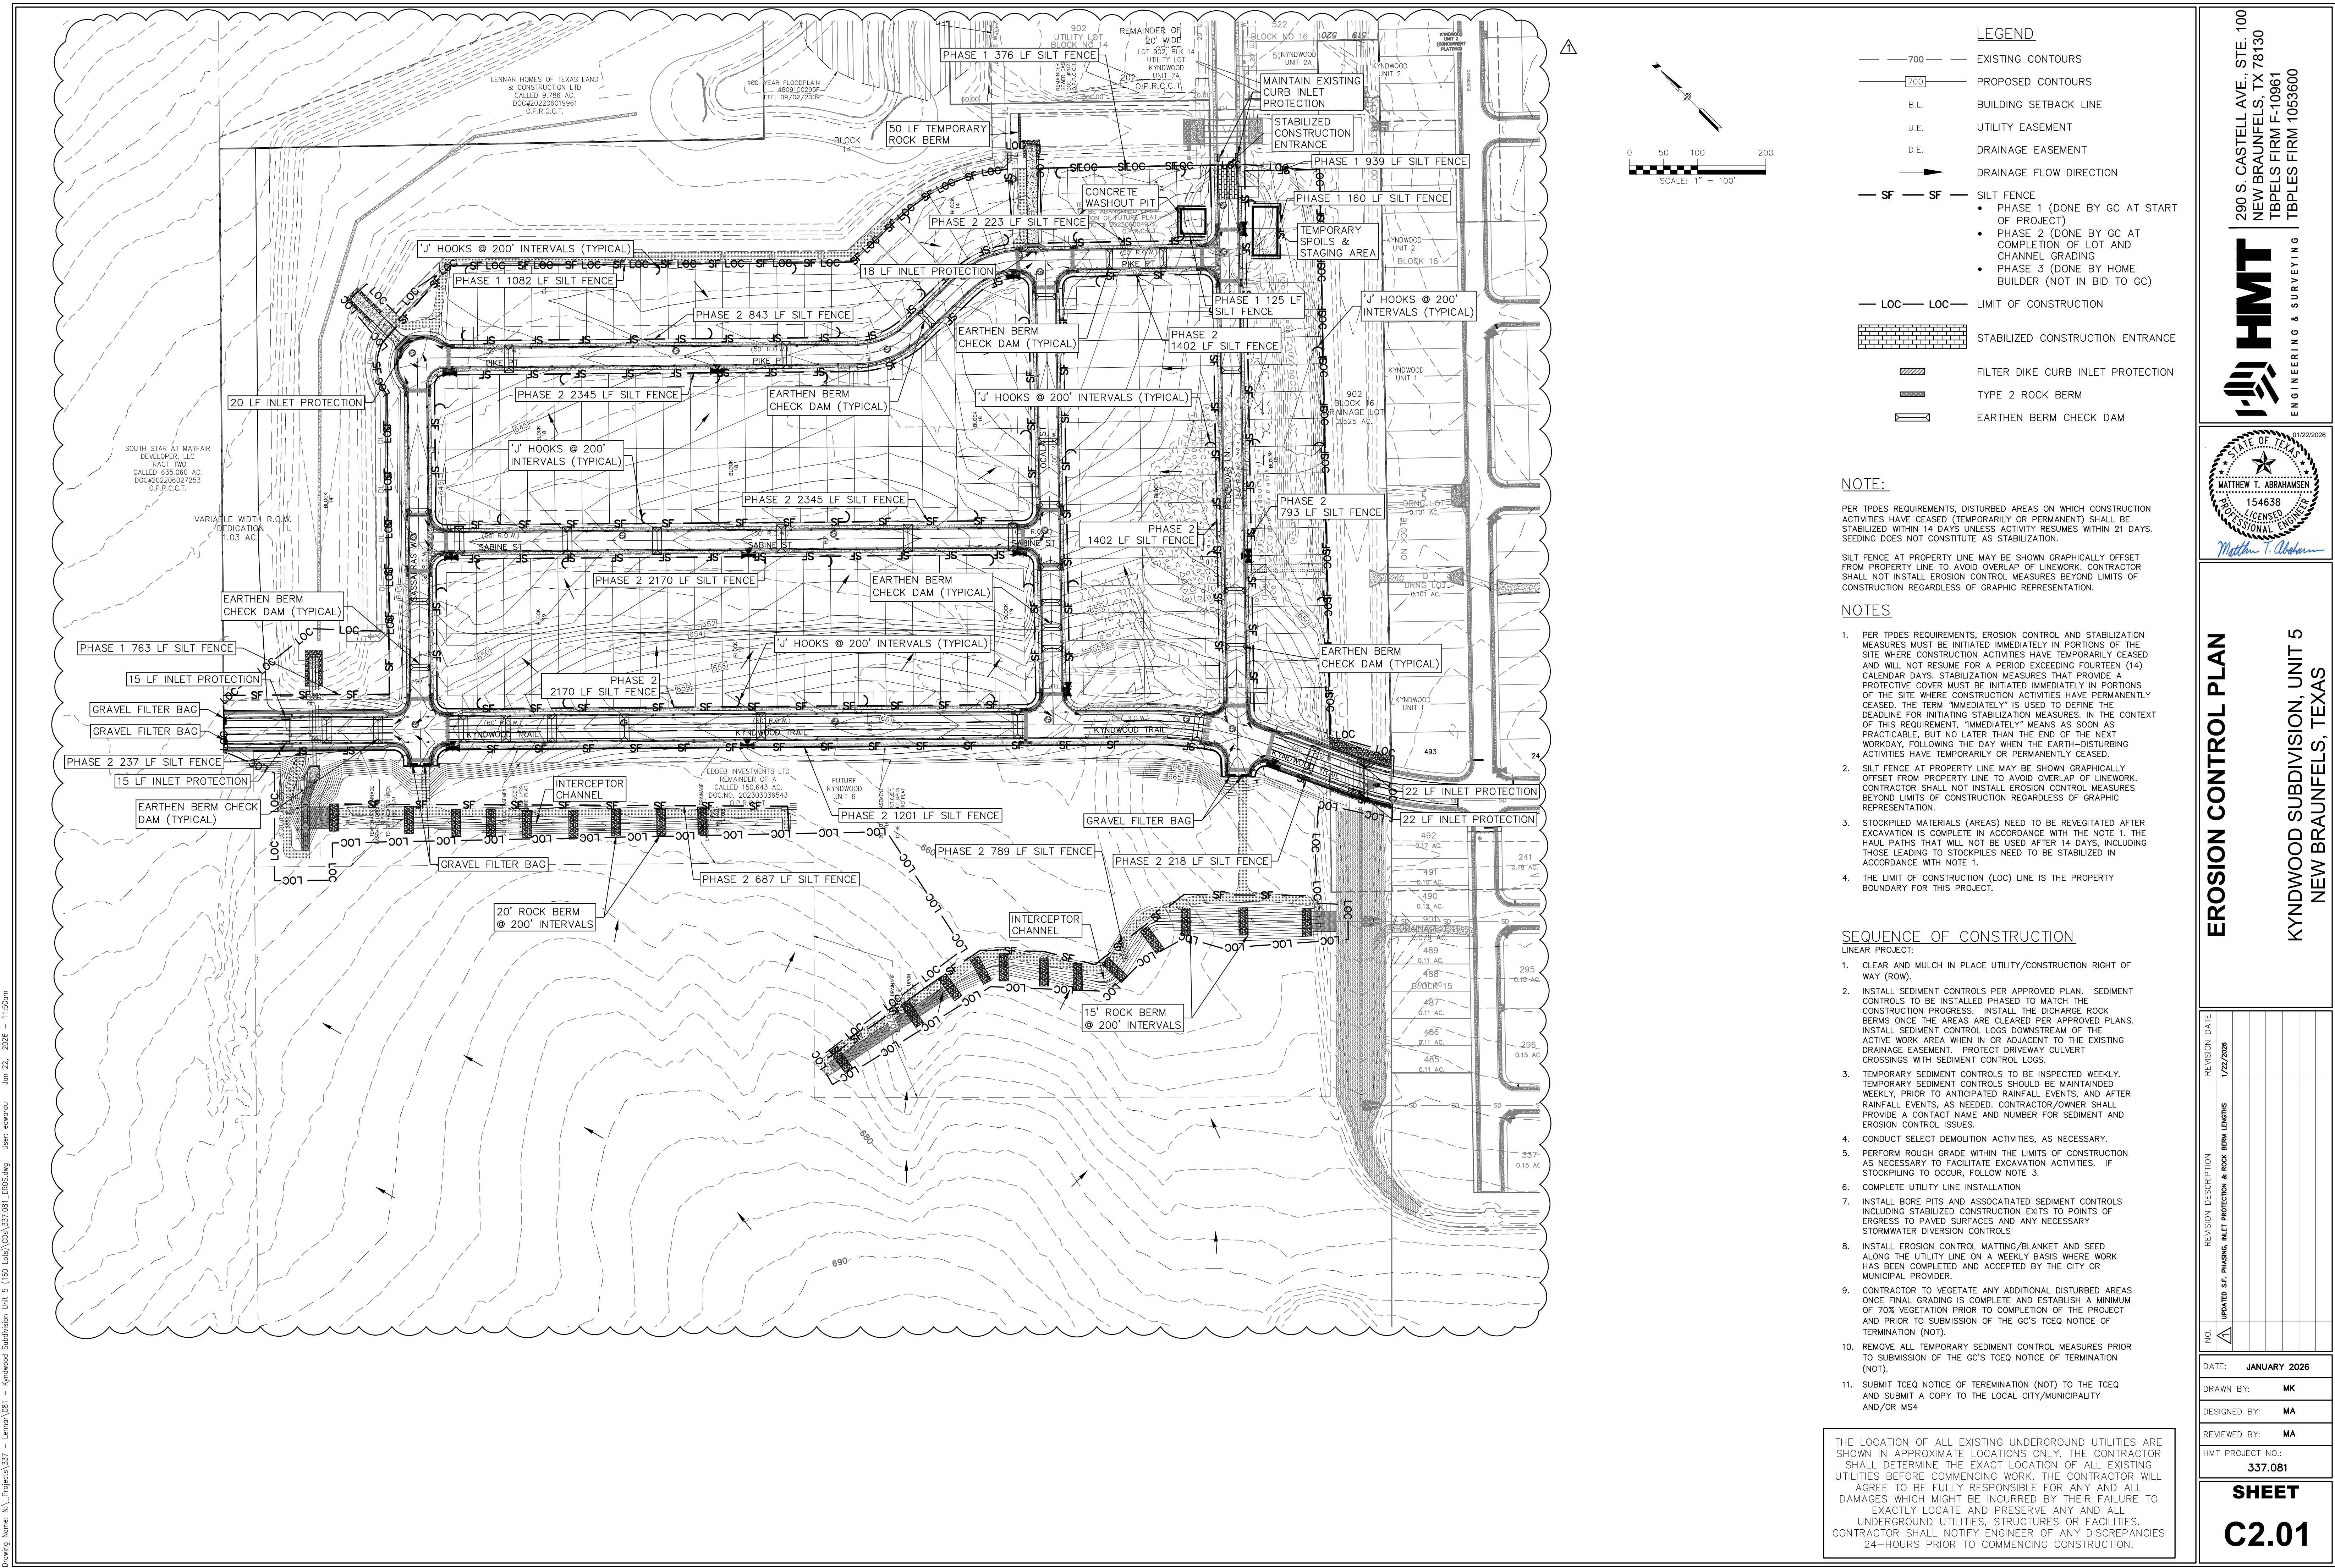



DRAINAGE FEATURES, DETENTION BASIN MAINTENANCE AND EQUIPMENT ACCESS REQUIREMENTS:

SILT SHALL BE REMOVED AND THE BASIN RETURNED TO ORIGINAL LINES AND GRADES WHEN STANDING WATER CONDITIONS OCCUR OR THE BASIN STORAGE VOLUME IS REDUCED BY MORE THAN 10%.

- A. TO LIMIT EROSION, NO UNVEGETATED AREA SHALL EXCEED 10 SQ. FT. IN EXTENT.
- B. ACCUMULATED PAPER, TRASH, AND DEBRIS SHALL BE REMOVED EVERY 6 MONTHS OR AS NECESSARY TO MAINTAIN PROPER OPERATION.
- C. BASINS SHALL BE MOWED ANNUALLY BETWEEN THE MONTHS OF JUNE AND SEPTEMBER.
- D. CORRECTIVE MAINTENANCE IS REQUIRED ANY TIME A BASIN DOES NOT DRAIN COMPLETELY WITHIN 60 HOURS OR CESSION OF INFLOW (IE: NO STANDING WATER IS ALLOWED).
- E. STRUCTURAL INTEGRITY OF BASINS SHALL BE MAINTAINED AT ALL TIMES.
- F. MAINTENANCE VEHICLE FOR POND ACCESS SHOULD BE A BOBCAT S175 SKID STEER LOADER OR VEHICLE OF EQUAL TO LESSER SIZE.

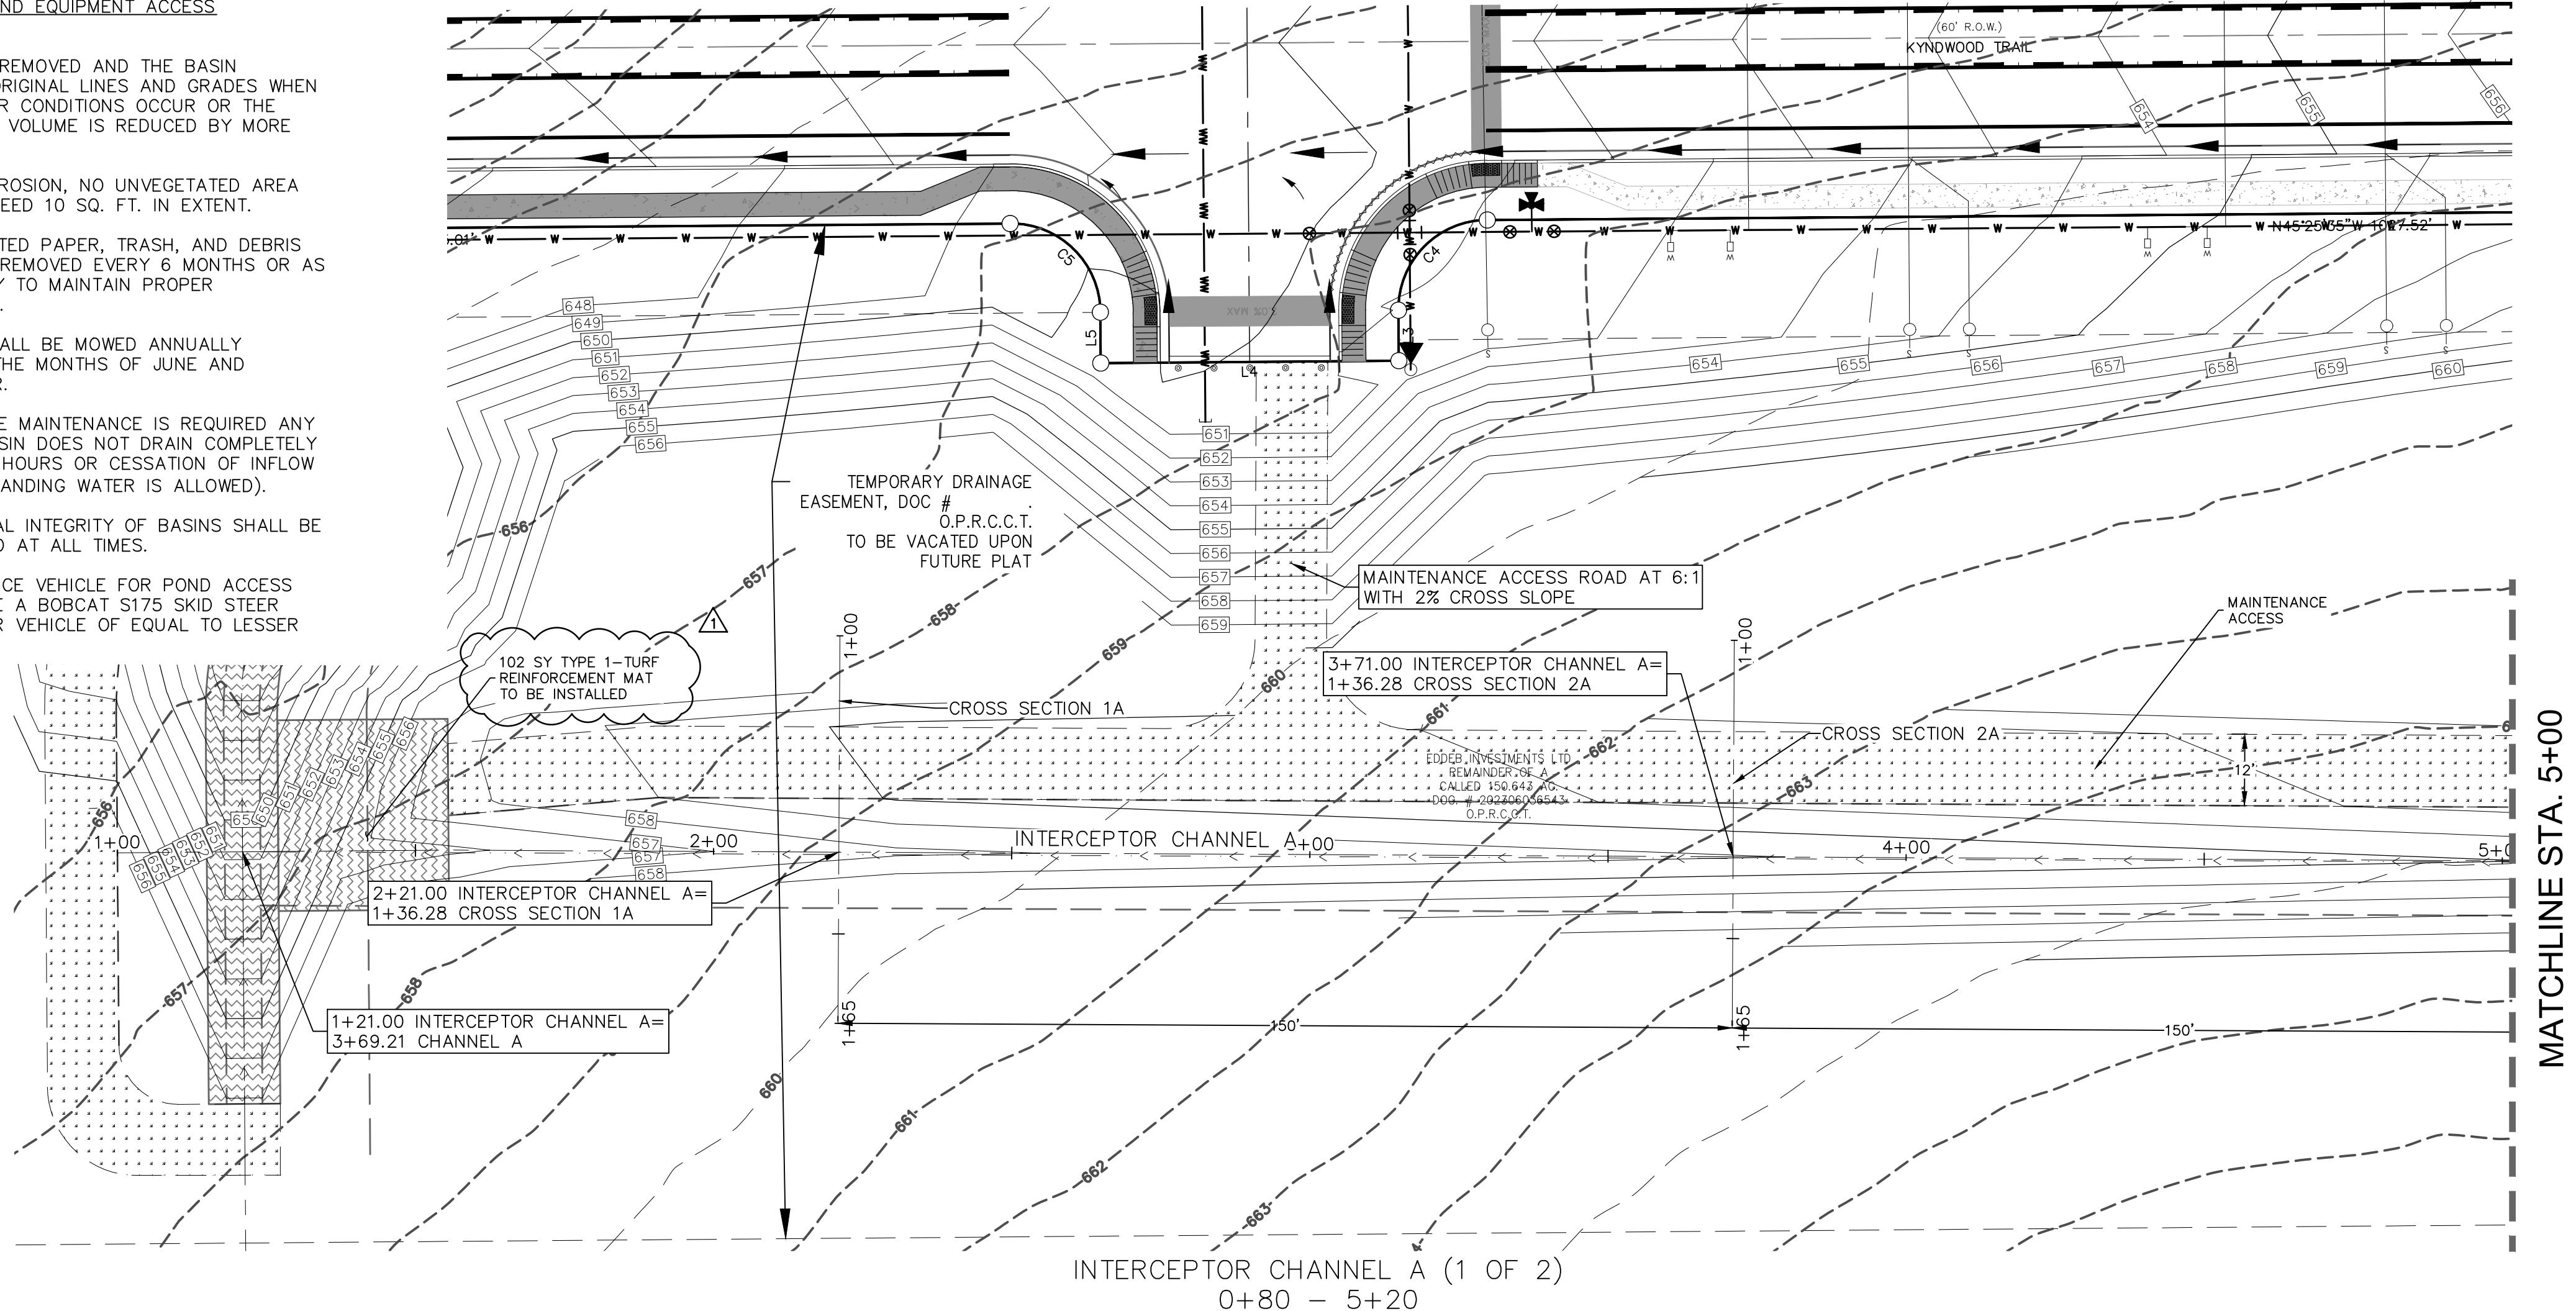



MATCHLINE STA. 5+00
SEE SHEET C5.03

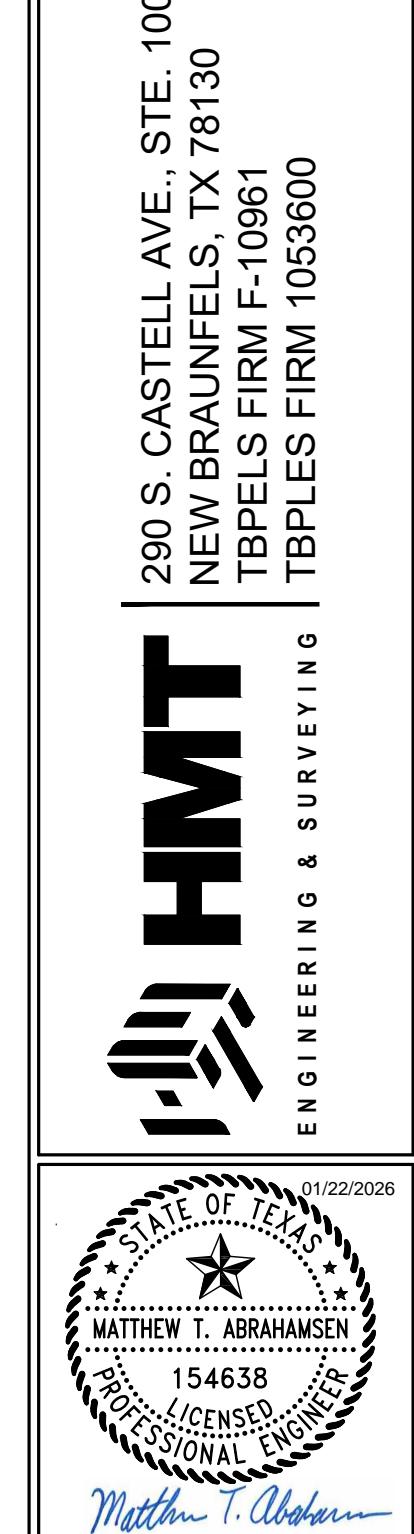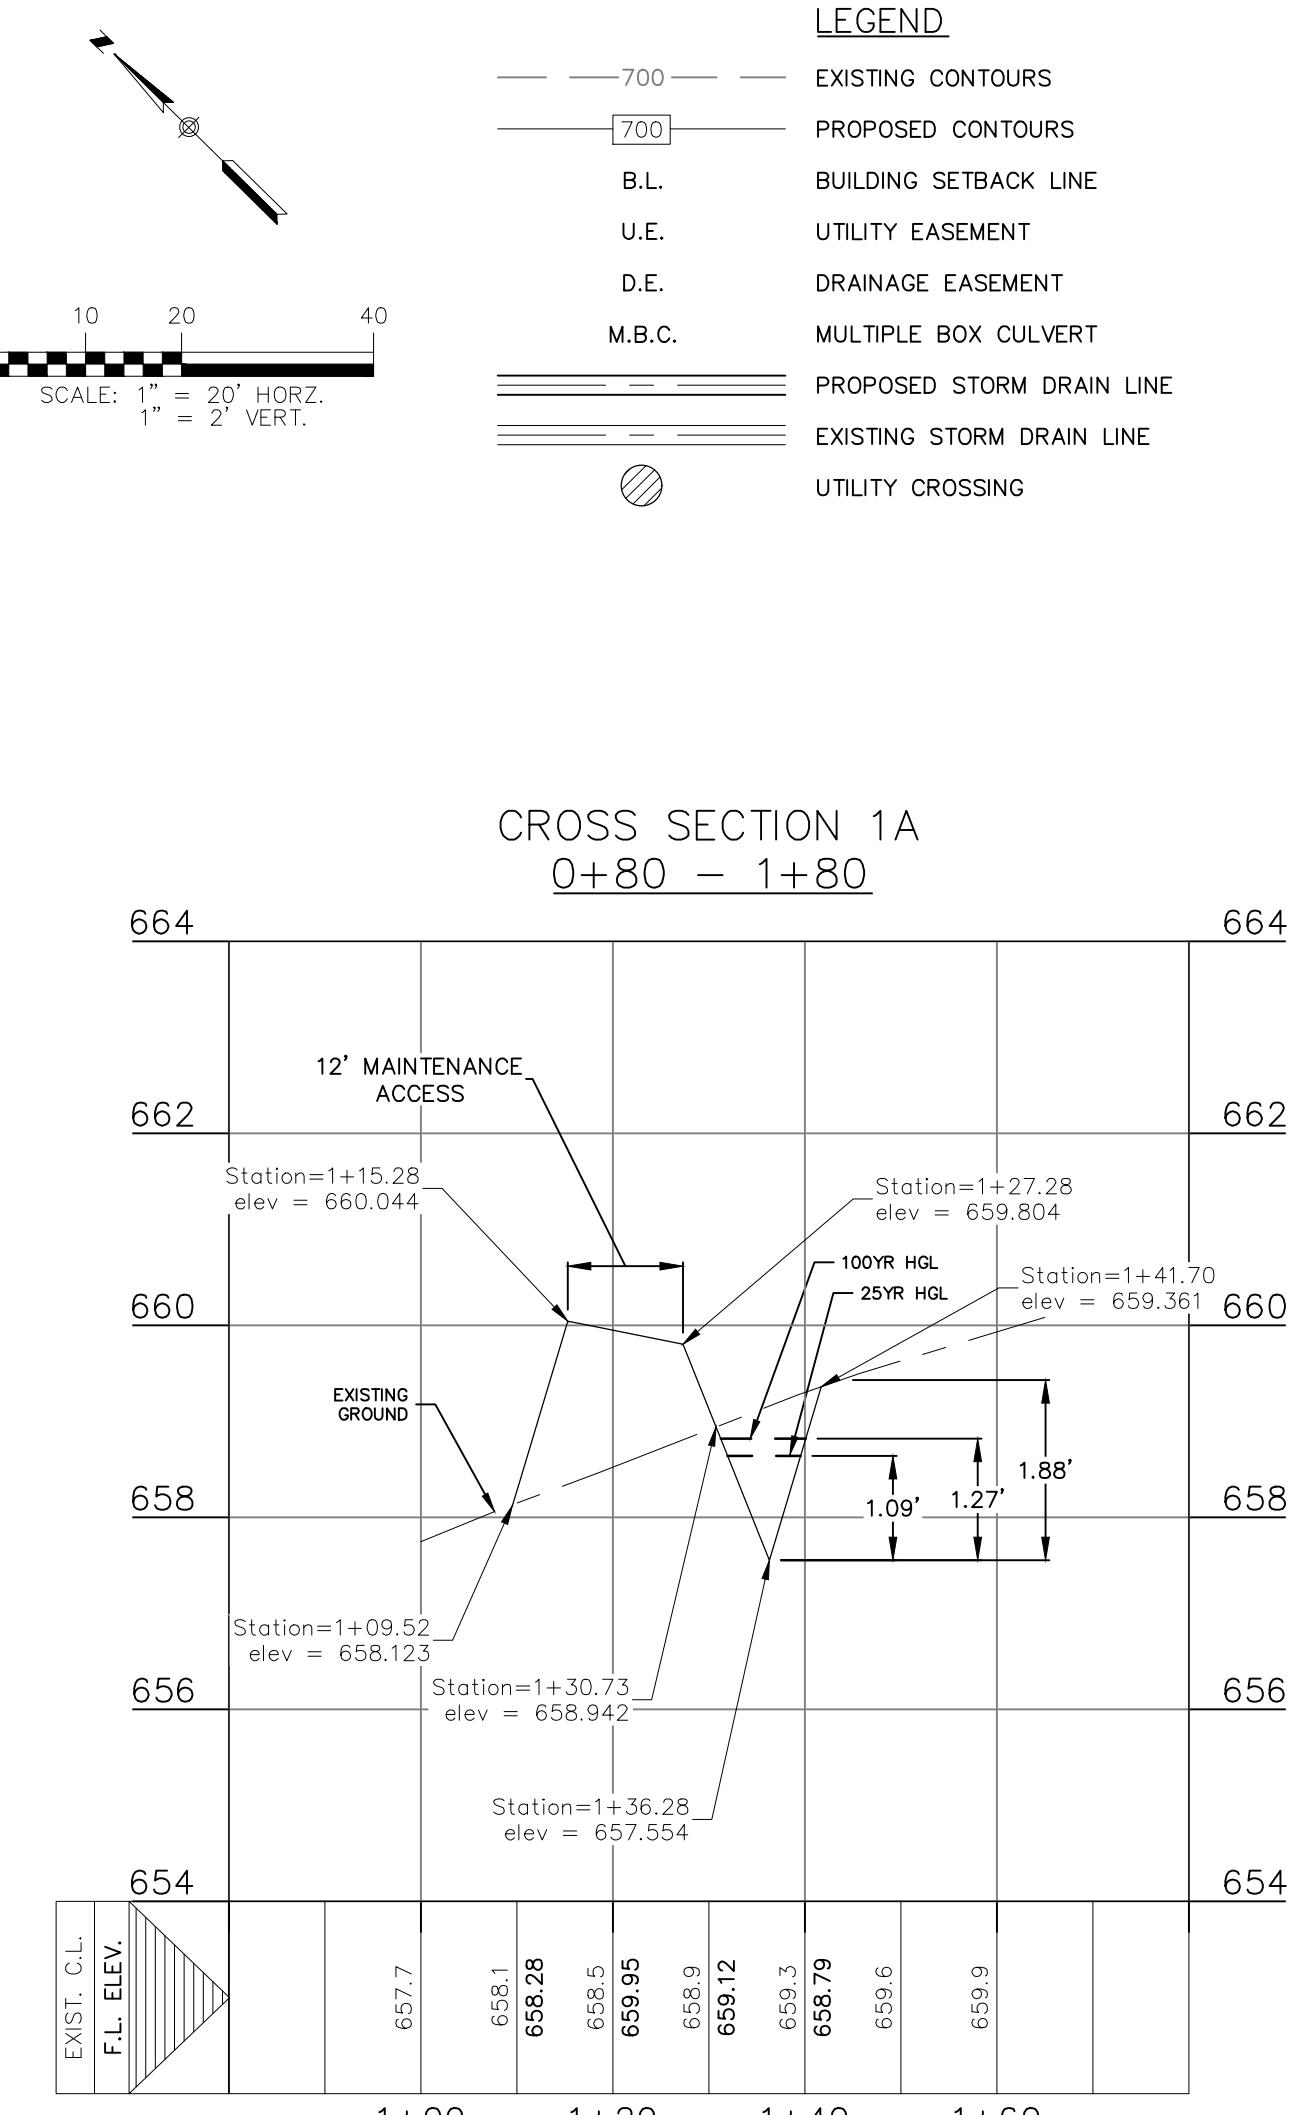

**INTERCEPTOR CHANNEL A
PLAN & PROFILE (1 OF 2)**

290 S. CASTELL AVE., STE. 100
NEW BRAUNFELS, TX 78130
TBPELS FIRM 1053600


KYNDWOOD SUBDIVISION, UNIT 5
NEW BRAUNFELS, TEXAS



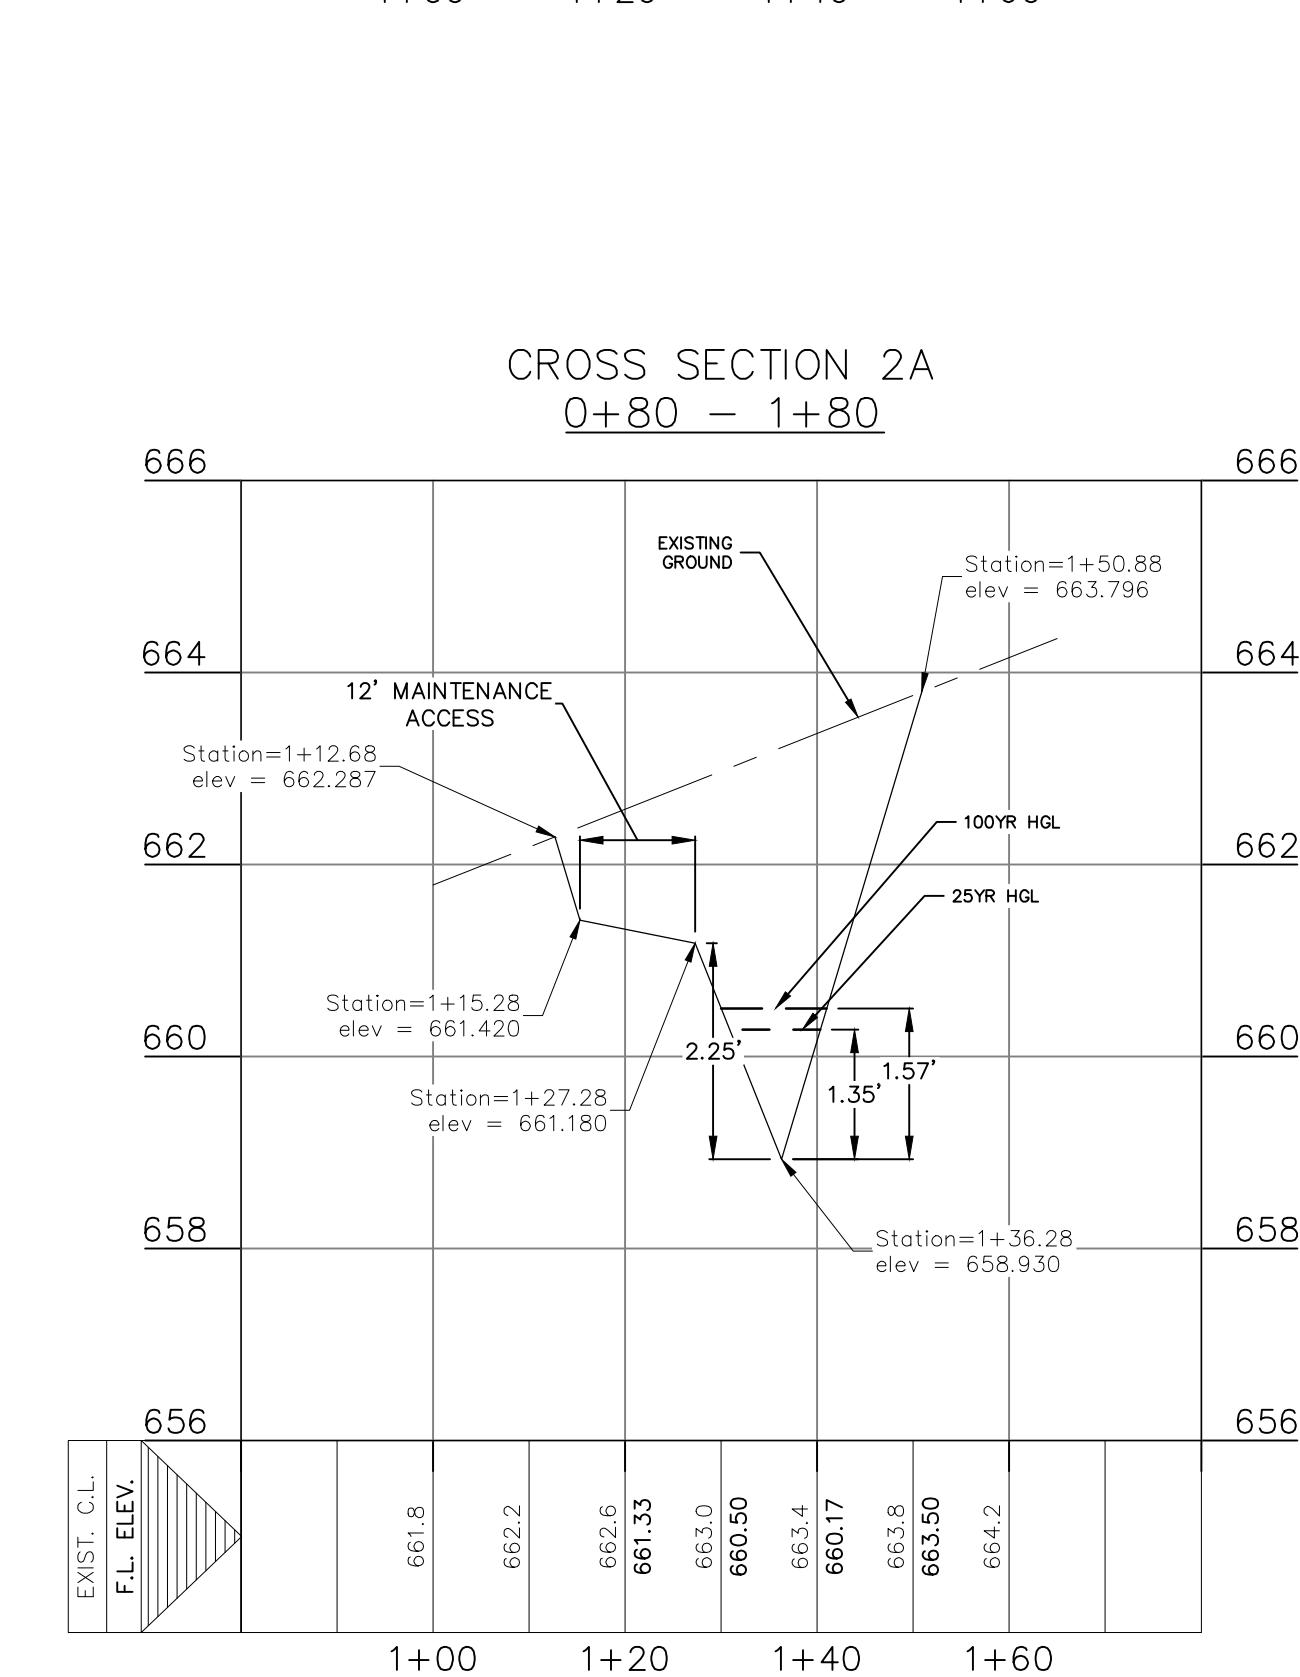
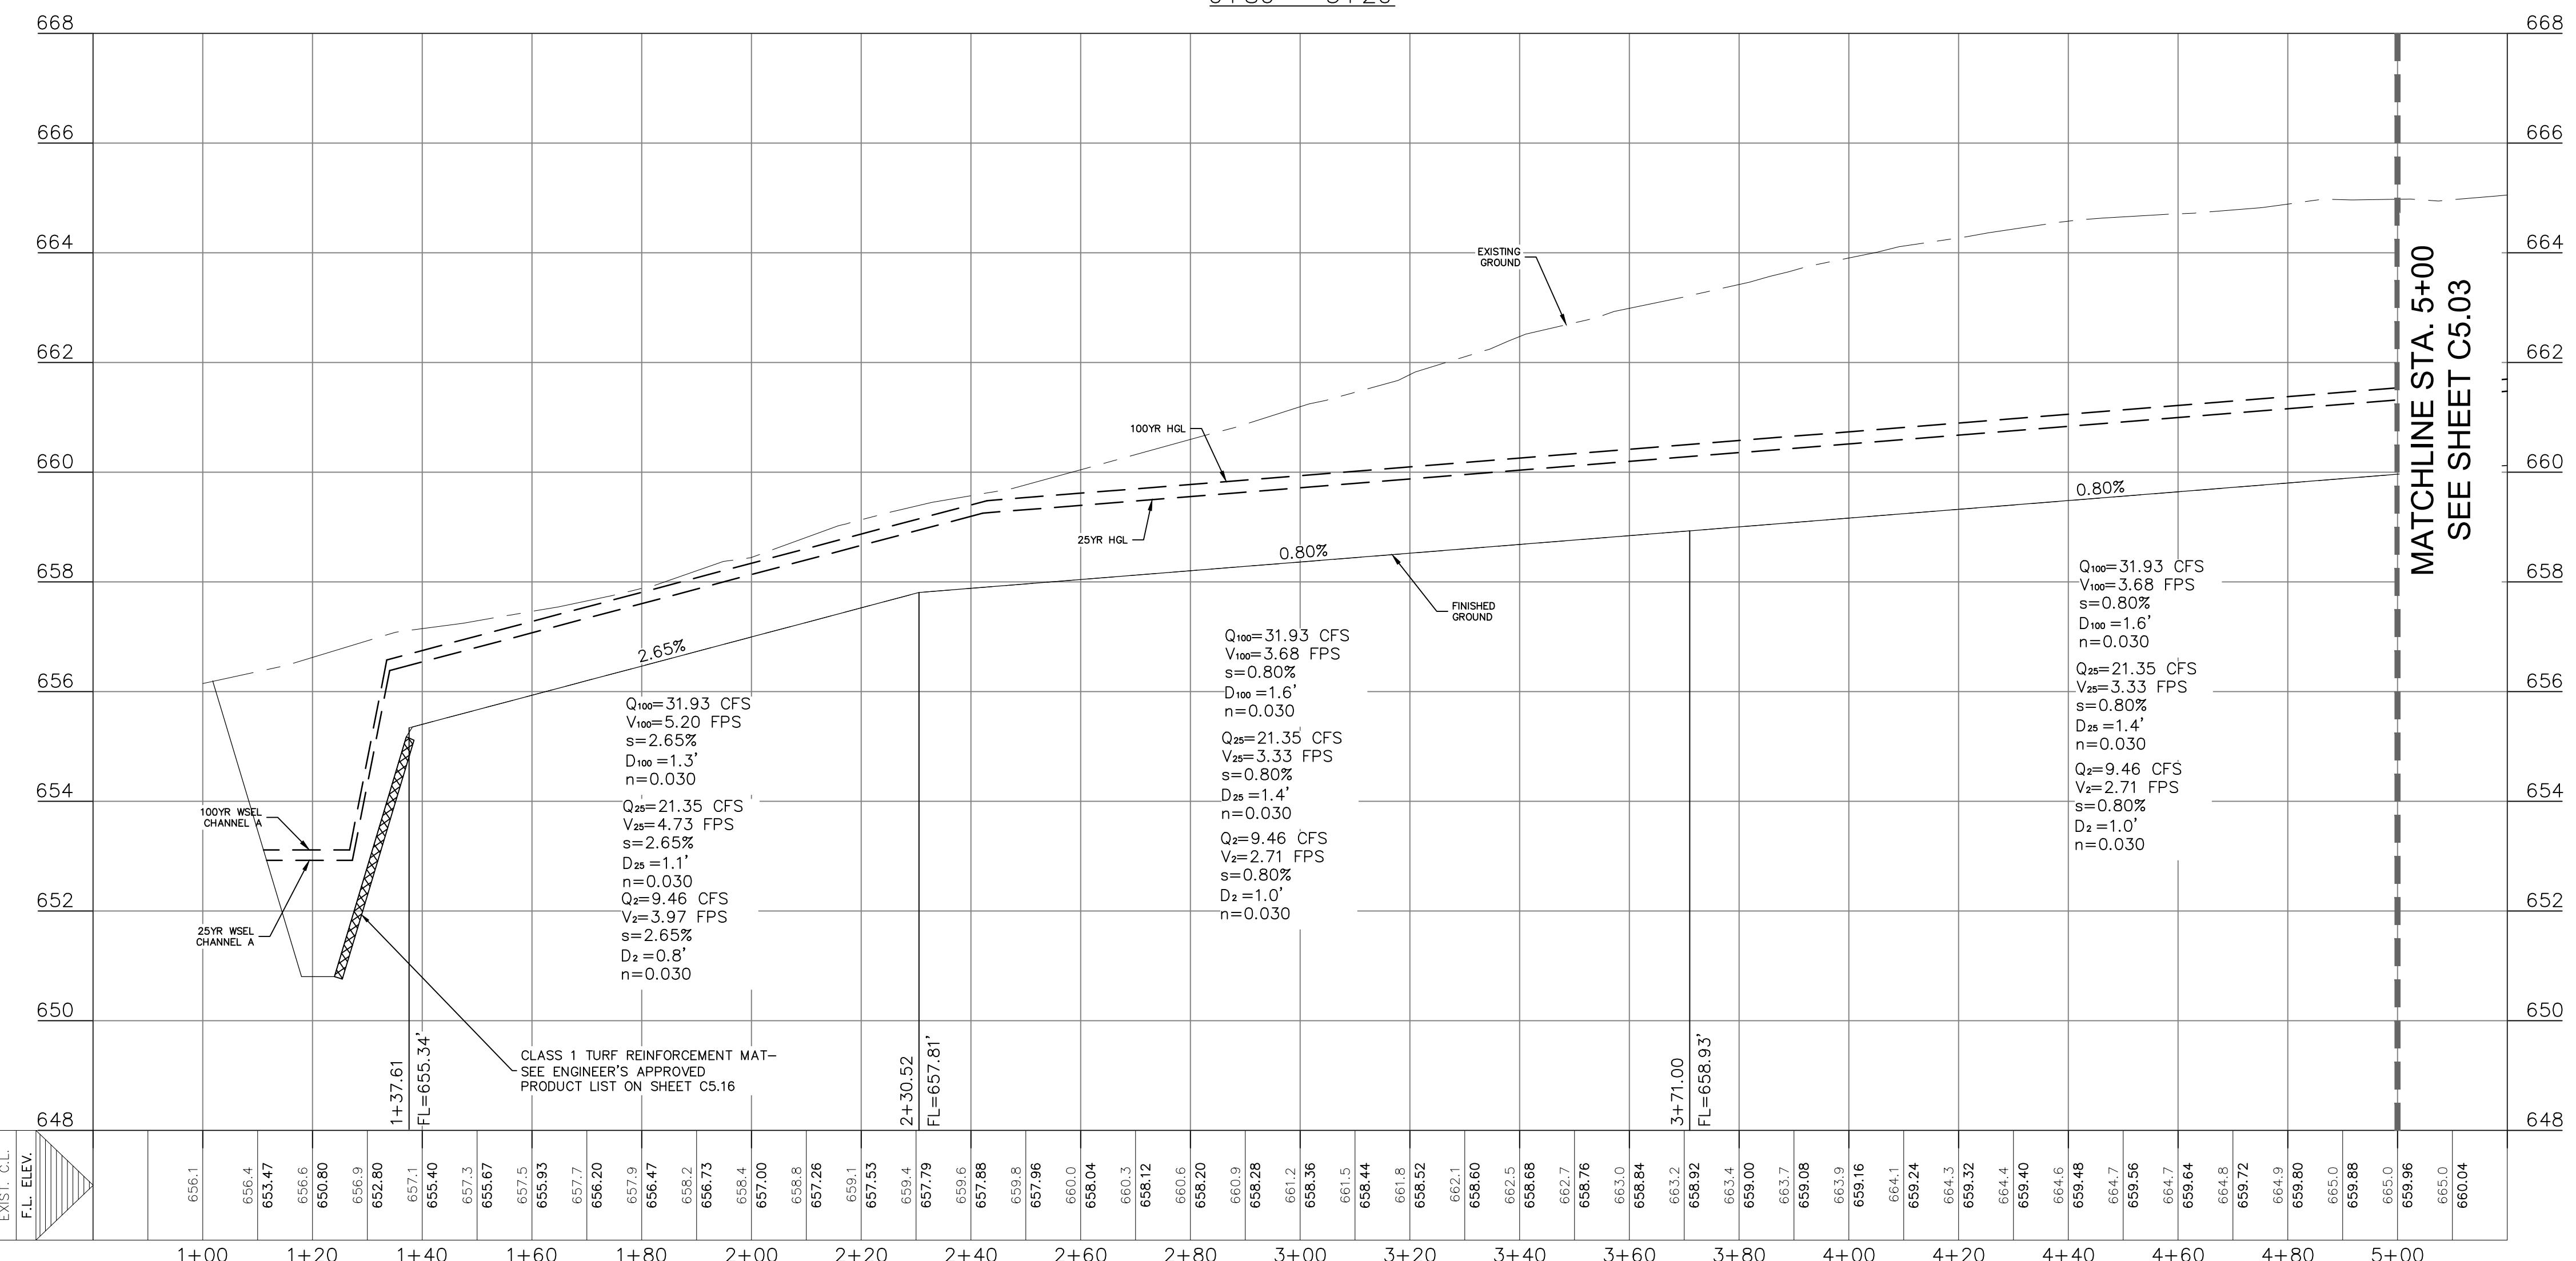


REFER TO THE COVER SHEET
FOR BENCHMARK INFORMATION.

THE LOCATION OF ALL EXISTING UNDERGROUND UTILITIES ARE SHOWN IN APPROXIMATE LOCATIONS ONLY. THE CONTRACTOR SHALL DETERMINE THE EXACT LOCATION OF ALL EXISTING UTILITIES BEFORE COMMENCING WORK. THE CONTRACTOR WILL AGREE TO BE FULLY RESPONSIBLE FOR ANY AND ALL DAMAGES WHICH MIGHT BE INCURRED BY THEIR FAILURE TO EXACTLY LOCATE AND PRESERVE ANY AND ALL UNDERGROUND UTILITIES, STRUCTURES OR FACILITIES. CONTRACTOR SHALL NOTIFY ENGINEER OF ANY DISCREPANCIES 24-HOURS PRIOR TO COMMENCING CONSTRUCTION.

NO. REVISION DATE
REVISION NOTES
1/22/2026
DATE: JANUARY 2026
DRAWN BY: MK
DESIGNED BY: MA
REVIEWED BY: MA
HMT PROJECT NO.: 337.081
SHEET
C5.02

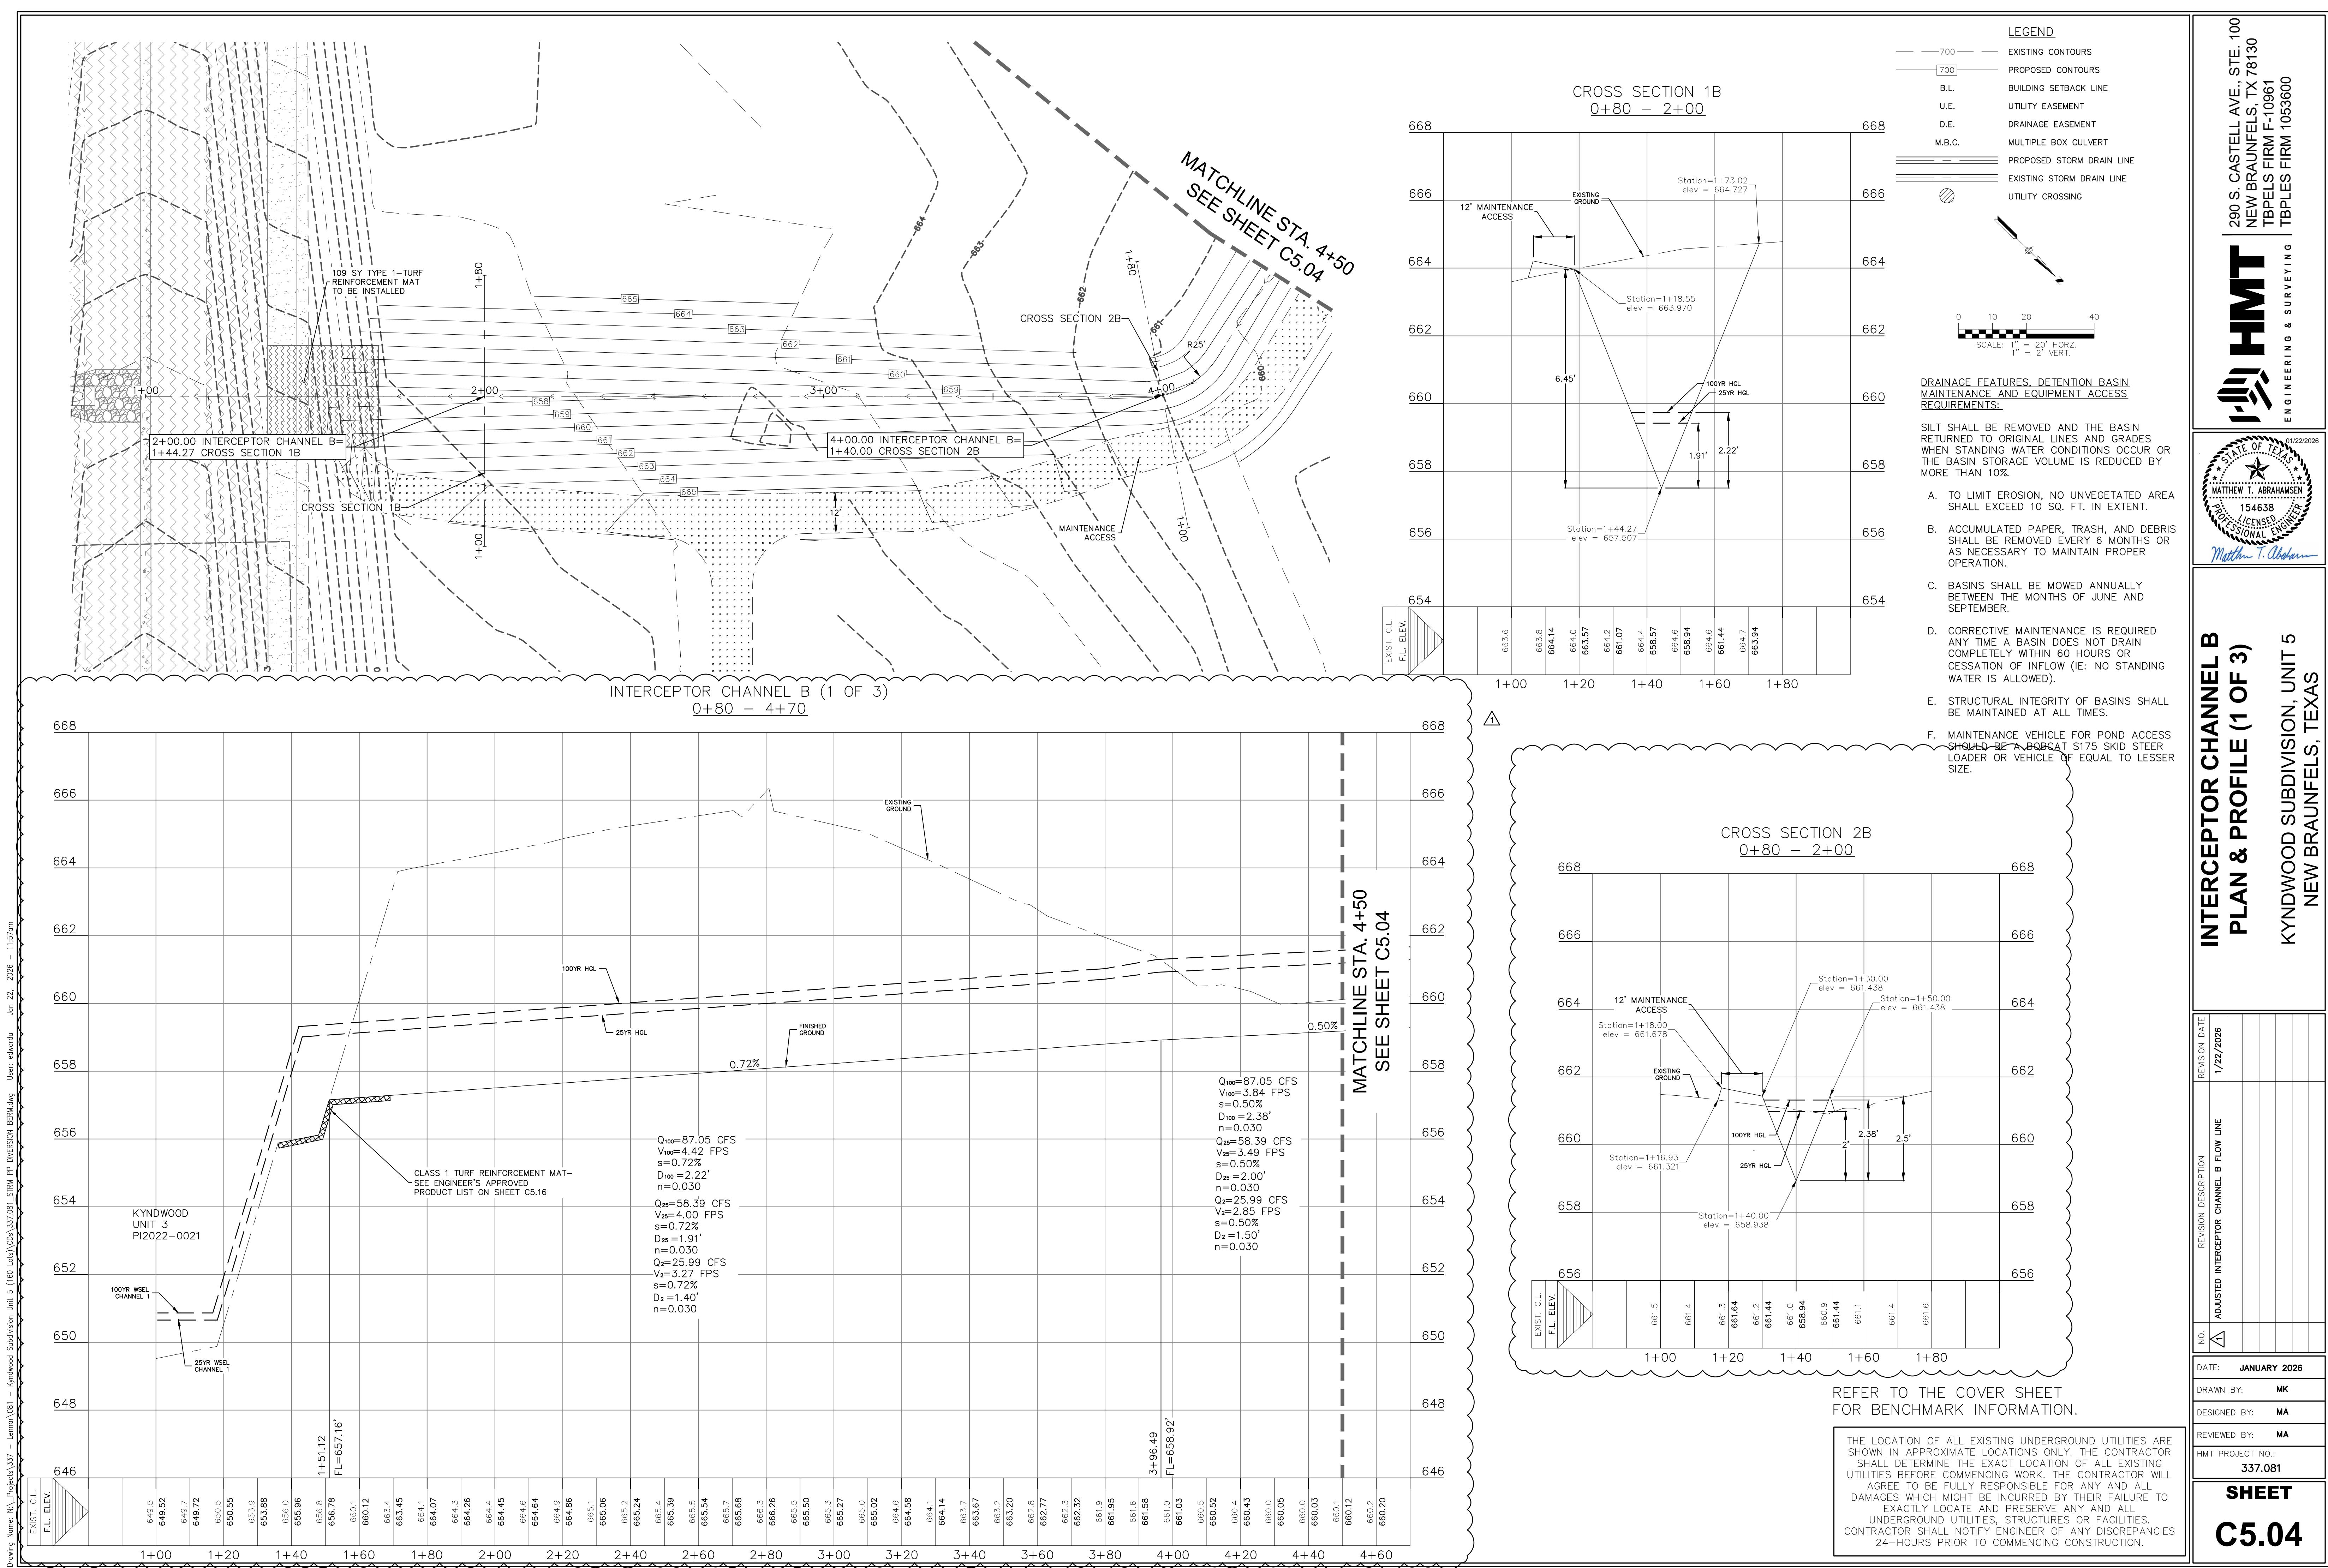

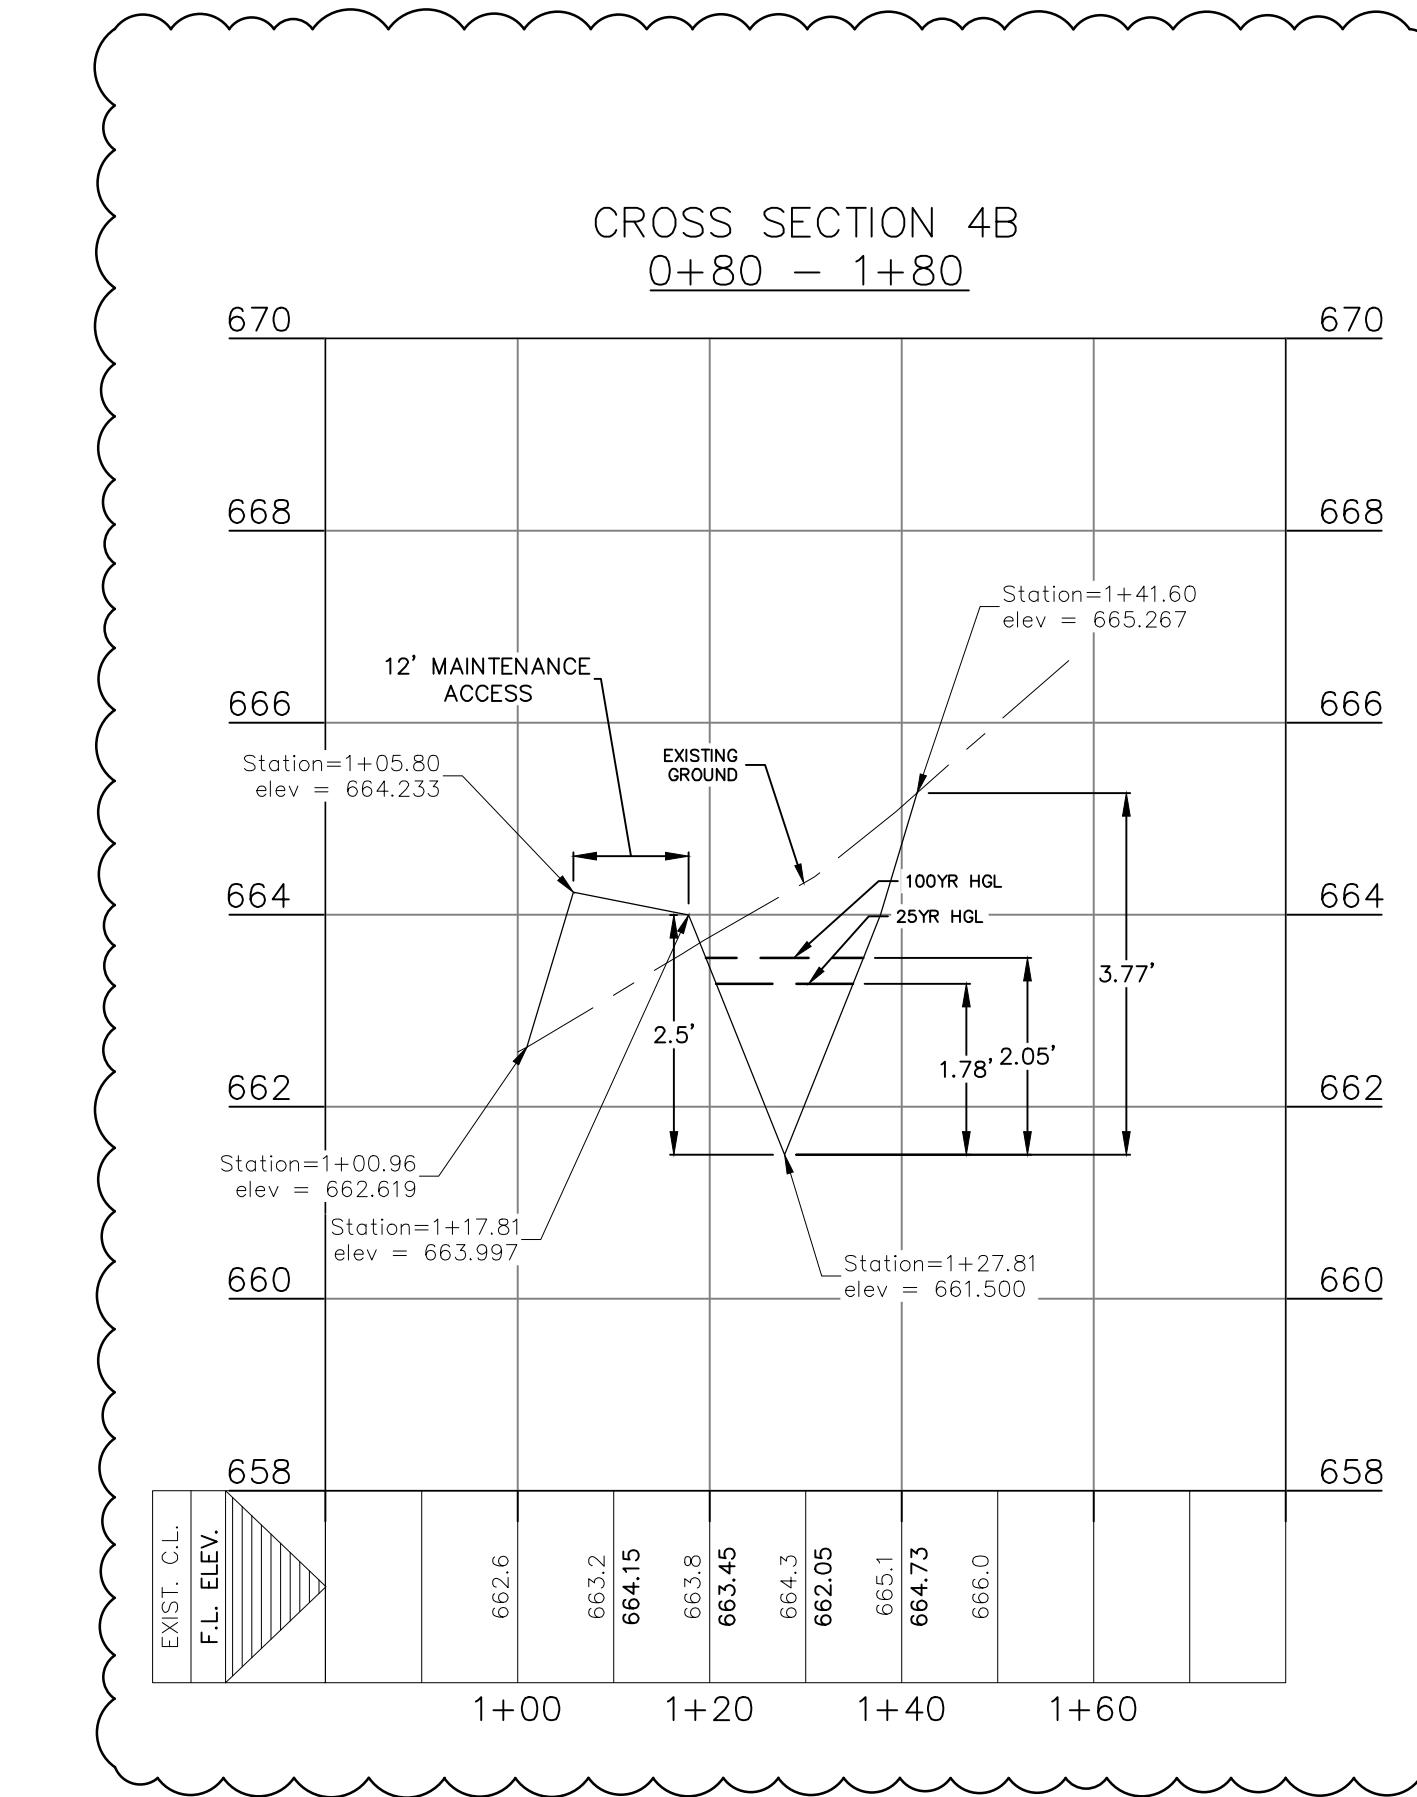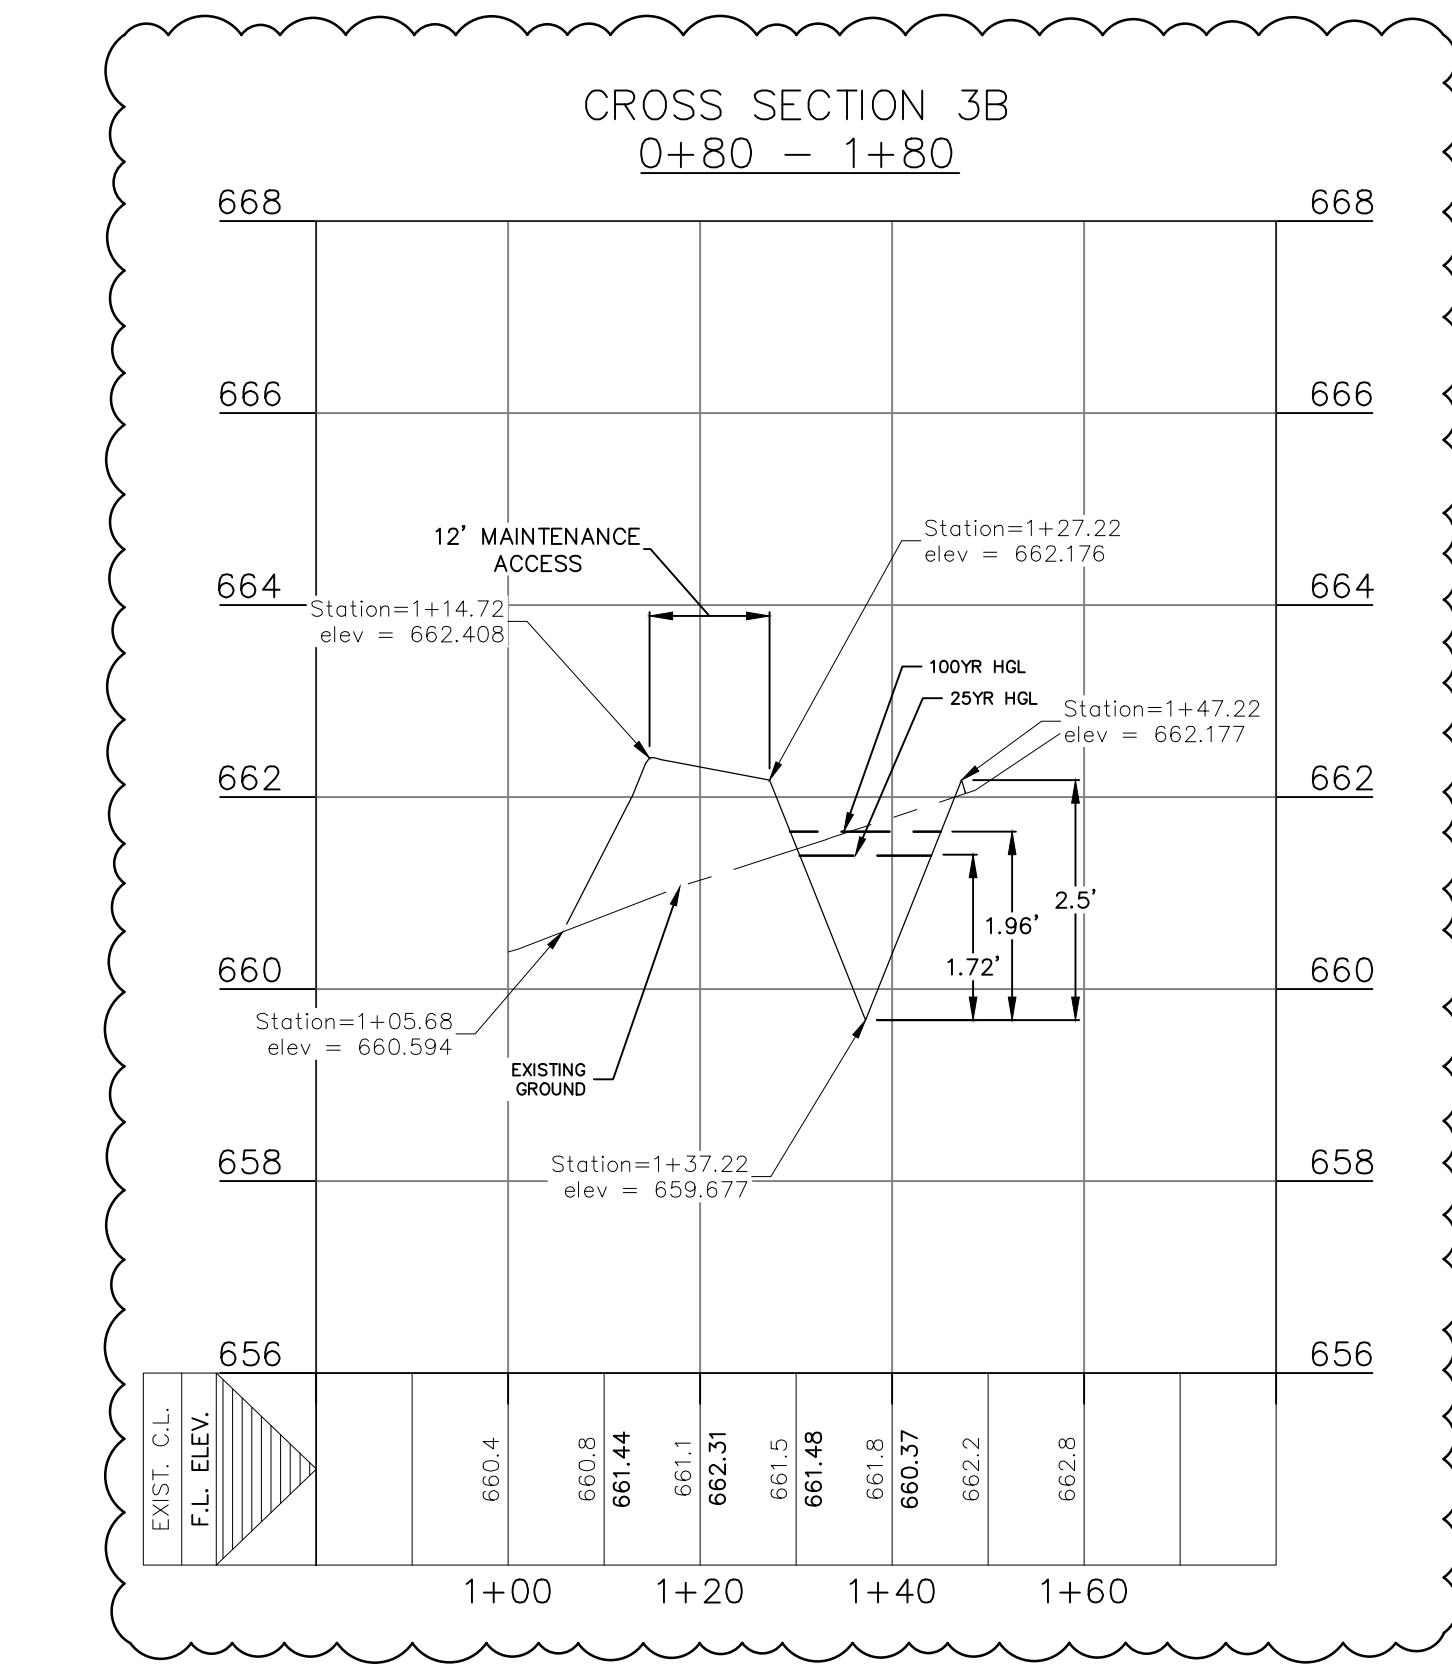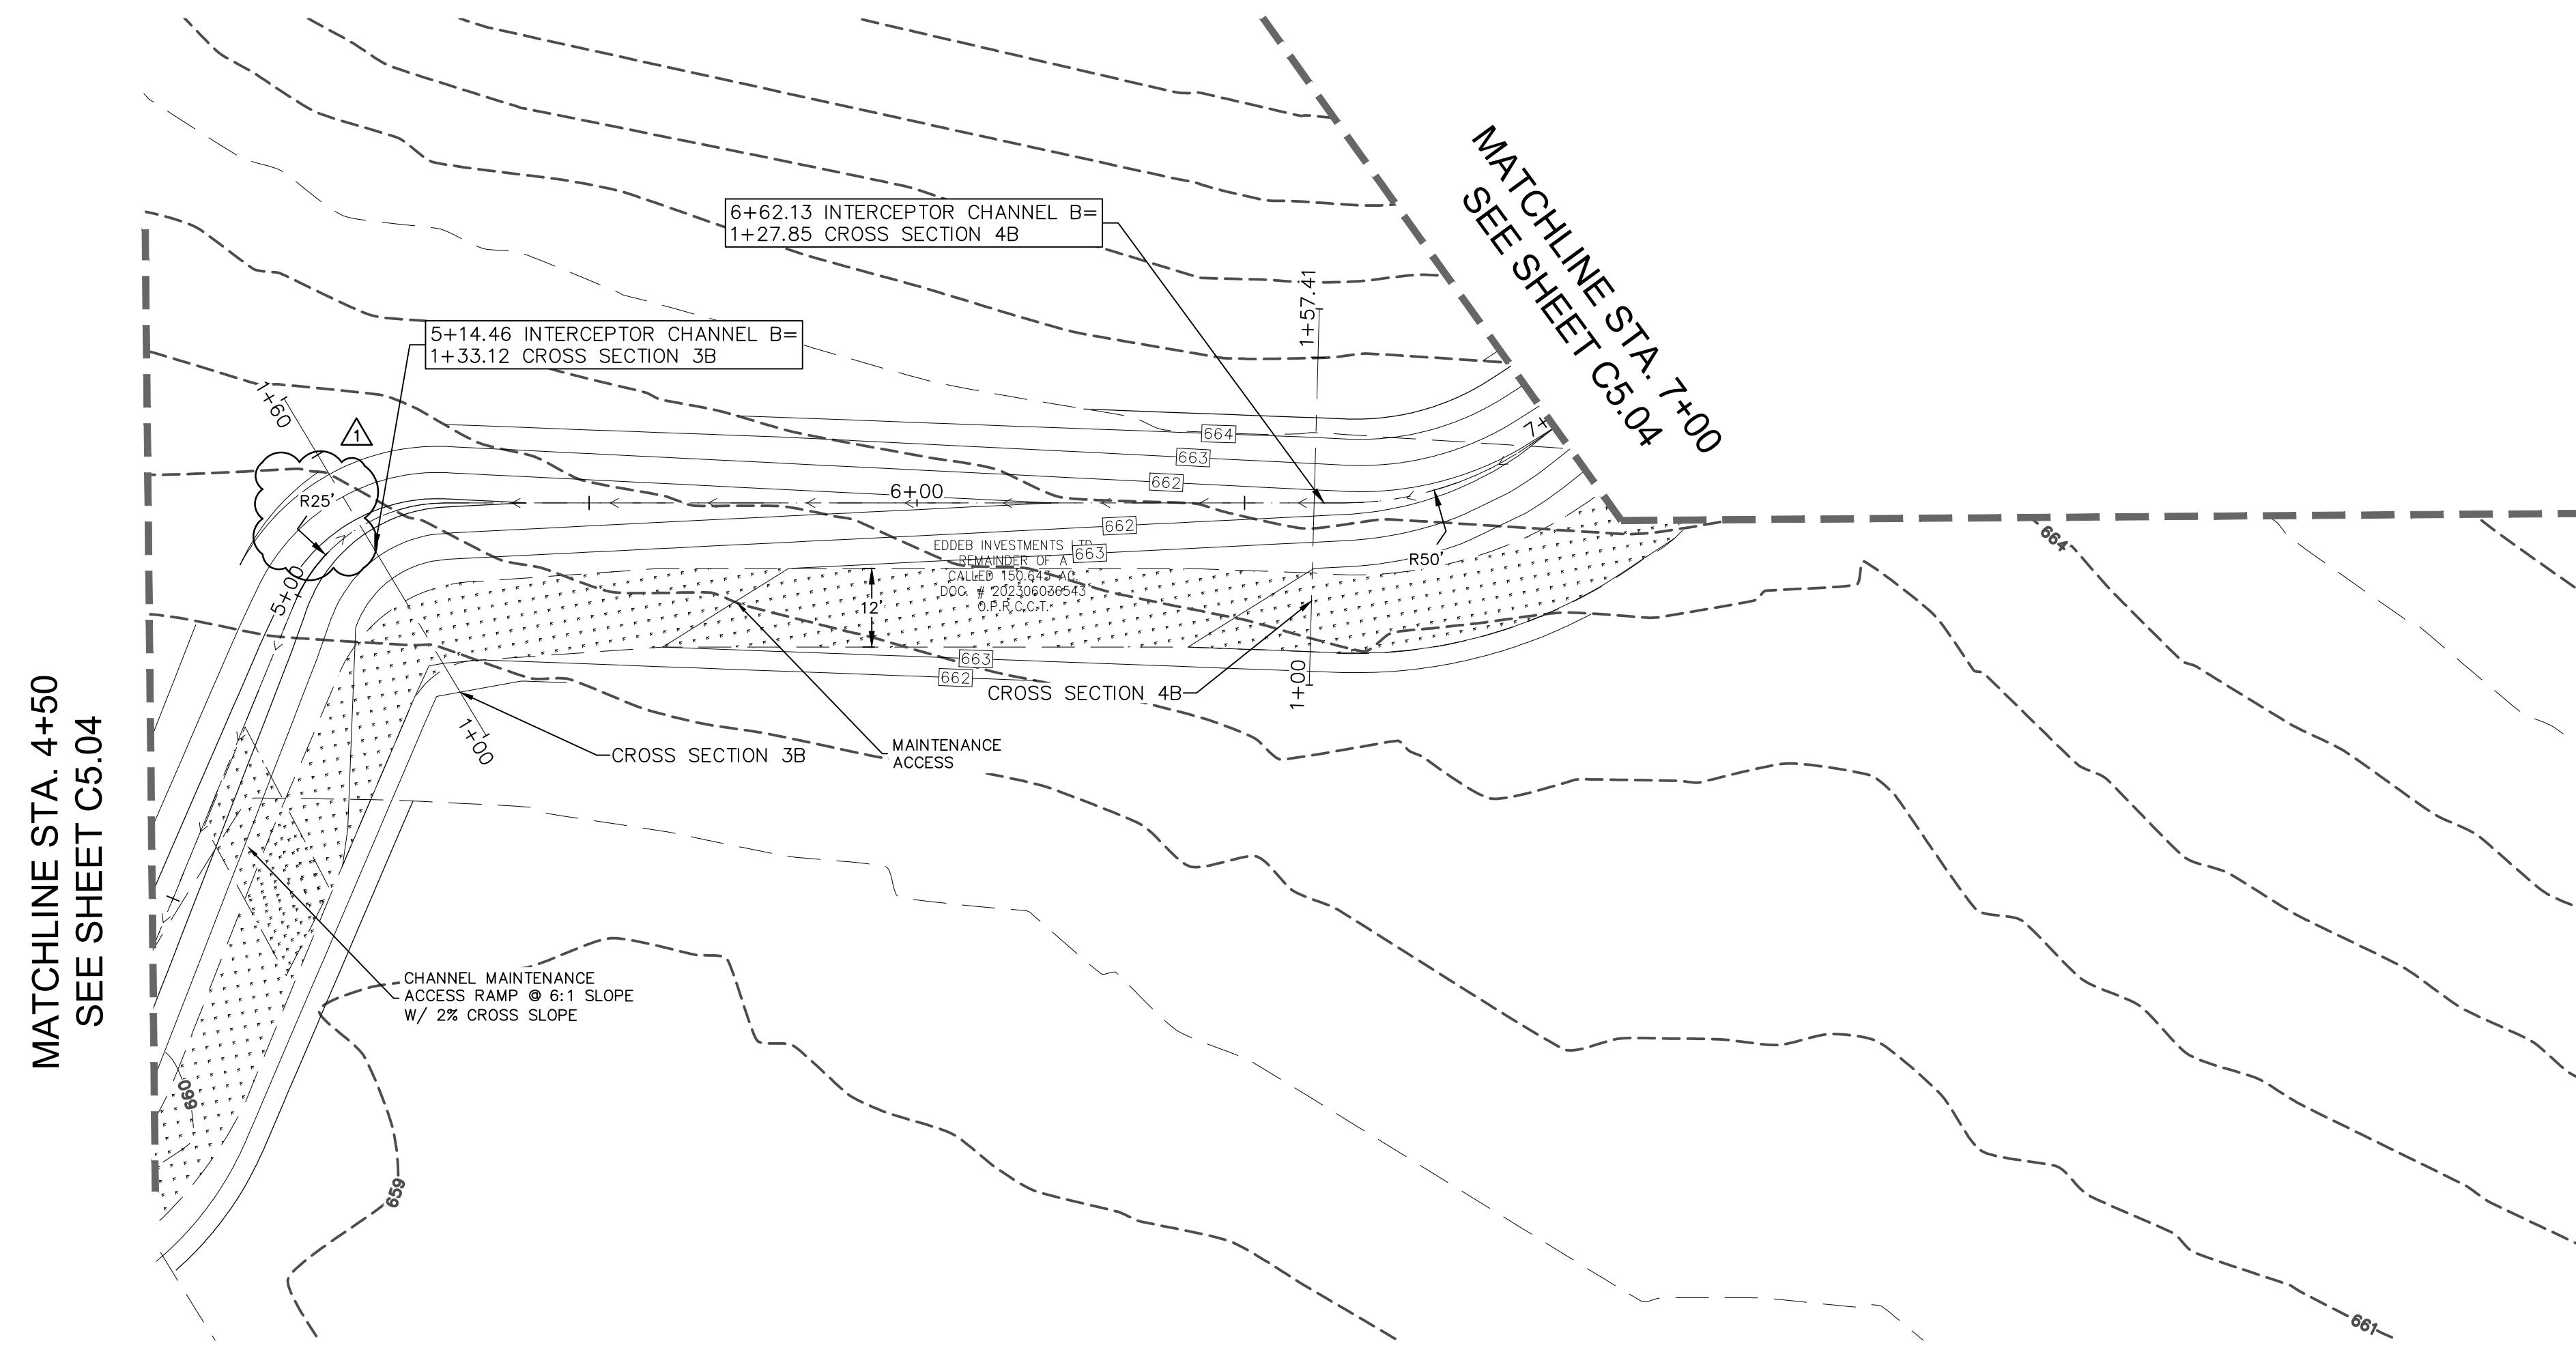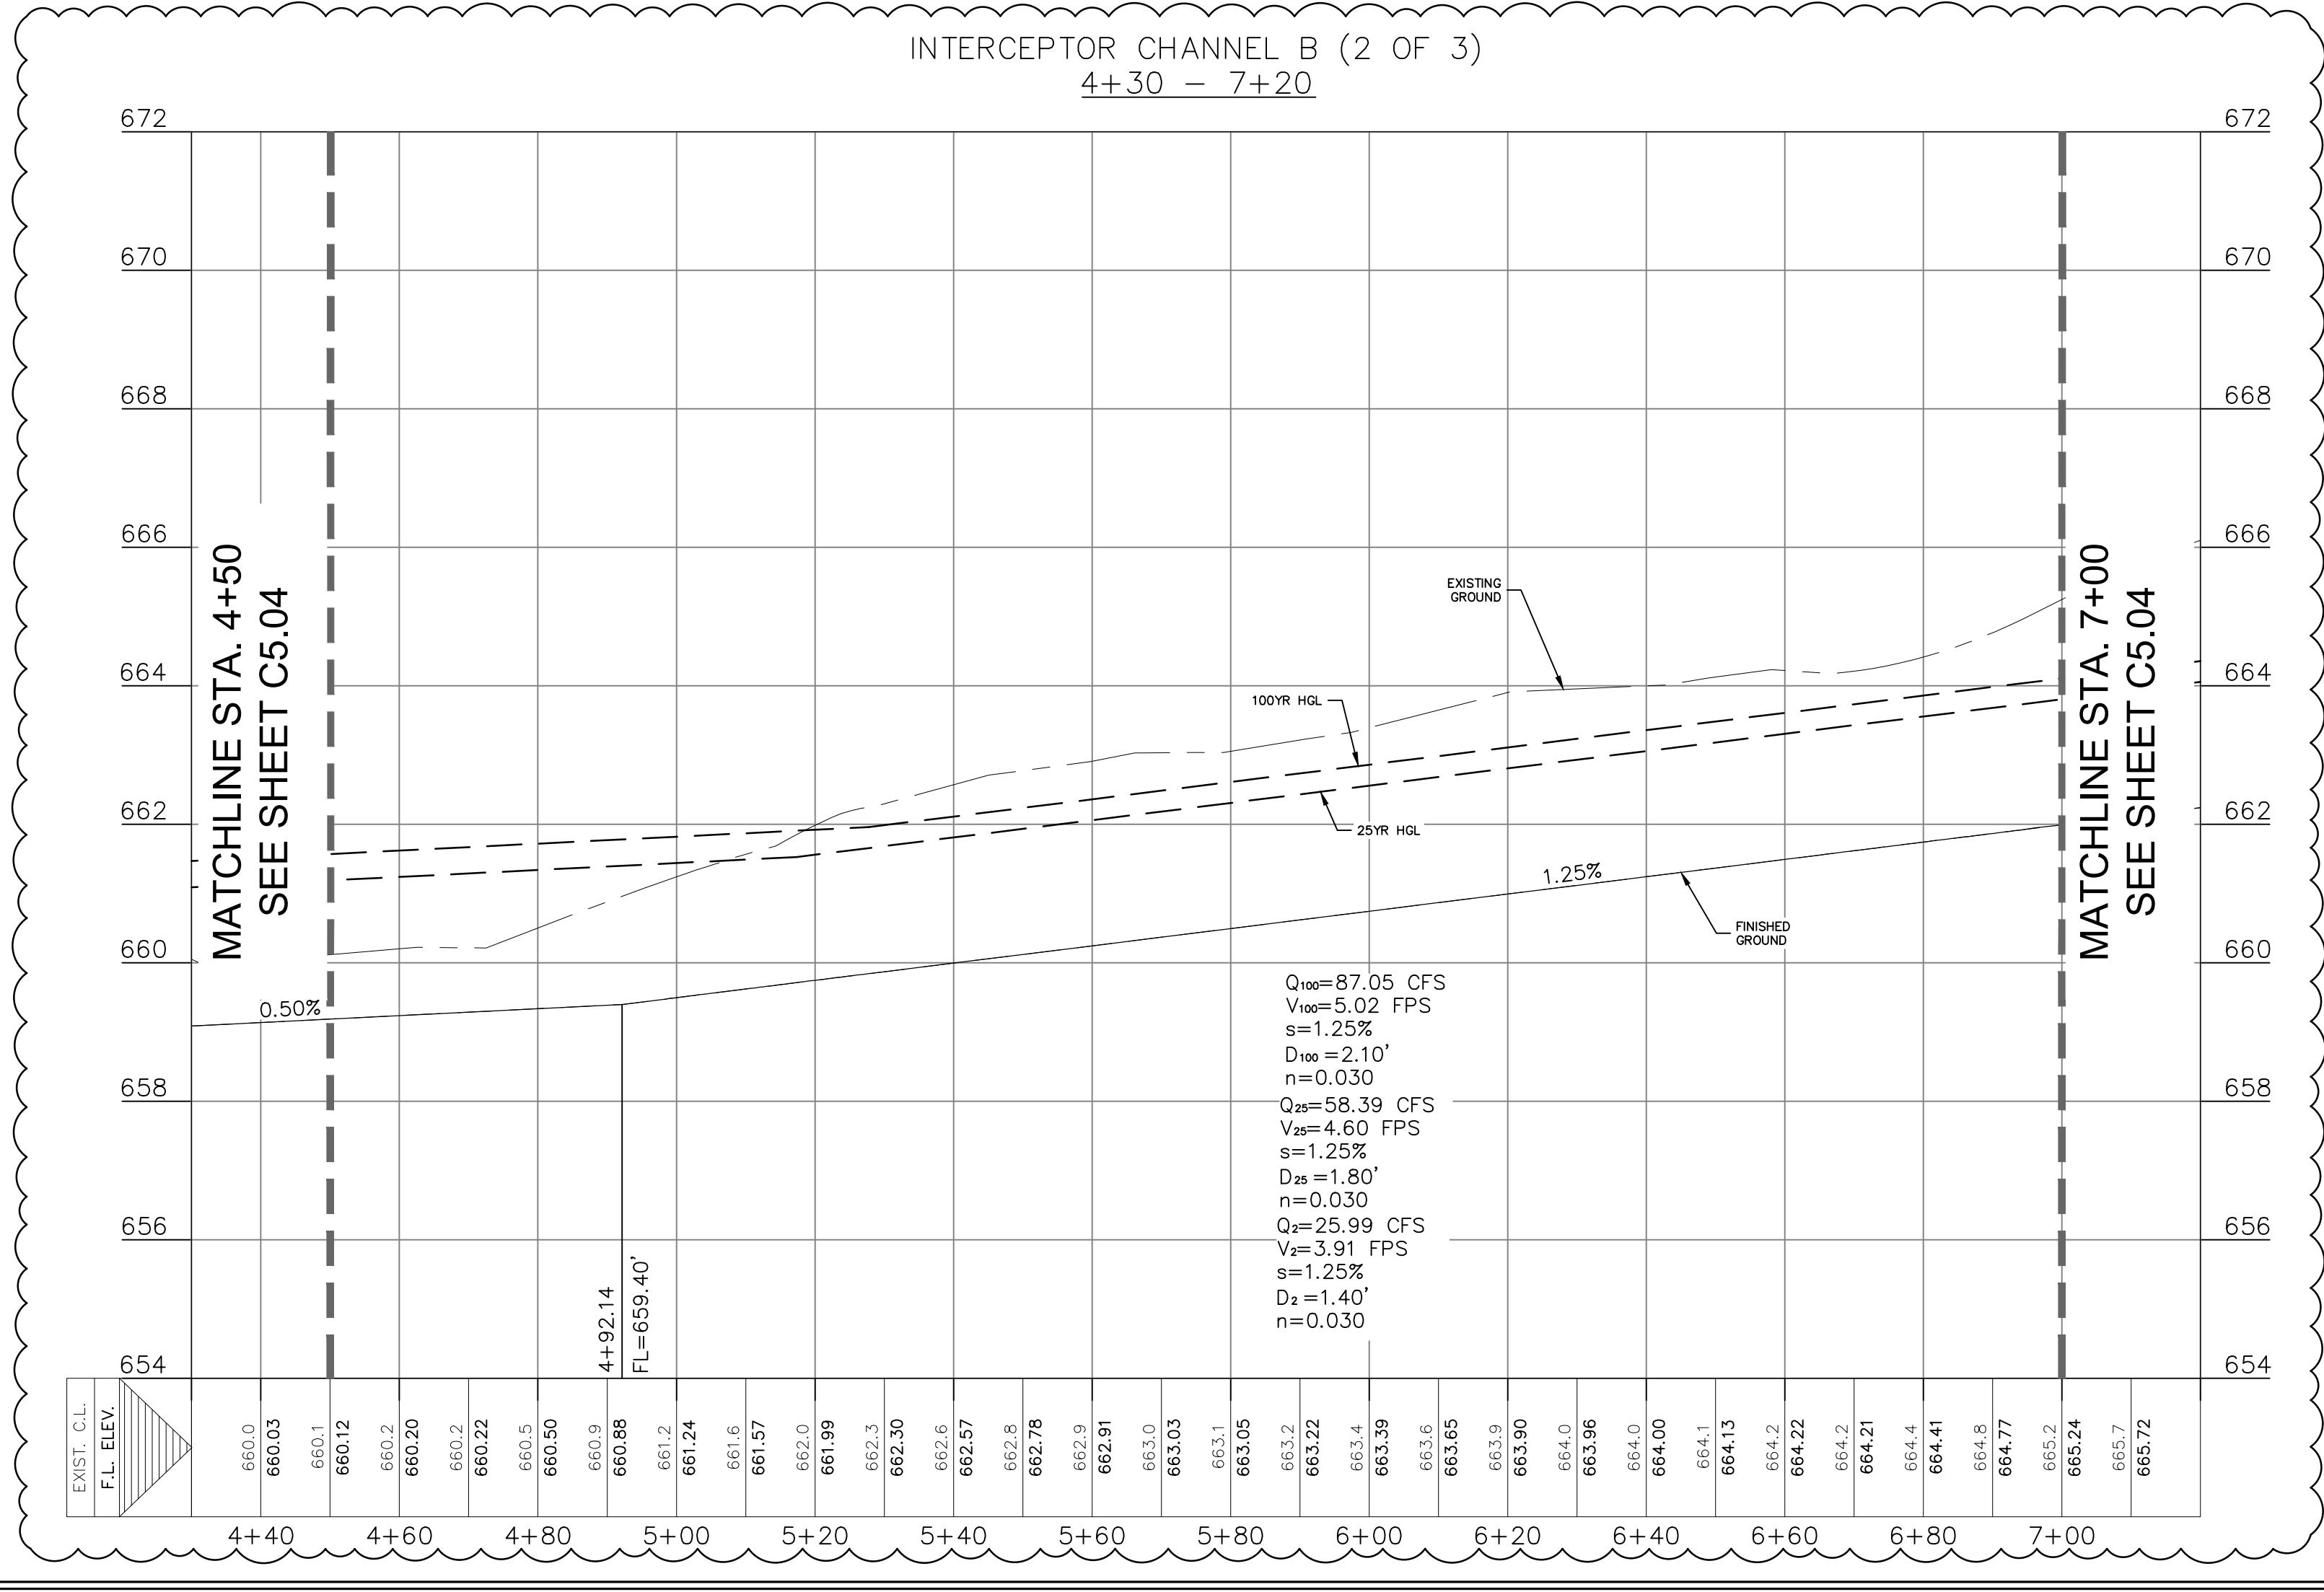

REFER TO THE COVER SHEET
FOR BENCHMARK INFORMATION.

THE LOCATION OF ALL EXISTING UNDERGROUND UTILITIES ARE SHOWN IN APPROXIMATE LOCATIONS ONLY. THE CONTRACTOR SHALL DETERMINE THE EXACT LOCATION OF ALL EXISTING UTILITIES BEFORE COMMENCING WORK. THE CONTRACTOR WILL AGREE TO BE FULLY RESPONSIBLE FOR ANY AND ALL DAMAGES WHICH MIGHT BE INCURRED BY THEIR FAILURE TO EXACTLY LOCATE AND PRESERVE ANY AND ALL UNDERGROUND UTILITIES, STRUCTURES OR FACILITIES. CONTRACTOR SHALL NOTIFY ENGINEER OF ANY DISCREPANCIES 24-HOURS PRIOR TO COMMENCING CONSTRUCTION.

DRAINAGE FEATURES, DETENTION BASIN MAINTENANCE AND EQUIPMENT ACCESS REQUIREMENTS:

- A. TO LIMIT EROSION, NO UNVEGETATED AREA SHALL EXCEED 10 SQ. FT. IN EXTENT.
- B. ACCUMULATED PAPER, TRASH, AND DEBRIS SHALL BE REMOVED EVERY 6 MONTHS OR AS NECESSARY TO MAINTAIN PROPER OPERATION.
- C. BASINS SHALL BE MOWED ANNUALLY BETWEEN THE MONTHS OF JUNE AND SEPTEMBER.
- D. CORRECTIVE MAINTENANCE IS REQUIRED ANY TIME A BASIN DOES NOT DRAIN COMPLETELY WITHIN 60 HOURS OR CESSION OF INFLOW (IE: NO STANDING WATER IS ALLOWED).
- E. STRUCTURAL INTEGRITY OF BASINS SHALL BE MAINTAINED AT ALL TIMES.
- F. MAINTENANCE VEHICLE FOR POND ACCESS SHOULD BE A BOBCAT S175 SKID STEER LOADER OR VEHICLE OF EQUAL TO LESSER SIZE.

HMT | ENGINEERING & SURVEYING

290 S. CASTELL AVE., STE. 100
NEW BRAUNFELS, TX 78130
TBPELS FIRM F-10961
TBPLES FIRM 1053600

01/22/2026

STATE OF TEXAS

MATTHEW T. ABRAHAMSEN

154638

LICENSED PROFESSIONAL ENGINEER

Matthew T. Abraham

INTERCEPTOR CHANNEL B PLAN & PROFILE (2 OF 3)





KYNDWOOD SUBDIVISION, UNIT 5 NEW BRAUNFELS, TEXAS

| NO. | REVISION DESCRIPTION | REVISION DATE |
|-----|----------------------------|---------------|
| 1 | ADJUSTED CHANNEL FLOW LINE | 1/22/2026 |
| | | |
| | | |
| </ | | |

| | |
|------------------|---------------------|
| DATE: | JANUARY 2026 |
| DRAWN BY: | MK |
| DESIGNED BY: | MA |
| REVIEWED BY: | MA |
| HMT PROJECT NO.: | |


SHEET

C5.05

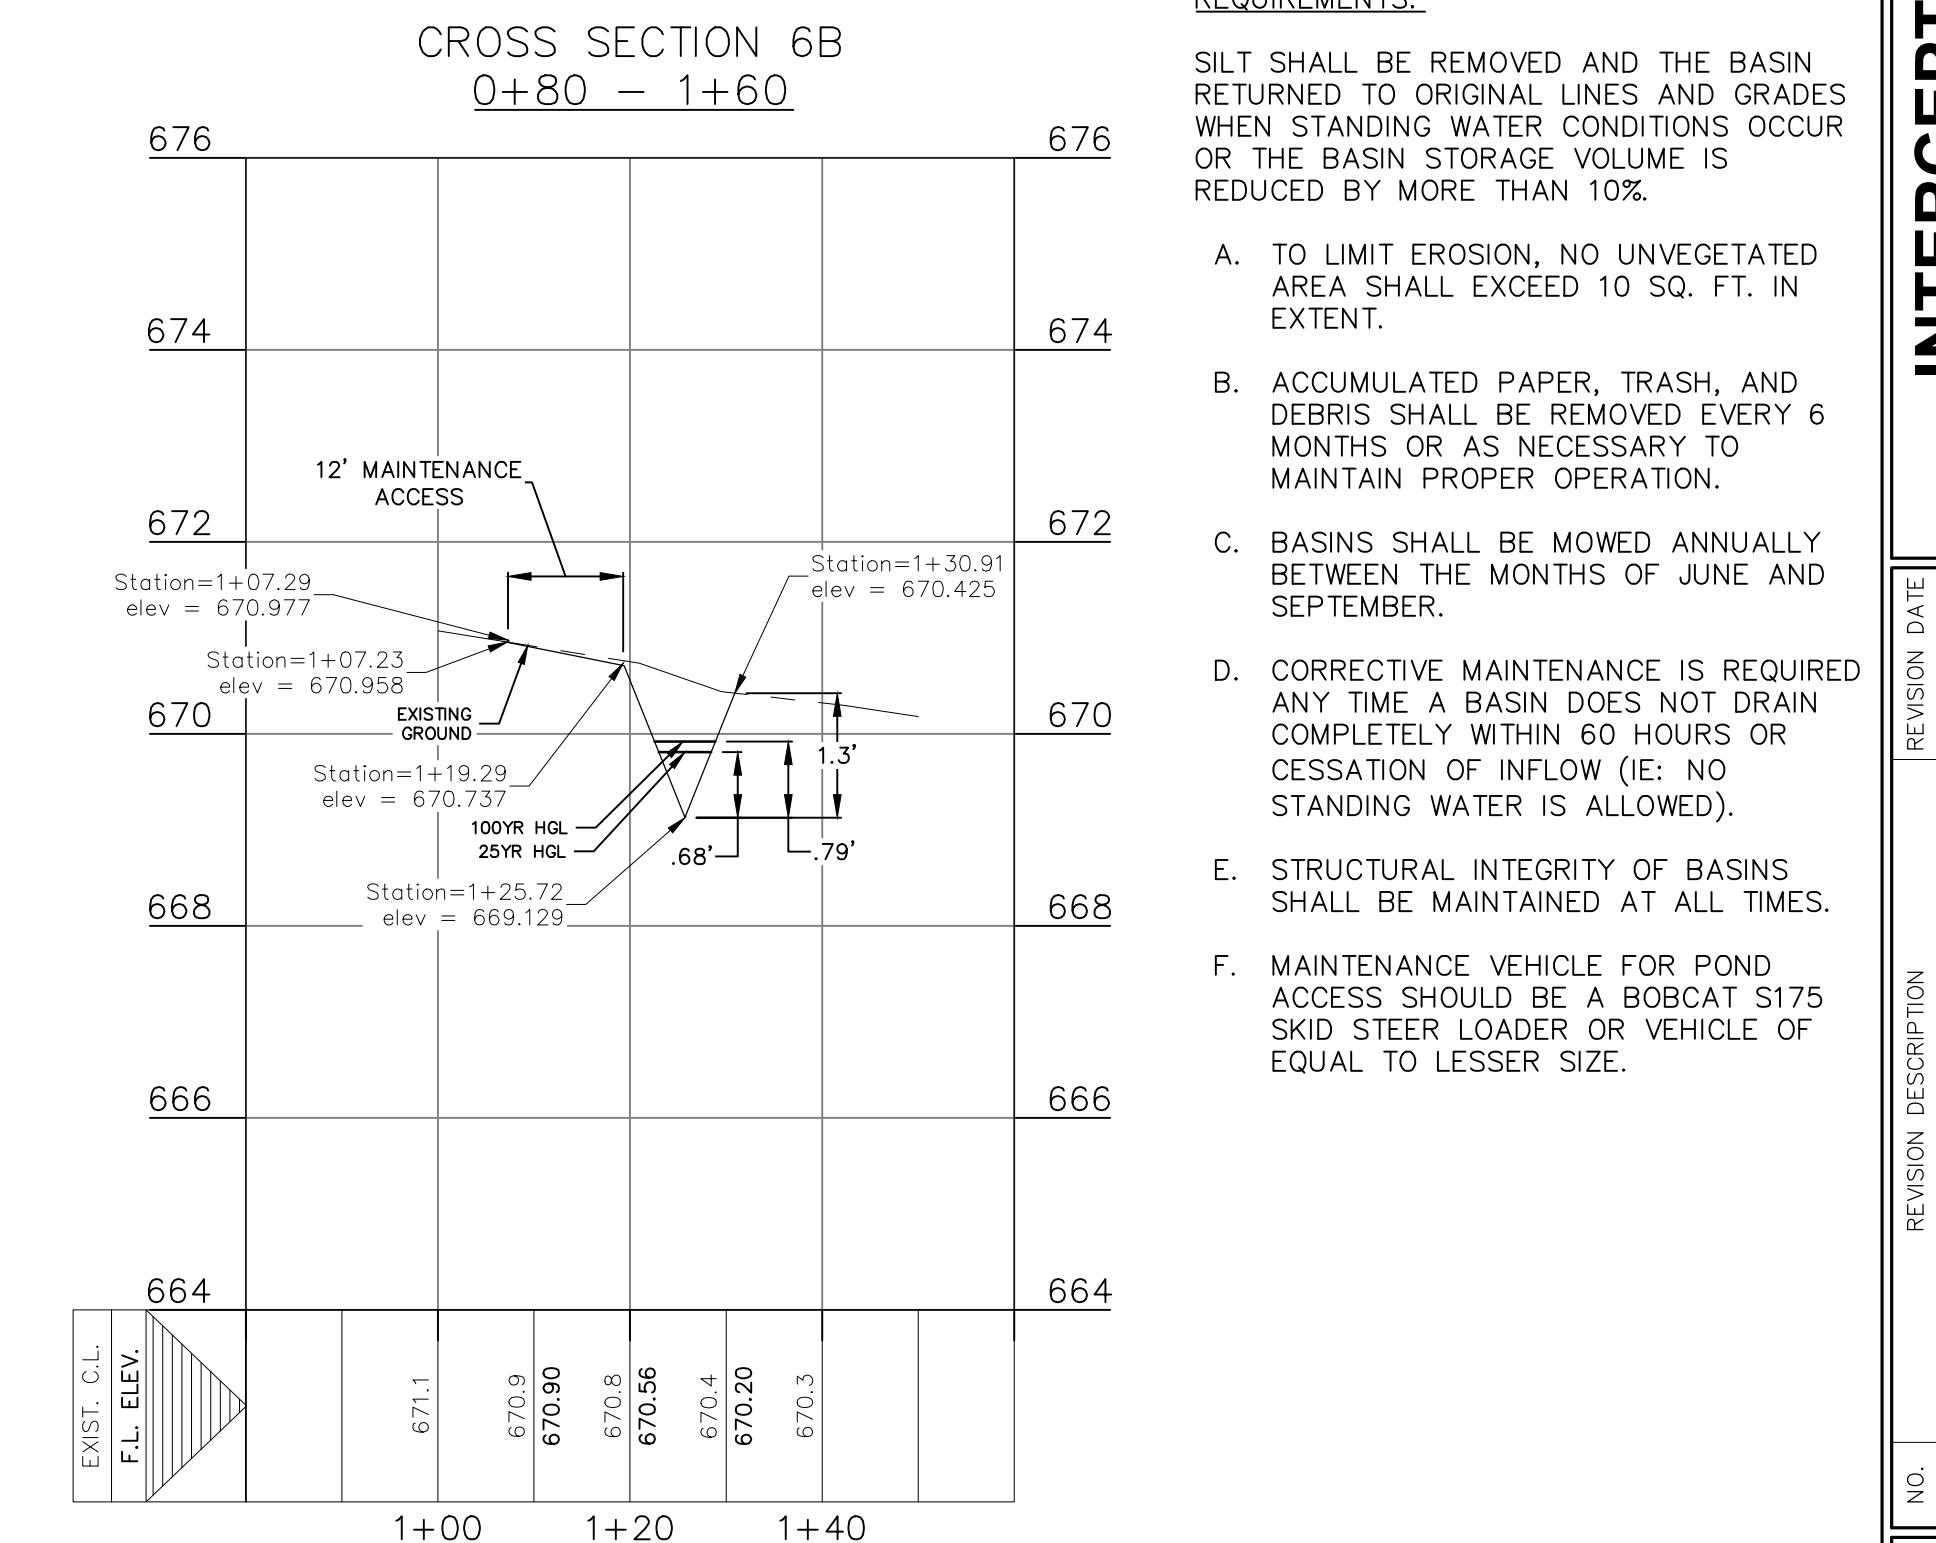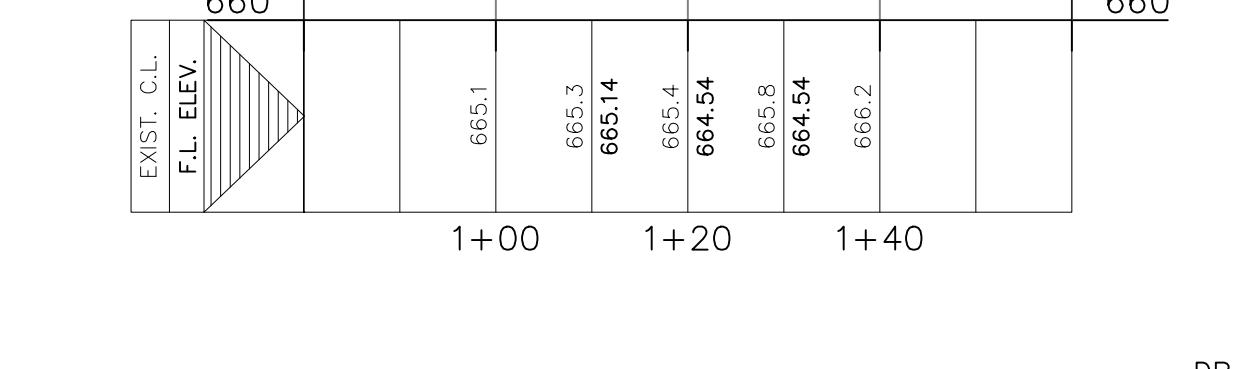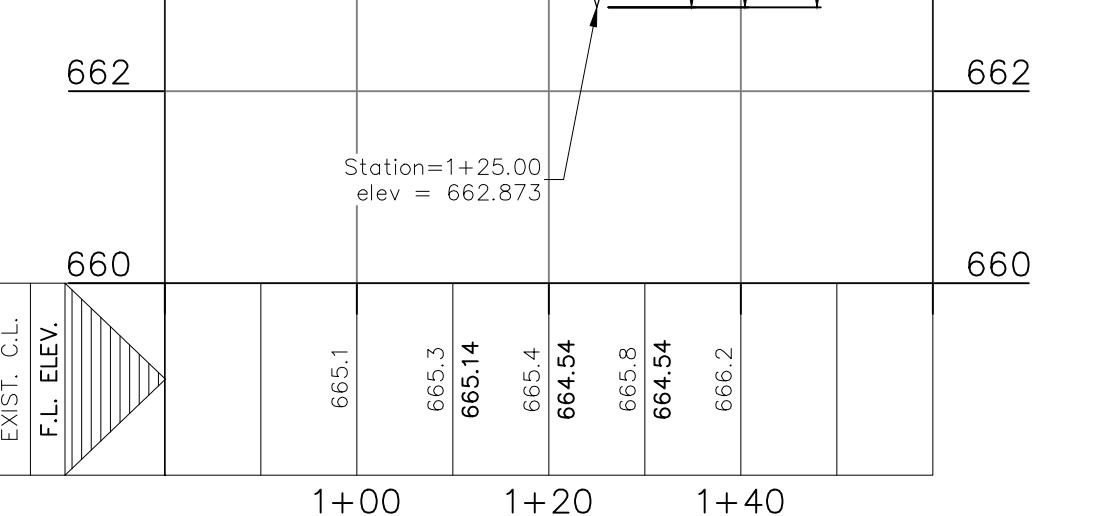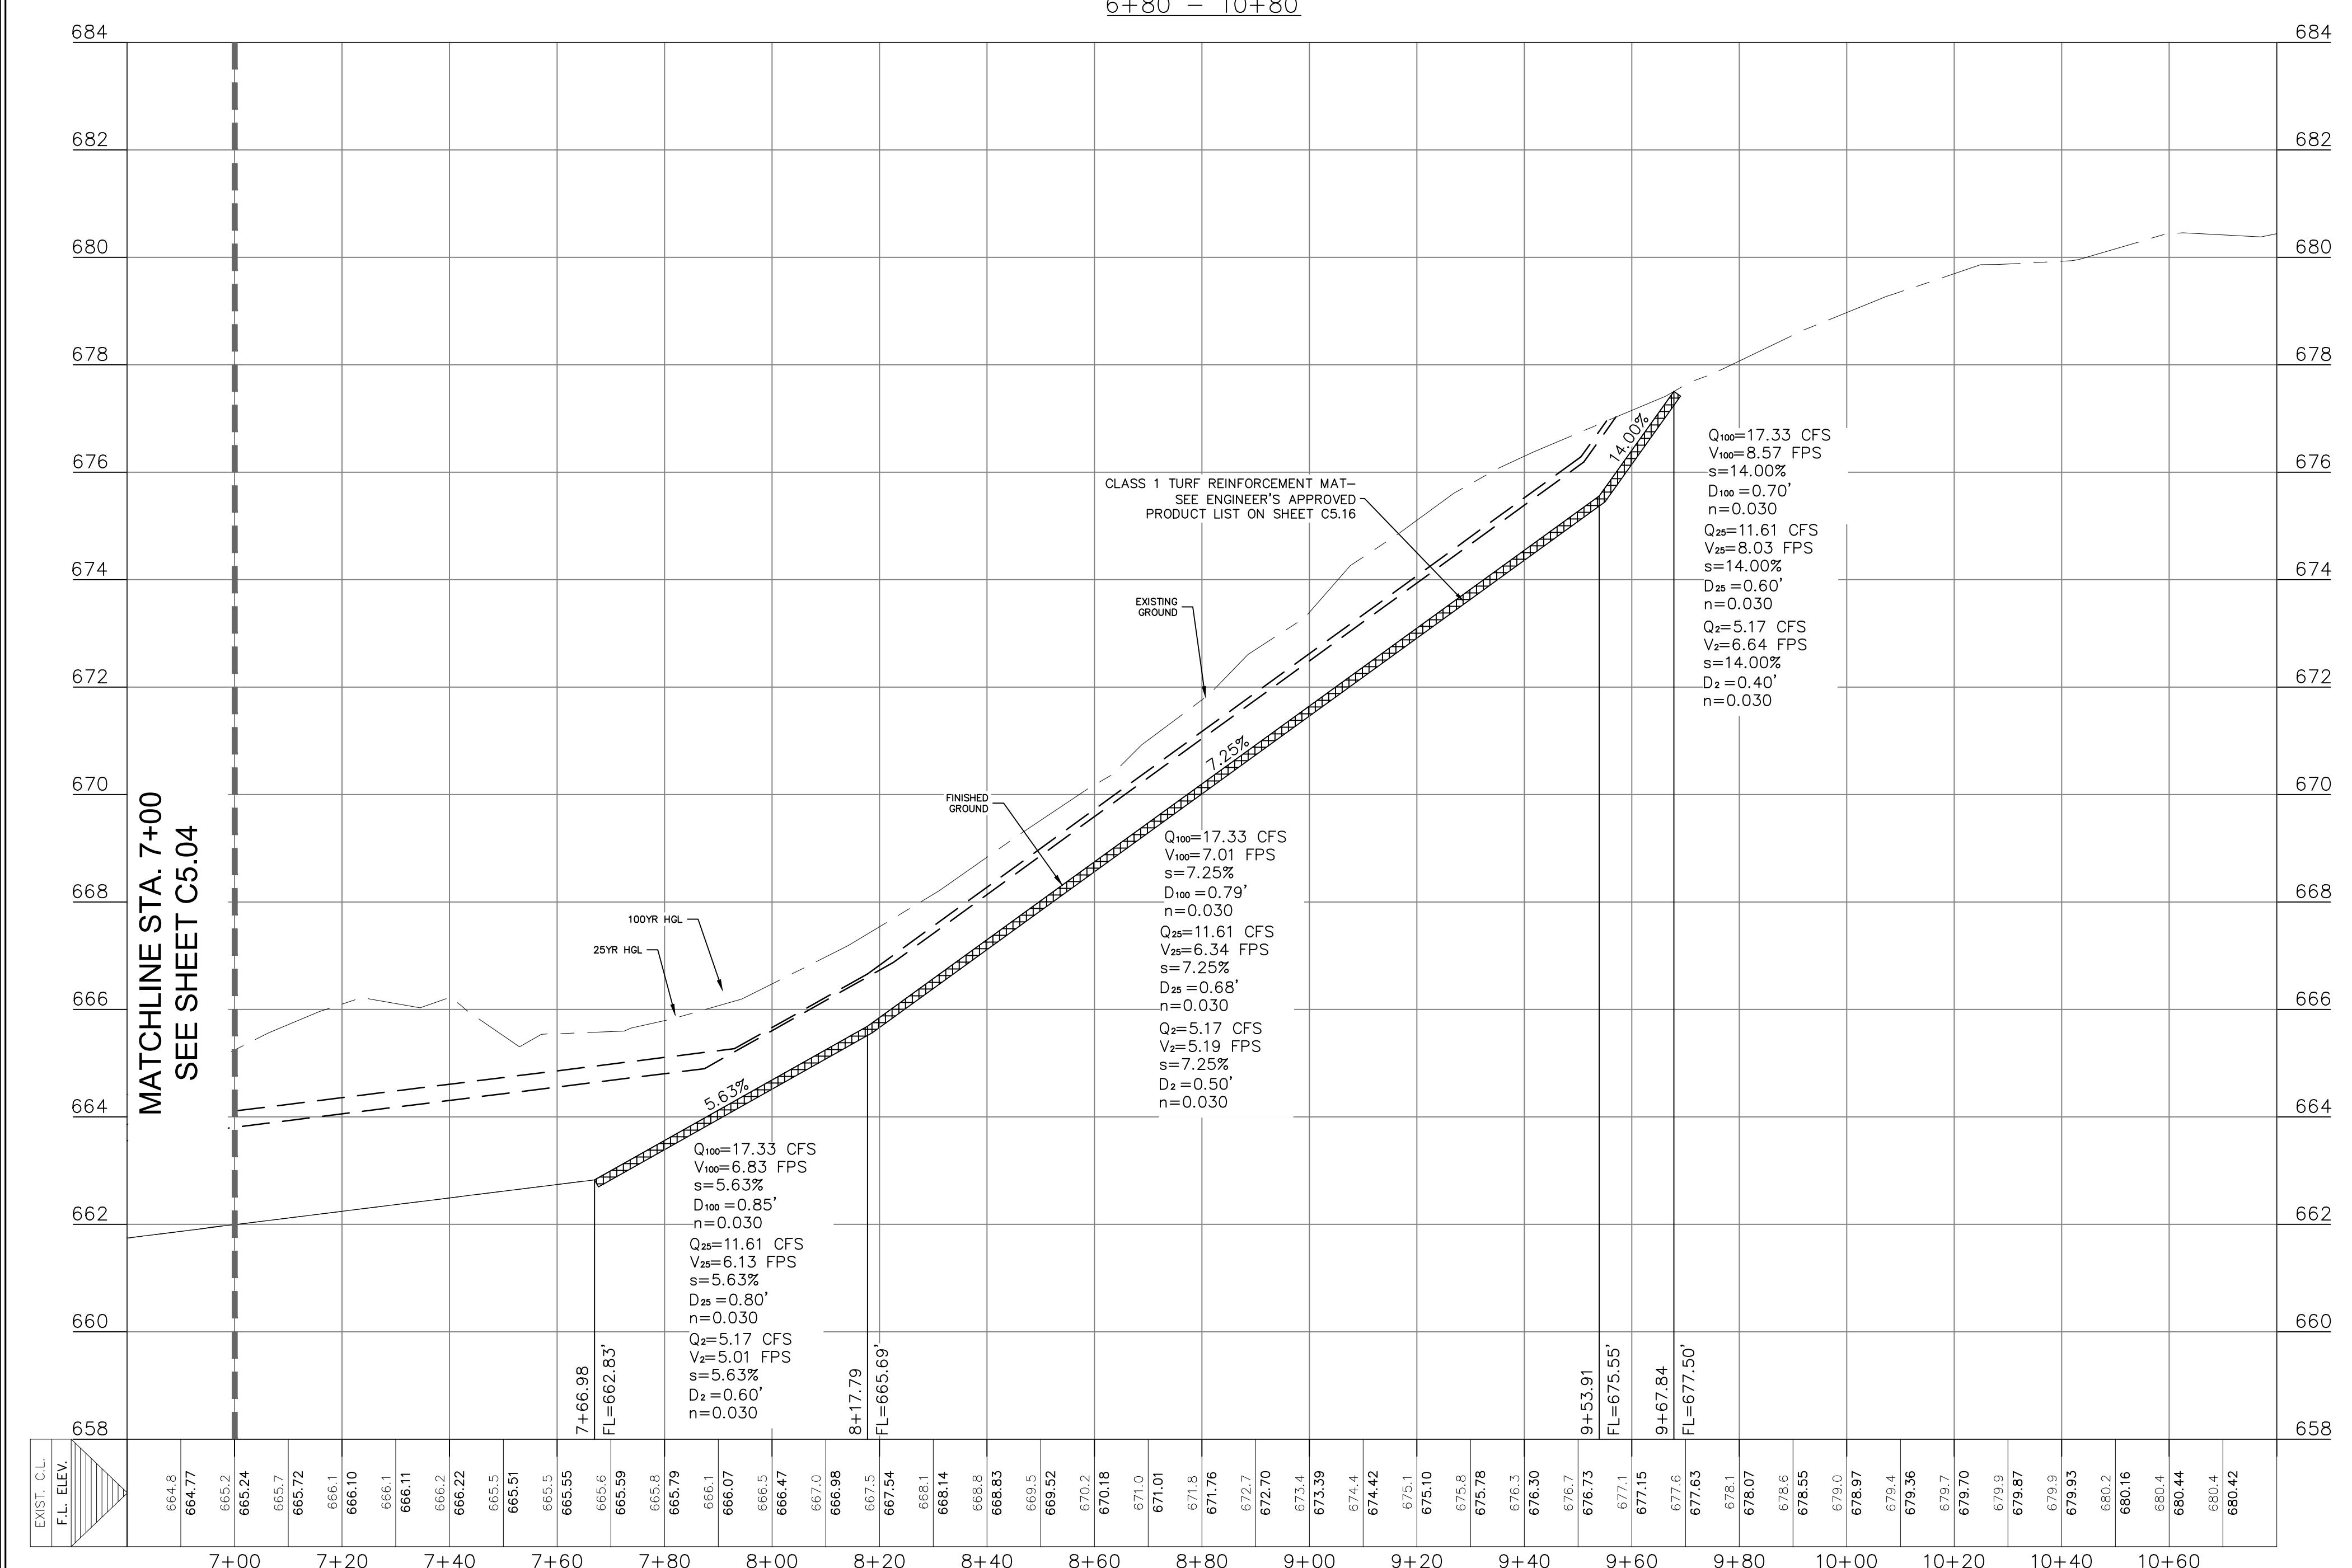

REFER TO THE COVER SHEET
FOR BENCHMARK INFORMATION.



THE LOCATION OF ALL EXISTING UNDERGROUND UTILITIES ARE SHOWN IN APPROXIMATE LOCATIONS ONLY. THE CONTRACTOR SHALL DETERMINE THE EXACT LOCATION OF ALL EXISTING UTILITIES BEFORE COMMENCING WORK. THE CONTRACTOR WILL AGREE TO BE FULLY RESPONSIBLE FOR ANY AND ALL DAMAGES WHICH MIGHT BE INCURRED BY THEIR FAILURE TO EXACTLY LOCATE AND PRESERVE ANY AND ALL UNDERGROUND UTILITIES, STRUCTURES OR FACILITIES. CONTRACTOR SHALL NOTIFY ENGINEER OF ANY DISCREPANCIES 24-HOURS PRIOR TO COMMENCING CONSTRUCTION.

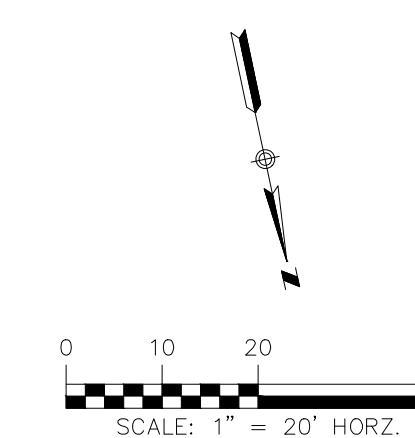

LEGEND



- EXISTING CONTOURS
- PROPOSED CONTOURS
- B.L. BUILDING SETBACK LINE
- U.E. UTILITY EASEMENT
- D.E. DRAINAGE EASEMENT
- M.B.C. MULTIPLE BOX CULVERT
- PROPOSED STORM DRAIN LINE
- EXISTING STORM DRAIN LINE
- UTILITY CROSSING

290 S. CASTELL AVE., STE. 100
NEW BRAUNFELS, TX 78130
TBPELS FIRM F-105061
TBPELS FIRM 1053600

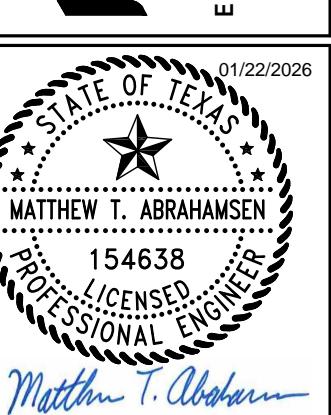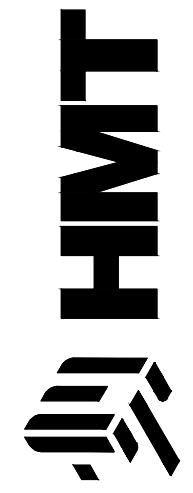

**INTERCEPTOR CHANNEL B
PLAN & PROFILE (3 OF 3)**

| NO. | REVISION DESCRIPTION | REVISION DATE |
|----------------|-----------------------------------|---------------|
| | ADDED MORE TURF REINFORCE MATTING | 1/22/2026 |
| DATE: | JANUARY 2026 | |
| DRAWN BY: | MK | |
| DESIGNED BY: | MA | |
| REVIEWED BY: | MA | |
| HMT PROJ. NO.: | 337.081 | |
| SHEET | | |
| C5.06 | | |

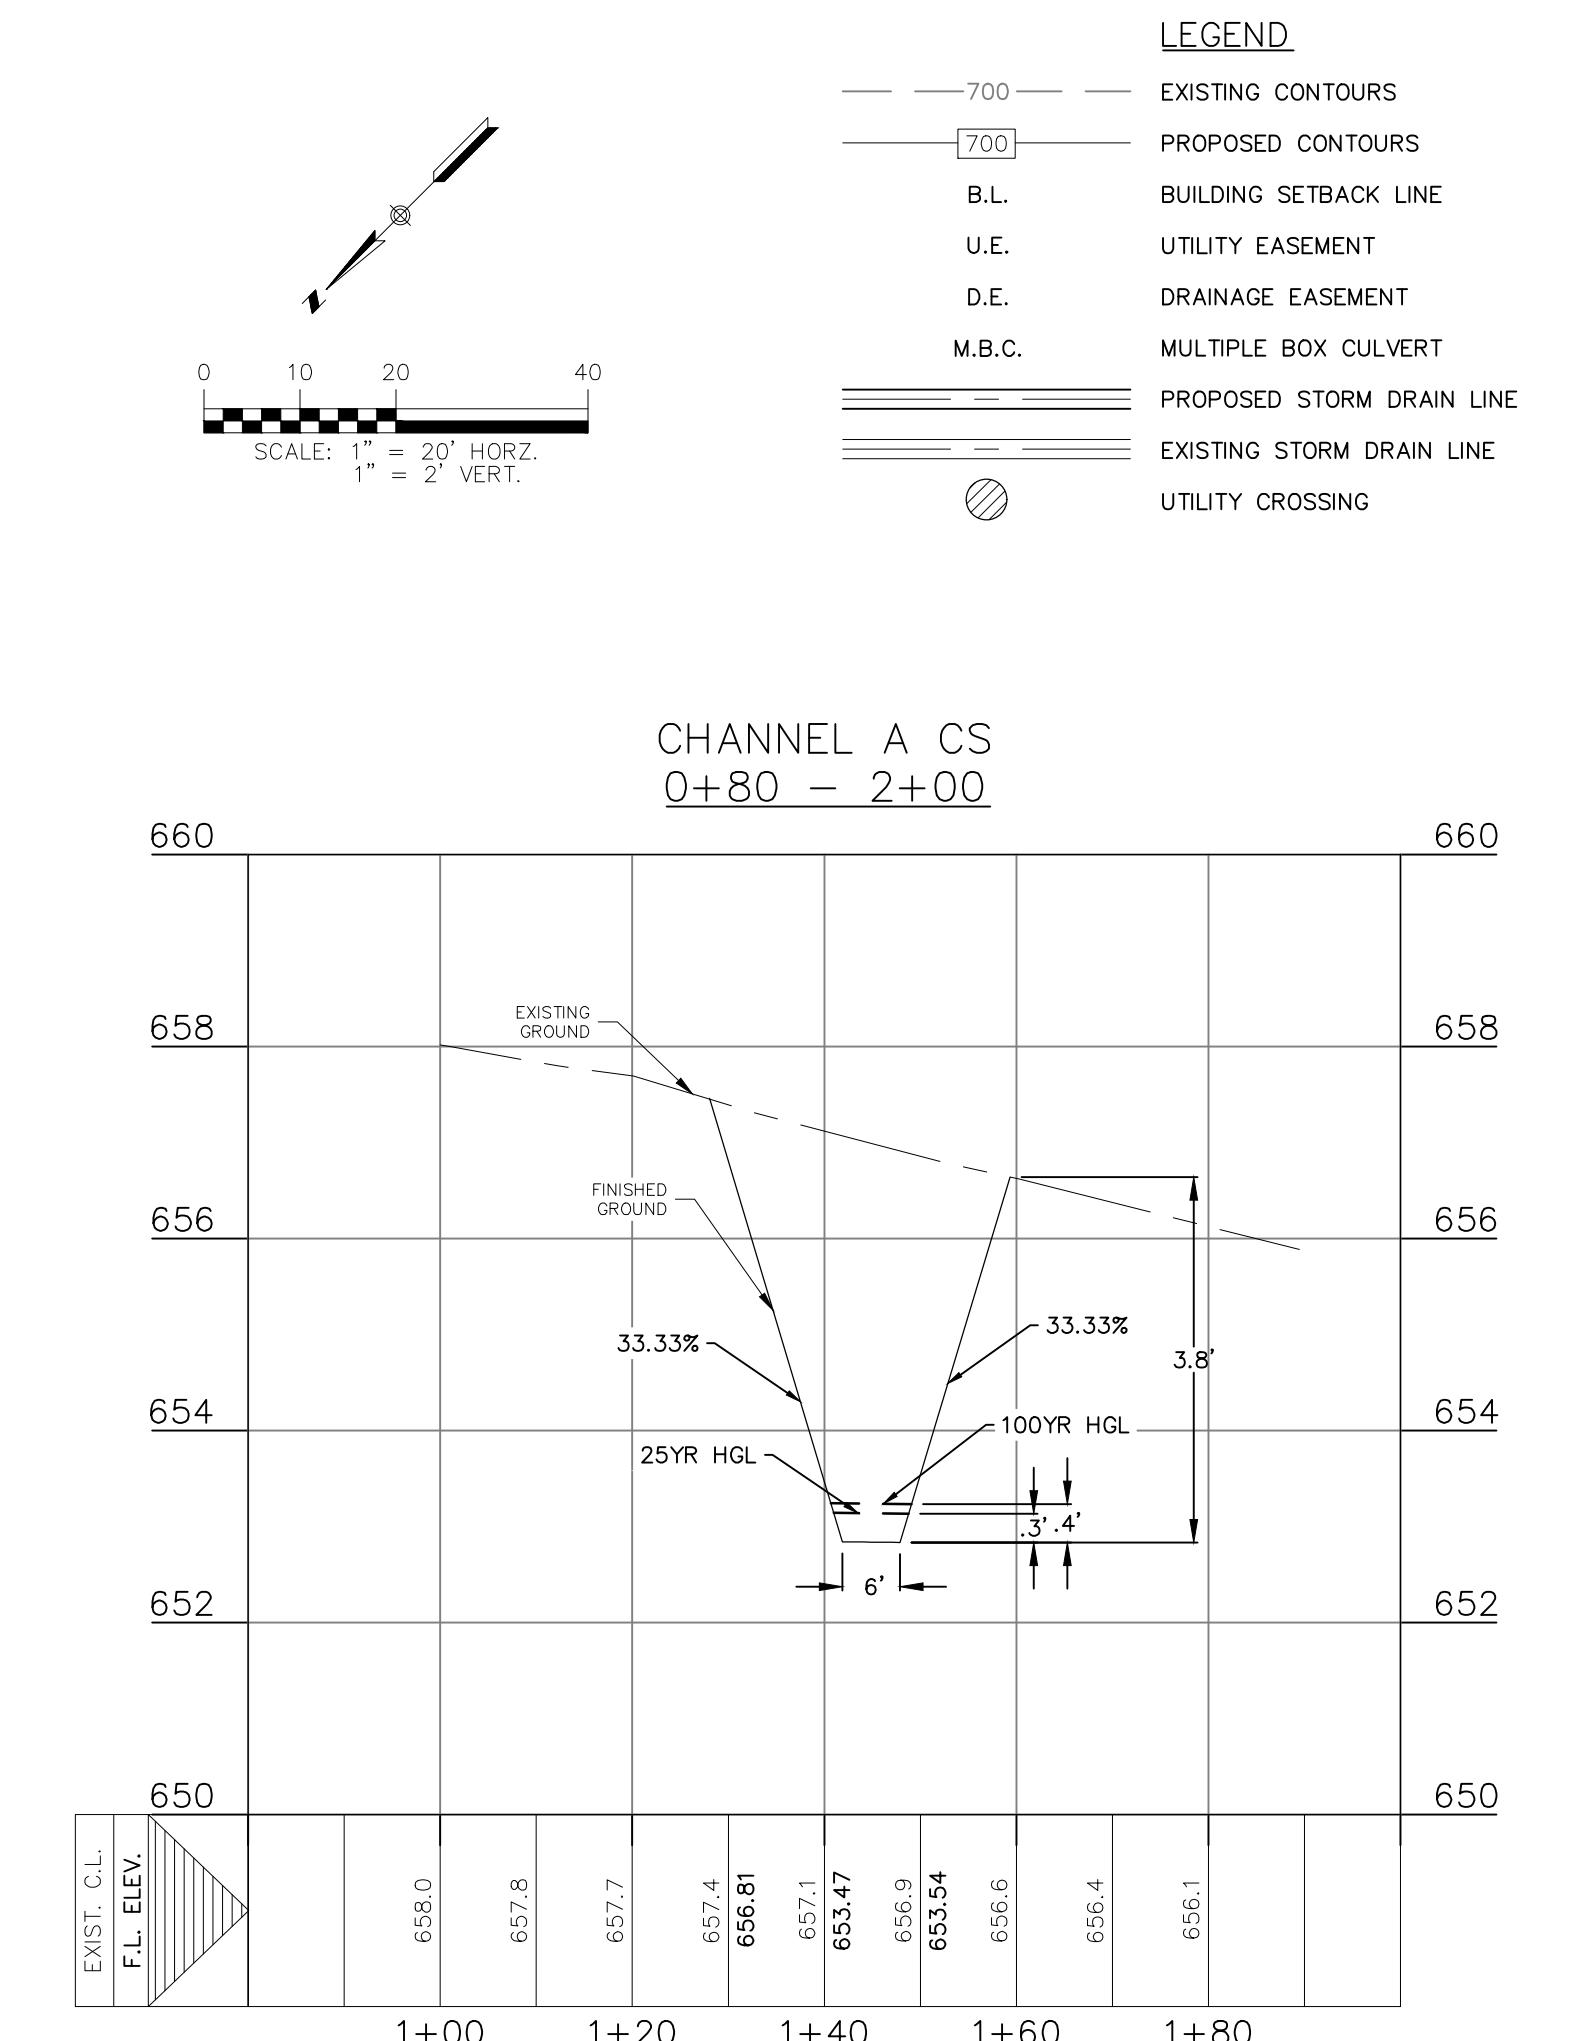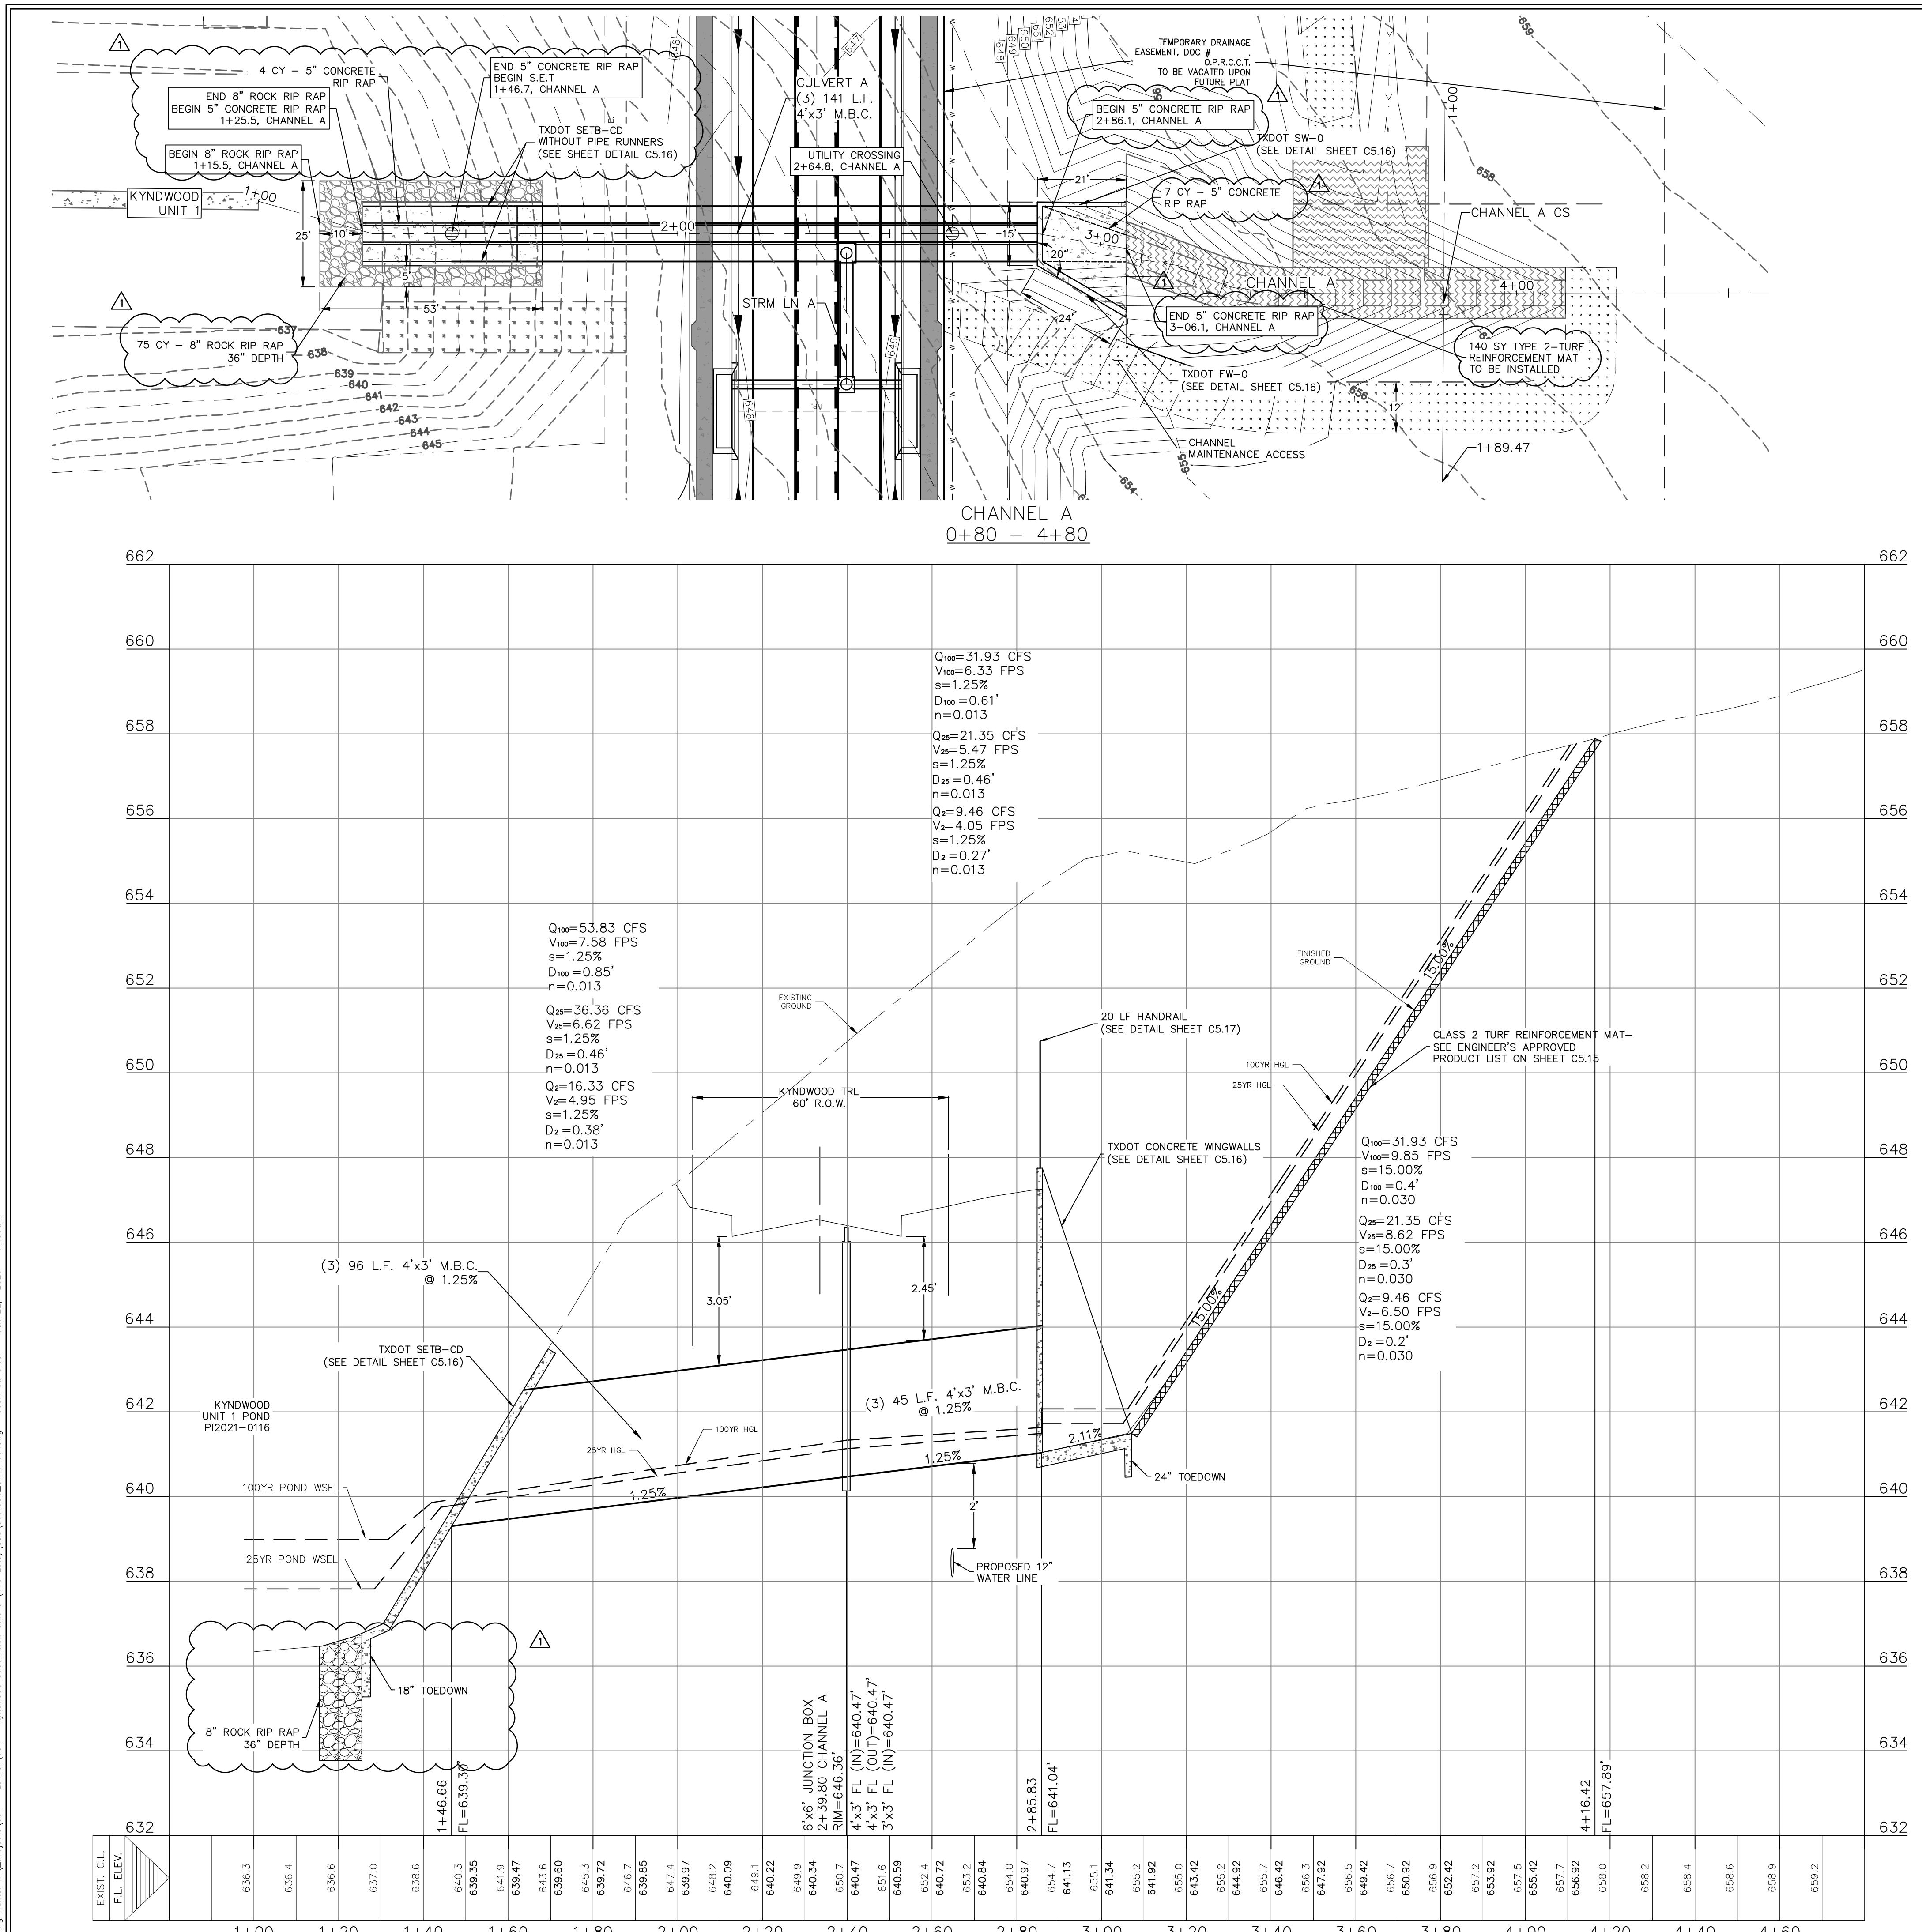

WATER FEATURES, DETENTION BASIN MAINTENANCE AND EQUIPMENT ACCESS REQUIREMENTS:

IT SHALL BE REMOVED AND THE BASIN TURNED TO ORIGINAL LINES AND GRADES WHEN STANDING WATER CONDITIONS OCCUR OR THE BASIN STORAGE VOLUME IS REDUCED BY MORE THAN 10%.

- TO LIMIT EROSION, NO UNVEGETATED AREA SHALL EXCEED 10 SQ. FT. IN EXTENT.
- ACCUMULATED PAPER, TRASH, AND DEBRIS SHALL BE REMOVED EVERY 6 MONTHS OR AS NECESSARY TO MAINTAIN PROPER OPERATION.
- BASINS SHALL BE MOWED ANNUALLY BETWEEN THE MONTHS OF JUNE AND SEPTEMBER.
- CORRECTIVE MAINTENANCE IS REQUIRED ANY TIME A BASIN DOES NOT DRAIN COMPLETELY WITHIN 60 HOURS OR CESSATION OF INFLOW (IE: NO STANDING WATER IS ALLOWED).
- STRUCTURAL INTEGRITY OF BASINS SHALL BE MAINTAINED AT ALL TIMES.
- MAINTENANCE VEHICLE FOR POND ACCESS SHOULD BE A BOBCAT S175 SKID STEER LOADER OR VEHICLE OF EQUAL TO LESSER SIZE.

REFER TO THE COVER SHEET
OR BENCHMARK INFORMATION.

THE LOCATION OF ALL EXISTING UNDERGROUND UTILITIES ARE SHOWN IN APPROXIMATE LOCATIONS ONLY. THE CONTRACTOR SHALL DETERMINE THE EXACT LOCATION OF ALL EXISTING UTILITIES BEFORE COMMENCING WORK. THE CONTRACTOR WILL AGREE TO BE FULLY RESPONSIBLE FOR ANY AND ALL DAMAGES WHICH MIGHT BE INCURRED BY THEIR FAILURE TO EXACTLY LOCATE AND PRESERVE ANY AND ALL UNDERGROUND UTILITIES, STRUCTURES OR FACILITIES. CONTRACTOR SHALL NOTIFY ENGINEER OF ANY DISCREPANCIES 24-HOURS PRIOR TO COMMENCING CONSTRUCTION.

CHANNEL A PLAN & PROFILE

KYNDWOOD SUBDIVISION, UNIT 5 NEW BRAUNFELS, TEXAS

DATE: **JANUARY 2026**

DRAWN BY: **MK**


DESIGNED BY: **MA**

REVIEWED BY: **MA**


HMT PROJECT NO.: **337.081**

SHEET


C5.07

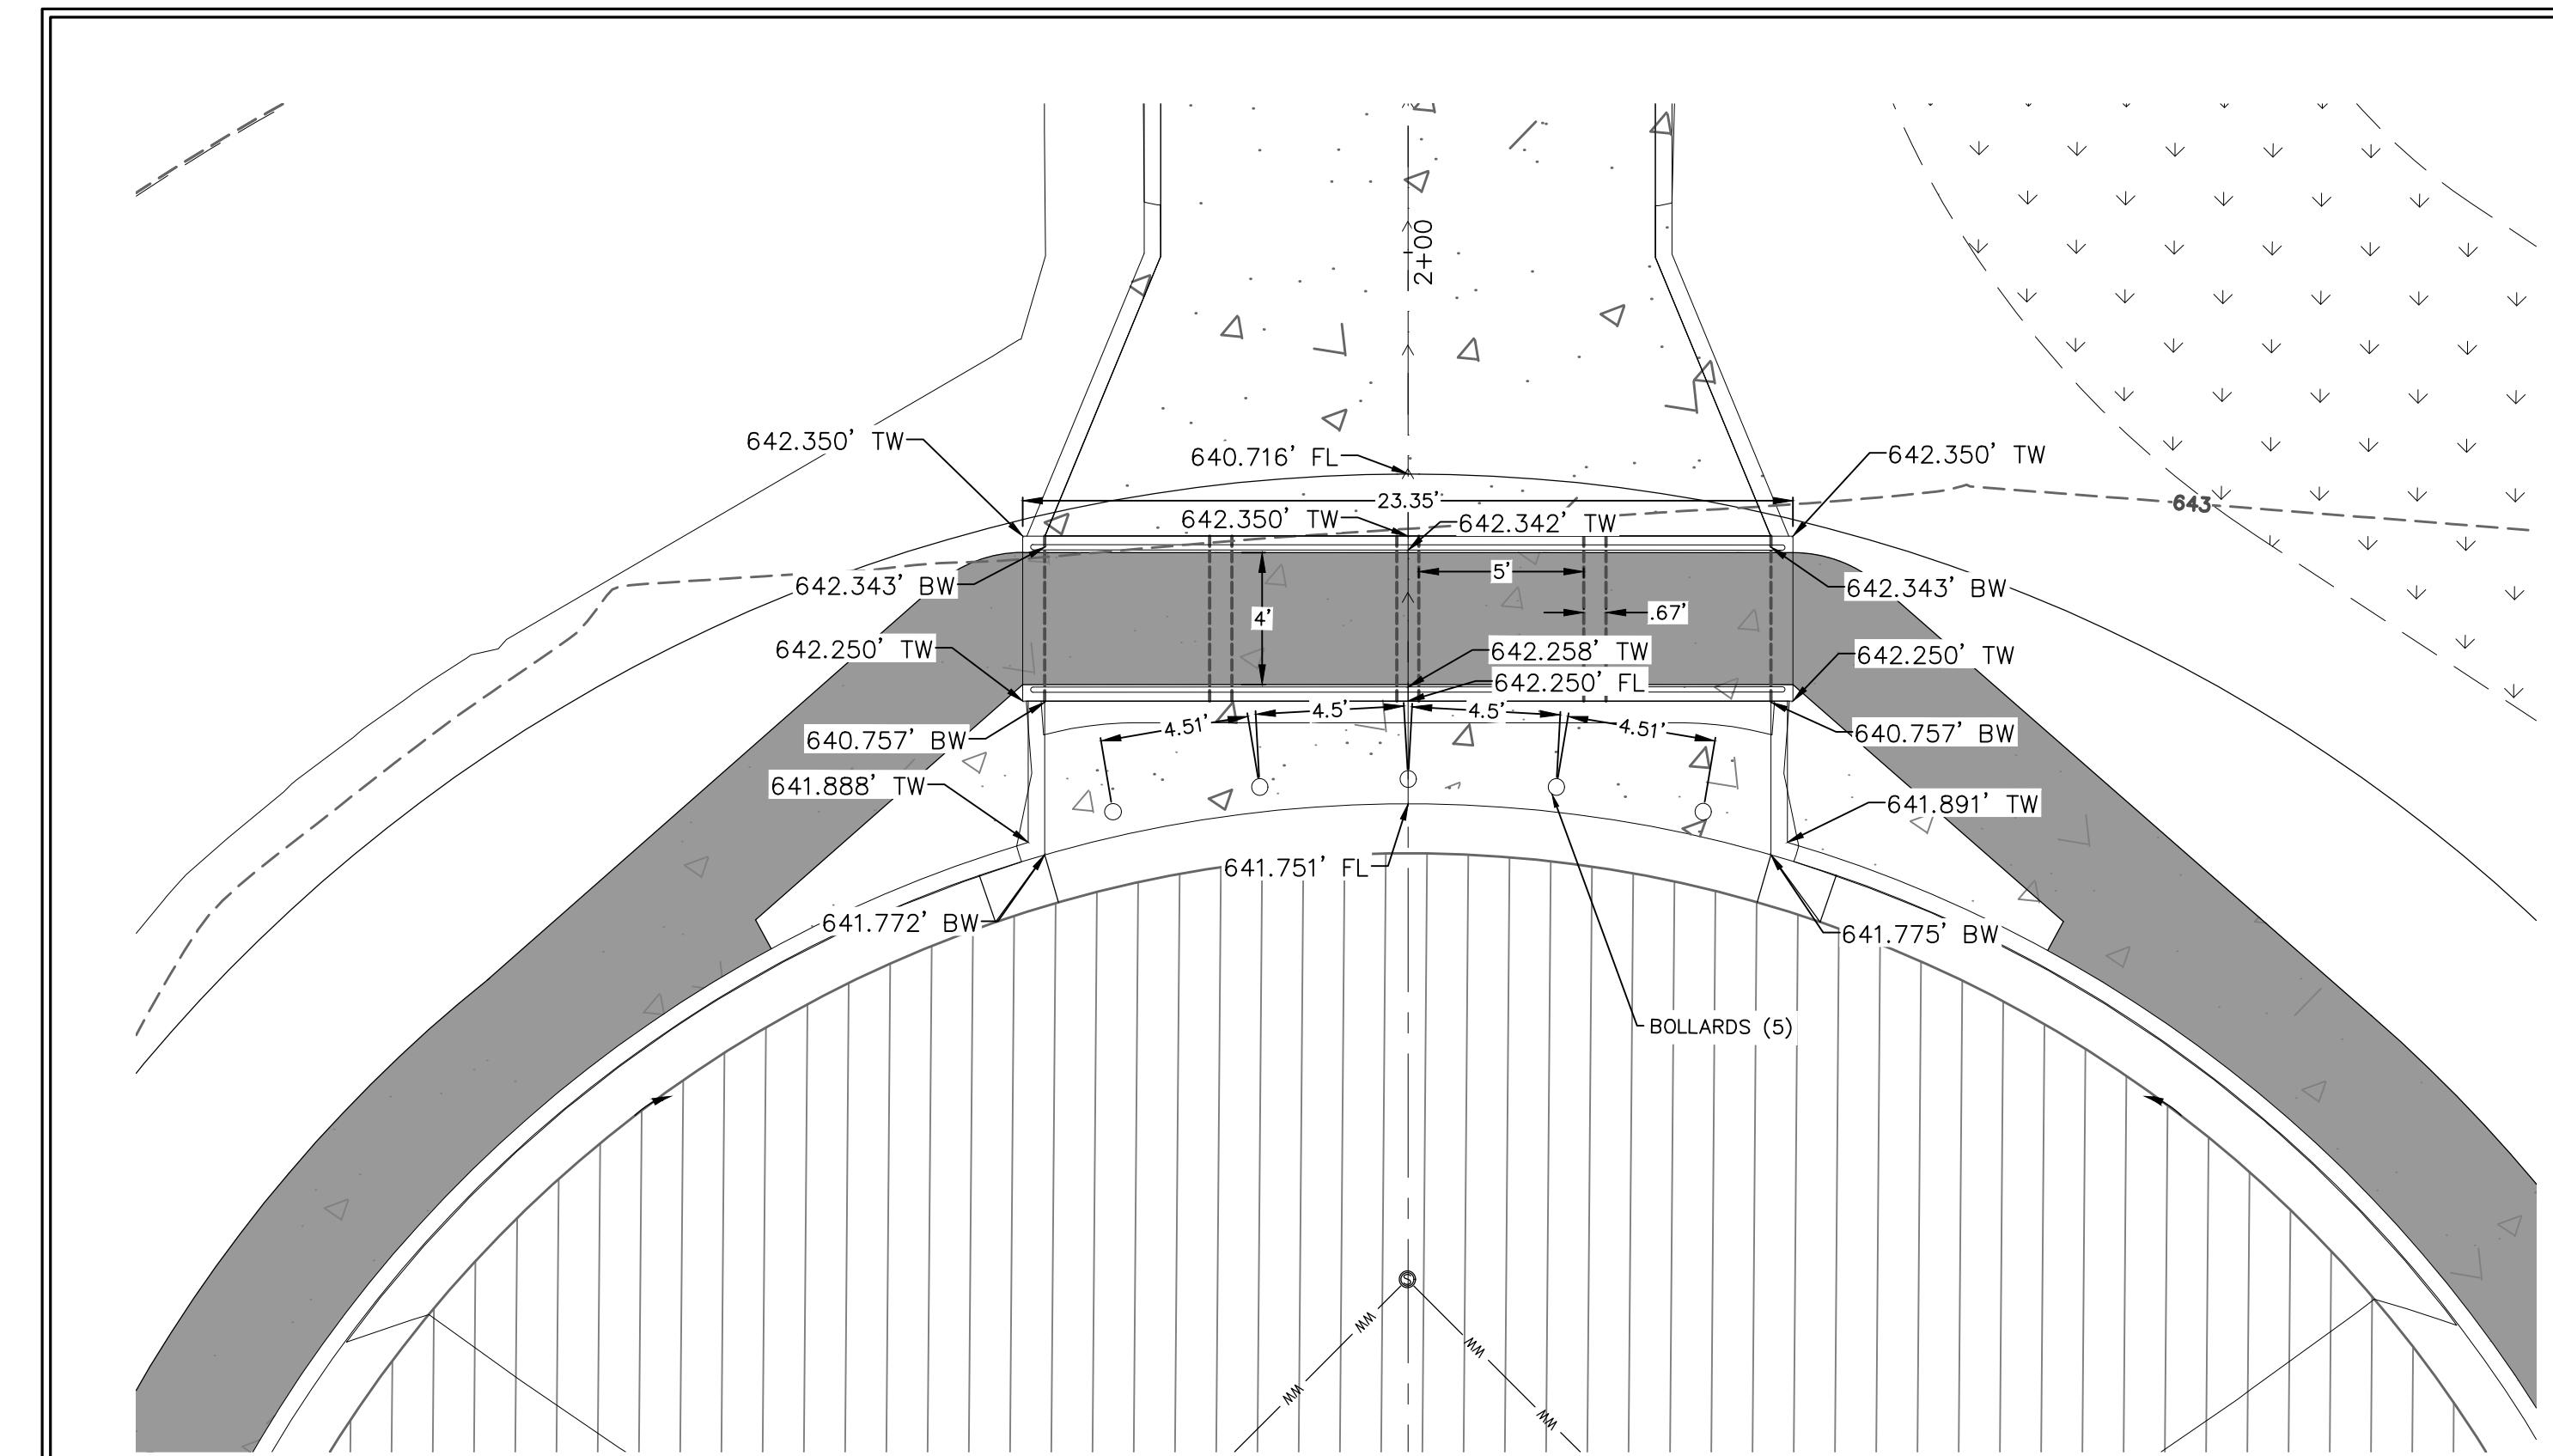


SIDEWALK BOX
SCALE : 1"=5'

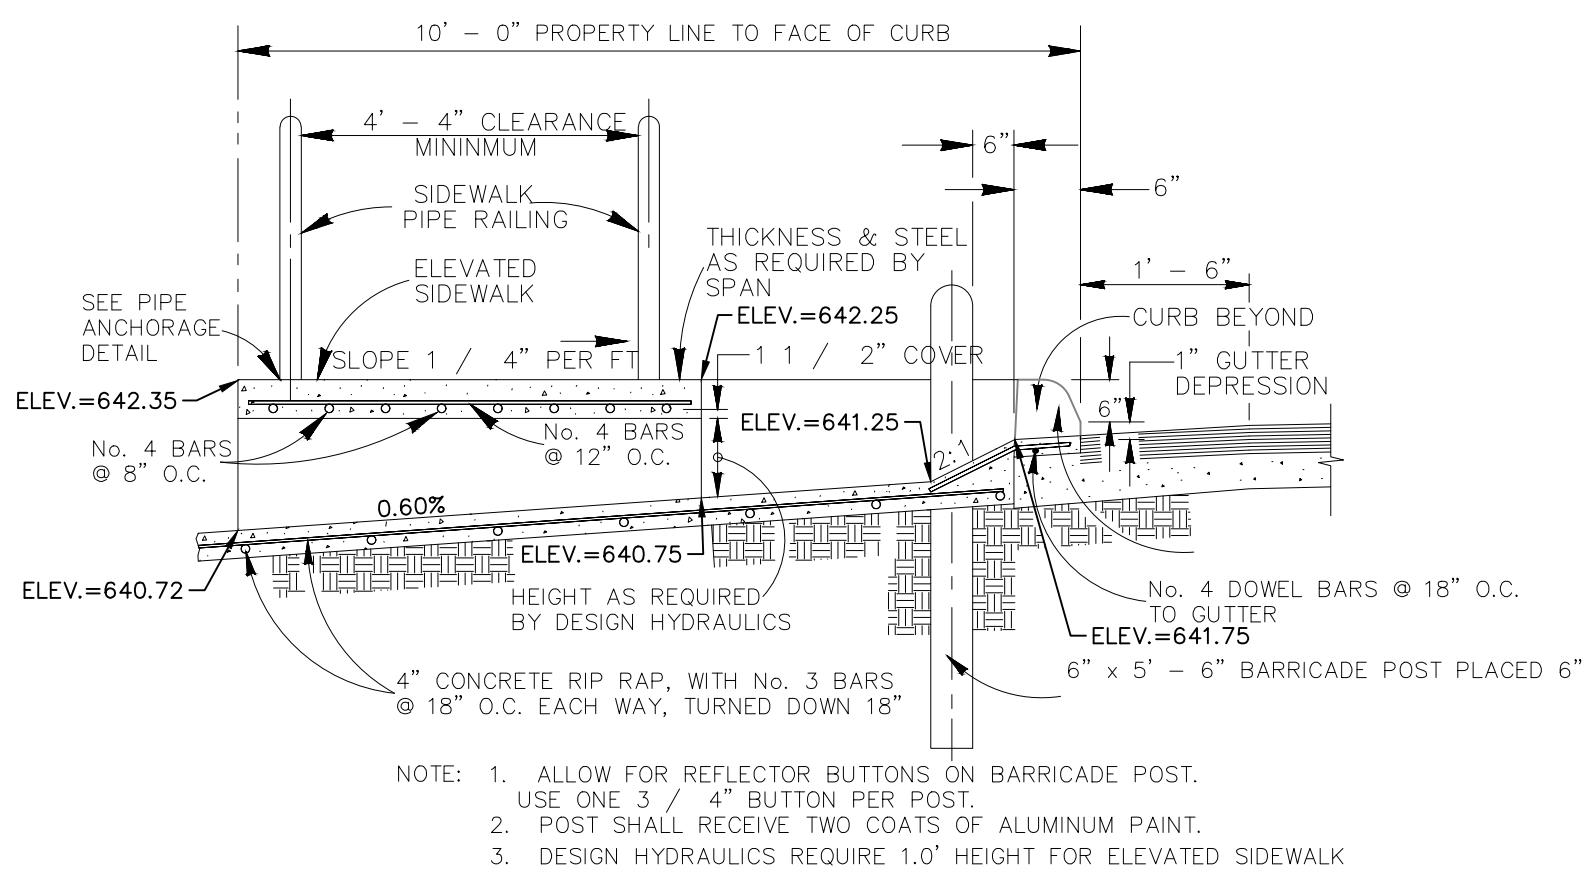


CHANNEL B – SIDEWALK & DROP CURB SECTION

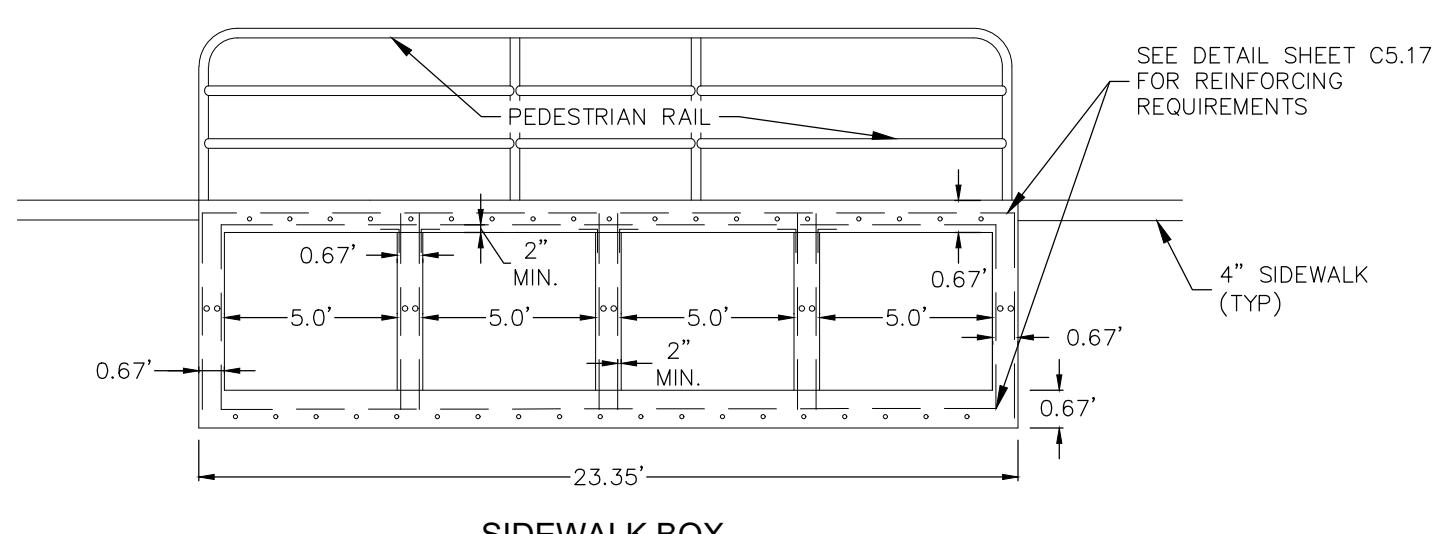


SIDEWALK BOX
N.T.S.

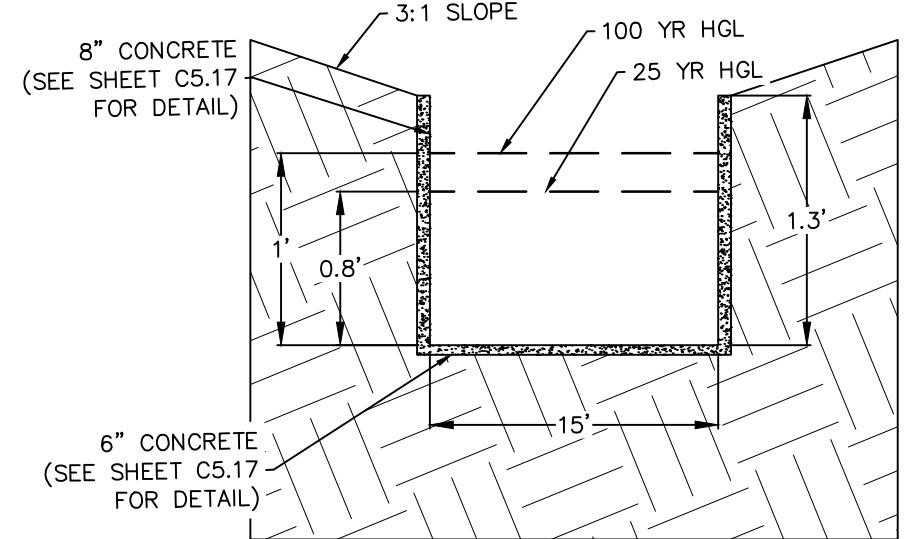

CROSS-SECTION A-A

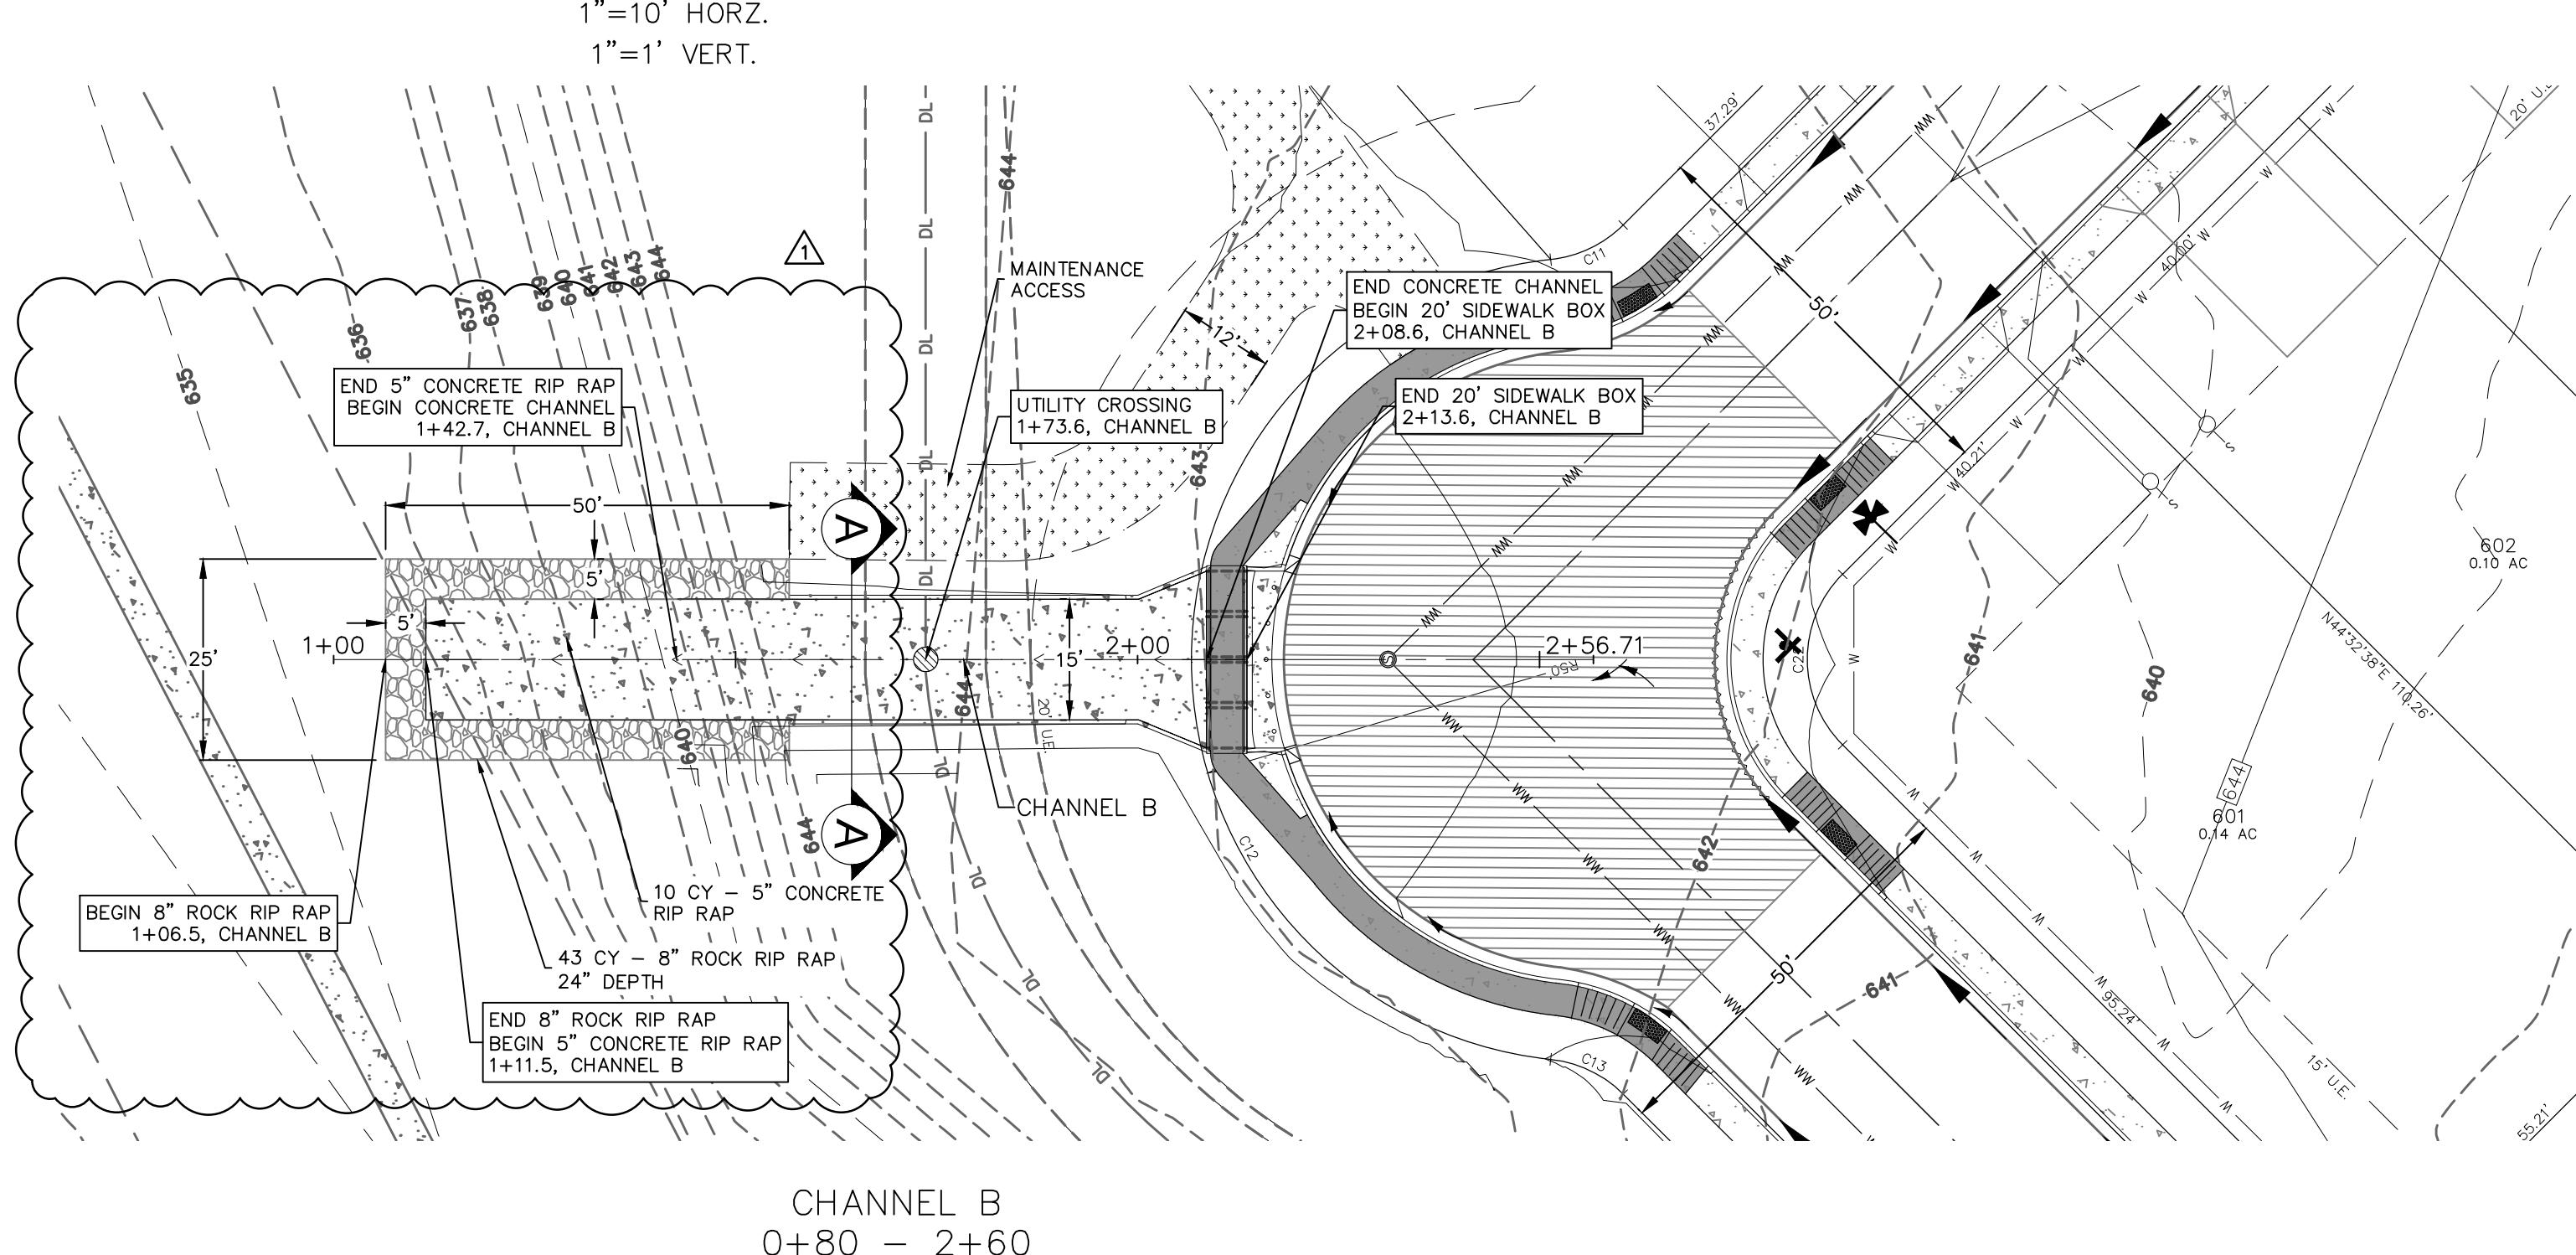

CHANNEL B
0+80 – 2+60

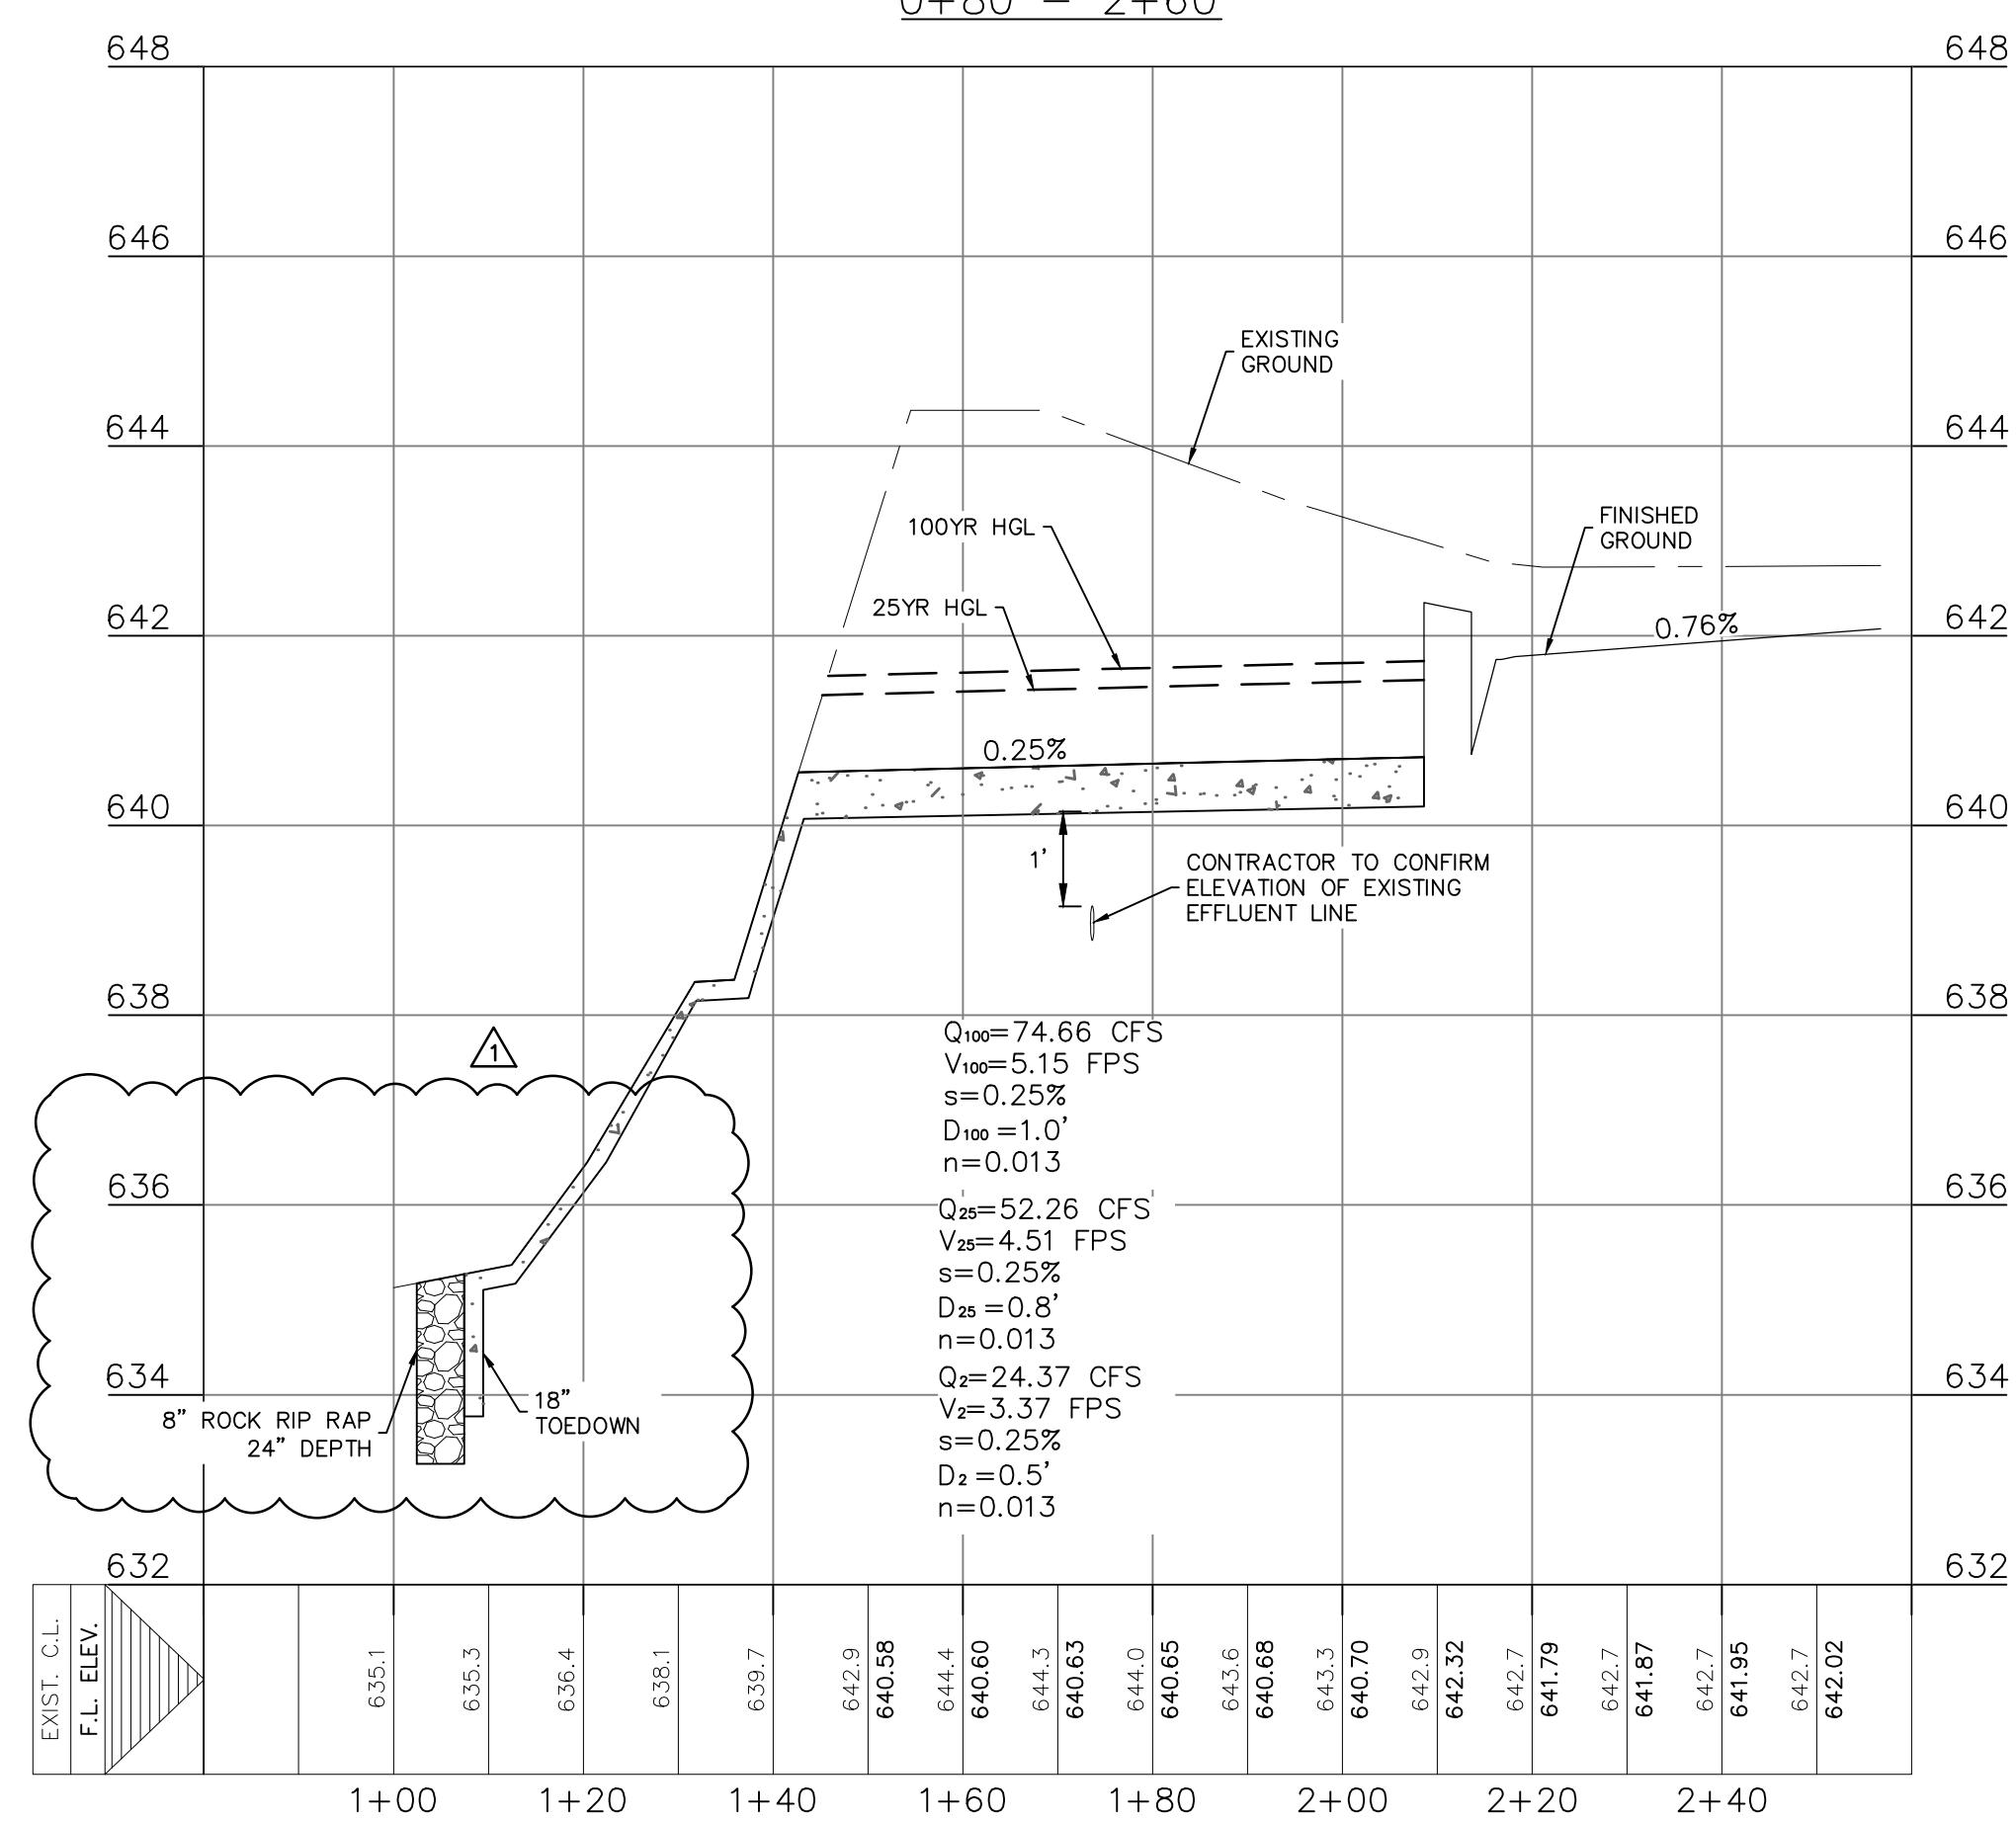

REFER TO THE COVER SHEET
FOR BENCHMARK INFORMATION.


THE LOCATION OF ALL EXISTING UNDERGROUND UTILITIES ARE SHOWN IN APPROXIMATE LOCATIONS ONLY. THE CONTRACTOR SHALL DETERMINE THE EXACT LOCATION OF ALL EXISTING UTILITIES BEFORE COMMENCING WORK. THE CONTRACTOR WILL AGREE TO BE FULLY RESPONSIBLE FOR ANY AND ALL DAMAGES WHICH MIGHT BE INCURRED BY THEIR FAILURE TO EXACTLY LOCATE AND PRESERVE ANY AND ALL UNDERGROUND UTILITIES, STRUCTURES OR FACILITIES. CONTRACTOR SHALL NOTIFY ENGINEER OF ANY DISCREPANCIES 24-HOURS PRIOR TO COMMENCING CONSTRUCTION.

LEGEND

- 700 EXISTING CONTOURS
- 700 PROPOSED CONTOURS
- B.L. BUILDING SETBACK LINE
- U.E. UTILITY EASEMENT
- D.E. DRAINAGE EASEMENT
- M.B.C. MULTIPLE BOX CULVERT
- PROPOSED STORM DRAIN LINE
- EXISTING STORM DRAIN LINE
- UTILITY CROSSING

290 S. CASTELL AVE., STE. 100
NEW BRAUNFELS, TX 78130
TBPELS FIRM F-105061
TBPELS FIRM 1053600

HMT
ENGINEERING & SURVEYING

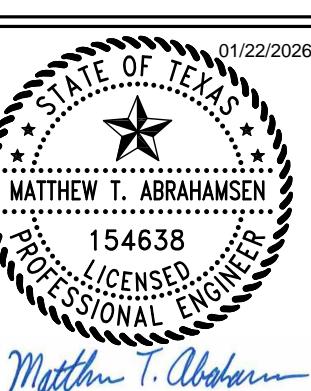


CHANNEL B
PLAN & PROFILE





KYNDWOOD SUBDIVISION, UNIT 5
NEW BRAUNFELS, TEXAS

| NO. | REVISION DESCRIPTION | REVISION DATE |
|-----|---------------------------------------|---------------|
| | UPDATED EROSION CONTROL FOR CHANNEL B | 1/22/2026 |

DATE: JANUARY 2026
DRAWN BY: MK
DESIGNED BY: MA
REVIEWED BY: MA
HMT PROJECT NO.: 337.081

SHEET
C5.08

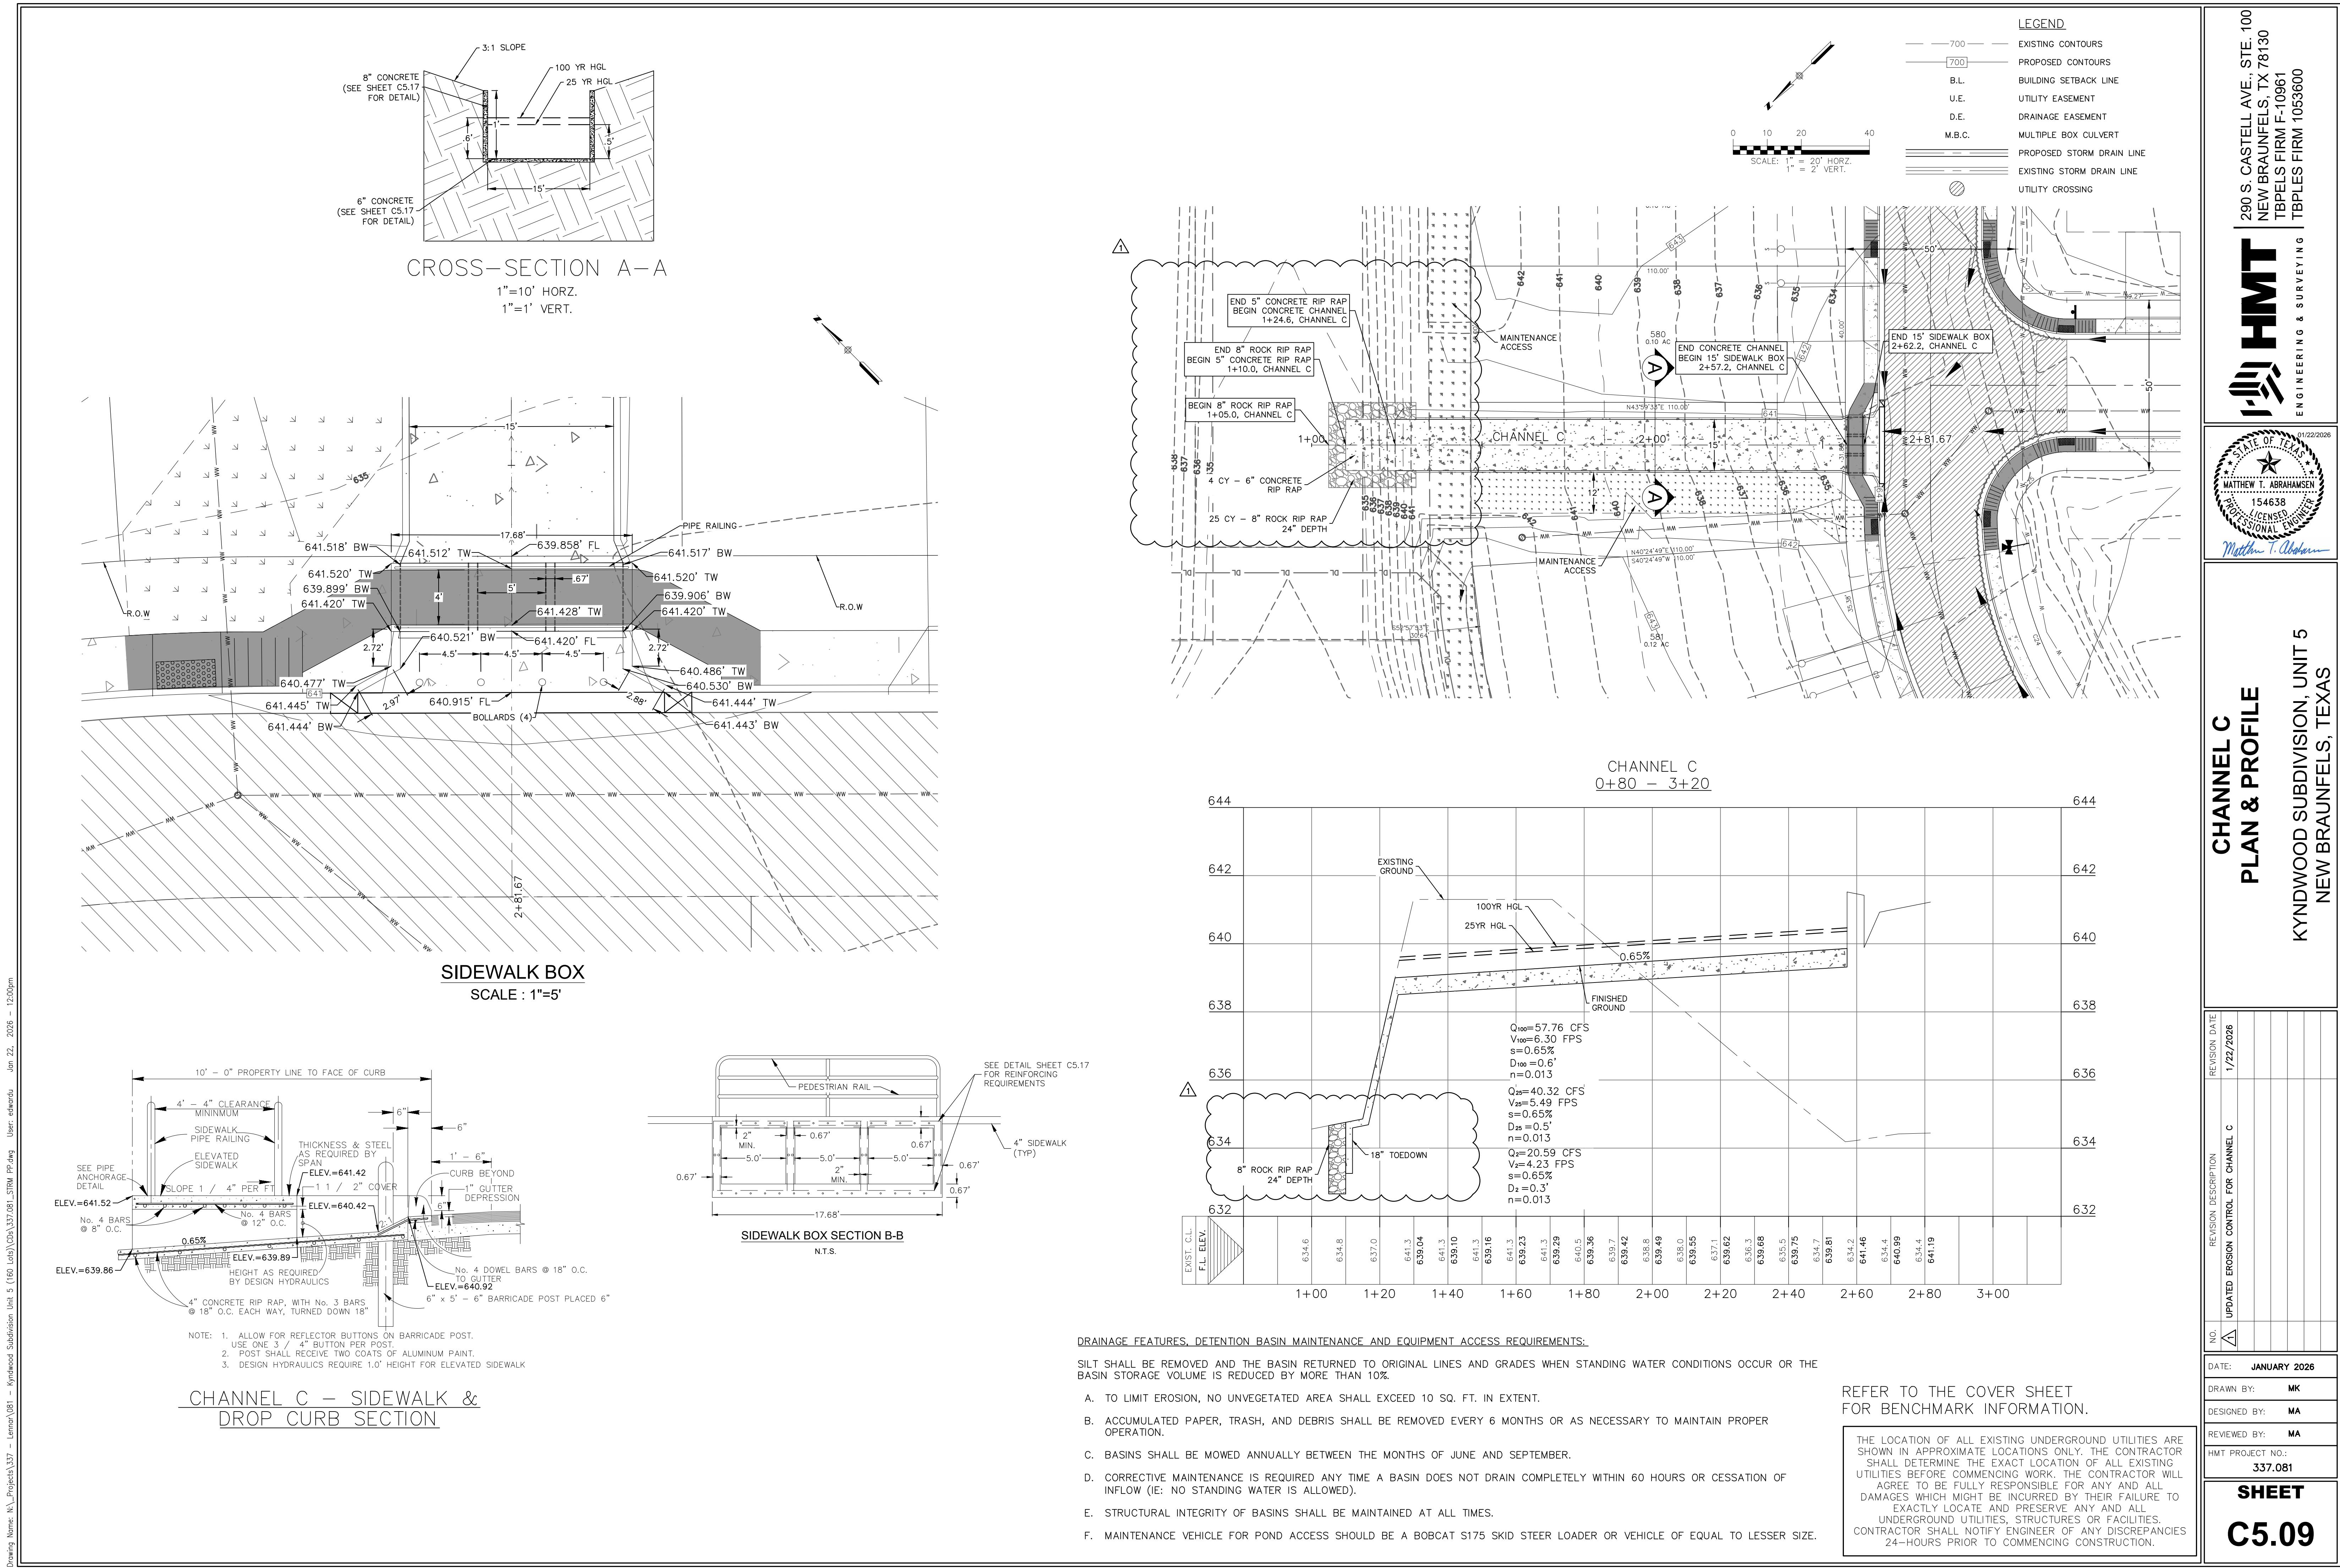

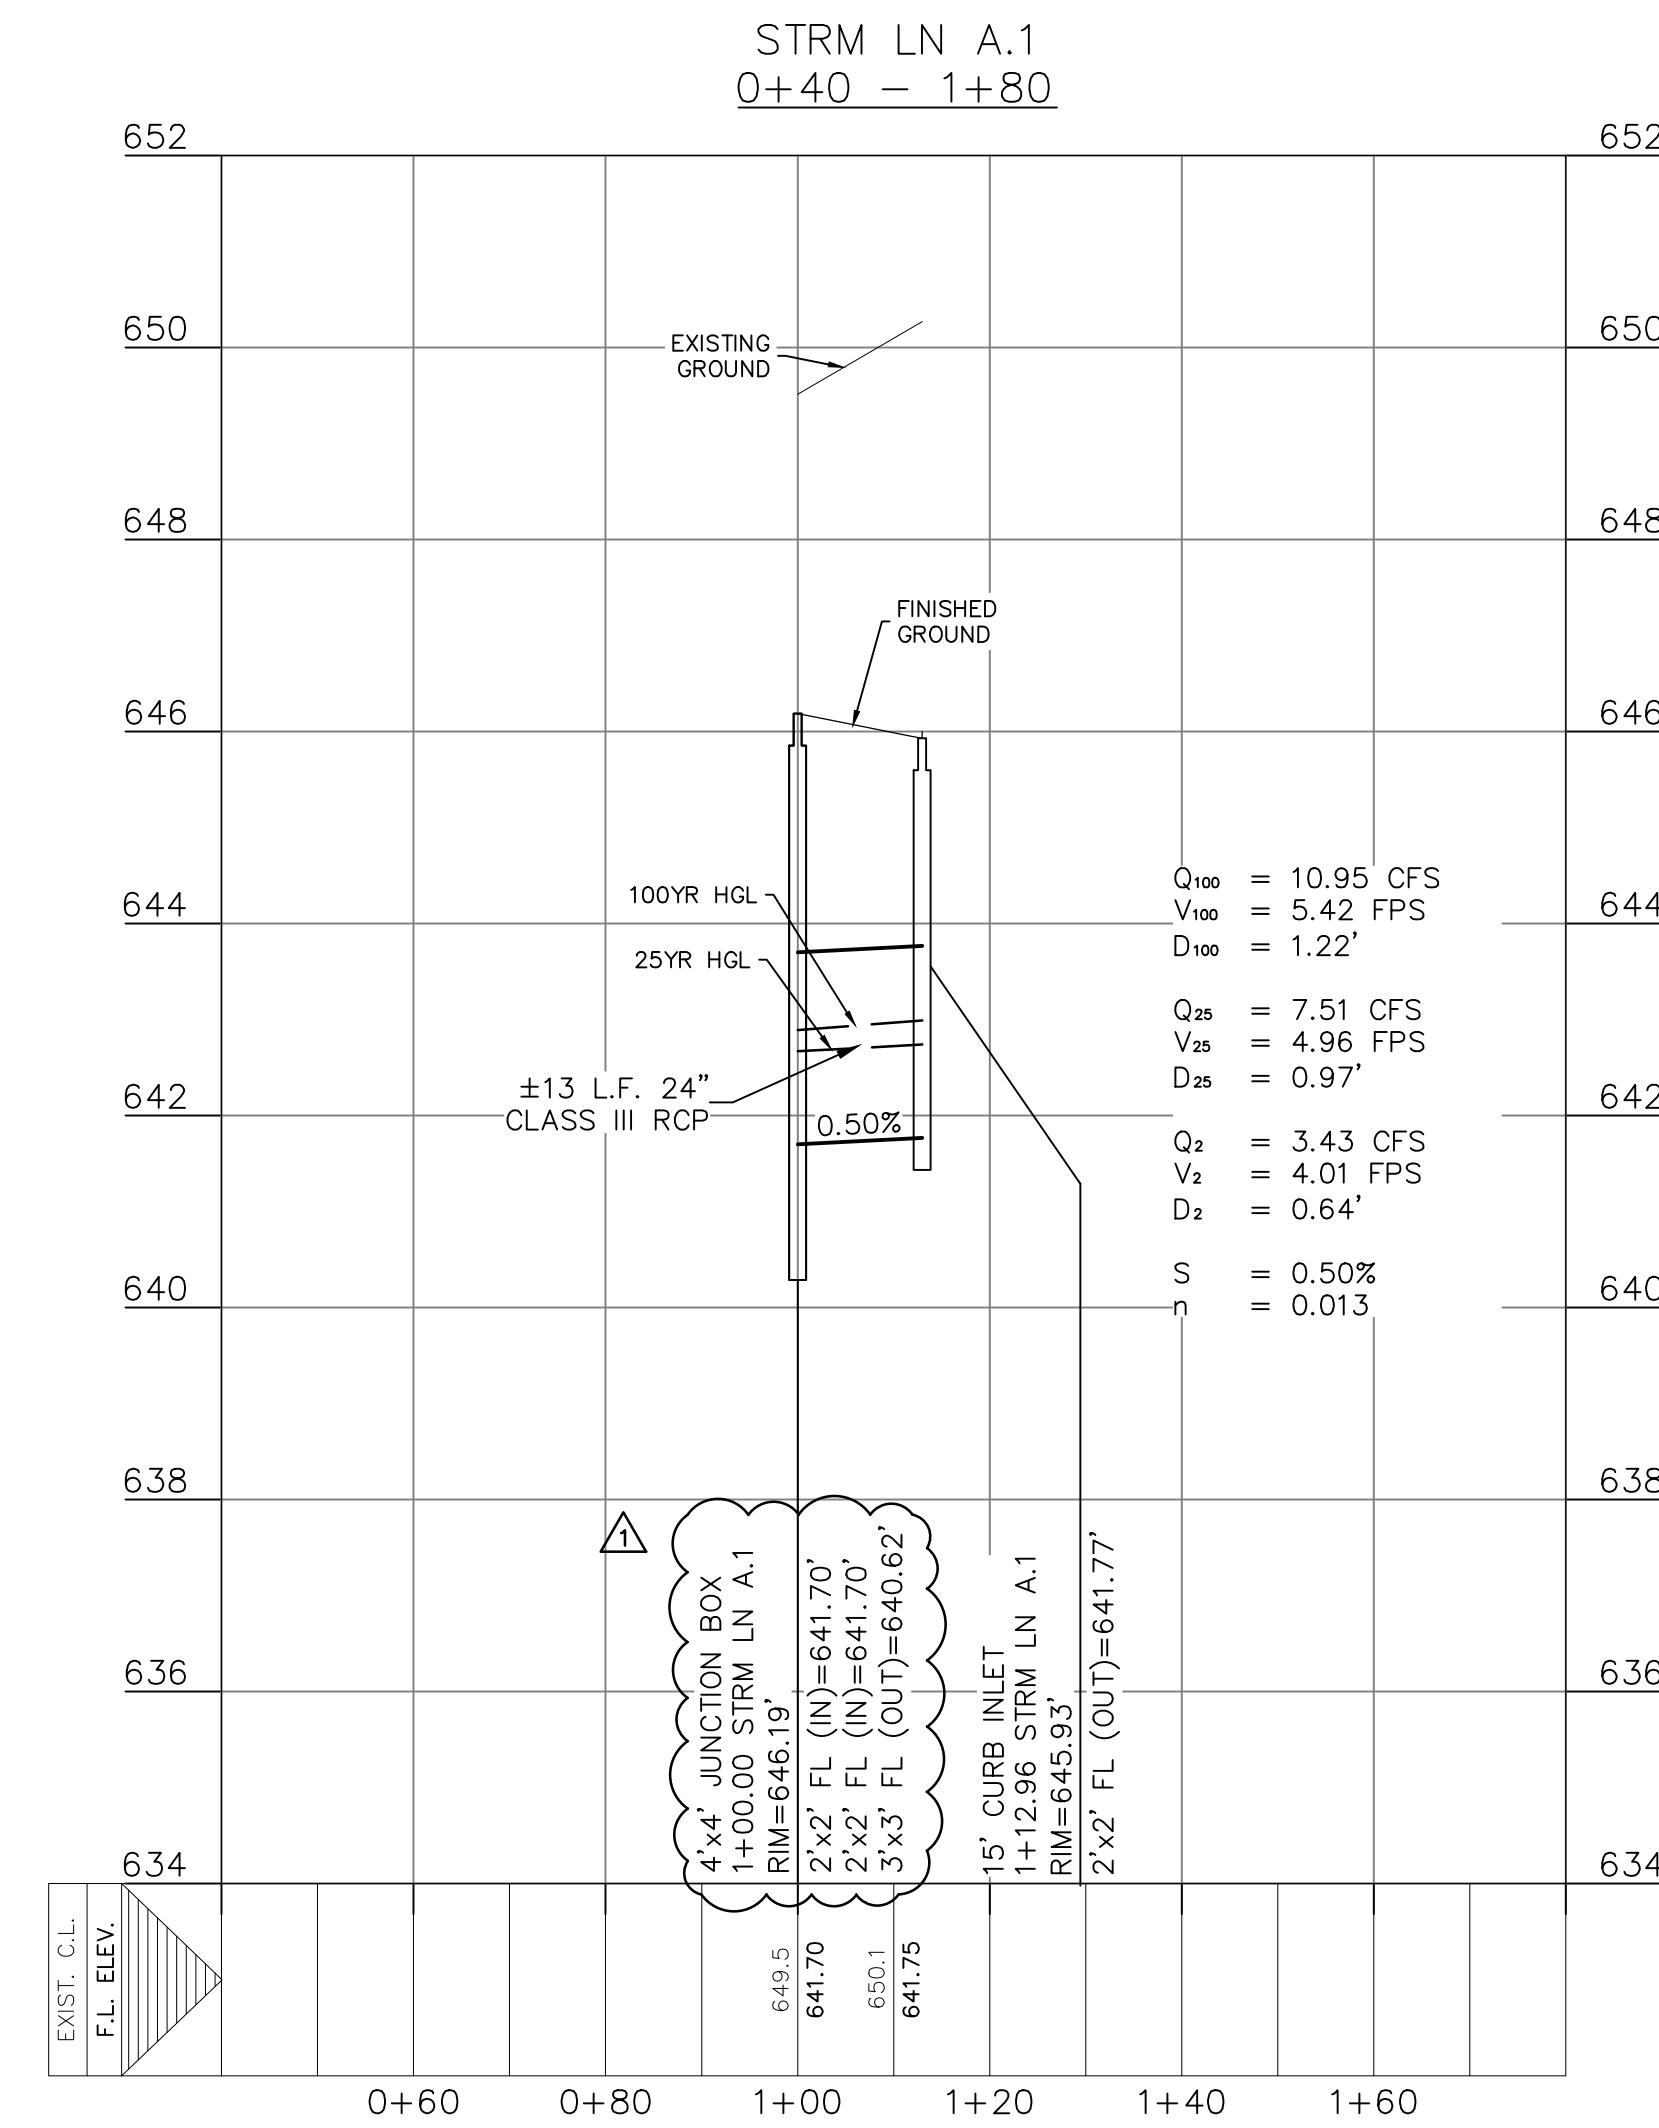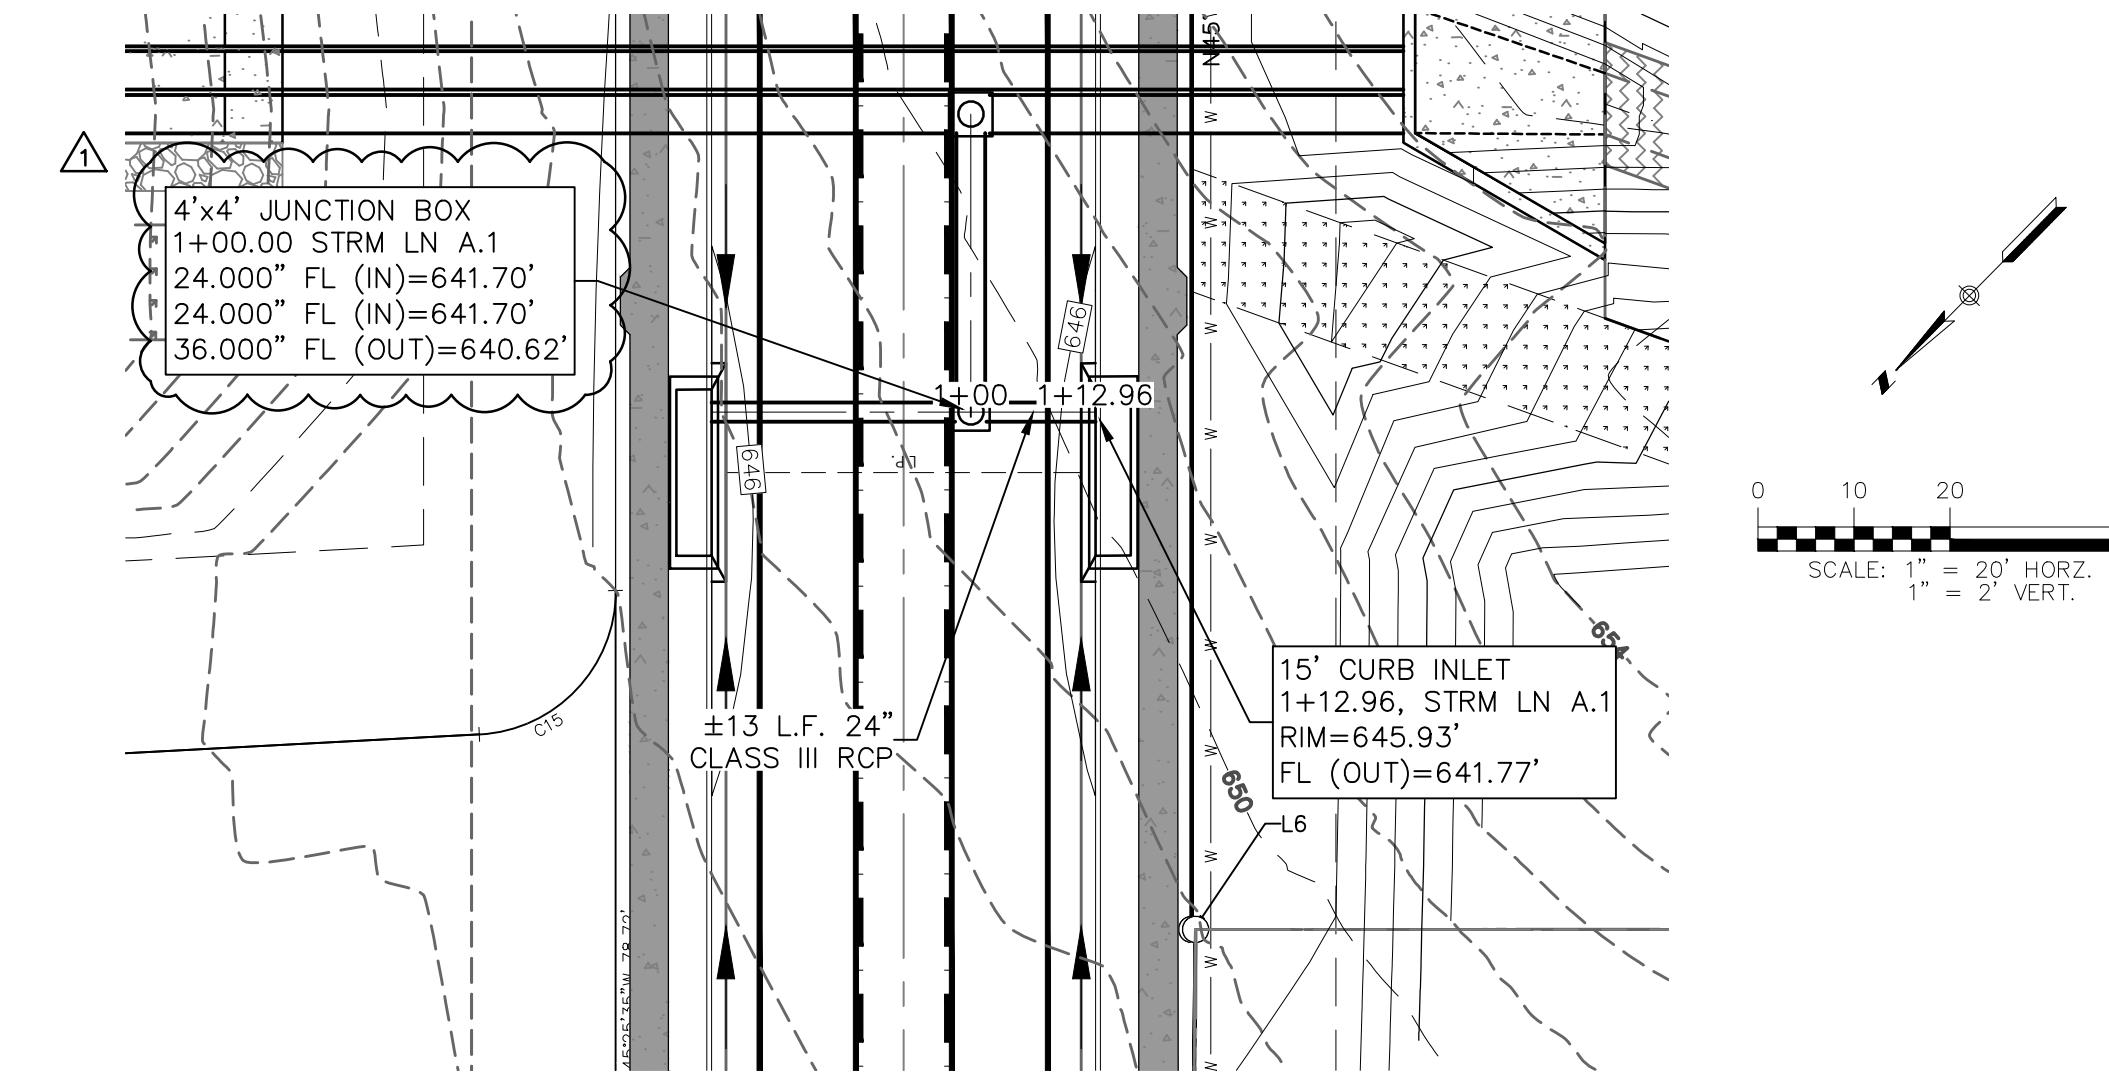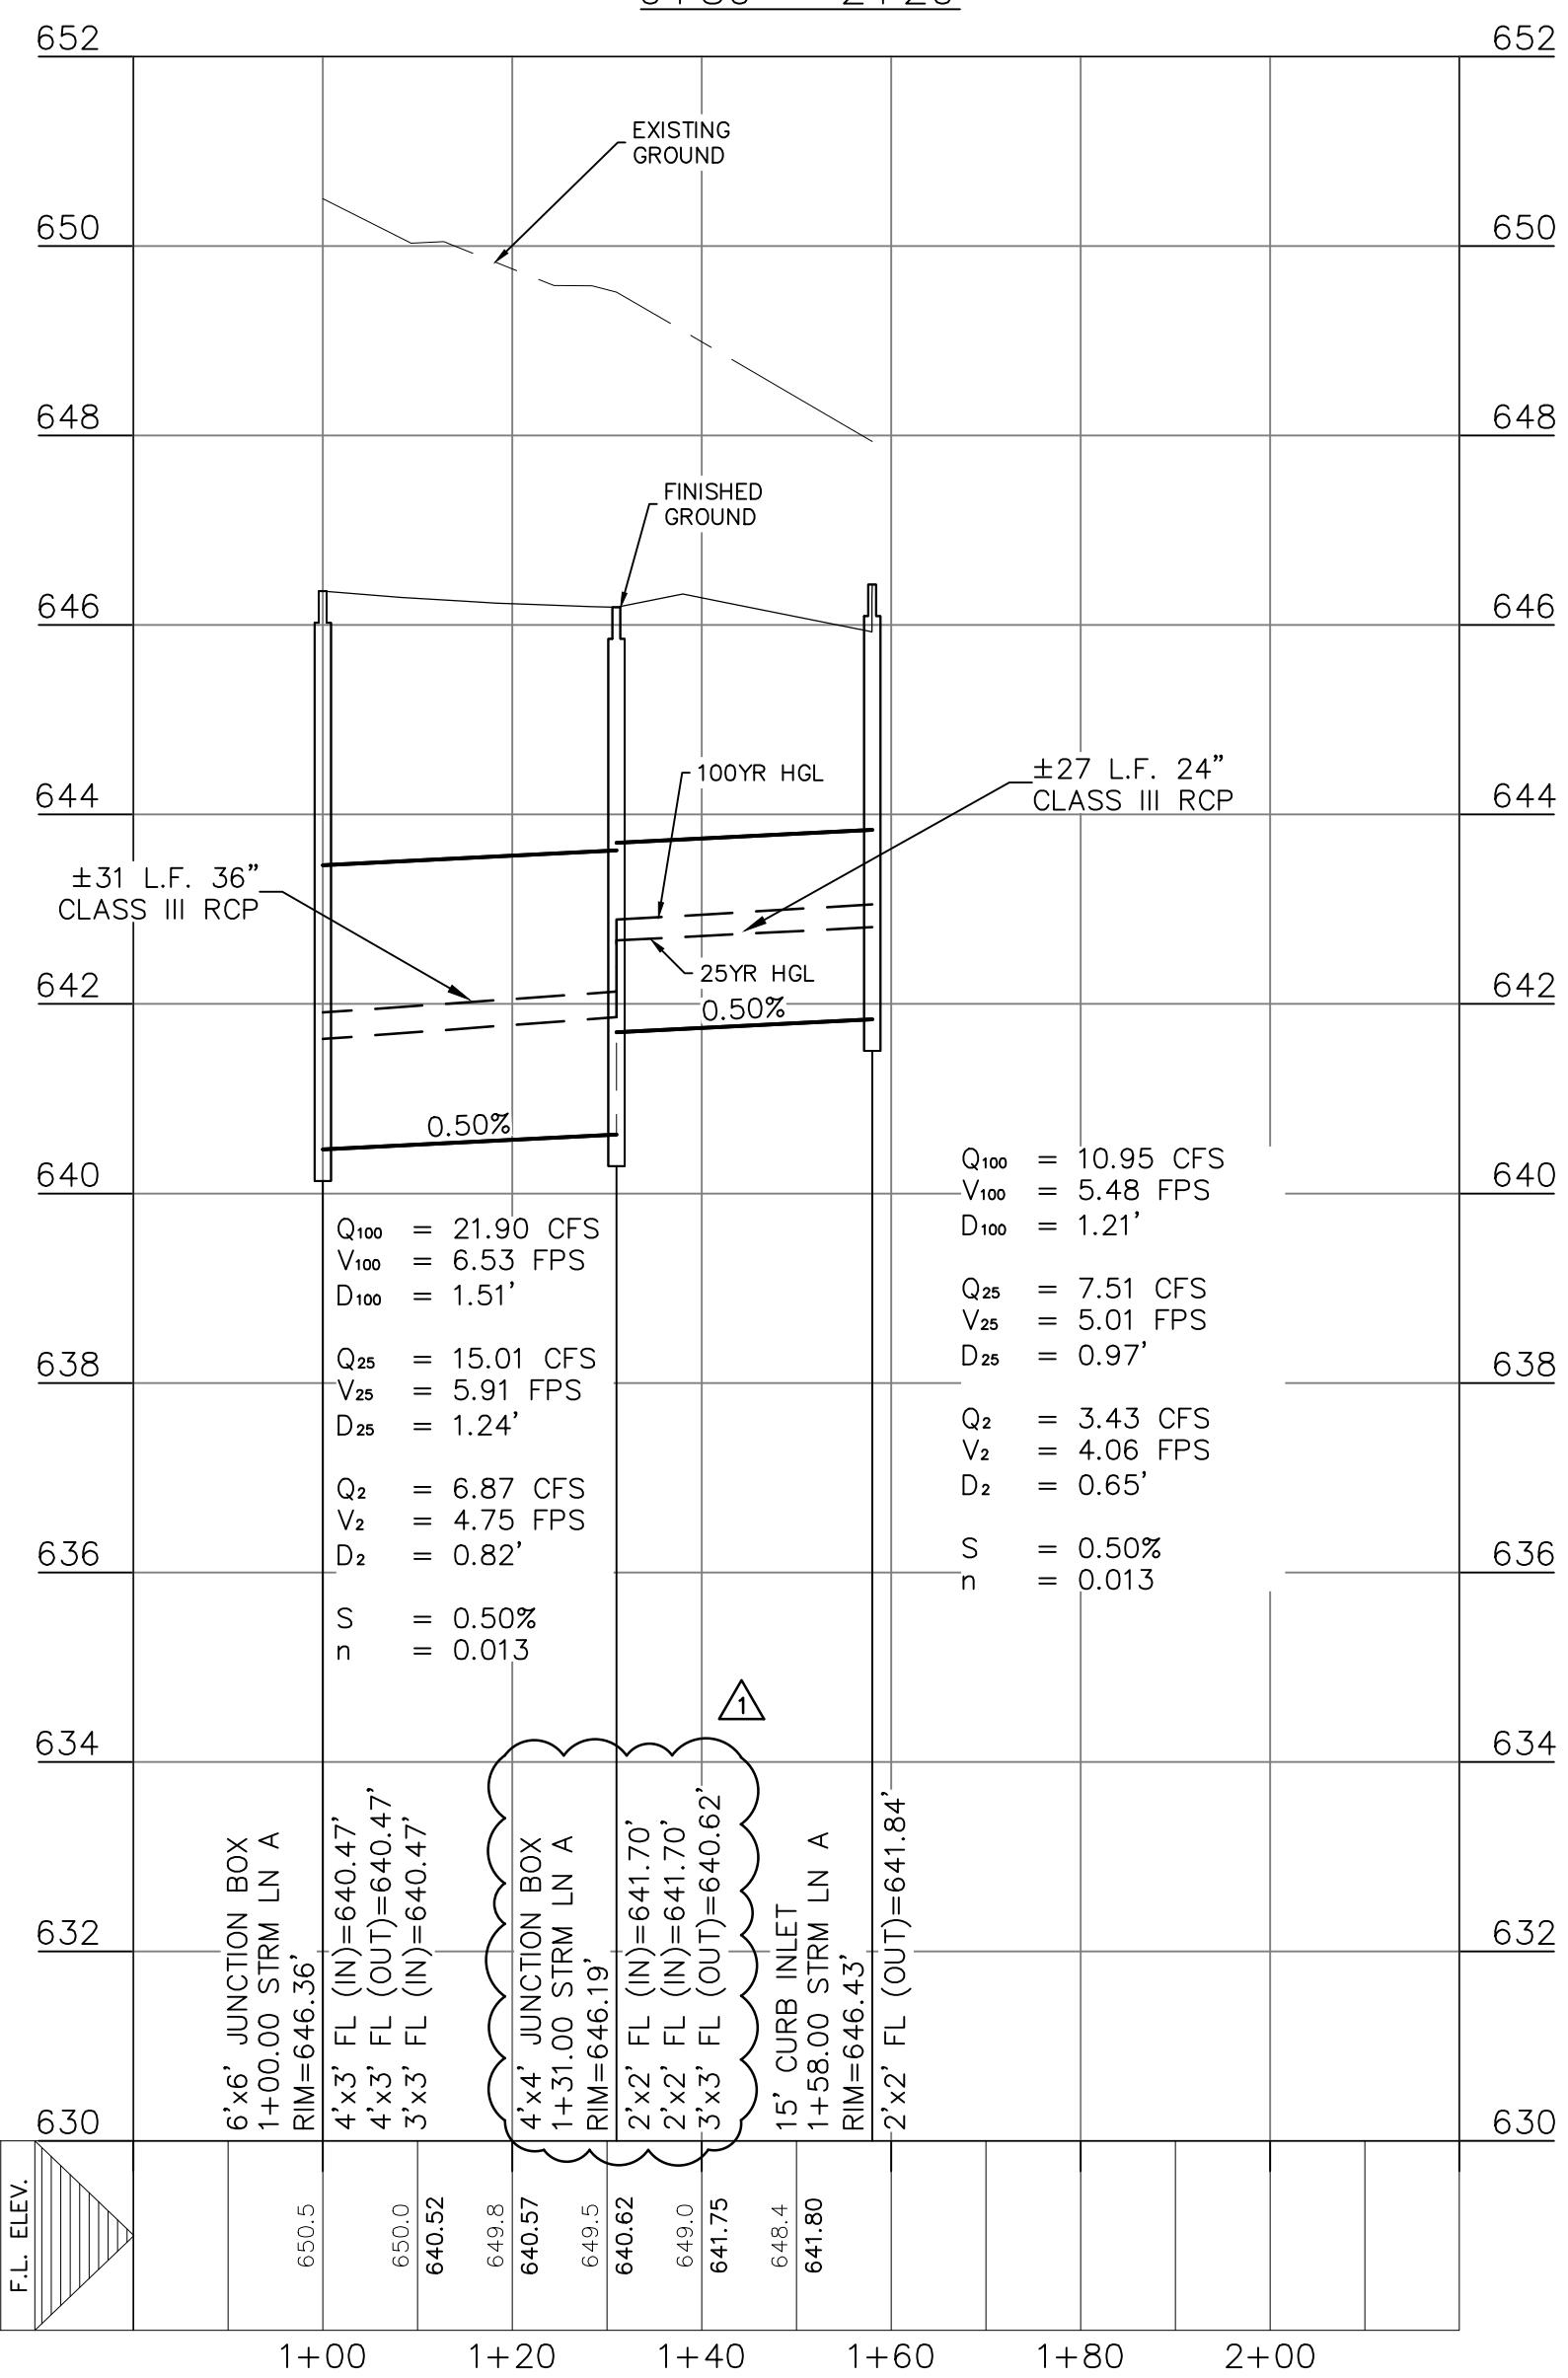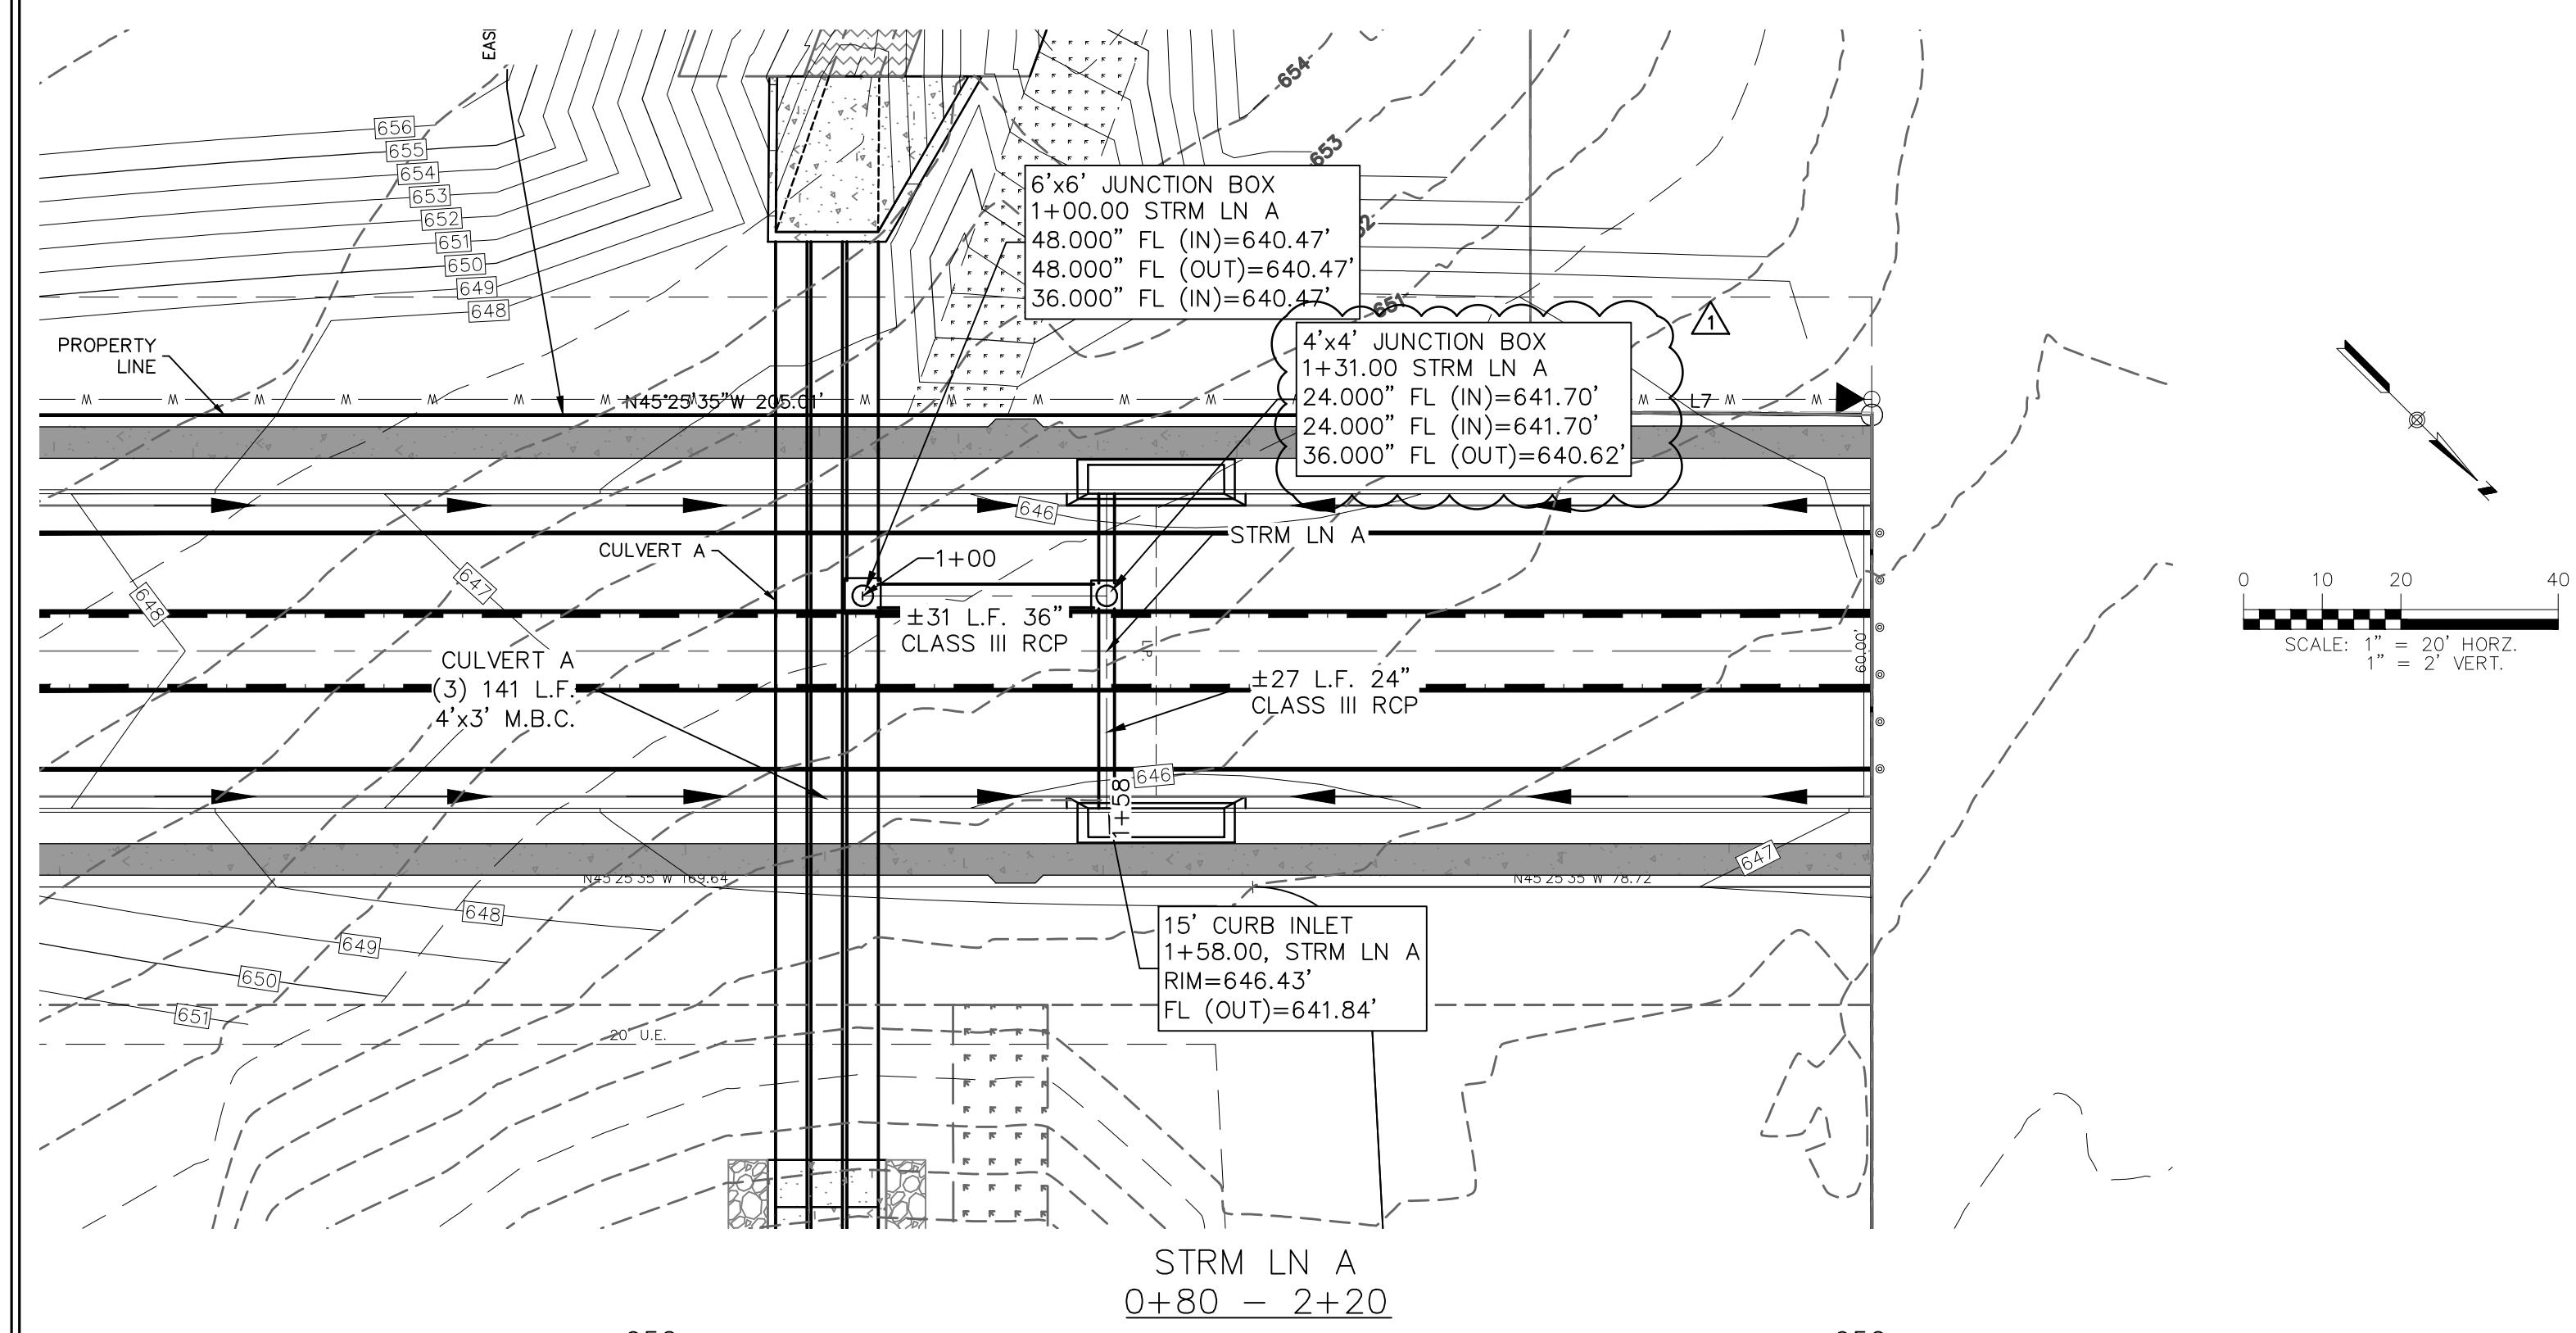


DRAINAGE FEATURES, DETENTION BASIN MAINTENANCE AND EQUIPMENT ACCESS REQUIREMENTS:

SILT SHALL BE REMOVED AND THE BASIN RETURNED TO ORIGINAL LINES AND GRADES WHEN STANDING WATER CONDITIONS OCCUR OR THE BASIN STORAGE VOLUME IS REDUCED BY MORE THAN 10%.

- A. TO LIMIT EROSION, NO UNVEGETATED AREA SHALL EXCEED 10 SQ. FT. IN EXTENT.
- B. ACCUMULATED PAPER, TRASH, AND DEBRIS SHALL BE REMOVED EVERY 6 MONTHS OR AS NECESSARY TO MAINTAIN PROPER OPERATION.
- C. BASINS SHALL BE MOWED ANNUALLY BETWEEN THE MONTHS OF JUNE AND SEPTEMBER.
- D. CORRECTIVE MAINTENANCE IS REQUIRED ANY TIME A BASIN DOES NOT DRAIN COMPLETELY WITHIN 60 HOURS OR CESSION OF INFLOW (IE: NO STANDING WATER IS ALLOWED).
- E. STRUCTURAL INTEGRITY OF BASINS SHALL BE MAINTAINED AT ALL TIMES.
- F. MAINTENANCE VEHICLE FOR POND ACCESS SHOULD BE A BOBCAT S175 SKID STEER LOADER OR VEHICLE OF EQUAL TO LESSER SIZE

REFER TO THE COVER SHEET
FOR BENCHMARK INFORMATION.

THE LOCATION OF ALL EXISTING UNDERGROUND UTILITIES ARE SHOWN IN APPROXIMATE LOCATIONS ONLY. THE CONTRACTOR SHALL DETERMINE THE EXACT LOCATION OF ALL EXISTING UTILITIES BEFORE COMMENCING WORK. THE CONTRACTOR WILL AGREE TO BE FULLY RESPONSIBLE FOR ANY AND ALL DAMAGES WHICH MIGHT BE INCURRED BY THEIR FAILURE TO EXACTLY LOCATE AND PRESERVE ANY AND ALL UNDERGROUND UTILITIES, STRUCTURES OR FACILITIES. CONTRACTOR SHALL NOTIFY ENGINEER OF ANY DISCREPANCIES 24-HOURS PRIOR TO COMMENCING CONSTRUCTION.

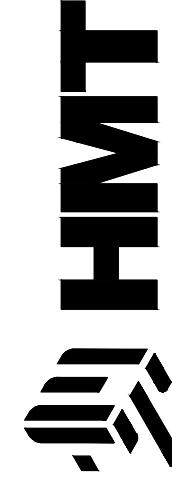

A circular watermark featuring the Texas state seal. The outer ring contains the words "THE STATE OF TEXAS" in a circular pattern. The inner circle contains a five-pointed star in the center, with the number "154638" to its left. The bottom half of the inner circle contains the words "LICENSED PROFESSIONAL ENGINEER". The entire seal is rendered in a light gray or watermark-like style.

STORM LINE A PLAN & PROFILE

KYNDWOOD SUBDIVISION, UNIT 5
NEW BRAUNFELS, TEXAS

| NO. | REVISION DESCRIPTION | REVISION DATE |
|-----|----------------------|---------------|
| 1 | UPDATED JUNCTION BOX | 1/22/2026 |
| | | |
| | | |
| | | |
| | | |
| | | |
| | | |

DATE: **JANUARY 2026**

DRAWN BY: **MK**

DESIGNED BY: **MA**

REVIEWED BY: **MA**



HMT PROJECT NO.:
337.081

SHEET

C5.10

SHEET

C5.10

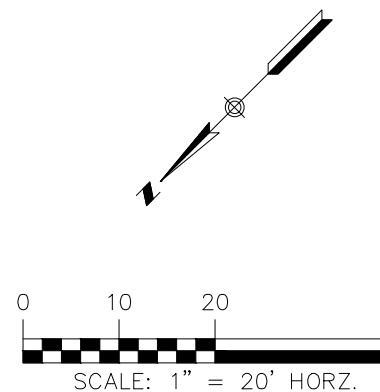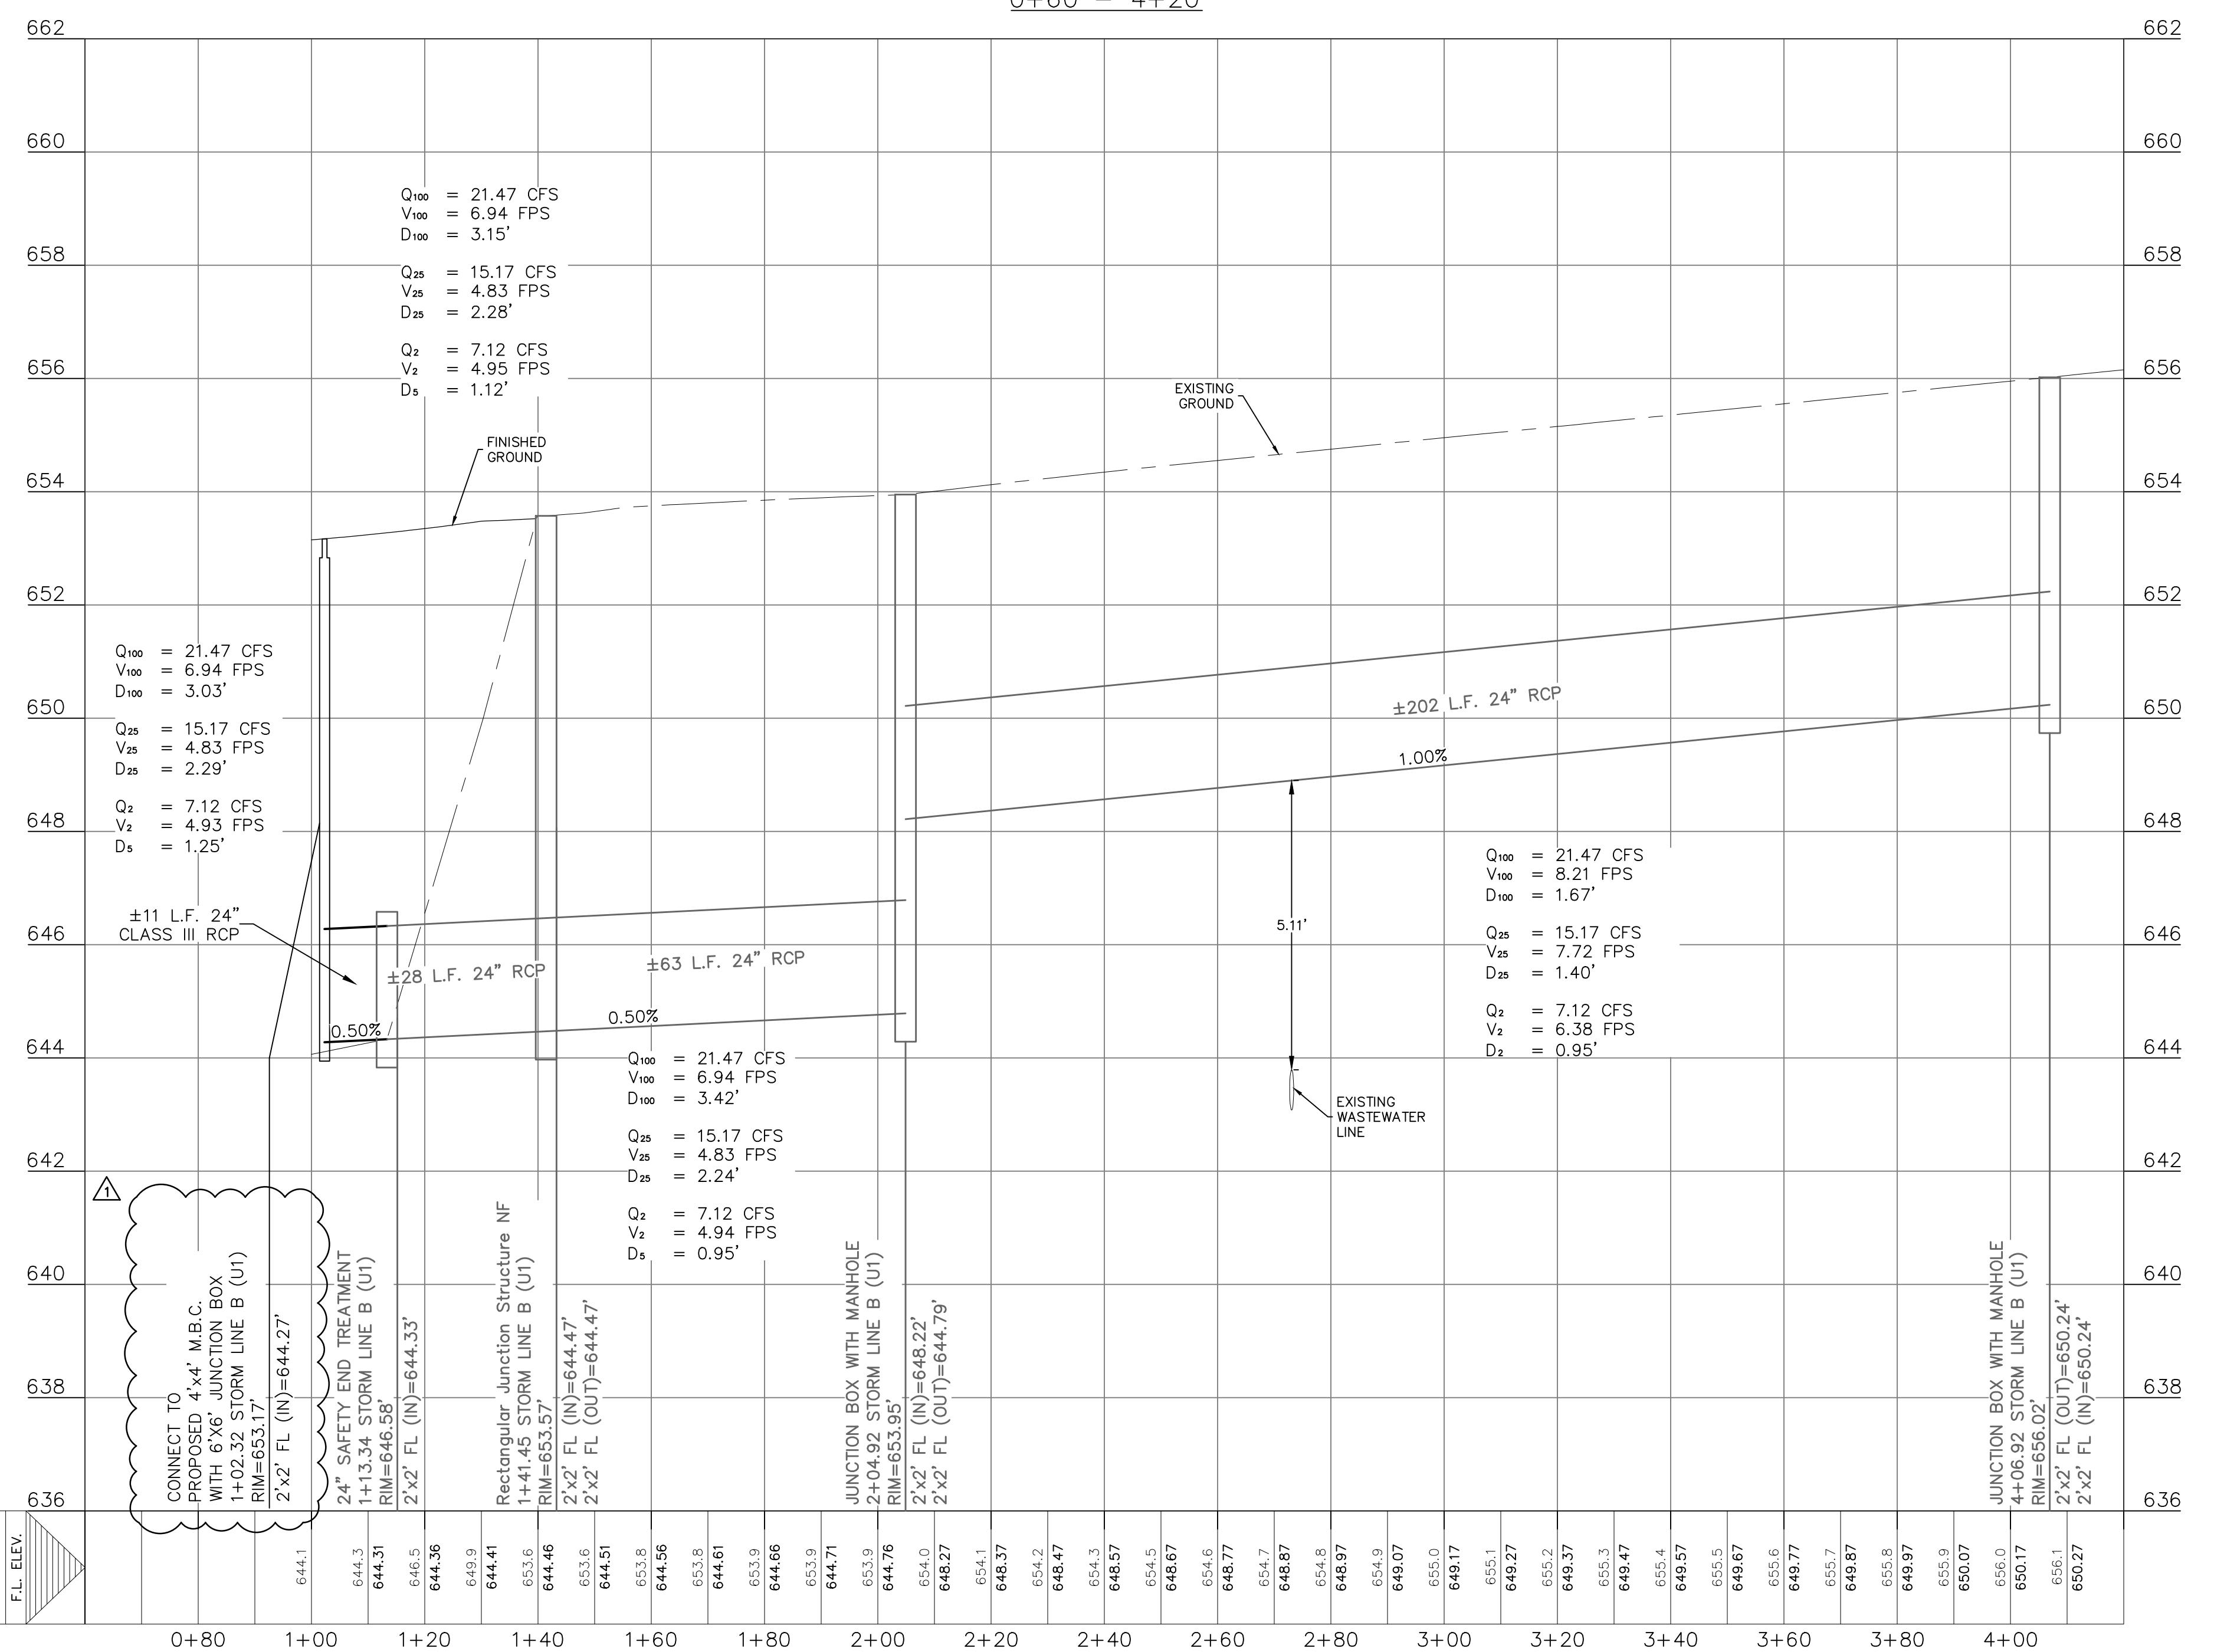

LEGEND

- 700 EXISTING CONTOURS
- 700 PROPOSED CONTOURS
- B.L. BUILDING SETBACK LINE
- U.E. UTILITY EASEMENT
- D.E. DRAINAGE EASEMENT
- M.B.C. MULTIPLE BOX CULVERT
- PROPOSED STORM DRAIN LINE
- EXISTING STORM DRAIN LINE
- UTILITY CROSSING

DRAINAGE FEATURES, DETENTION BASIN MAINTENANCE AND EQUIPMENT ACCESS REQUIREMENTS

SILT SHALL BE REMOVED AND THE BASIN RETURNED TO ORIGINAL LINES AND GRADES WHEN STANDING WATER CONDITIONS OCCUR OR THE BASIN STORAGE VOLUME IS REDUCED BY MORE THAN 10%.

- TO LIMIT EROSION, NO UNVEGETATED AREA SHALL EXCEED 10 SQ. FT. IN EXTENT.
- ACCUMULATED PAPER, TRASH, AND DEBRIS SHALL BE REMOVED EVERY 6 MONTHS OR AS NECESSARY TO MAINTAIN PROPER OPERATION.
- BASINS SHALL BE MOVED ANNUALLY BETWEEN THE MONTHS OF JUNE AND SEPTEMBER.
- CORRECTIVE MAINTENANCE IS REQUIRED ANY TIME A BASIN DOES NOT DRAIN COMPLETELY WITHIN 60 HOURS OR CESSION OF INFLOW (IE: NO STANDING WATER IS ALLOWED).
- STRUCTURAL INTEGRITY OF BASINS SHALL BE MAINTAINED AT ALL TIMES.
- MAINTENANCE VEHICLE FOR POND ACCESS SHOULD BE A BOBCAT S175 SKID STEER LOADER OR VEHICLE OF EQUAL TO LESSER SIZE.

UNIT 1 STORM LINE EXTENSION PLAN & PROFILE

KYNDWOOD SUBDIVISION, UNIT 5
NEW BRAUNFELS, TEXAS


| NO. | REVISION | DESCRIPTION | REVISION DATE |
|------------------|--------------|-------------|---------------|
| | | | 1/22/2026 |
| DATE: | JANUARY 2026 | | |
| DRAWN BY: | MA | | |
| DESIGNED BY: | MA | | |
| REVIEWED BY: | MA | | |
| HMT PROJECT NO.: | 337.081 | | |
| SHEET | C5.11 | | |

290 S. CASTELL AVE., STE. 100
NEW BRAUNFELS, TX 78130
TBPELS FIRM F-105961
TBPELS FIRM 1053600



HMT
ENGINEERING & SURVEYING
01/22/2026
MATTHEW T. ABRAHAMSEN
154638
LICENSED PROFESSIONAL ENGINEER
Matthew T. Abraham

REFER TO THE COVER SHEET FOR BENCHMARK INFORMATION.


THE LOCATION OF ALL EXISTING UNDERGROUND UTILITIES ARE SHOWN IN APPROXIMATE LOCATIONS ONLY. THE CONTRACTOR SHALL DETERMINE THE EXACT LOCATION OF ALL EXISTING UTILITIES BEFORE COMMENCING WORK. THE CONTRACTOR WILL AGREE TO BE FULLY RESPONSIBLE FOR ANY AND ALL DAMAGES WHICH MIGHT BE INCURRED BY THEIR FAILURE TO EXACTLY LOCATE AND PRESERVE ANY AND ALL UNDERGROUND UTILITIES, STRUCTURES OR FACILITIES. CONTRACTOR SHALL NOTIFY ENGINEER OF ANY DISCREPANCIES 24-HOURS PRIOR TO COMMENCING CONSTRUCTION.

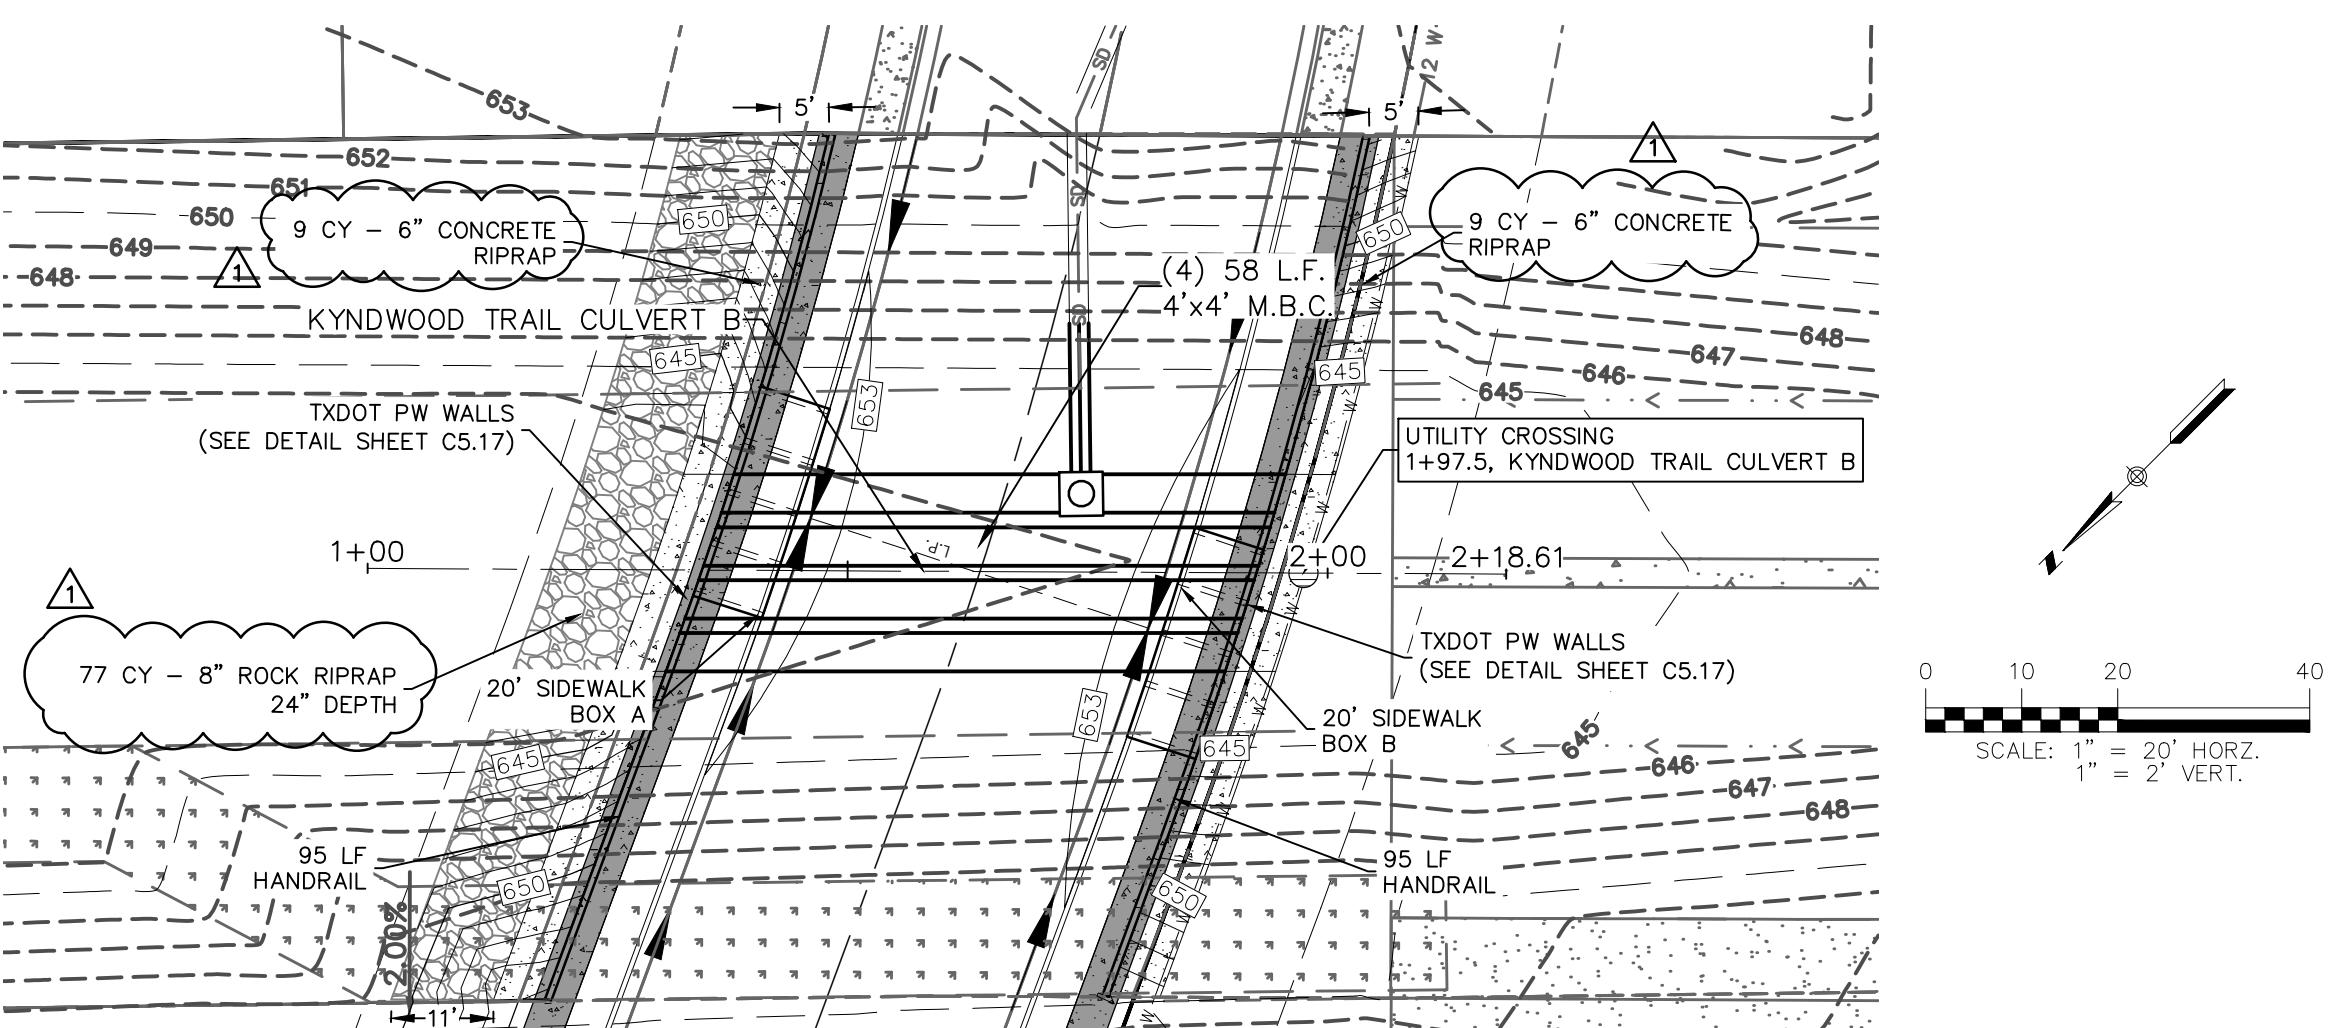

KYNDWOOD TRAIL CULVERT B
0+80 - 2+40

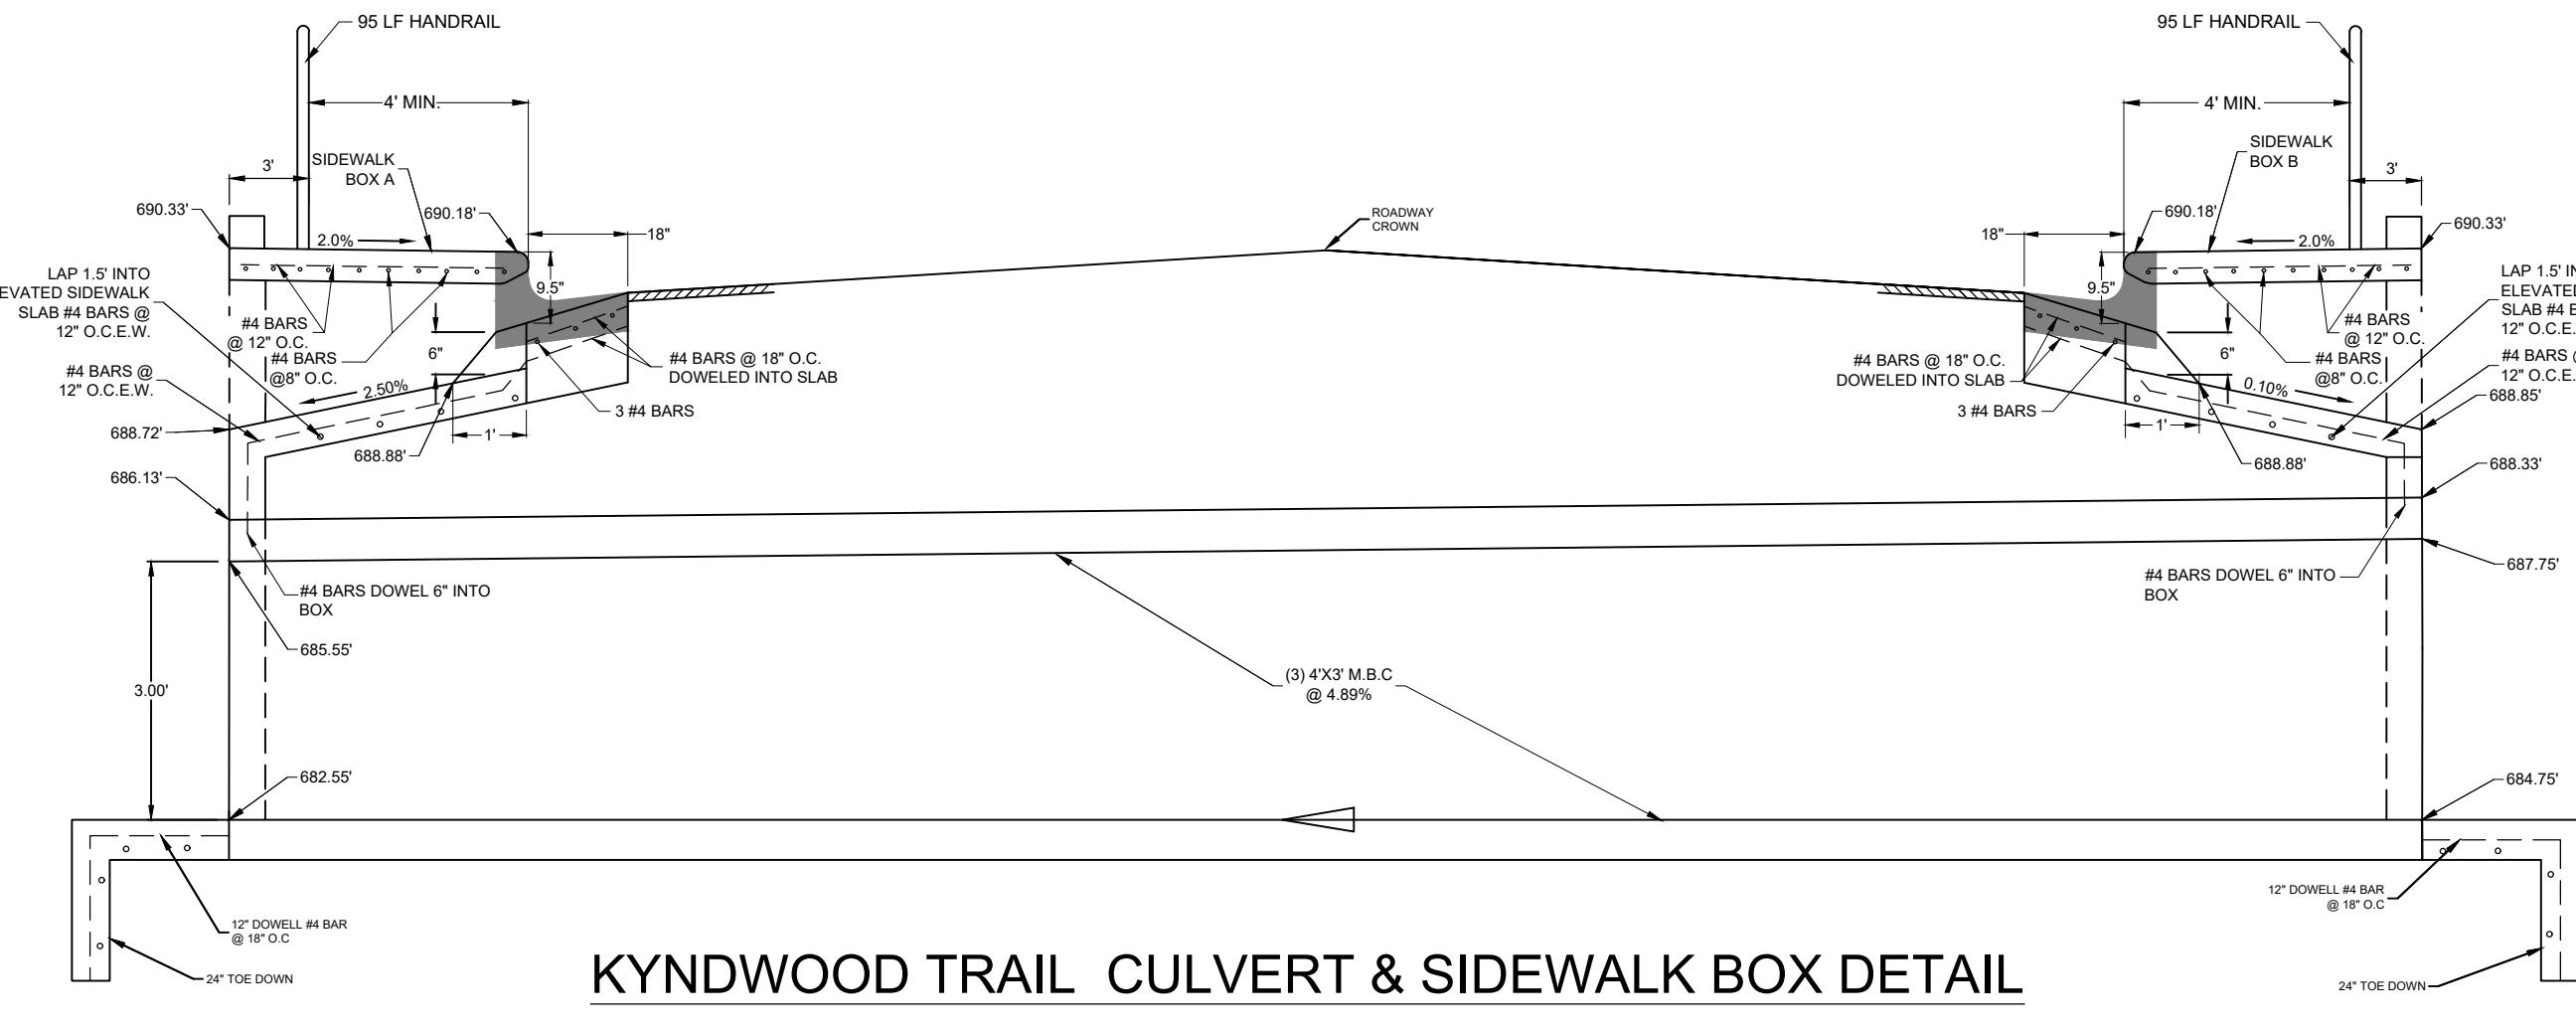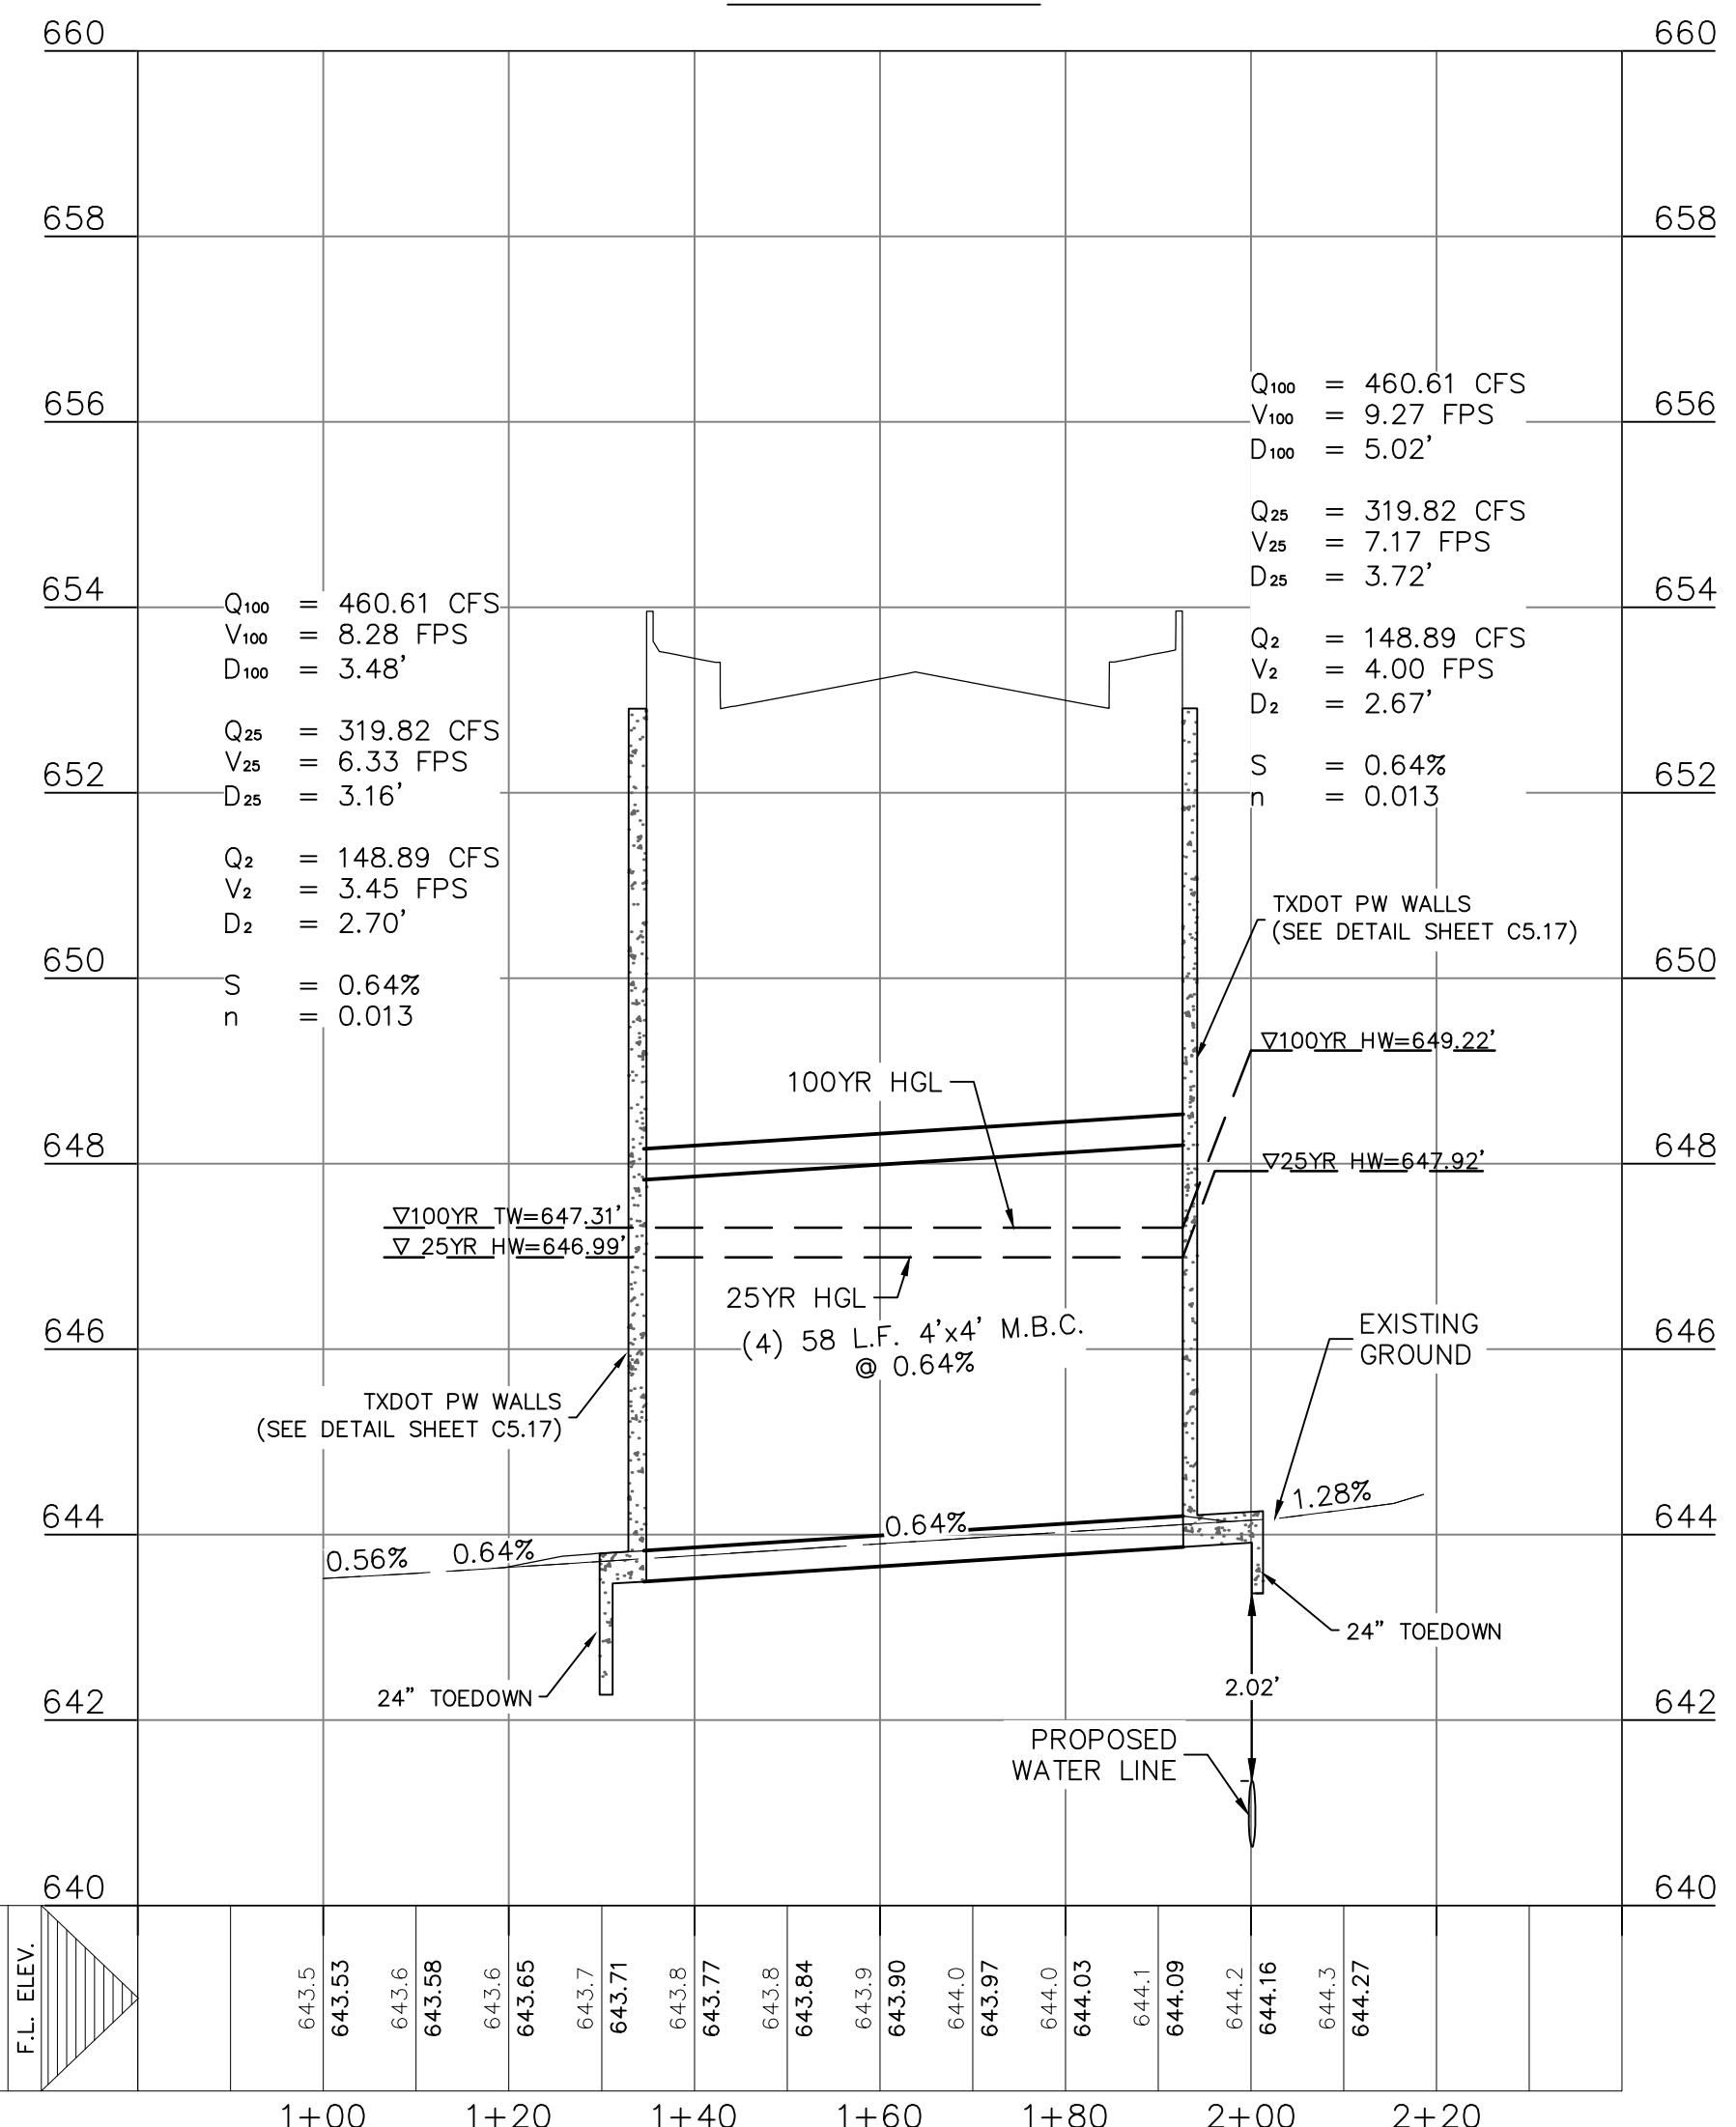

KYNDWOOD TRAIL CULVERT & SIDEWALK BOX DETAIL

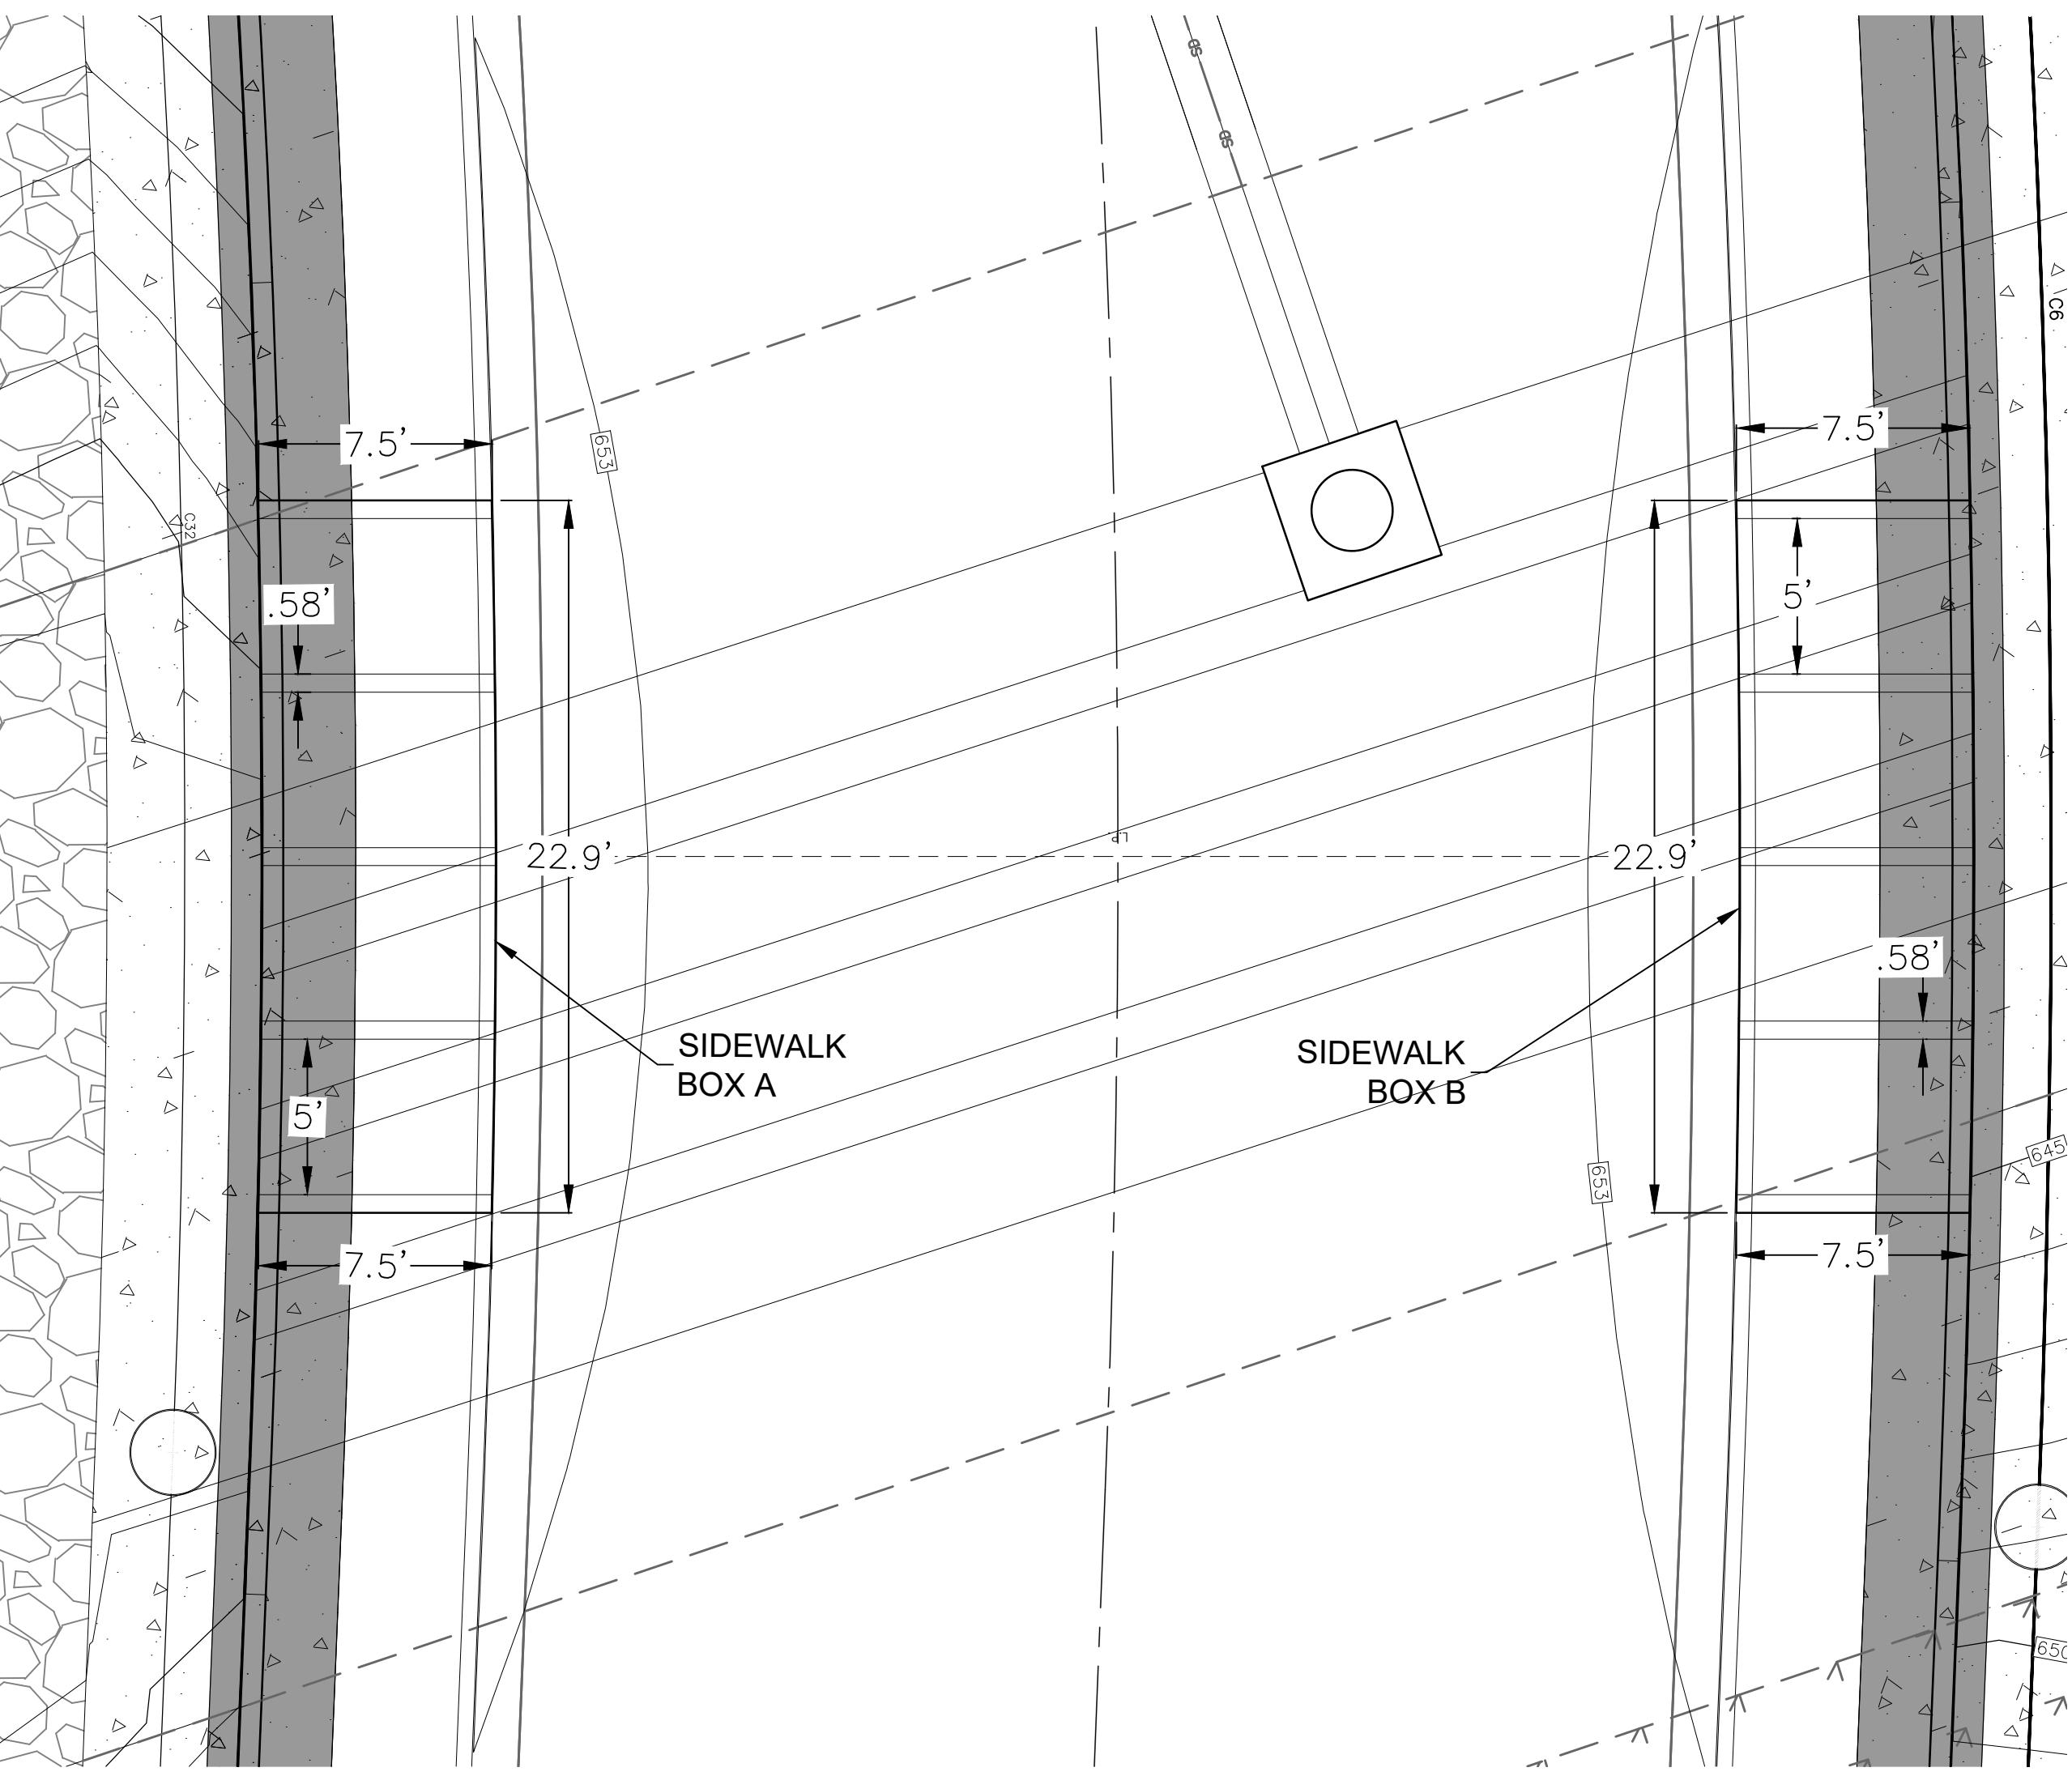

SIDEWALK BOXES

SCALE : 1"=5'

REFER TO THE COVER SHEET
FOR BENCHMARK INFORMATION.

THE LOCATION OF ALL EXISTING UNDERGROUND UTILITIES ARE SHOWN IN APPROXIMATE LOCATIONS ONLY. THE CONTRACTOR SHALL DETERMINE THE EXACT LOCATION OF ALL EXISTING UTILITIES BEFORE COMMENCING WORK. THE CONTRACTOR WILL AGREE TO BE FULLY RESPONSIBLE FOR ANY AND ALL DAMAGES WHICH MIGHT BE INCURRED BY THEIR FAILURE TO EXACTLY LOCATE AND PRESERVE ANY AND ALL UNDERGROUND UTILITIES, STRUCTURES OR FACILITIES. CONTRACTOR SHALL NOTIFY ENGINEER OF ANY DISCREPANCIES 24-HOURS PRIOR TO COMMENCING CONSTRUCTION.

HNT HINNIT
ENGINEERING & SURVEYING

290 S. CASTELL AVE., STE. 100
NEW BRAUNFELS, TX 78130
TBPELS FIRM F-10961
TBPLES FIRM 1053600

01/22/2026

STATE OF TEXAS
MATTHEW T. ABRAHAMS
154638
LICENSED PROFESSIONAL ENGINEER

Matthew T. Abrahams

WYNDWOOD RAIL CULVERT B

KYNDWOOD SUBDIVISION, UNIT 5
NEW BRAUNFELS, TEXAS

1 ADDED ROCK AND CONCRETE RIP RAP LABELS 1/22/2026

DATE: **JANUARY 2026**

AWN BY: **MK**


SIGNED BY: **MA**

VIEWED BY: **MA**

PROJECT NO.: **337.081**


SHEET

C5.12

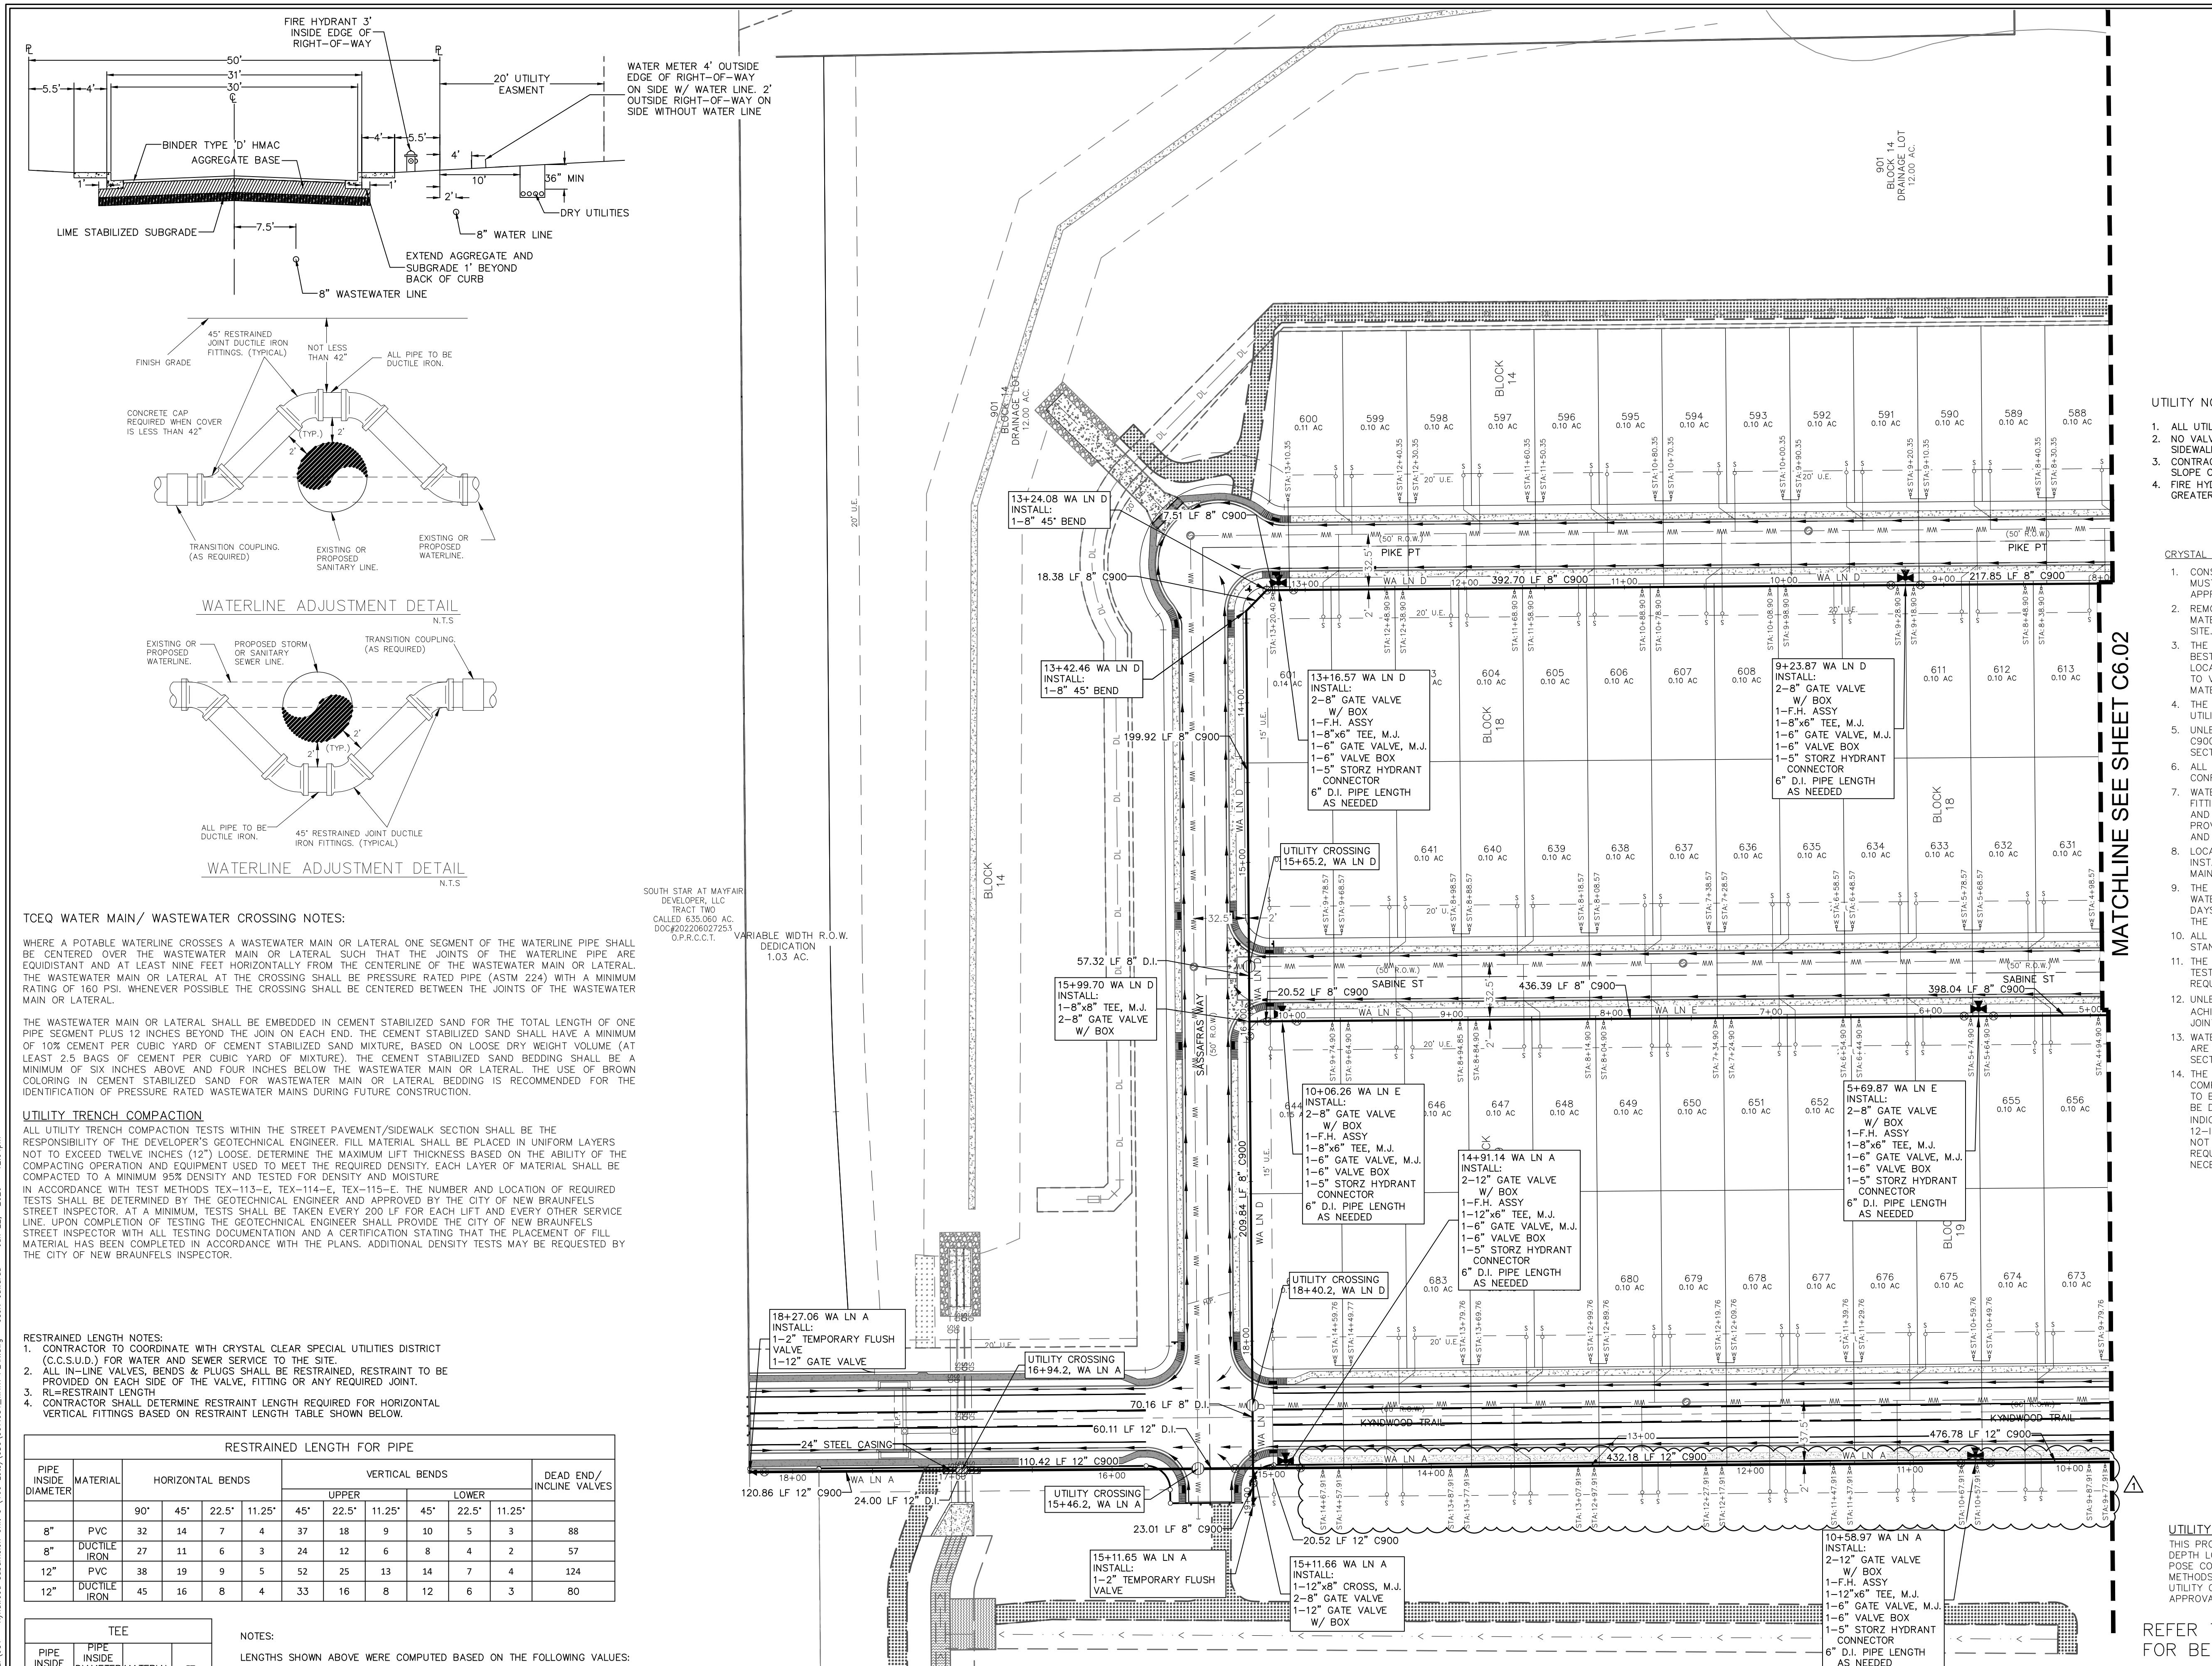

LEGEND

| | |
|---|------------------------|
| — — — 700 — — | EXISTING CONTOURS |
| — [700] — — | PROPOSED CONTOURS |
| B.L. | BUILDING SETBACK LINE |
| U.E. | UTILITY EASEMENT |
| D.E. | DRAINAGE EASEMENT |
| — EX W — EX W — | EXISTING WATER LINE |
| — W — W — | PROPOSED WATER LINE |
| W — — — | PROPOSED WATER SERVICE |
|  | UTILITY CROSSING |

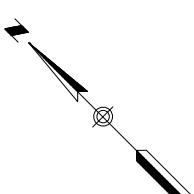

0 25 50 100



HORIZONTAL SCALE: 1:50

UTILITY NOTES:

1. ALL UTILITIES TO BE CONSTRUCTED PRIOR TO THE STREETS.
2. NO VALVES, HYDRANTS, ETC. SHALL BE CONSTRUCTED WITHIN CURBS, SIDEWALKS OR DRIVEWAYS.
3. CONTRACTOR TO VERIFY EXISTING LATERAL HAS A MINIMUM LONGITUDINAL SLOPE OF 2%.
4. FIRE HYDRANTS ARE TO BE INSTALLED OUTSIDE OF THE SIDEWALK AND NO GREATER THAN 9 FEET FROM THE BACK OF CURB.

CRYSTAL CLEAR SPECIAL UTILITY DISTRICT (CCSUD) WATER MAIN NOTES

1. CONSTRUCTION OF ALL CCSUD WATER UTILITY INFRASTRUCTURE MUST ADHERE TO CCSUD'S TECHNICAL SPECIFICATIONS, DETAILS AND APPROVED EQUIPMENT LIST.
2. REMOVE ONLY VEGETATION, TREES, STUMPS, RUBBISH, AND OTHER MATERIAL NECESSARY FOR CONSTRUCTION AND DISPOSE OF OFF SITE.
3. THE CONNECTION LOCATIONS LISTED IN THE PLANS ARE BASED ON BEST AVAILABLE INFORMATION. THE CONTRACTOR SHALL FIELD LOCATE EXISTING WATER MAIN LOCATIONS AT ALL TIE-IN LOCATIONS TO VERIFY SIZE, ELEVATION, AND MATERIAL PRIOR TO ORDERING MATERIALS FOR CONNECTION.
4. THE CONTRACTOR SHALL MAINTAIN MINIMUM SEPARATION BETWEEN UTILITIES PER TCEQ STANDARDS.
5. UNLESS OTHERWISE SPECIFIED, ALL PVC WATER MAINS SHALL BE C900 DR 18, COLORED BLUE IN ACCORDANCE WITH SPECIFICATION SECTION 02650 - PVC PIPE FOR WATER MAINS.
6. ALL DUCTILE IRON WATER MAINS SHALL BE PRESSURE CLASS CONFORMING TO AWWA C151 AND CEMENT LINED.
7. WATER MAINS SHALL BE RESTRAINED WITH RESTRAINT LENGTHS OF FITTINGS SHOWN IN THRUST BLOCKING IS REQUIRED AT ALL FITTINGS AND BENDS IN ACCORDANCE WITH THE THRUST BLOCKING DETAIL PROVIDED AND SPECIFICATION SECTION 02680 - JOINT RESTRAINTS AND THRUST BLOCKING.
8. LOCATIONS OF COMBINATION AIR VALVES SHOWN ARE APPROXIMATE. INSTALL AIR RELEASE VALVES AT THE HIGH POINT IN THE WATER MAIN FOR THE LOCATIONS GIVEN.
9. THE CONTRACTOR SHALL COORDINATE PRESSURE TESTING OF NEW WATER MAINS WITH OWNER AND ENGINEER AT LEAST TWO BUSINESS DAYS PRIOR. PRESSURE TESTING REQUIREMENTS ARE INCLUDED IN THE SPECIFICATIONS.
10. ALL WATER MAINS SHALL BE DISINFECTED PER AWWA AND TCEQ STANDARDS.
11. THE OWNER SHALL SUPPLY ALL WATER NEEDED FOR CONSTRUCTION TESTING AND DISINFECTION. THE CONTRACTOR SHALL NOT BE REQUIRED TO PAY FOR THIS WATER.
12. UNLESS NOTED OTHERWISE, ALL WATER MAIN P.I.'S SHALL BE ACHIEVED USING THE WATER MAIN MANUFACTURER'S ALLOWABLE JOINT DEFLECTION.
13. WATER MAINS, FIRE HYDRANTS, APPURTENANCES, AND VALVES THAT ARE ABANDONED SHALL BE CUT AND PLUGGED PER SPECIFICATION SECTION 02500 - ABANDONMENT OF WATER INFRASTRUCTURE.
14. THE CONTRACTOR SHALL BE RESPONSIBLE FOR MEETING 98% COMPACTION ON ALL TRENCH BACKFILL AND PAYING FOR THE TESTS TO BE PERFORMED BY A THIRD PARTY. COMPACTION TESTS WILL BE DONE AT ONE LOCATION POINT RANDOMLY SELECTED OR AS INDICATED BY CCSUD INSPECTOR/TEST ADMINISTRATOR, PER EACH 12-INCH LOOSE LIFT 400 LINEAR FEET AT A MINIMUM. PERMITS WILL NOT BE ACCEPTED AND FINALIZED BY CCSUD WITHOUT THIS REQUIREMENT BEING MET AND VERIFIED BY PROVIDING ALL

OVERALL WATER PLAN
(1 OF 2)

YNDWOOD SUBDIVISION, UNIT 5
NEW BRAUNFELS, TEXAS

HNT HNT
ENGINEERING & SURVEYING

290 S. CASTELL AVE., STE. 100
NEW BRAUNFELS, TX 78130
TBPELS FIRM F-10961
TBPLES FIRM 1053600

01/22/2026

STATE OF TEXAS
MATTHEW T. ABRAHAMS
154638
LICENSED PROFESSIONAL ENGINEER

Matthew T. Abrahams

| | |
|-----------------------------|-----------|
| DATE: JANUARY 2026 | |
| AWN BY: | MK |
| SIGNED BY: | MA |
| VIEWED BY: | MA |
| PROJECT NO.: 337.081 | |
| SHEET | |
| C6.01 | |

RESTRAINED LENGTH NOTES:

1. CONTRACTOR TO COORDINATE WITH CRYSTAL CLEAR SPECIAL UTILITIES DISTRICT (C.C.S.U.D.) FOR WATER AND SEWER SERVICE TO THE SITE.
2. ALL IN-LINE VALVES, BENDS & PLUGS SHALL BE RESTRAINED, RESTRAINT TO BE PROVIDED ON EACH SIDE OF THE VALVE, FITTING OR ANY REQUIRED JOINT.
3. RL=RESTRAINT LENGTH
4. CONTRACTOR SHALL DETERMINE RESTRAINT LENGTH REQUIRED FOR HORIZONTAL VERTICAL FITTINGS BASED ON RESTRAINT LENGTH TABLE SHOWN BELOW.

| RESTRAINED LENGTH FOR PIPE | | | | | | | | | | | | |
|----------------------------|-----------------|------------------|-----|-------|--------|----------------|-------|--------|-------|-------|-----------------------------|-----|
| PIPE INSIDE DIAMETER | MATERIAL | HORIZONTAL BENDS | | | | VERTICAL BENDS | | | | | DEAD END/ INCLINE VALVES | |
| | | | | | | UPPER | | | LOWER | | | |
| | | 90° | 45° | 22.5° | 11.25° | 45° | 22.5° | 11.25° | 45° | 22.5° | 11.25° | |
| 8" | PVC | 32 | 14 | 7 | 4 | 37 | 18 | 9 | 10 | 5 | 3 | 88 |
| 8" | DUCTILE IRON | 27 | 11 | 6 | 3 | 24 | 12 | 6 | 8 | 4 | 2 | 57 |
| 12" | PVC | 38 | 19 | 9 | 5 | 52 | 25 | 13 | 14 | 7 | 4 | 124 |
| 12" | DUCTILE IRON | 45 | 16 | 8 | 4 | 33 | 16 | 8 | 12 | 6 | 3 | 80 |

| TEE | | | |
|--------------------------------------|--|-----------------|-----|
| PIPE INSIDE DIAMETER OF RUN | PIPE INSIDE DIAMETER OF BRANCH | MATERIAL | FT. |
| 8" | 8" | PVC | 77 |
| 8" | 8" | DUCTILE IRON | 50 |
| 12" | 8" | PVC | 72 |
| 12" | 8" | DUCTILE IRON | 46 |
| 12" | 12" | PVC | 114 |
| 12" | 12" | DUCTILE IRON | 73 |

NOTES:
LENGTHS SHOWN ABOVE WERE COMPUTED BASED ON THE FOLLOWING VALUES:
1) SAFETY FACTOR = 1.5 TO 1

1) SAFETY FACTOR = 1.5 TO 1
2) TEST PRESSURE = 200psi.
3) SOIL DESIGNATION = INORGANIC CLAY OF HIGH PLASTICITY (CH, GRAN. FILL)
4) DEPTH OF COVER = 3.5 FEET (TYPICAL AND UPPER BEND)
5) DEPTH OF COVER = 5 FEET (LOWER BEND)

TCEQ WATER MAIN/ WASTEWATER CROSSING NOTES:


WHERE A POTABLE WATERLINE CROSSES A WASTEWATER MAIN OR LATERAL ONE SEGMENT OF THE WATERLINE PIPE SHALL BE CENTERED OVER THE WASTEWATER MAIN OR LATERAL SUCH THAT THE JOINTS OF THE WATERLINE PIPE ARE EQUIDISTANT AND AT LEAST NINE FEET HORIZONTALLY FROM THE CENTERLINE OF THE WASTEWATER MAIN OR LATERAL. THE WASTEWATER MAIN OR LATERAL AT THE CROSSING SHALL BE PRESSURE RATED PIPE (ASTM 224) WITH A MINIMUM RATING OF 160 PSI. WHENEVER POSSIBLE THE CROSSING SHALL BE CENTERED BETWEEN THE JOINTS OF THE WASTEWATER MAIN OR LATERAL.

THE WASTEWATER MAIN OR LATERAL SHALL BE EMBEDDED IN CEMENT STABILIZED SAND FOR THE TOTAL LENGTH OF ONE PIPE SEGMENT PLUS 12 INCHES BEYOND THE JOIN ON EACH END. THE CEMENT STABILIZED SAND SHALL HAVE A MINIMUM OF 10% CEMENT PER CUBIC YARD OF CEMENT STABILIZED SAND MIXTURE, BASED ON LOOSE DRY WEIGHT VOLUME (AT LEAST 2.5 BAGS OF CEMENT PER CUBIC YARD OF MIXTURE). THE CEMENT STABILIZED SAND BEDDING SHALL BE A MINIMUM OF SIX INCHES ABOVE AND FOUR INCHES BELOW THE WASTEWATER MAIN OR LATERAL. THE USE OF BROWN COLORING IN CEMENT STABILIZED SAND FOR WASTEWATER MAIN OR LATERAL BEDDING IS RECOMMENDED FOR THE IDENTIFICATION OF PRESSURE RATED WASTEWATER MAINS DURING FUTURE CONSTRUCTION.


UTILITY TRENCH COMPACTION

ALL UTILITY TRENCH COMPACTION TESTS WITHIN THE STREET PAVEMENT/SIDEWALK SECTION SHALL BE THE RESPONSIBILITY OF THE DEVELOPER'S GEOTECHNICAL ENGINEER. FILL MATERIAL SHALL BE PLACED IN UNIFORM LAYERS NOT TO EXCEED TWELVE INCHES (12") LOOSE. DETERMINE THE MAXIMUM LIFT THICKNESS BASED ON THE ABILITY OF THE COMPACTING OPERATION AND EQUIPMENT USED TO MEET THE REQUIRED DENSITY. EACH LAYER OF MATERIAL SHALL BE COMPACTED TO A MINIMUM 95% DENSITY AND TESTED FOR DENSITY AND MOISTURE IN ACCORDANCE WITH TEST METHODS TEX-113-E, TEX-114-E, TEX-115-E. THE NUMBER AND LOCATION OF REQUIRED TESTS SHALL BE DETERMINED BY THE GEOTECHNICAL ENGINEER AND APPROVED BY THE CITY OF NEW BRAUNFELS STREET INSPECTOR. AT A MINIMUM, TESTS SHALL BE TAKEN EVERY 200 LF FOR EACH LIFT AND EVERY OTHER SERVICE LINE. UPON COMPLETION OF TESTING THE GEOTECHNICAL ENGINEER SHALL PROVIDE THE CITY OF NEW BRAUNFELS STREET INSPECTOR WITH ALL TESTING DOCUMENTATION AND A CERTIFICATION STATING THAT THE PLACEMENT OF FILL MATERIAL HAS BEEN COMPLETED IN ACCORDANCE WITH THE PLANS. ADDITIONAL DENSITY TESTS MAY BE REQUESTED BY THE CITY OF NEW BRAUNFELS INSPECTOR.



UTILITy TRENCH COMPACTION (DEEP)
THIS PROJECT INCLUDES UTILITY INSTALLATIONS GREATER THAN 5-FEET IN DEPTH LOCATED IN PUBLIC RIGHT-OF-WAY OR EASEMENTS. DEEP TRENCHES POSE COMPACTION TESTING AND CONSTRUCTION CHALLENGES AND CITY METHODS FOR TESTING AND COMPACTION MAY NOT BE ACHIEVABLE. A UTILITY COMPACTION PLAN WILL BE REQUIRED AND MUST BE SUBMITTED FOR APPROVAL TO CITY PRIOR TO UTILITY INSTALLATION.

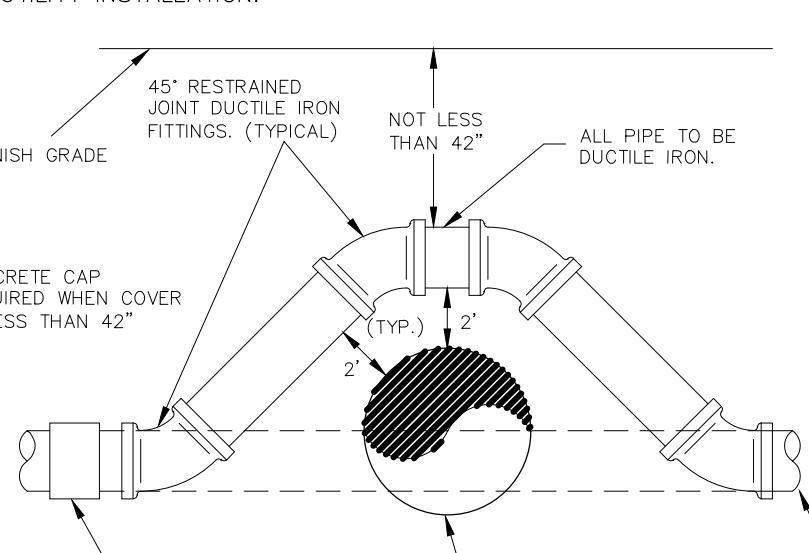

MATCHLINE SEE SHEET C6.01

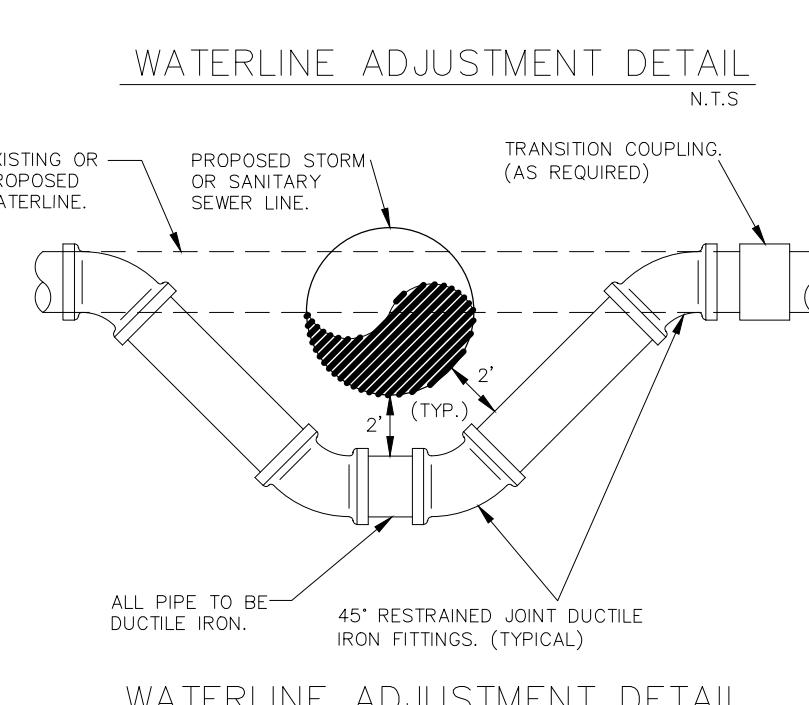


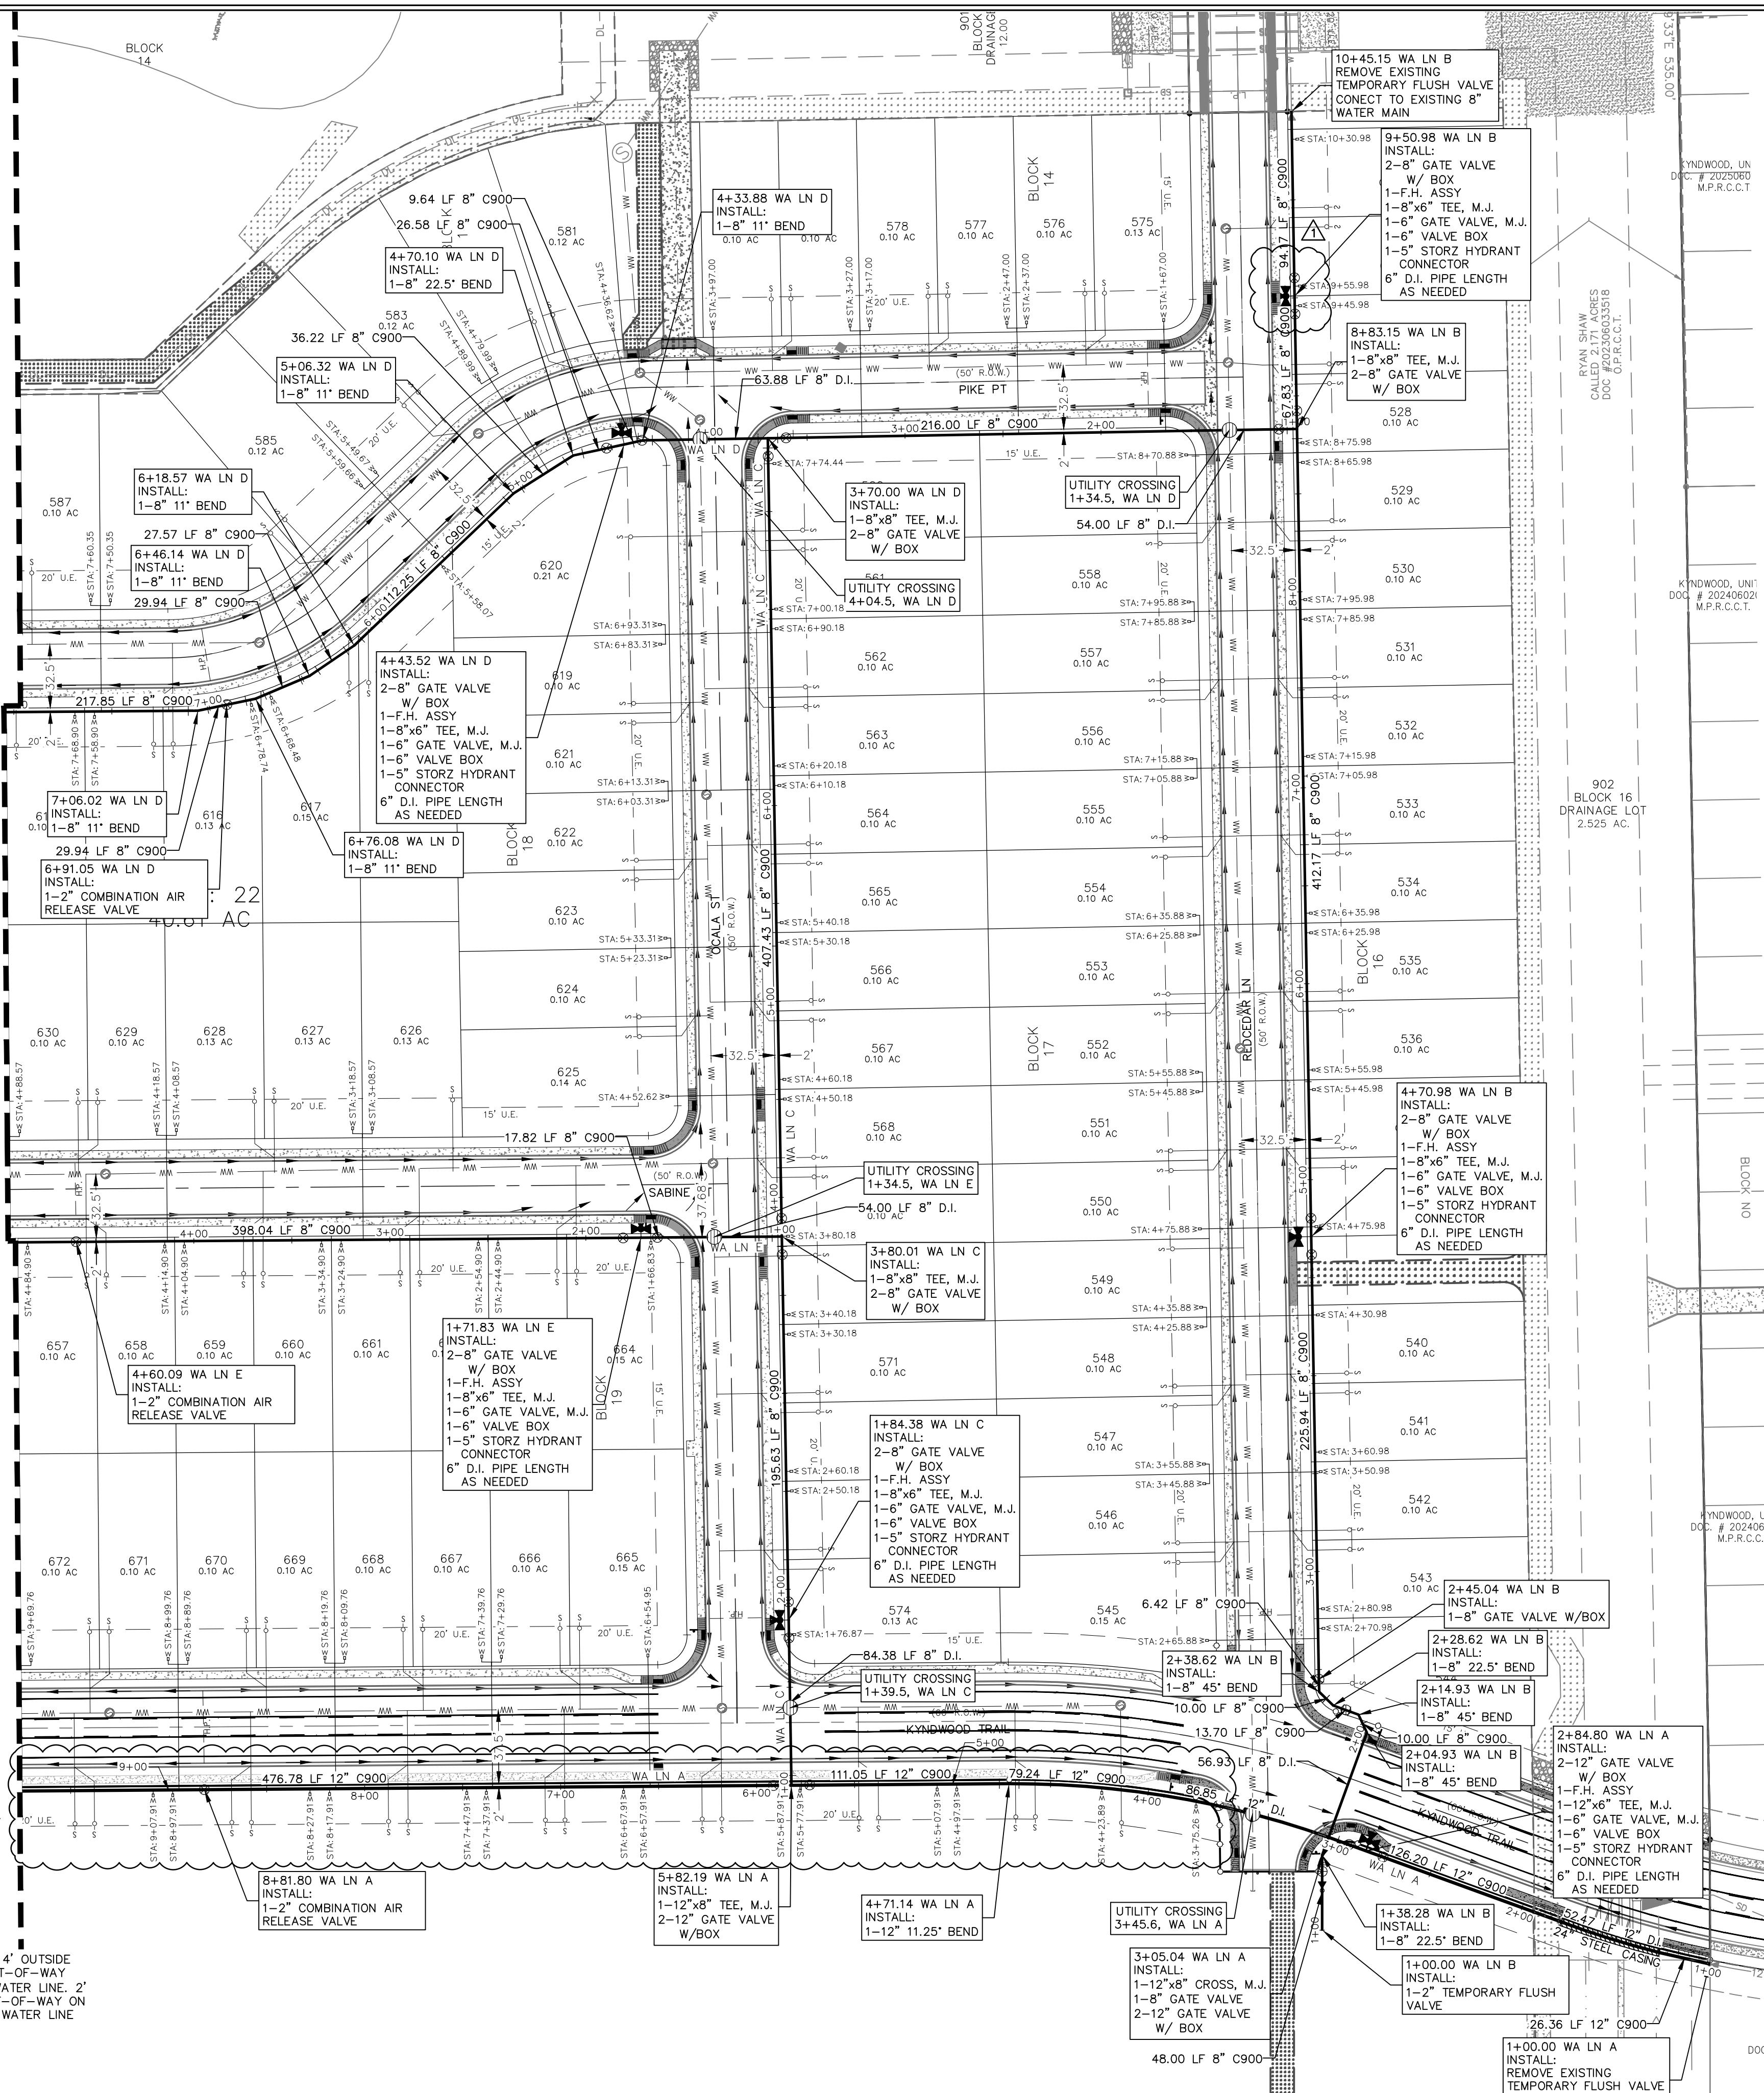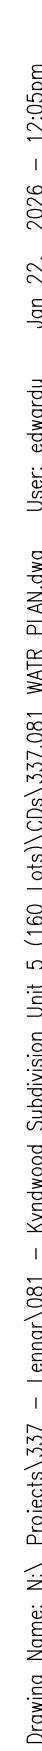

REFER TO THE COVER SHEET
OR BENCHMARK INFORMATION.

THE LOCATION OF ALL EXISTING UNDERGROUND UTILITIES ARE SHOWN IN APPROXIMATE LOCATIONS ONLY. THE CONTRACTOR SHALL DETERMINE THE EXACT LOCATION OF ALL EXISTING UTILITIES BEFORE COMMENCING WORK. THE CONTRACTOR WILL AGREE TO BE FULLY RESPONSIBLE FOR ANY AND ALL DAMAGES WHICH MIGHT BE INCURRED BY THEIR FAILURE TO EXACTLY LOCATE AND PRESERVE ANY AND ALL UNDERGROUND UTILITIES, STRUCTURES OR FACILITIES. CONTRACTOR SHALL NOTIFY ENGINEER OF ANY DISCREPANCIES 24-HOURS PRIOR TO COMMENCING CONSTRUCTION.



HNT HNT
ENGINEERING & SURVEYING

290 S. CASTELL AVE., STE. 100
NEW BRAUNFELS, TX 78130
TBPELS FIRM F-10961
TBPLES FIRM 1053600

OVERALL WATER PLAN (2 OF 2)

SHEET

C6.02

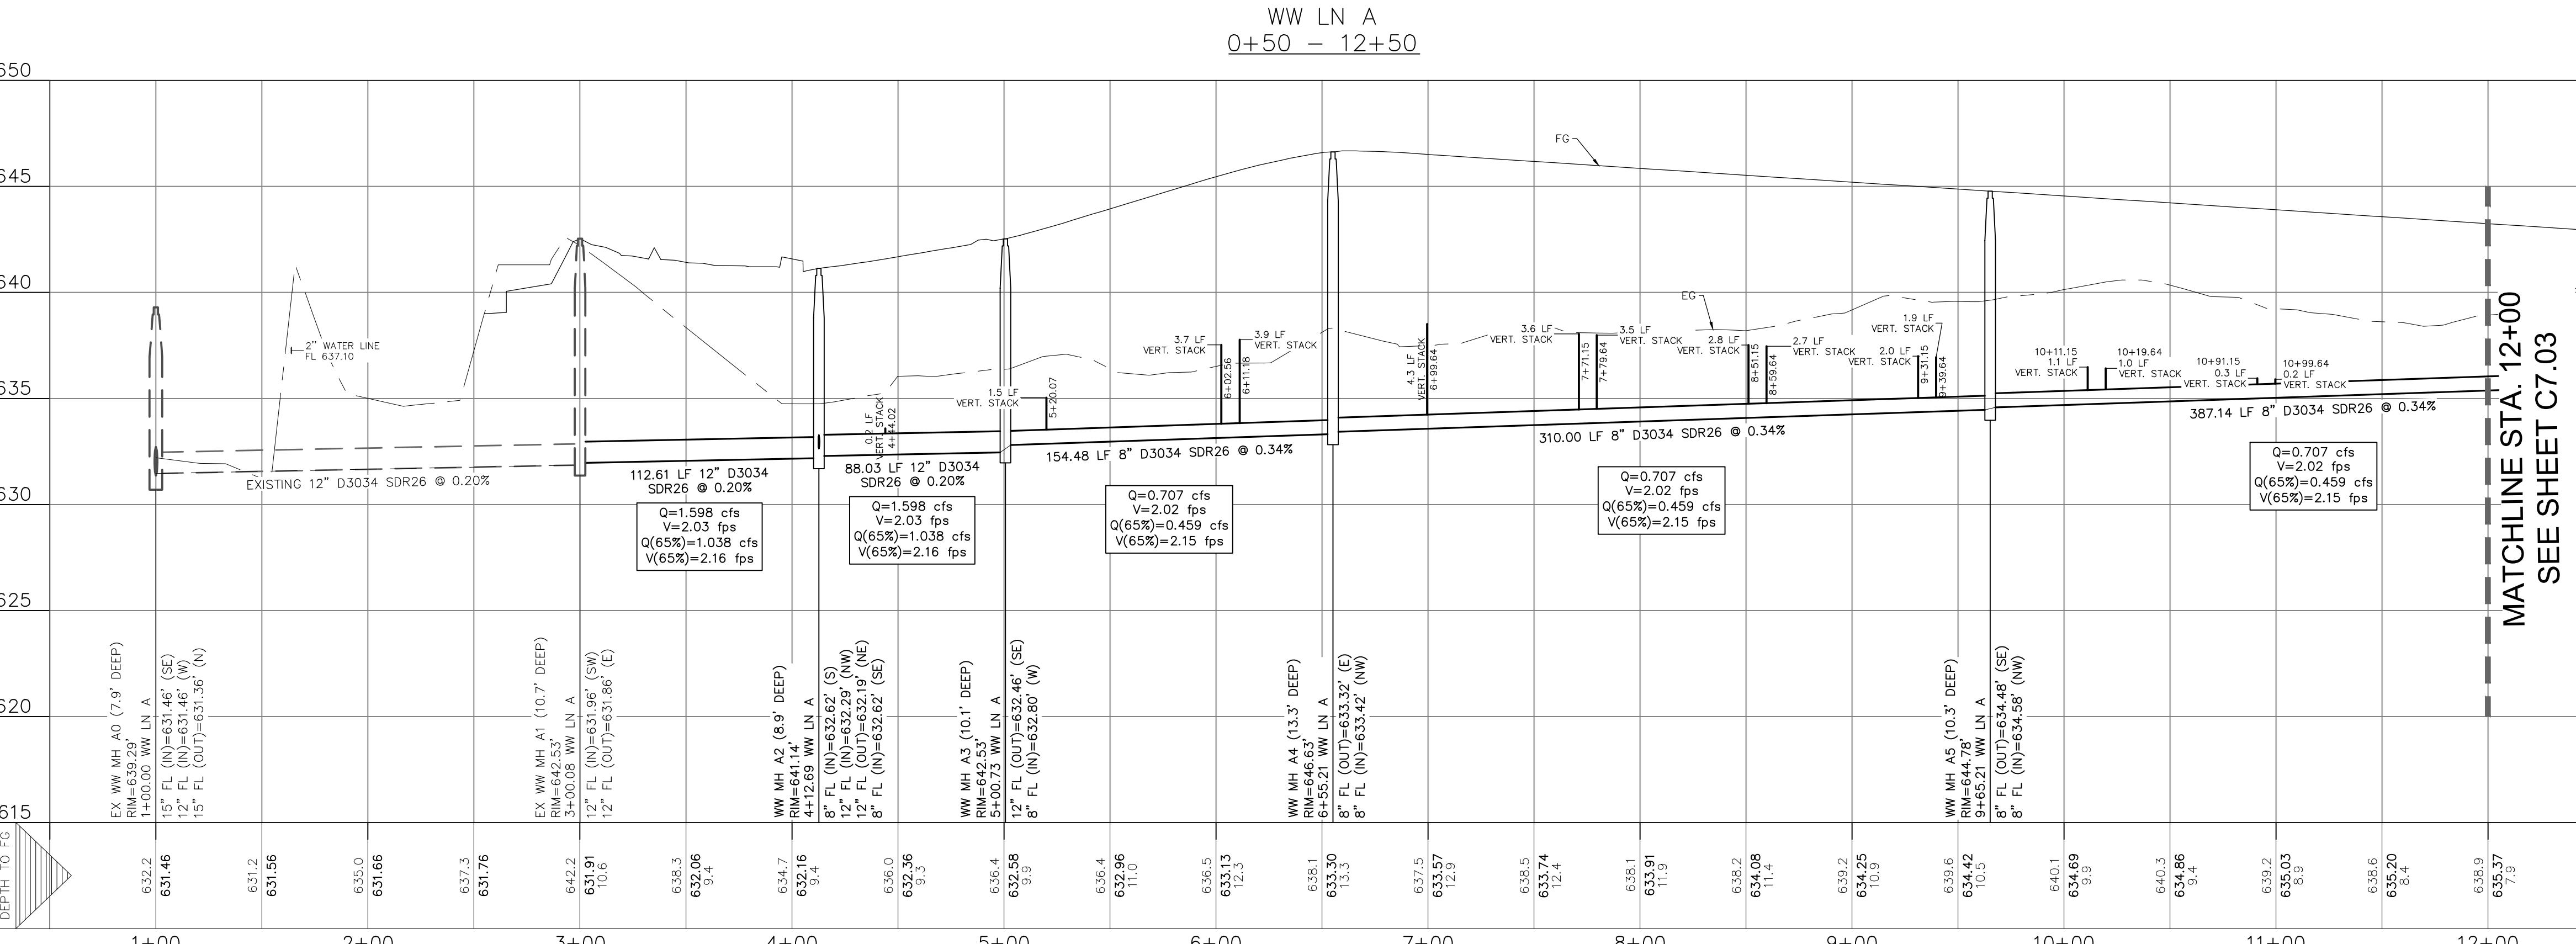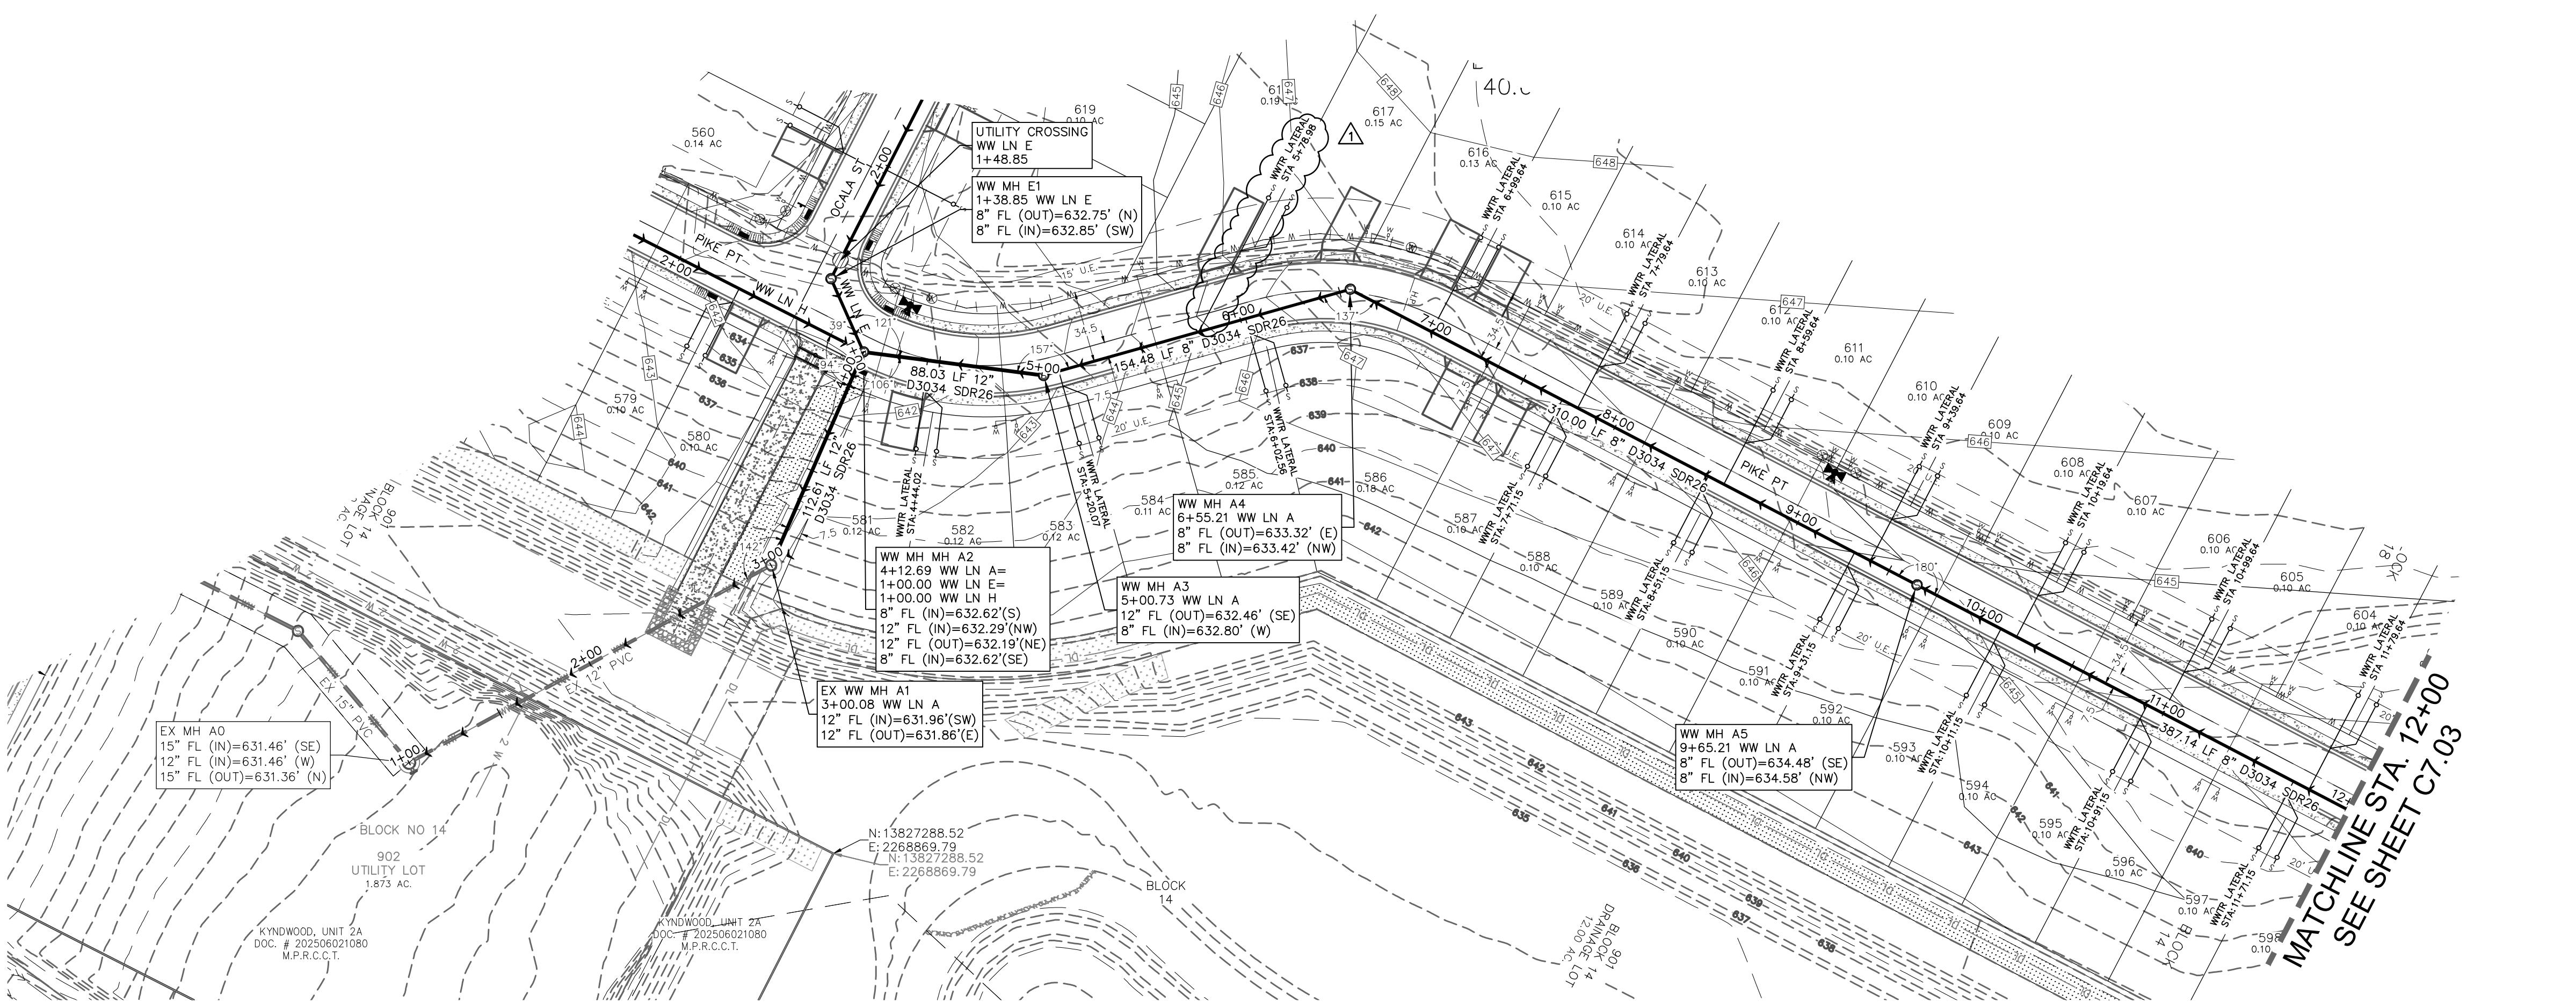

TRENCH EXCAVATION SAFETY PROTECTION
 CONTRACTOR AND/OR CONTRACTOR'S INDEPENDENTLY RETAINED EMPLOYEE OR STRUCTURAL DESIGN/GEOTECHNICAL/SAFETY/EQUIPMENT CONSULTANT, IF ANY, SHALL REVIEW THESE PLANS AND AVAILABLE GEOTECHNICAL INFORMATION AND THE ANTICIPATED INSTALLATION SITE(S) WITHIN THE PROJECT WORK AREA IN ORDER TO IMPLEMENT CONTRACTOR'S TRENCH EXCAVATION SAFETY PROTECTION SYSTEMS, PROGRAMS AND/OR PROCEDURES FOR THE PROJECT DESCRIBED IN THE CONTRACT DOCUMENTS. THE CONTRACTOR'S IMPLEMENTATION OF THESE SYSTEMS, PROGRAMS AND/OR PROCEDURES SHALL PROVIDE FOR ADEQUATE TRENCH EXCAVATION SAFETY PROTECTION THAT COMPLY WITH AS A MINIMUM, OSHA STANDARDS FOR TRENCH EXCAVATIONS. SPECIFICALLY, CONTRACTOR AND/OR CONTRACTOR'S INDEPENDENTLY RETAINED EMPLOYEE OR SAFETY CONSULTANT SHALL IMPLEMENT A TRENCH SAFETY PROGRAM IN ACCORDANCE WITH OSHA STANDARDS GOVERNING THE PRESENCE AND ACTIVITIES OF INDIVIDUALS WORKING IN AND AROUND TRENCH EXCAVATIONS.

UTILITY TRENCH COMPACTION (DEEP)
 CITY REQUIREMENTS FOR TESTING SHALL BE ADHERED TO, IN CASES WHERE TRENCH DEPTHS DO NOT ALLOW TECHNICIANS ACCESS, METHODS FOR TESTING SHALL BE PROPOSED AND APPROVED PRIOR TO CONSTRUCTION COMMENCING.

THIS PROJECT INCLUDES UTILITY INSTALLATIONS GREATER THAN 5-FEET IN DEPTH LOCATED IN PUBLIC RIGHT-OF-WAY OR EXCAVATED DEEP TRENCHES. DEEP TRENCHES POSE COMPACTION TESTING AND CONSTRUCTION CHALLENGES AND CITY METHODS FOR TESTING AND COMPACTION MAY NOT BE ACHIEVABLE. A UTILITY COMPACTION PLAN WILL BE REQUIRED AND MUST BE SUBMITTED FOR APPROVAL TO CITY PRIOR TO UTILITY INSTALLATION.

ALL UTILITY TRENCH COMPACTION TESTS WITHIN THE STREET PAVEMENT/SIDEWALK SECTION SHALL BE THE RESPONSIBILITY OF THE GEOTECHNICAL ENGINEER. MATERIAL SHALL BE PLACED IN UNIFORM LAYERS NOT TO EXCEED TWELVE INCHES (12") THICK. DETERMINE THE MAXIMUM LIFT THICKNESS BASED ON THE ABILITY OF THE COMPACTION OPERATION AND EQUIPMENT USED TO MEET THE REQUIRED DENSITY. EACH LAYER OF MATERIAL SHALL BE COMPACTED TO A MINIMUM 95% DENSITY AND TESTED FOR DENSITY AND MOISTURE.

IN ACCORDANCE WITH TEST METHODS TEX-113-E, TEX-114-E, TEX-115-E. THE NUMBER AND LOCATION OF REQUIRED TESTS SHALL BE DETERMINED BY THE GEOTECHNICAL ENGINEER AND APPROVED BY THE CITY OF NEW BRAUNFELS STREET INSPECTOR. AT A MINIMUM, TESTS SHALL BE TAKEN EVERY 200 LF FOR EACH LIFT AND EVERY OTHER SERVICE LINE. UPON COMPLETION OF TESTING THE GEOTECHNICAL ENGINEER SHALL PROVIDE THE CITY OF NEW BRAUNFELS STREET INSPECTOR WITH ALL TESTING DOCUMENTATION AND A CERTIFICATION STATING THAT THE PLACEMENT OF FILM MATERIAL HAS BEEN COMPLETED IN ACCORDANCE WITH THE PLANS. ADDITIONAL DENSITY TESTS MAY BE REQUESTED BY THE CITY OF NEW BRAUNFELS INSPECTOR.

UTILITY TRENCH COMPACTION

THE LOCATION OF ALL EXISTING UNDERGROUND UTILITIES ARE SHOWN IN APPROXIMATE LOCATIONS ONLY. THE CONTRACTOR SHALL DETERMINE THE EXACT LOCATION OF ALL EXISTING UTILITIES BEFORE COMMENCING WORK. THE CONTRACTOR WILL AGREE TO BE FULLY RESPONSIBLE FOR ANY AND ALL DAMAGES WHICH MIGHT BE INCURRED BY THEIR FAILURE TO EXACTLY LOCATE AND PRESERVE ANY AND ALL UNDERGROUND UTILITIES, STRUCTURES OR FACILITIES. CONTRACTOR SHALL NOTIFY ENGINEER OF ANY DISCREPANCIES 24-HOURS PRIOR TO COMMENCING CONSTRUCTION.

REFER TO THE COVER SHEET FOR BENCHMARK INFORMATION.

THE LOCATION OF ALL EXISTING UNDERGROUND UTILITIES ARE SHOWN IN APPROXIMATE LOCATIONS ONLY. THE CONTRACTOR SHALL DETERMINE THE EXACT LOCATION OF ALL EXISTING UTILITIES BEFORE COMMENCING WORK. THE CONTRACTOR WILL AGREE TO BE FULLY RESPONSIBLE FOR ANY AND ALL DAMAGES WHICH MIGHT BE INCURRED BY THEIR FAILURE TO EXACTLY LOCATE AND PRESERVE ANY AND ALL UNDERGROUND UTILITIES, STRUCTURES OR FACILITIES. CONTRACTOR SHALL NOTIFY ENGINEER OF ANY DISCREPANCIES 24-HOURS PRIOR TO COMMENCING CONSTRUCTION.

THE LOCATION OF ALL EXISTING UNDERGROUND UTILITIES ARE SHOWN IN APPROXIMATE LOCATIONS ONLY. THE CONTRACTOR SHALL DETERMINE THE EXACT LOCATION OF ALL EXISTING UTILITIES BEFORE COMMENCING WORK. THE CONTRACTOR WILL AGREE TO BE FULLY RESPONSIBLE FOR ANY AND ALL DAMAGES WHICH MIGHT BE INCURRED BY THEIR FAILURE TO EXACTLY LOCATE AND PRESERVE ANY AND ALL UNDERGROUND UTILITIES, STRUCTURES OR FACILITIES. CONTRACTOR SHALL NOTIFY ENGINEER OF ANY DISCREPANCIES 24-HOURS PRIOR TO COMMENCING CONSTRUCTION.

LEGEND

- EXISTING CONTOURS
- PROPOSED CONTOURS
- B.L. BUILDING SETBACK LINE
- U.E. UTILITY EASEMENT
- D.E. DRAINAGE EASEMENT
- WW EXISTING WASTEWATER LINE
- WW PROPOSED WASTEWATER MANHOLE
- WW PROPOSED WASTEWATER LINE
- WW PROPOSED WASTEWATER SERVICE
- UTILITY CROSSING

UTILITY NOTES:

- ALL UTILITIES TO BE CONSTRUCTED & TESTED PRIOR TO THE STREETS.
- NO VALVES, HYDRANTS, ETC. SHALL BE CONSTRUCTED WITHIN CURB SIDEWALKS OR DRIVEWAYS.
- ALL SEWER PIPE ASTM D3034 (TYPICAL OF OTHER SHEETS) (115 PSI) SDR 26 UNLESS CALLED OUT OTHERWISE.
- REFER TO THE COVER SHEET FOR BENCHMARK INFORMATION.
- AT WATER CROSSINGS INCLUDING FIRE HYDRANT LEADS, WHITE COLOR GASKETED ASTM D2241 SDR 26 PIPE AND FITTINGS SHALL BE USED FOR MAINS AND LATERALS.
- REFER TO ALL CCSUD NOTES ON SHEET C00.2.

CRYSTAL CLEAR SPECIAL UTILITY DISTRICT (CCSUD) WASTEWATER NOTES:

- THE CONTRACTOR SHALL MAINTAIN SERVICE TO EXISTING THE WASTEWATER SYSTEM AT ALL TIMES DURING CONSTRUCTION.
- A MINIMUM OF 8" WASTEWATER PIPE AND FITTINGS (P.V.C. SDR-26, ASTM D3034, SDR-26) ARE REQUIRED.
- ALL RESIDENTIAL WASTEWATER SERVICE LATERALS SHALL BE EXTENDED TO THE PROPERTY LINE AND CLEANOUTS SHALL BE INSTALLED AT THE PROPERTY LINE. SERVICES TO LOTS WILL EXTEND FOUR (4) FEET PAST THE UNDERGROUND ELECTRIC CONDUIT. ELECTRIC IS INSTALLED IN THE FRONT EASAGE. ALL SEWER CLEANOUTS THAT LEAD TO CCSUD MAINS SHALL BE INSTALLED WITH A PROTECTIVE UTILITY SHROUD AND PIVOTING MARKER POLE DURING TIME OF CONSTRUCTION.
- PIPE BEDDING MATERIAL OF WASTEWATER MAINS SHALL BE COMPOSED OF WELL GRADED, CRUSHED STONE OR GRAVEL PER SECTION 01230 OF CCSUD SPECIFICATIONS.
- SECONDARY AND GENERAL BACKFILL OF WASTEWATER MAINS SHALL BE APPROVED SOIL MATERIALS FOR BACKFILL AND FILL, FREE OF CLAY, ROCK, OR GRAVEL LARGER THAN 2-INCHES IN ANY DIMENSION, DEBRIS, WASTE, FROZEN MATERIALS, VEGGIEABLE, AND OTHER ORGANIC MATTER AND DELIVERED IN PLACED IN LAYERS NOT EXCEEDING EIGHT-INCHES MEETING THESE REQUIREMENTS MAY BE USED FOR BACKFILL.
- ALL WASTEWATER MAINS SHALL HAVE COMPRESSION OR MECHANICAL JOINTS AS PER 30 TAC §217.53 (C) (2).
- FOR WASTEWATER LINES LESS THAN 24" IN DIAMETER, SELECT INITIAL BACKFILL. THE LINES SHALL BE BACKFILLED IN LIFTS.

a. THE FIRST LIFT SHALL BE SPREAD UNIFORM AND SIMULTANEOUSLY ON EACH SIDE AND UNDER THE SHOULDERS OF THE PIPE TO THE MID POINT OR SPRING LINE OF THE PIPE.

b. THE SECOND LIFT SHALL BE PLACED TO A DEPTH AS SHOWN ON THE PIPE BACKFILL DETAIL. MAINS LARGER THAN 24", 12" MAXIMUM LIFTS SHALL BE USED.

c. ALL MANHOLES MUST BE WATERTIGHT, EITHER MONOLITHIC, CAST-IN-PLACE CONCRETE STRUCTURES OR PREFABRICATED MANHOLES SPECIFICALLY APPROVED BY THE MANHOLES SHALL HAVE WATER-TIGHT RINGS AND COUPLED WITH A WATER-TIGHT COVER. THE MANHOLE COVERS SHALL BE EVERY THIRD MANHOLE IN SEQUENCE SHALL HAVE AN ALTERNATE MEANS OF VENTING. 30 TAC §213.5 (C) (3) (A) AND 30 TAC §217.55 (C).

d. ALL MANHOLES SHALL BE CONSTRUCTED SO THAT THE TOP OF THE RING IS TWO INCHES (2") ABOVE SURROUNDING GROUND EXCEPT WHEN LOCATED IN PAVED AREA. IN PAVED AREAS, THE MANHOLE RING SHALL BE FLUSH WITH PAVEMENT.

e. ALL NEW MANHOLES, UNLESS APPROVED BY CCSUD, ARE TO HAVE COVERS WITH 32" OPENINGS.

f. WASTEWATER MAIN CONNECTIONS TO PRE-CAST MANHOLES WILL BE COMPRESSION JOINTS OR MECHANICAL 'BOOT' TYPE JOINT AS APPROVED BY CCSUD.

g. WASTEWATER MAINS SHALL BE TESTED FROM MANHOLE TO MANHOLE.

h. IN AREAS WHERE A NEW WASTEWATER MANHOLE IS TO BE CONSTRUCTED OVER AN EXISTING WASTEWATER SYSTEM, THE CONTRACTOR'S RESPONSIBILITY IS TO TEST THE EXISTING MANHOLES BEFORE CONSTRUCTION. AFTER THE PROPOSED MANHOLE(S) HAS BEEN BUILT, THE CONTRACTOR SHALL RE-TEST THE EXISTING SYSTEM TO THE SATISFACTION OF THE CONSTRUCTION INSPECTOR. (NO SEPARATE PAY ITEM).

i. WHERE THE MINIMUM 9 FOOT SEPARATION DISTANCE BETWEEN WASTEWATER AND WATER LINES CANNOT BE MAINTAINED, THE TOTAL LENGTH OF WASTEWATER LINES SHALL BE IN STRICT ACCORDANCE WITH TCEQ. THE WASTEWATER LINE SHALL BE CONSTRUCTED OF CAST IRON, DUCTILE IRON OR PVC MEETING THE ASTM SPECIFICATION FOR BOTH PIPES AND JOINTS OF 160 PSI AND SHALL BE IN ACCORDANCE WITH 30 TAC § 217.53 (D) AND 30 TAC § 290.44 (E).

j. NO TESTS WILL BE PERFORMED PRIOR TO 30 DAYS FROM COMPLETE BE STRICTLY ADHERED TO:

a. PULL MANDREL

b. PERFORM FLUSH TEST

c. CLEANING OF ANY DEBRIS

d. FLUSHING OF SYSTEM

e. TV INSPECTION (WITHIN 72 HOURS OF FLUSHING)

f. A MINIMUM OF 3 FEET OF COVER IS TO BE MAINTAINED OVER THE WASTEWATER MAIN AND LATERALS AT SUBGRADE, OTHERWISE CONCRETE END CAPS SHALL BE REQUIRED.

g. TCEQ AND EPA REQUIRE EROSION AND SEDIMENTATION CONTROL FOR THE CONSTRUCTION OF WASTEWATER COLLECTION SYSTEMS. DEVELOPER OR AUTHORIZED ENGINEER SHALL BE RESPONSIBLE FOR EROSION AND SEDIMENTATION CONTROL. NOTES ON THE EROSION AND SEDIMENTATION PLAN AND FIELD SHEET, ALL TEMPORARY EROSION AND SEDIMENTATION CONTROL SHALL BE REMOVED BY THE CONTRACTOR AT FINAL ACCEPTANCE TESTED BY CCSUD.

h. ALL MANHOLES NOT WITHIN PAVED STREETS SHALL HAVE LOCKING CONCRETE COLLAR TO SECURE RING AND COVER TO MANHOLE CONE

PER CCSUD DETAIL DRAWING #329.

i. ALL MANHOLES OVER THE EDWARDS AQUIFER RECHARGE ZONE SHALL HAVE LOCKING CONCRETE COLLAR TO SECURE RING AND COVER TO MANHOLE CONE PER CCSUD DETAIL DRAWING #329.

j. THE CONTRACTOR SHALL BE RESPONSIBLE FOR MEETING 98% COMPACTION ON ALL TRENCHES EXCAVATED FOR THE TRENCHES TO BE APPROVED BY A THIRD PARTY. COMPACTION TESTS WILL BE DONE AT ONE LOCATION POINT RANDOMLY SELECTED OR AS INDICATED BY CCSUD INSPECTOR/TEST ADMINISTRATOR, PER EACH 12-INCH LOOSE LIFT 400 LINEAR FEET AT A MINIMUM. PERMITS WILL NOT BE ACCEPTED AND FINALIZED BY CCSUD WITHOUT THIS REQUIREMENT BEING MET AND VERIFIED BY PROVIDING ALL NECESSARY DOCUMENTED TEST RESULTS.

REFER TO THE COVER SHEET FOR BENCHMARK INFORMATION.

HMT
 ENGINEERING & SURVEYING
 290 S. CASTELL AVE., STE. 100
 NEW BRAUNFELS, TX 78130
 TBPELS FIRM F-105061
 TBPELS FIRM 105360



01/22/2026
 STATE OF TEXAS
 MATTHEW T. ABELSEN
 154638
 LICENSED PROFESSIONAL ENGINEER
 Matthew T. Abelsen

WASTEWATER LINE A PLAN AND PROFILE (1 OF 2)
 KYNDWOOD SUBDIVISION, UNIT 5
 NEW BRAUNFELS, TEXAS

NO. REVISION SERVICE UPDATED
 1/22/2026

DATE: JANUARY 2026
 DRAWN BY: MK
 DESIGNED BY: MA
 REVIEWED BY: MA
 HMT PROJECT NO.: 337.081
 SHEET C7.02

TRENCH EXCAVATION SAFETY PROTECTION
 CONTRACTOR AND/OR CONTRACTOR'S INDEPENDENTLY RETAINED EMPLOYEE OR STRUCTURAL DESIGN/GEOTECHNICAL/SAFETY/EQUIPMENT CONSULTANT, IF ANY, SHALL REVIEW THESE PLANS AND AVAILABLE GEOTECHNICAL INFORMATION AND THE ANTICIPATED INSTALLATION SITE(S) WITHIN THE PROJECT WORK AREA IN ORDER TO IMPLEMENT CONTRACTOR'S TRENCH EXCAVATION SAFETY PROTECTION SYSTEMS, PROGRAMS AND/OR PROCEDURES FOR THE PROJECT DESCRIBED IN THE CONTRACT DOCUMENTS. THE CONTRACTOR'S IMPLEMENTATION OF THESE SYSTEMS, PROGRAMS AND/OR PROCEDURES SHALL PROVIDE FOR ADEQUATE TRENCH EXCAVATION SAFETY PROTECTION THAT COMPLY WITH AS A MINIMUM, OSHA STANDARDS FOR TRENCH EXCAVATIONS. SPECIFICALLY, CONTRACTOR AND/OR CONTRACTOR'S INDEPENDENTLY RETAINED EMPLOYEE OR SAFETY CONSULTANT SHALL IMPLEMENT A TRENCH SAFETY PROGRAM IN ACCORDANCE WITH OSHA STANDARDS GOVERNING THE PRESENCE AND ACTIVITIES OF INDIVIDUALS WORKING IN AND AROUND TRENCH EXCAVATIONS.

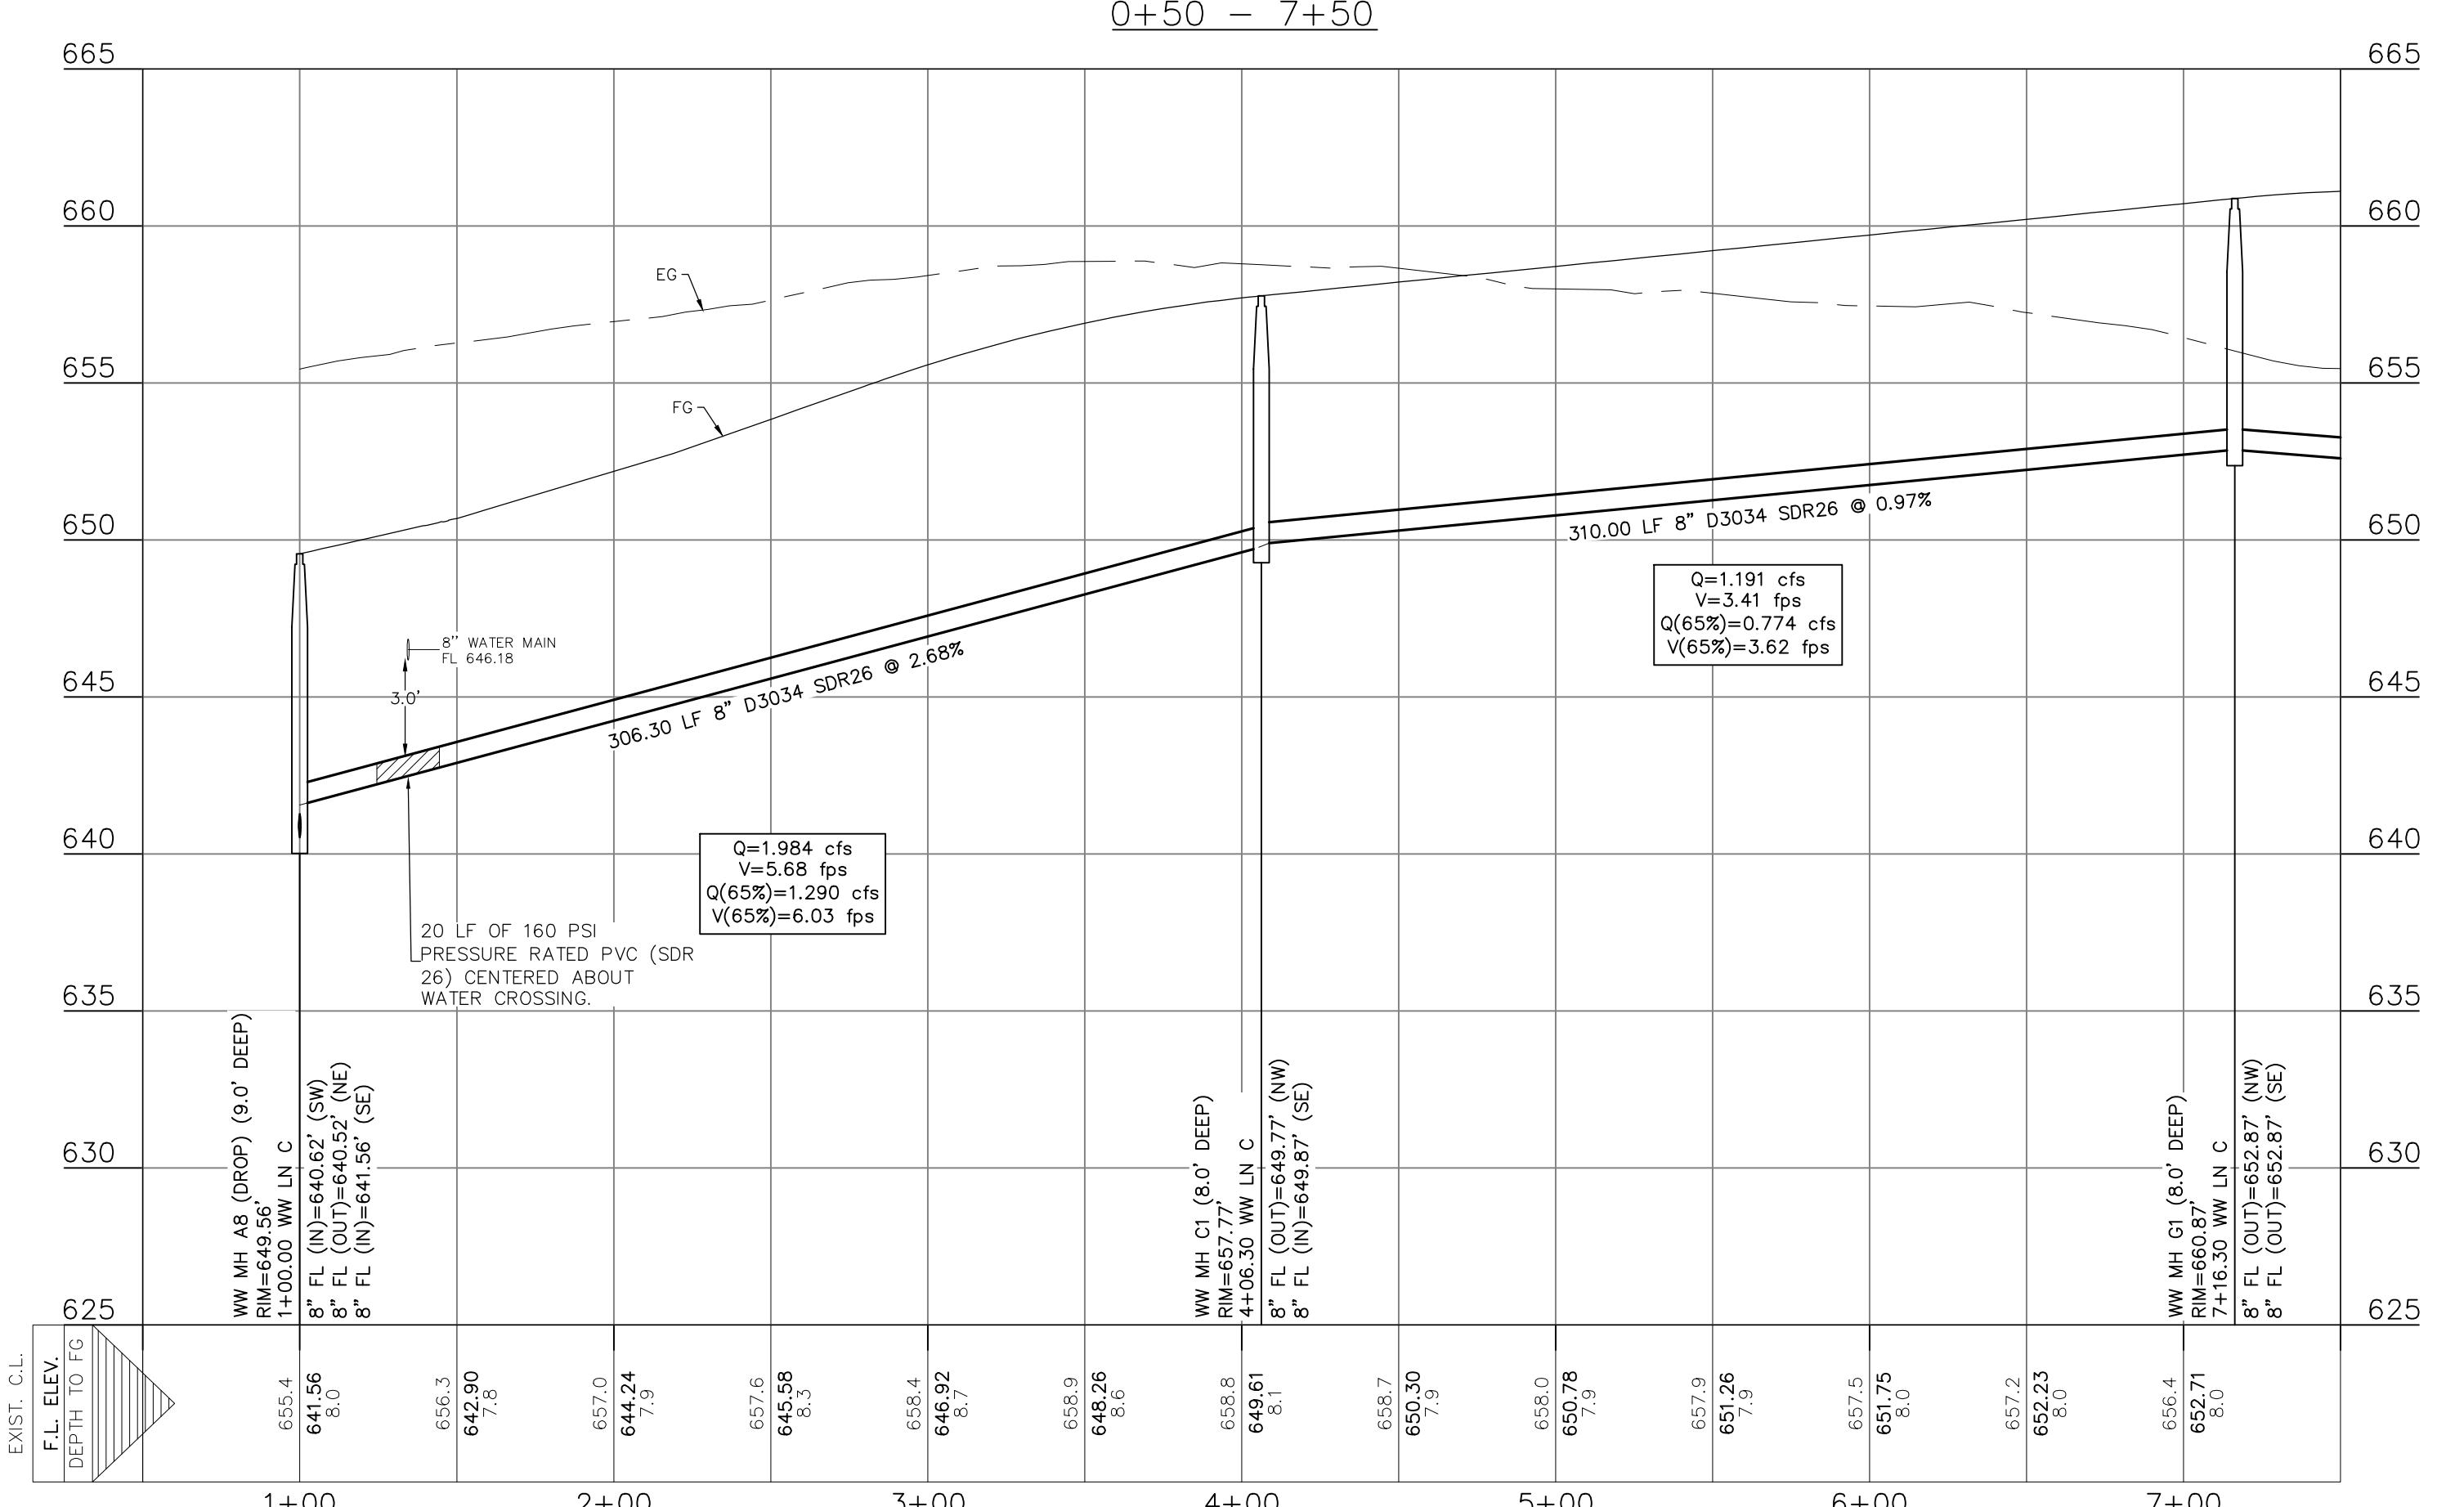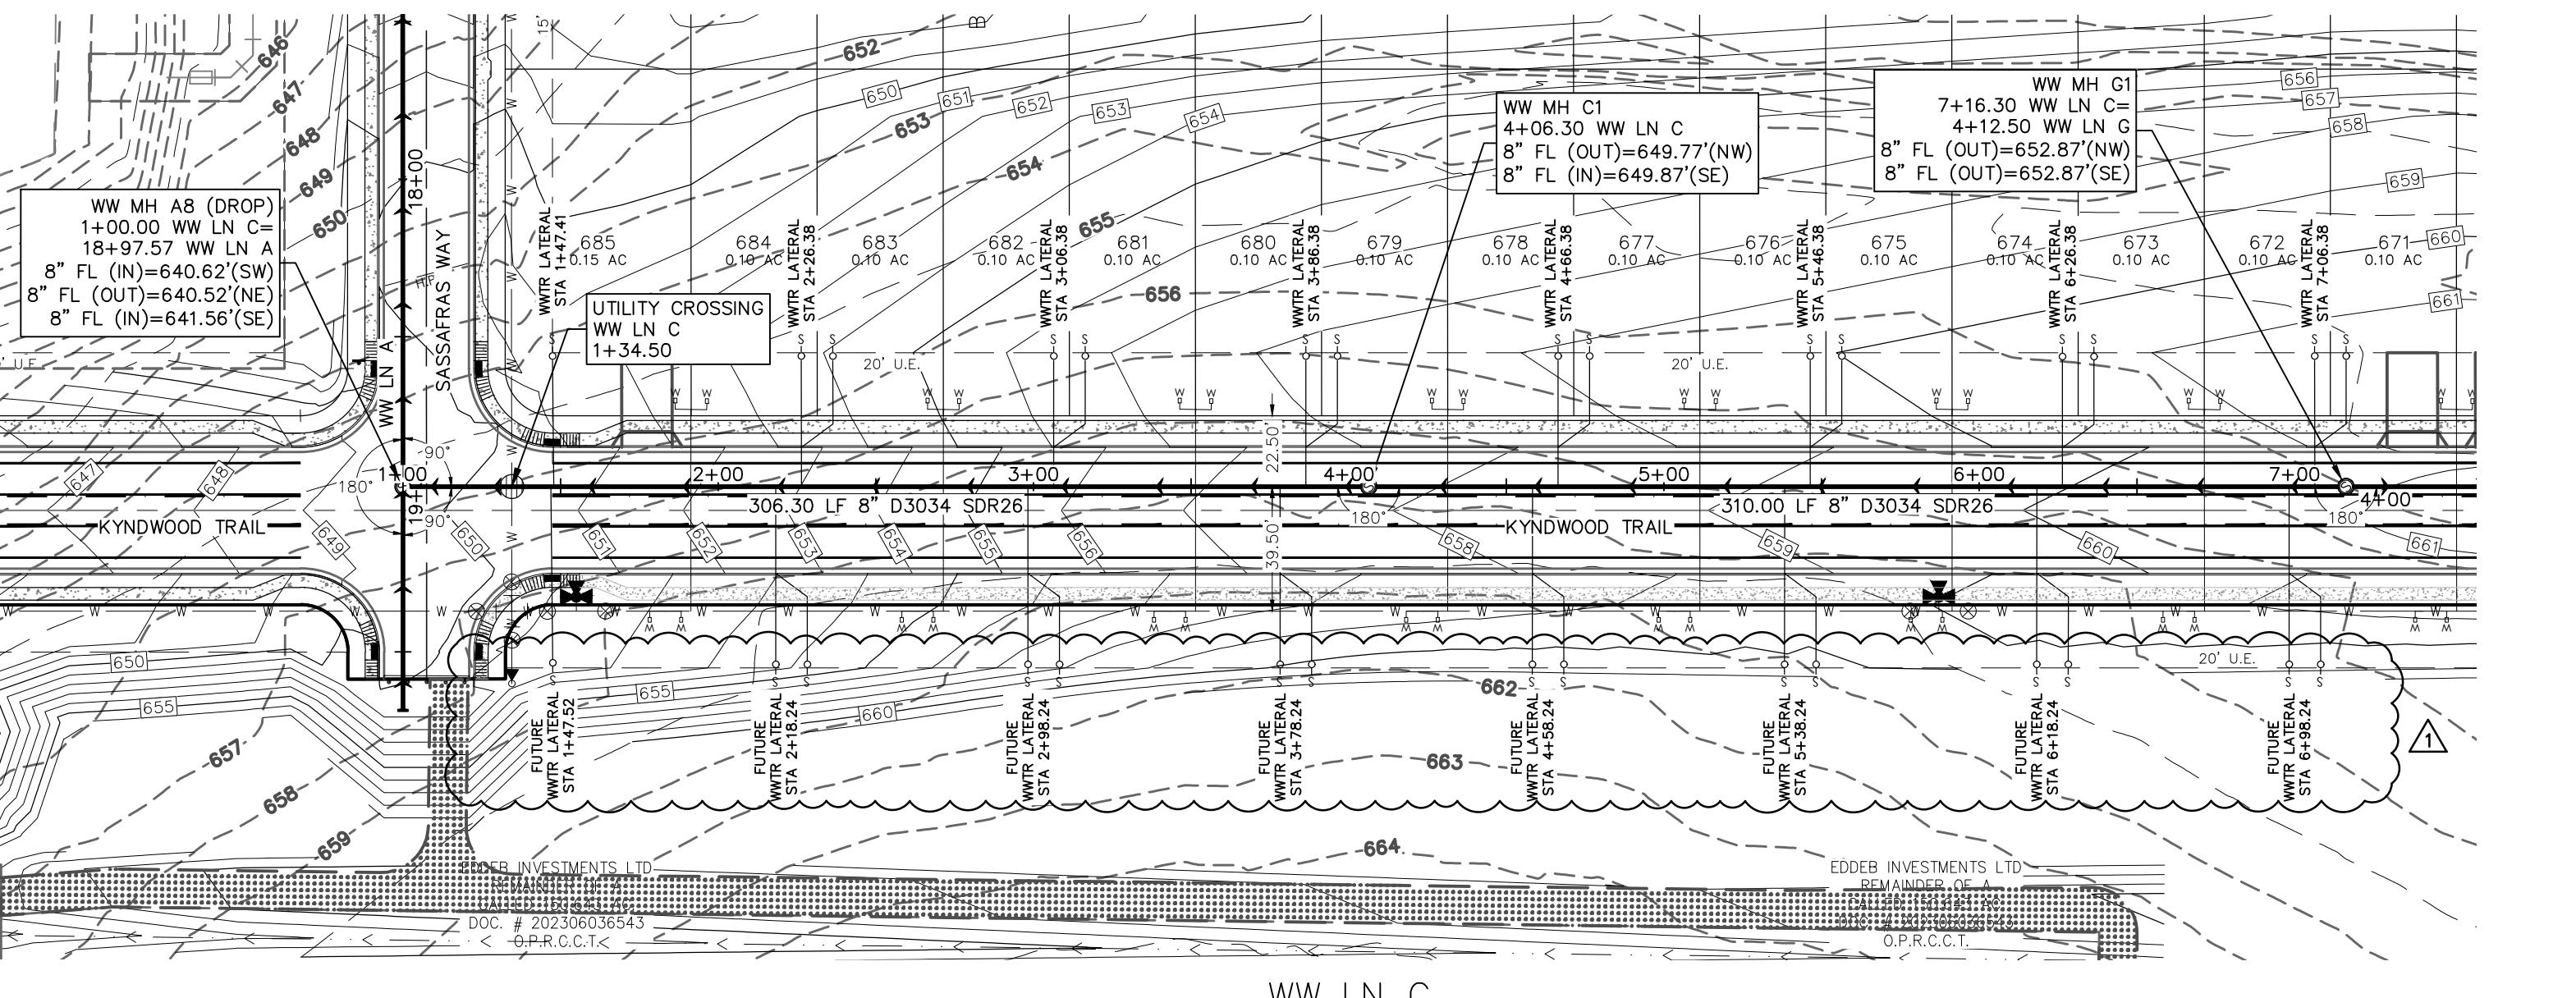

UTILITY TRENCH COMPACTION (DEEP)
 CITY REQUIREMENTS FOR TESTING SHALL BE ADHERED TO, IN CASES WHERE TRENCH DEPTHS DO NOT ALLOW TECHNICIANS ACCESS, METHODS FOR TESTING SHALL BE PROPOSED AND APPROVED PRIOR TO CONSTRUCTION COMMENCING.


THIS PROJECT INCLUDES UTILITY INSTALLATIONS GREATER THAN 5'-FEET IN DEPTH LOCATED IN PUBLIC RIGHT-OF-WAY OR EXCAVATED DEEP TRENCHES. DEEP TRENCHES POSE COMPACTION TESTING AND CONSTRUCTION CHALLENGES AND CITY METHODS FOR TESTING AND COMPACTION MAY NOT BE ACHIEVABLE. A UTILITY COMPACTION PLAN WILL BE REQUIRED AND MUST BE SUBMITTED FOR APPROVAL TO CITY PRIOR TO UTILITY INSTALLATION.

UTILITY TRENCH COMPACTION
 ALL UTILITY TRENCH COMPACTION TESTS WITHIN THE STREET PAVEMENT/SIDEWALK SECTION SHALL BE THE RESPONSIBILITY OF THE CONTRACTOR. GEOTECHNICAL ENGINEERS AND MATERIALS SHALL BE PLACED IN UNIFORM LAYERS NOT TO EXCEED TWELVE INCHES (12") THICK. DETERMINE THE MAXIMUM LIFT THICKNESS BASED ON THE ABILITY OF THE COMPACTION OPERATION AND EQUIPMENT USED TO MEET THE REQUIRED DENSITY. EACH LAYER OF MATERIAL SHALL BE COMPACTED TO A MINIMUM 95% DENSITY AND TESTED FOR DENSITY AND MOISTURE.

IN ACCORDANCE WITH TEST METHODS TEX-113-E, TEX-114-E, TEX-115-E. THE NUMBER OF TESTS TO BE APPROVED BY THE CITY OF NEW BRAUNFELS STREET INSPECTOR, AT A MINIMUM, TESTS SHALL BE TAKEN EVERY 200 LF FOR EACH LIFT AND EVERY OTHER SERVICE LINE. UPON COMPLETION OF TESTING THE GEOTECHNICAL ENGINEER SHALL PROVIDE THE CITY OF NEW BRAUNFELS STREET INSPECTOR WITH ALL TESTING DOCUMENTATION AND A CERTIFICATION STATING THAT THE PLACEMENT OF FILM MATERIAL HAS BEEN COMPLETED IN ACCORDANCE WITH THE PLANS. ADDITIONAL DENSITY TESTS MAY BE REQUESTED BY THE CITY OF NEW BRAUNFELS INSPECTOR.

REFER TO THE COVER SHEET FOR BENCHMARK INFORMATION.

THE LOCATION OF ALL EXISTING UNDERGROUND UTILITIES ARE SHOWN IN APPROXIMATE LOCATIONS ONLY. THE CONTRACTOR SHALL DETERMINE THE EXACT LOCATION OF ALL EXISTING UTILITIES BEFORE COMMENCING WORK. THE CONTRACTOR WILL AGREE TO BE FULLY RESPONSIBLE FOR ANY AND ALL DAMAGES WHICH MIGHT BE INCURRED BY THEIR FAILURE TO EXACTLY LOCATE AND PRESERVE ANY AND ALL UNDERGROUND UTILITIES, STRUCTURES OR FACILITIES. CONTRACTOR SHALL NOTIFY ENGINEER OF ANY DISCREPANCIES 24-HOURS PRIOR TO COMMENCING CONSTRUCTION.

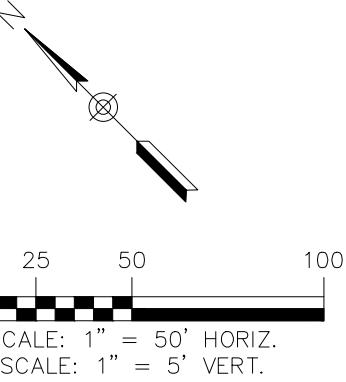

LEGEND

| | |
|---------|-----------------------------|
| 700 | EXISTING CONTOURS |
| 700 | PROPOSED CONTOURS |
| B.L. | BUILDING SETBACK LINE |
| U.E. | UTILITY EASEMENT |
| D.E. | DRAINAGE EASEMENT |
| WW | EXISTING WASTEWATER LINE |
| WW | PROPOSED WASTEWATER MANHOLE |
| WW | PROPOSED WASTEWATER LINE |
| WW | PROPOSED WASTEWATER SERVICE |
| Utility | UTILITY CROSSING |

UTILITY NOTES:

1. ALL UTILITIES TO BE CONSTRUCTED & TESTED PRIOR TO THE STREETS.
2. NO VALVES, HYDRANTS, ETC. SHALL BE CONSTRUCTED WITHIN CURB SIDEWALKS OR DRIVEWAYS.
3. ALL SEWER PIPE ASTM D3034 (TYPICAL OF OTHER SHEETS) (115 PSI) SDR 26 UNLESS CALLED OUT OTHERWISE.
4. REFER TO THE COVER SHEET FOR BENCHMARK INFORMATION.
5. AT WATER CROSSINGS INCLUDING FIRE HYDRANT LEADS, WHITE COLOR GASKETED ASTM D2241 SDR 26 PIPE AND FITTINGS SHALL BE USED FOR MAINS AND LATERALS.
6. REFER TO ALL CCSUD NOTES ON SHEET CO.02.

CRYSTAL CLEAR SPECIAL UTILITY DISTRICT (CCSUD) WASTEWATER NOTES

1. THE CONTRACTOR SHALL MAINTAIN SERVICE TO EXISTING THE WASTEWATER SYSTEM AT ALL TIMES DURING CONSTRUCTION.
2. A MINIMUM OF 8" WASTEWATER PIPE AND FITTINGS (P.V.C. SDR-26, ASTM D3034, SDR-26) SHALL BE REQUIRED FOR ALL LATERALS.
3. ALL EXISTING WASTEWATER SERVICE LATERALS SHALL BE EXTENDED TO THE PROPERTY LINE AND CLEANOUTS SHALL BE INSTALLED AT THE PROPERTY LINE. SERVICES TO LOTS WILL EXTEND FOUR (4) FEET PAST THE UNDERGROUND ELECTRIC CONDUIT. ELECTRIC IS INSTALLED IN THE FRONT EASEMENT. ALL SEWER CLEANOUTS THAT LEAD TO CCSUD MAINS SHALL BE INSTALLED WITH A PROTECTIVE UTILITY SHROUD AND PIVOTING MARKER POLE DURING TIME OF CONSTRUCTION.
4. PIPE BEDDING MATERIAL OF WASTEWATER MAINS SHALL BE COMPOSED OF WELL GRADED, CRUSHED STONE OR GRAVEL PER SECTION 01230 OF CCSUD'S SPECIFICATIONS.
5. SECONDARY AND GENERAL BACKFILL OF WASTEWATER MAINS SHALL BE APPROVED SOIL MATERIALS FOR BACKFILL AND FILL, FREE OF CLAY, ROCK, OR GRAVEL LARGER THAN 2-INCHES IN ANY DIMENSION, DEBRIS, WASTE, FROZEN MATERIALS, VEGETABLE, AND OTHER ORGANIC MATTER AND DELAYED EXPANSION MATERIALS. EXCAVATED MATERIALS MEETING THESE REQUIREMENTS MAY BE USED FOR BACKFILL.
6. ALL WASTEWATER MAINS SHALL HAVE COMPRESSION OR MECHANICAL JOINTS AS PER 30 TAC §217.53 (C) (2).
7. FOR WASTEWATER LINES LESS THAN 24" IN DIAMETER, SELECT INITIAL BACKFILL MATERIALS AS INDICATED IN THE LIFT.
8. a. THE FIRST LIFT SHALL BE SPREAD UNIFORMLY AND SIMULTANEOUSLY ON EACH SIDE AND UNDER THE SHOULDERS OF THE PIPE TO THE MID POINT OR SPRING LINE OF THE PIPE.
b. THE SECOND LIFT SHALL BE PLACED TO A DEPTH AS SHOWN ON THE PIPE BACKFILL DETAIL. MAINS LARGER THAN 24", 12" MAXIMUM LIFTS SHALL BE USED.
9. ALL MANHOLES MUST BE WATERTIGHT, EITHER MONOLITHIC, CAST-IN-PLACE CONCRETE STRUCTURES OR PREFABRICATED MANHOLES SPECIFICALLY APPROVED BY THE MANHOLES SHALL HAVE WATER-TIGHT RINGS AND COVERS WHICH ARE EASILY REMOVED FOR INSPECTION. THE MANHOLE COVERS SHALL BE EVERY THIRD MANHOLE IN SEQUENCE SHALL HAVE AN ALTERNATE MEANS OF VENTING. 30 TAC §213.5 (C) (3) (A) AND 30 TAC §217.55 (C).
10. ALL MANHOLES SHALL BE CONSTRUCTED SO THAT THE TOP OF THE RING IS TWO INCHES (2") ABOVE SURROUNDING GROUND EXCEPT WHEN LOCATED IN PAVED AREA. IN PAVED AREAS, THE MANHOLE RING SHALL BE FLUSH WITH PAVEMENT.
11. ALL NEW MANHOLES, UNLESS APPROVED BY CCSUD, ARE TO HAVE COVERS WITH 32" OPENINGS.
12. WASTEWATER MAINS SHALL BE TESTED FROM MANHOLE TO MANHOLE.
13. IN AREAS WHERE A NEW WASTEWATER MANHOLE IS TO BE CONSTRUCTED OVER AN EXISTING MANHOLE, THE CONTRACTOR'S RESPONSIBILITY IS TO TEST THE EXISTING MANHOLE BEFORE CONSTRUCTION. AFTER THE PROPOSED MANHOLE(S) HAS BEEN BUILT, THE CONTRACTOR SHALL RE-TEST THE EXISTING SYSTEM TO THE SATISFACTION OF THE CONSTRUCTION INSPECTOR. (N. SEPARATE PAY ITEM).
14. WHERE THE MINIMUM 9 FOOT SEPARATION DISTANCE BETWEEN WASTEWATER AND WATER LINES CANNOT BE MAINTAINED, THE TOTAL LENGTH OF WASTEWATER LINES SHALL BE IN STRICT ACCORDANCE WITH TCEQ. THE WASTEWATER LINE SHALL BE CONSTRUCTED OF CAST IRON, DUCTILE IRON OR PVC MEETING THE ASTM SPECIFICATION FOR BOTH PIPES AND JOINTS OF 160 PSI AND SHALL BE IN ACCORDANCE WITH 30 TAC § 217.53 (D) AND 30 TAC § 290.44 (E).
15. NO WORK WILL BE PERFORMED PRIOR TO 30 DAYS FROM COMPLETE INSTALLATION OF THE WASTEWATER LINES. THE FOLLOWING SEQUENCE WILL BE STRICTLY ADHERED TO:
 - a. PULL MANDREL
 - b. PERFORM FLUSH TEST
 - c. CLEANING OF ANY DEBRIS
 - d. FLUSHING OF SYSTEM
 - e. TV INSPECTION (WITHIN 72 HOURS OF FLUSHING)
16. A MINIMUM OF 3 FEET OF COVER IS TO BE MAINTAINED OVER THE WASTEWATER MAIN AND LATERALS AT SUBGRADE, OTHERWISE CONCRETE ENCLOSURE SHALL BE REQUIRED.
17. TCEQ AND EPA REQUIRE EROSION AND SEDIMENTATION CONTROL FOR THE CONSTRUCTION OF WASTEWATER COLLECTION SYSTEMS. DEVELOPER OR AUTHORIZED REPRESENTATIVE SHALL PROVIDE EROSION AND SEDIMENTATION CONTROL NOTES ON THE CONSTRUCTION PLAN AND FIELD SHEET. ALL TEMPORARY EROSION AND SEDIMENTATION CONTROL SHALL BE REMOVED BY THE CONTRACTOR AT FINAL ACCEPTANCE OF THE PROJECT BY CCSUD.
18. ALL MANHOLES NOT WITHIN PAVED STREETS SHALL HAVE LOCKING CONCRETE COLLAR TO SECURE RING AND COVER TO MANHOLE CONE DRAWING #329.
19. ALL MANHOLES OVER THE EDWARDS AQUIFER RECHARGE ZONE SHALL HAVE LOCKING CONCRETE COLLAR TO SECURE RING AND COVER TO MANHOLE CONE PER CCSUD DETAIL DRAWING #329.
20. THE CONTRACTOR SHALL BE RESPONSIBLE FOR MEETING 98% COMPACTION ON ALL EXCAVATED TRENCHES. PLANS FOR THE TESTS WILL BE APPROVED BY A THIRD PARTY. COMPACTION TESTS WILL BE DONE AT ONE LOCATION POINT RANDOMLY SELECTED OR AS INDICATED BY CCSUD INSPECTOR/TEST ADMINISTRATOR, PER EACH 12-INCH LOOSE LIFT 400 LINEAR FEET AT A MINIMUM. PERMITS WILL NOT BE ACCEPTED AND FINALIZED BY CCSUD WITHOUT THIS REQUIREMENT BEING MET AND VERIFIED BY PROVIDING ALL NECESSARY DOCUMENTED TEST RESULTS.

REFER TO THE COVER SHEET FOR BENCHMARK INFORMATION.


290 S. CASTELL AVE., STE. 100
 NEW BRAUNFELS, TX 78130
 TBPELS FIRM F-10961
 TBPELS FIRM 1053600
HMT
 ENGINEERING & SURVEYING

WASTEWATER SUBDIVISION, UNIT 5 KYNDWOOD SUBDIVISION, NEW BRAUNFELS, TEXAS

| NO. | REVISION DESCRIPTION | REVISION DATE |
|-----|-----------------------------|---------------|
| | WASTEWATER SERVICES UPDATED | 1/22/2026 |

| DATE: | JANUARY 2026 |
|------------------|--------------|
| DRAWN BY: | MK |
| DESIGNED BY: | MA |
| REVIEWED BY: | MA |
| HMT PROJECT NO.: | 337.081 |

SHEET
C7.05

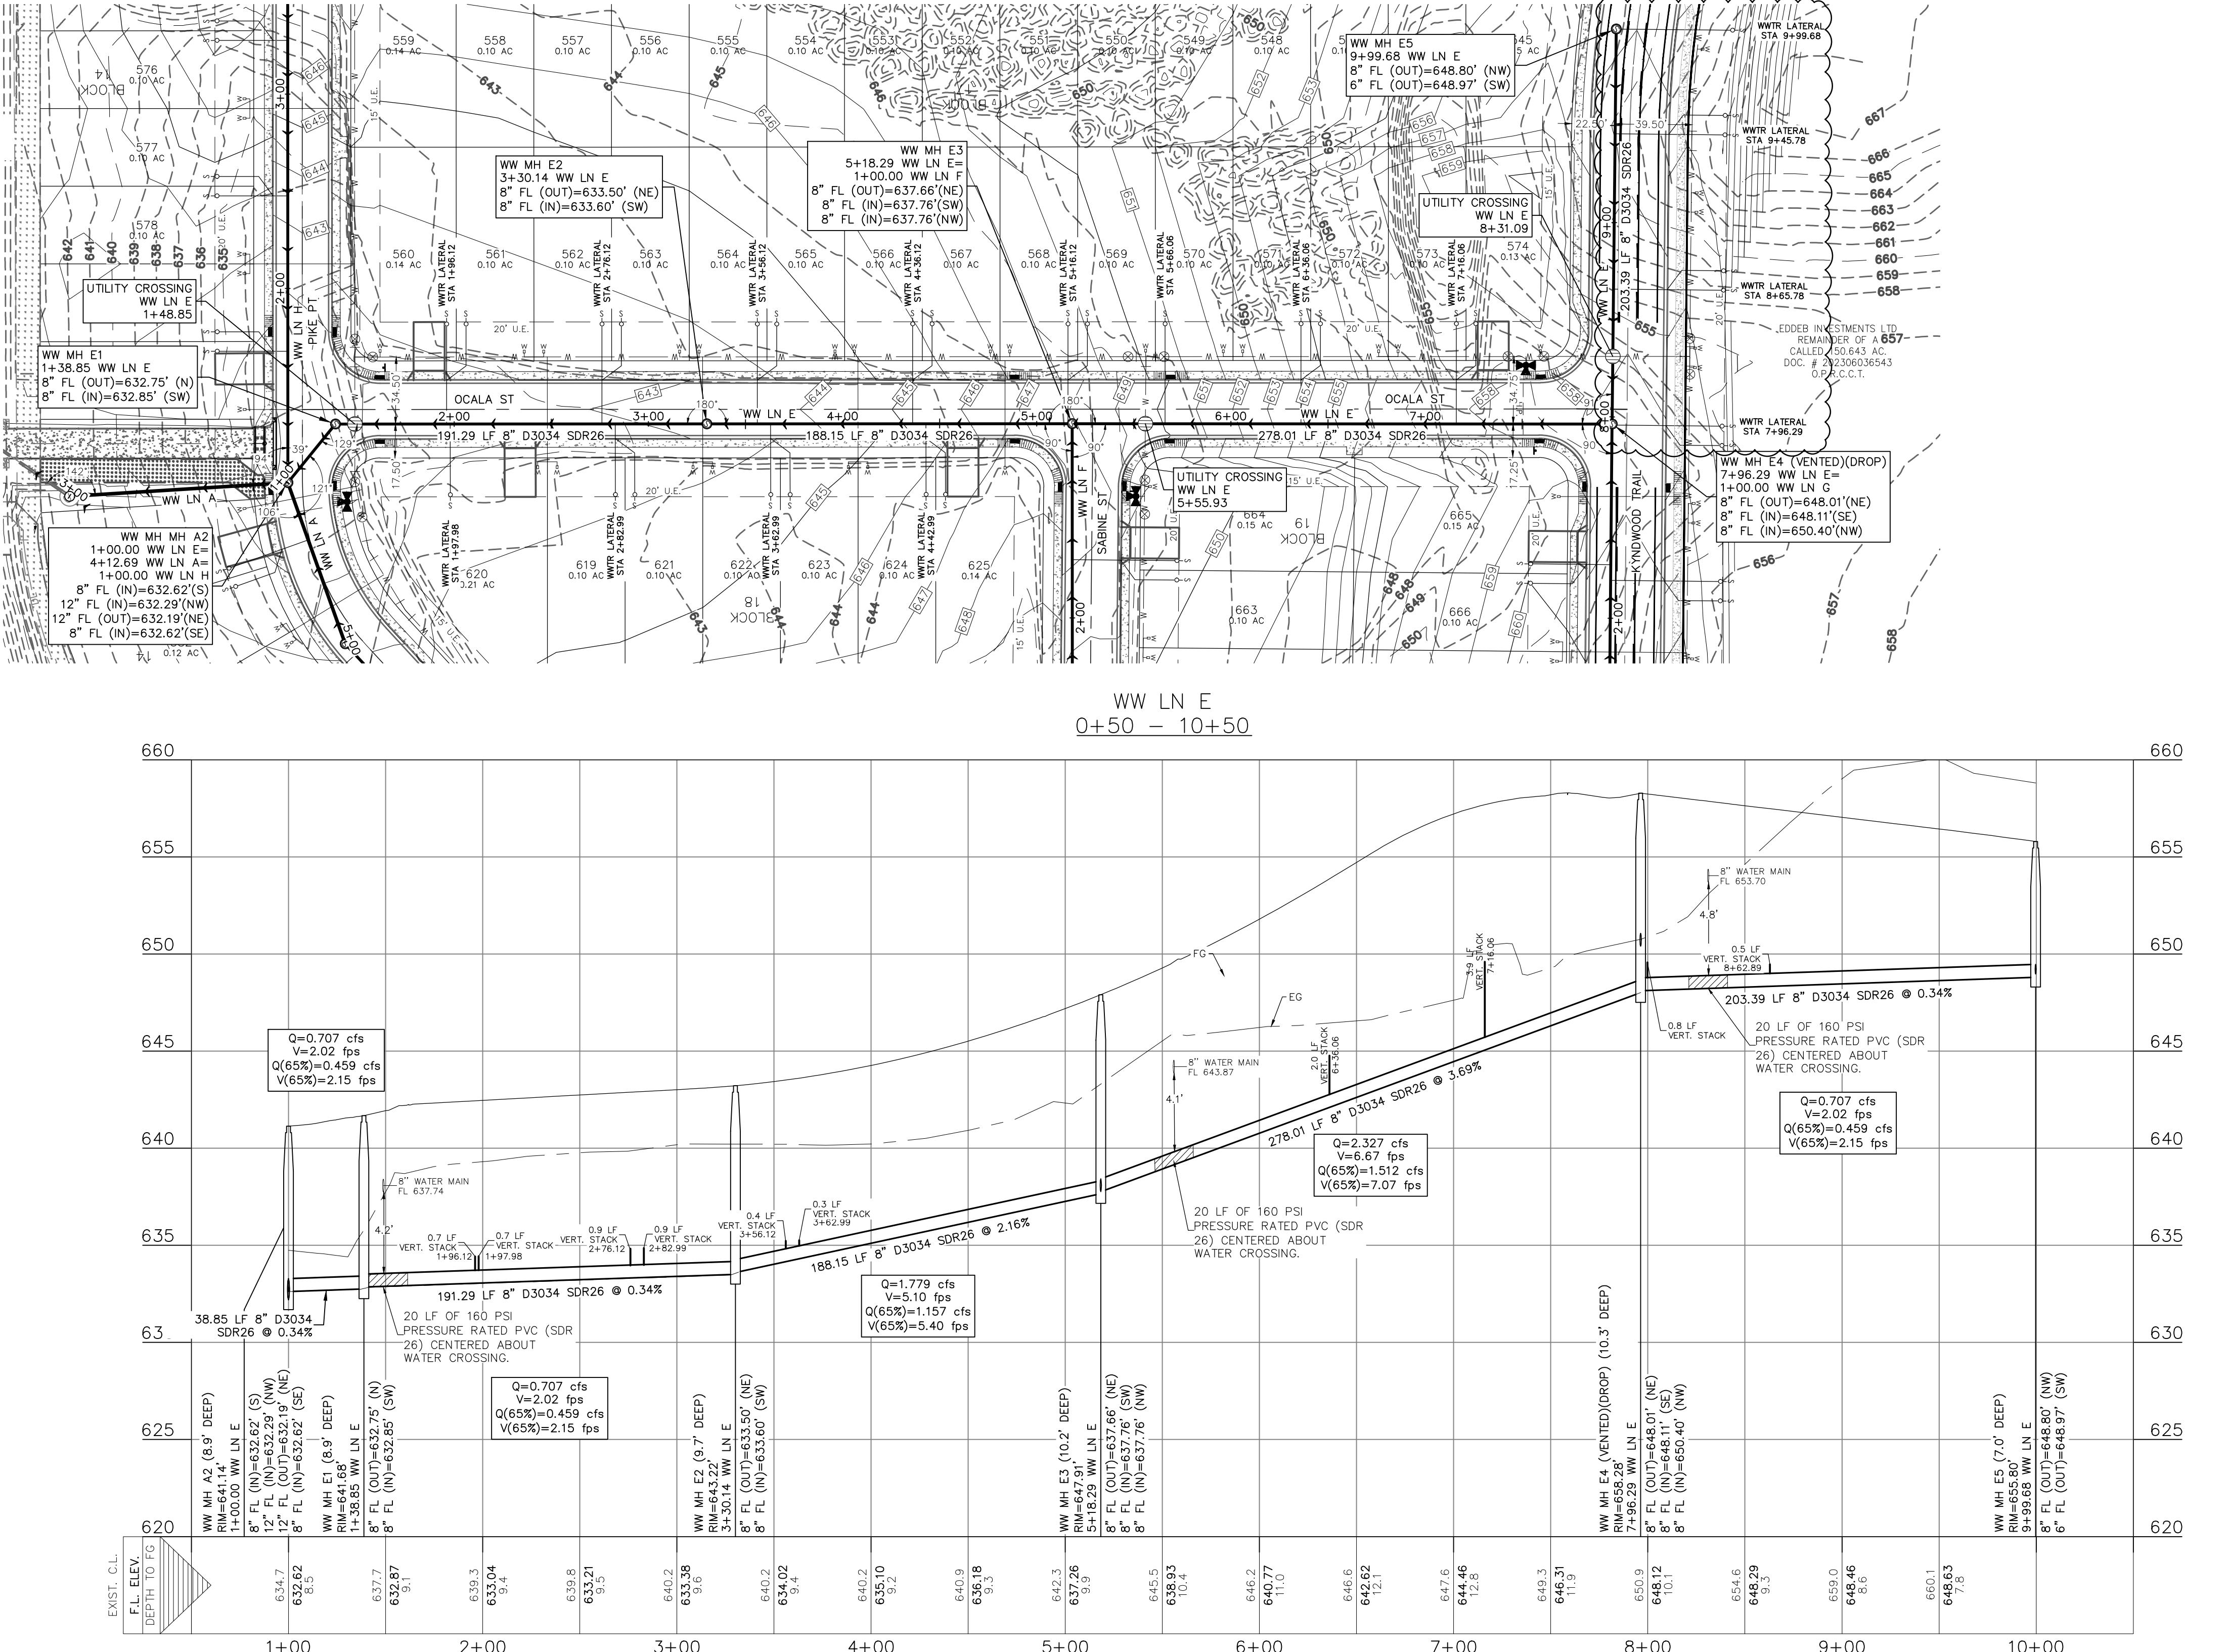

TRENCH EXCAVATION SAFETY PROTECTION
 CONTRACTOR AND/OR CONTRACTOR'S INDEPENDENTLY RETAINED EMPLOYEE OR STRUCTURAL DESIGN/GEOTECHNICAL/SAFETY/EQUIPMENT CONSULTANT, IF ANY, SHALL REVIEW THESE PLANS AND AVAILABLE GEOTECHNICAL INFORMATION AND THE ANTICIPATED INSTALLATION SITE(S) WITHIN THE PROJECT WORK AREA IN ORDER TO IMPLEMENT CONTRACTOR'S TRENCH EXCAVATION SAFETY PROTECTION SYSTEMS, PROGRAMS AND/OR PROCEDURES FOR THE PROJECT DESCRIBED IN THE CONTRACT DOCUMENTS. THE CONTRACTOR'S IMPLEMENTATION OF THESE SYSTEMS, PROGRAMS AND/OR PROCEDURES SHALL PROVIDE FOR ADEQUATE TRENCH EXCAVATION SAFETY PROTECTION THAT COMPLY WITH AS A MINIMUM, OSHA STANDARDS FOR TRENCH EXCAVATIONS. SPECIFICALLY, CONTRACTOR AND/OR CONTRACTOR'S INDEPENDENTLY RETAINED EMPLOYEE OR SAFETY CONSULTANT SHALL IMPLEMENT A TRENCH SAFETY PROGRAM IN ACCORDANCE WITH OSHA STANDARDS GOVERNING THE PRESENCE AND ACTIVITIES OF INDIVIDUALS WORKING IN AND AROUND TRENCH EXCAVATIONS.

UTILITY TRENCH COMPACTION (DEEP)
 CITY REQUIREMENTS FOR TESTING SHALL BE ADHERED TO, IN CASES WHERE TRENCH DEPTHS DO NOT ALLOW TECHNICIANS ACCESS, METHODS FOR TESTING SHALL BE PROPOSED AND APPROVED PRIOR TO CONSTRUCTION COMMENCING.
 THIS PROJECT INCLUDES UTILITY INSTALLATIONS GREATER THAN 5 FEET IN DEPTH LOCATED IN PUBLIC RIGHT-OF-WAY OR EXCAVATED DEEP TRENCHES. DEEP TRENCHES POSE COMPACTION TESTING AND CONSTRUCTION CHALLENGES AND CITY METHODS FOR TESTING AND COMPACTION MAY NOT BE ACHIEVABLE. A UTILITY COMPACTION PLAN WILL BE REQUIRED AND MUST BE SUBMITTED FOR APPROVAL TO CITY PRIOR TO UTILITY INSTALLATION.
 IN ACCORDANCE WITH TEST METHODS TEX-113-E, TEX-114-E, TEX-115-E. THE NUMBER OF UTILITY TESTS SHALL BE DETERMINED BY THE GEOTECHNICAL ENGINEER AND APPROVED BY THE CITY OF NEW BRAUNFELS STREET INSPECTOR. AT A MINIMUM, TESTS SHALL BE TAKEN EVERY 200 LF FOR EACH LIFT AND EVERY OTHER SERVICE LINE. UPON COMPLETION OF TESTING THE GEOTECHNICAL ENGINEER SHALL PROVIDE THE CITY OF NEW BRAUNFELS STREET INSPECTOR WITH ALL TESTING DOCUMENTATION AND A CERTIFICATION STATING THAT THE PLACEMENT OF FILM MATERIAL HAS BEEN COMPLETED IN ACCORDANCE WITH THE PLANS. ADDITIONAL DENSITY TESTS MAY BE REQUESTED BY THE CITY OF NEW BRAUNFELS INSPECTOR.

UTILITY TRENCH COMPACTION
 ALL UTILITY TRENCH COMPACTION TESTS WITHIN THE STREET PAVEMENT/SIDEWALK SECTION SHALL BE THE RESPONSIBILITY OF THE DEVELOPER/CONTRACTOR. THE GEOTECHNICAL ENGINEER OR WATER LINE SHALL BE PLACED IN UNIFORM LAYERS NOT TO EXCEED TWELVE INCHES (12") DEEP. DETERMINE THE MAXIMUM LIFT THICKNESS BASED ON THE ABILITY OF THE COMPACTION OPERATION AND EQUIPMENT USED TO MEET THE REQUIRED DENSITY. EACH LAYER OF MATERIAL SHALL BE COMPACTED TO A MINIMUM 95% DENSITY AND TESTED FOR DENSITY AND MOISTURE.

IN

ACCORDANCE

WITH

TEST

METHODS

TEX-113-E,

TEX-114-E,

TEX-115-E.

THE

NUMBER

OF

UTILITY

TESTS

SHALL

BE

DETERMINED

BY

THE

GEOTECHNICAL

ENGINEER

AND

APPROVED

BY

THE

CITY

OF

NEW

BRAUNFELS

STREET

INSPECTOR.

AT

A

MINIMUM

TESTS

SHALL

BE

TAKEN

EACH

LIFT

AND

EVERY

OTHER

SERVICE

LINE.

UPON

COMPLETION

OF

TESTING

THE

GEOTECHNICAL

ENGINEER

SHALL

PROVIDE

THE

CITY

OF

NEW

BRAUNFELS

STREET

INSPECTOR

WITH

ALL

TESTING

DOCUMENTATION

AND

A CERTIFICATION

STATING

THAT

THE

PLACEMENT

OF

FILM

MATERIAL

HAS

BEEN

COMPLETED

IN

ACCORDANCE

WITH

THE

PLANS

ADDITIONAL

DENSITY

TESTS

MAINTAIN

IN

ACCORDANCE

WITH

THE

PLANS

AS

REQUESTED

BY

THE

CITY

OF

NEW

BRAUNFELS

STREET

INSPECTOR.

REFER TO THE COVER SHEET FOR BENCHMARK INFORMATION.

THE LOCATION OF ALL EXISTING UNDERGROUND UTILITIES ARE SHOWN IN APPROXIMATE LOCATIONS ONLY. THE CONTRACTOR SHALL DETERMINE THE EXACT LOCATION OF ALL EXISTING UTILITIES BEFORE COMMENCING WORK. THE CONTRACTOR WILL AGREE TO BE FULLY RESPONSIBLE FOR ANY AND ALL DAMAGES WHICH MIGHT BE INCURRED BY THEIR FAILURE TO EXACTLY LOCATE AND PRESERVE ANY AND ALL UNDERGROUND UTILITIES, STRUCTURES OR FACILITIES. CONTRACTOR SHALL NOTIFY ENGINEER OF ANY DISCREPANCIES 24-HOURS PRIOR TO COMMENCING CONSTRUCTION.

DATE: JANUARY 2026

DRAWN BY: MK

DESIGNED BY: MA

REVIEWED BY: MA

HMT PROJECT NO.: 337.081

SHEET

C7.06

HMT
 ENGINEERING & SURVEYING
 290 S. CASTELL AVE., STE. 100
 NEW BRAUNFELS, TX 78130
 TBPELS FIRM F-10961
 TBPELS FIRM 1053600

01/22/2026
 STATE OF TEXAS
 MATTHEW T. ABELSEN
 154638
 LICENSED PROFESSIONAL ENGINEER
 Matthew T. Abelsen

