


Date: Jan 12, 2024, 8:28am User ID: Richardgarcia
File: P:\88\34\25\Design\Civil\WDA-883425.dwg

This document has been produced from material that was stored AND/OR TRANSMITTED ELECTRONICALLY AND MAY HAVE BEEN INADVERTENTLY ALTERED. RELY ONLY ON FINAL HARD COPY MATERIALS BEARING THE CONSULTANT'S ORIGINAL SIGNATURE AND SEAL. AERIAL IMAGERY PROVIDED BY GOOGLE UNLESS OTHERWISE NOTED. Imagery © 2016, CAPOCO, Digital Globe, Texas Orthoregistry Program, USDA Farm Service Agency.

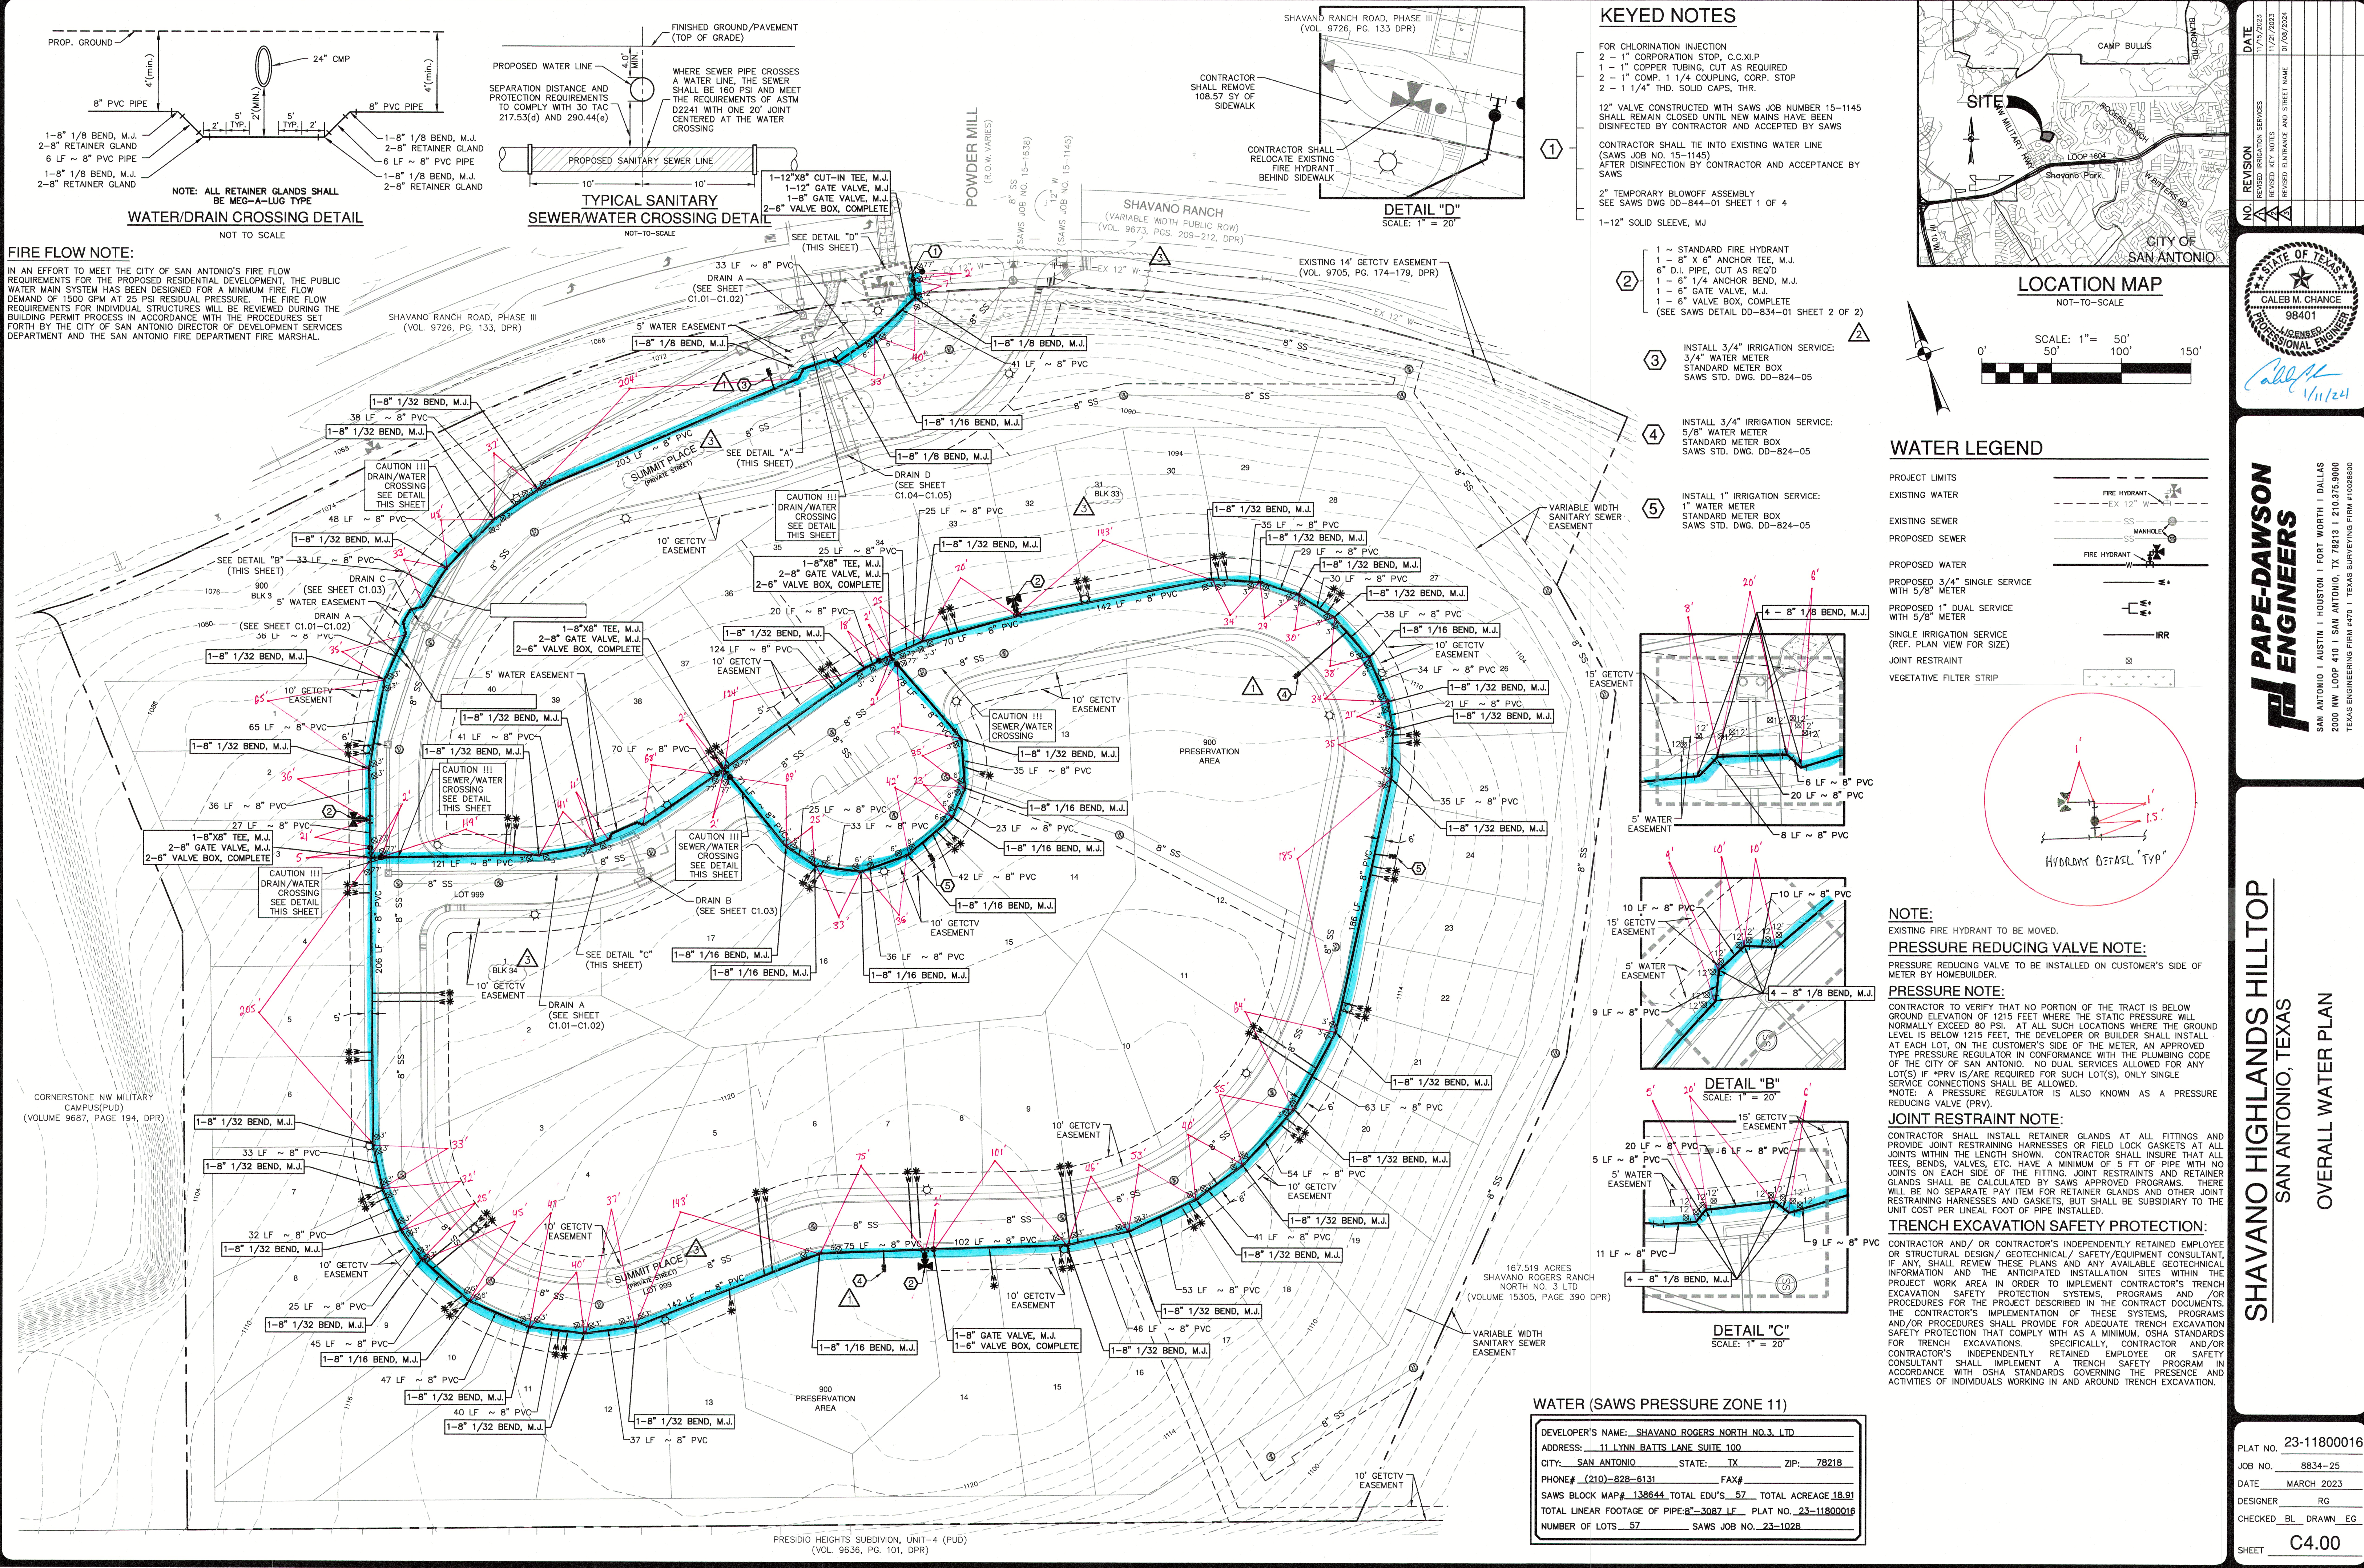

PAPE-DAWSON ENGINEERS

SAN ANTONIO | AUSTIN | HOUSTON | FORT WORTH | DALLAS
2000 NW LOOP 410 | SAN ANTONIO, TX 78213 | 210.375.9000
TEXAS ENGINEERING FIRM #470 | TEXAS SURVEYING FIRM #10038600

SHAVANO HIGHLANDS HILLTOP
SAN ANTONIO, TEXAS

OVERALL WATER PLAN

PLAT NO. 23-11800016
JOB NO. 8834-25
DATE MARCH 2023
DESIGNER RG
CHECKED BL DRAWN EG
SHEET C4.00