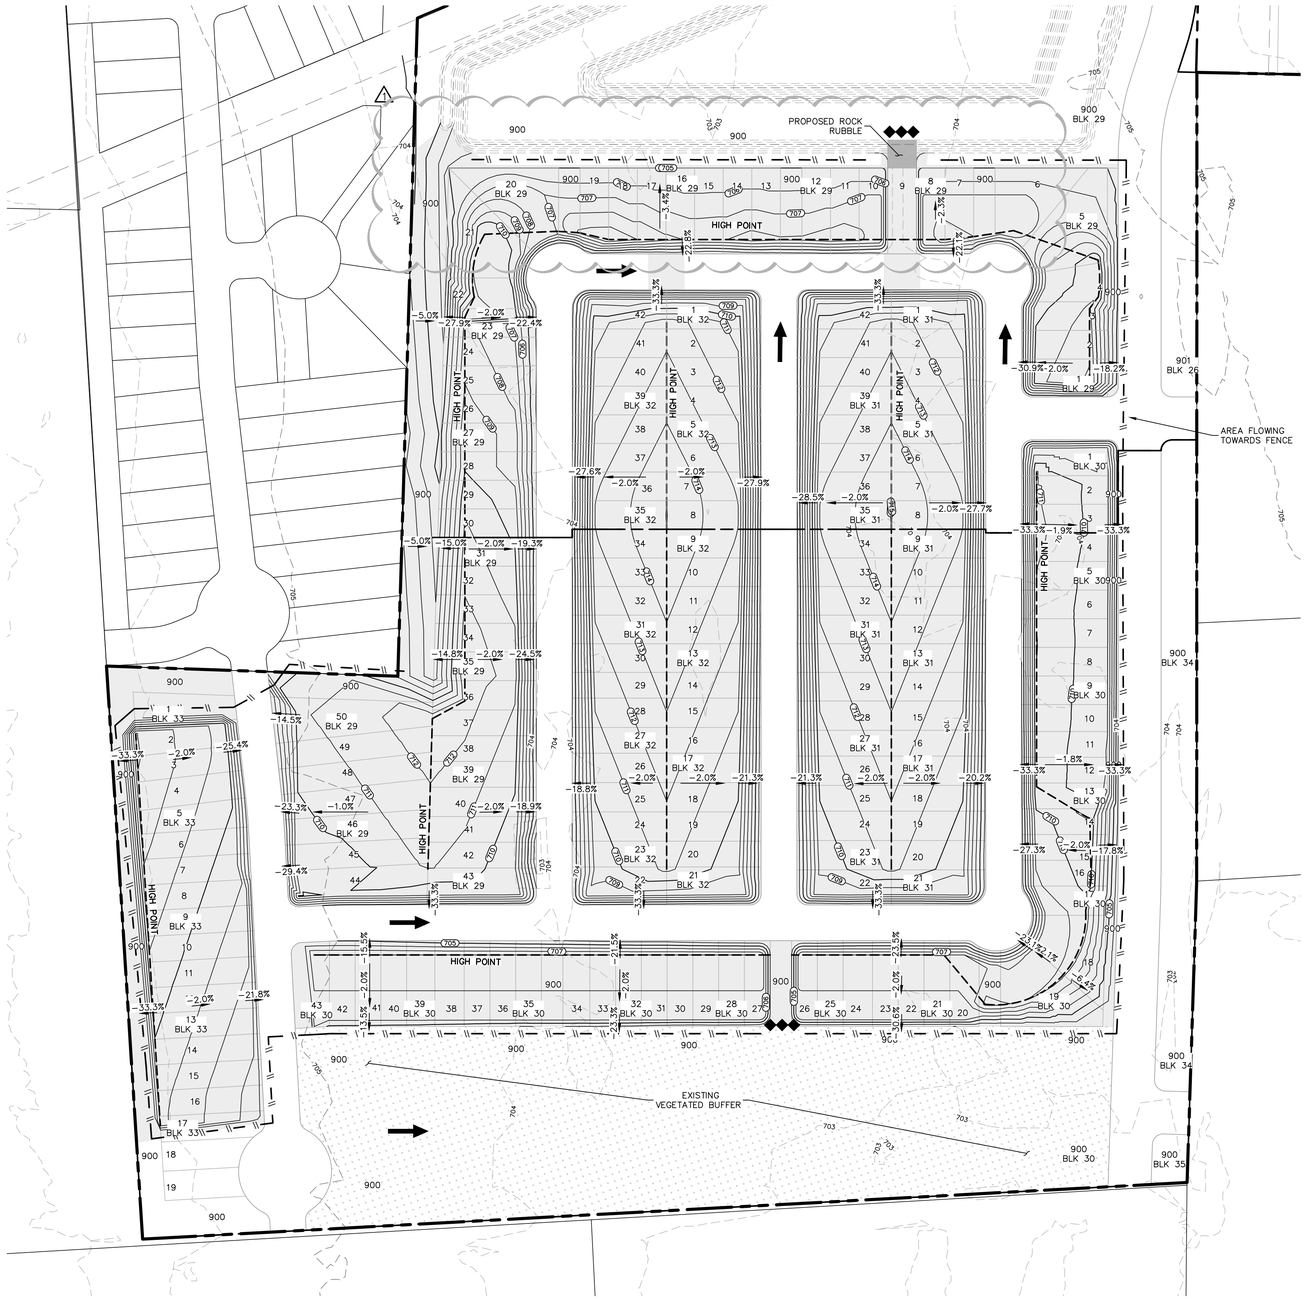

SCALE: 1"= 100'

0' 100' 200' 300'

LEGEND

PROJECT LIMITS	
EXISTING CONTOUR	976
PROPOSED CONTOUR	970
FLOW ARROW (PROPOSED)	
SILT FENCE	
ROCK BERM	
LIMITS OF DISTURBED AREA	

NOTES:

1. CONTRACTOR TO EXCAVATE AREA AS NEEDED TO BALANCE STEELWOOD TRAIL UNIT 3.
2. CONTRACTOR TO MAINTAIN 2% MINIMUM SLOPE AND POSITIVE DRAINAGE.
3. CONTRACTOR TO PROVIDE AS-BUILT TOPOGRAPHIC SURVEY OF ALL DISTURBED AREAS WITHIN THE EXCAVATION AREA AFTER ALL EXCAVATION IS COMPLETE.

NO.	REVISION	DATE
1	REVISED GRADING	07/11/22

PAPE-DAWSON ENGINEERS
NEW BRAUNFELS I SAN ANTONIO I AUSTIN I HOUSTON I FT WORTH I DALLAS
1672 INDEPENDENCE DR, STE 102 I NEW BRAUNFELS, TX 78132 I 830.632.5533
TEXAS ENGINEERING FIRM #470 I TEXAS SURVEYING FIRM #10028800

STEELWOOD TRAIL
NEW BRAUNFELS, TEXAS
GRADING EXHIBIT

PLAT NO. _____
JOB NO. 30034-03
DATE MARCH 2022
DESIGNER CL
CHECKED _____ DRAWN CL
SHEET 1 OF 1

Date: Jul 11, 2022, 12:25pm User ID: clundberg
File: P:\300\34\03\Design\Exhibits\220707-Unit 6 and 7 Grading.dwg

THIS DOCUMENT HAS BEEN PRODUCED FROM MATERIAL THAT WAS STORED AND/OR TRANSMITTED ELECTRONICALLY AND MAY HAVE BEEN INADVERTENTLY ALTERED. RELY ONLY ON FINAL HARDCOPY MATERIALS BEARING THE CONSULTANT'S ORIGINAL SIGNATURE AND SEAL. AERIAL IMAGERY PROVIDED BY GOOGLE© UNLESS OTHERWISE NOTED. Imagery © 2016,CAPCOG,Digital Globe,Texas Orthoimagery Program, USDA Farm Service Agency.